



WR I+230
WALLOMSAC RIVER

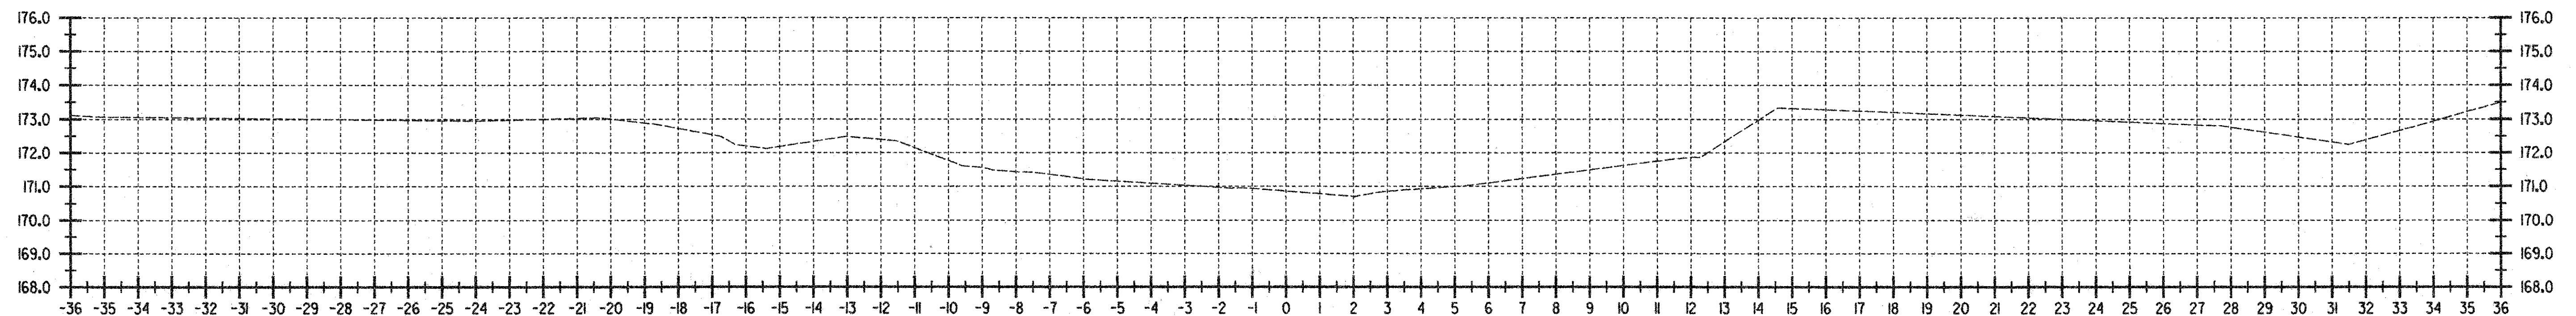

WR I+220
WALLOMSAC RIVER

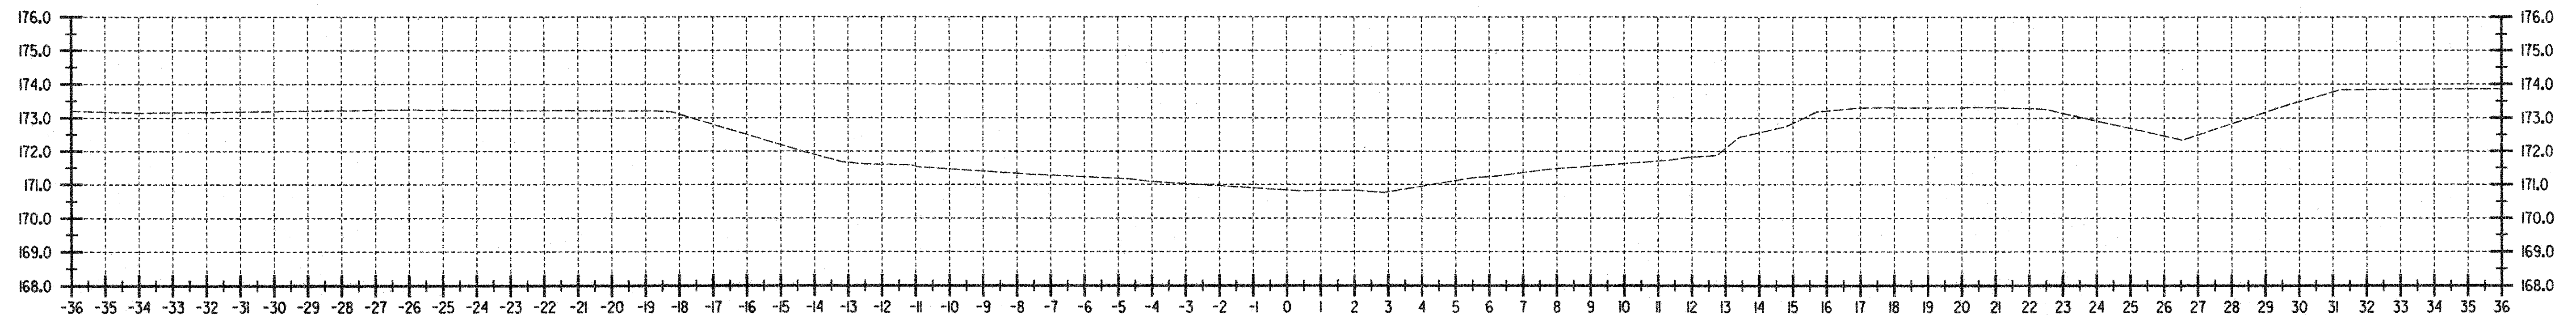

WR I+210
WALLOMSAC RIVER

DATUM
 VERTICAL NAVD 88
 HORIZONTAL NAD 83 (0992)

ALL DIMENSIONS IN MILLIMETERS
 EXCEPT AS INDICATED

 H 1:100
 V 1:100

SURVEYED BY C.H.A. & V.S.E. DATE 12/93
 DRAWN BY J.S.L. DATE 6/98
 SQUAD LEADER T.P.K.
 DESIGN FILE NO. /5116/VAOT/VTSECT3.D
 IPARM FILE _____ DATE PLOTTED _____
 PROJ. NAME BENNINGTON - HOOSICK
D.P.L. 0146(I) c14
 PROJ. NO. P.I.N. 1306.60
 SHEET 309 OF 385 SHEETS