



WR 1+410  
WALLOOMSAC RIVER

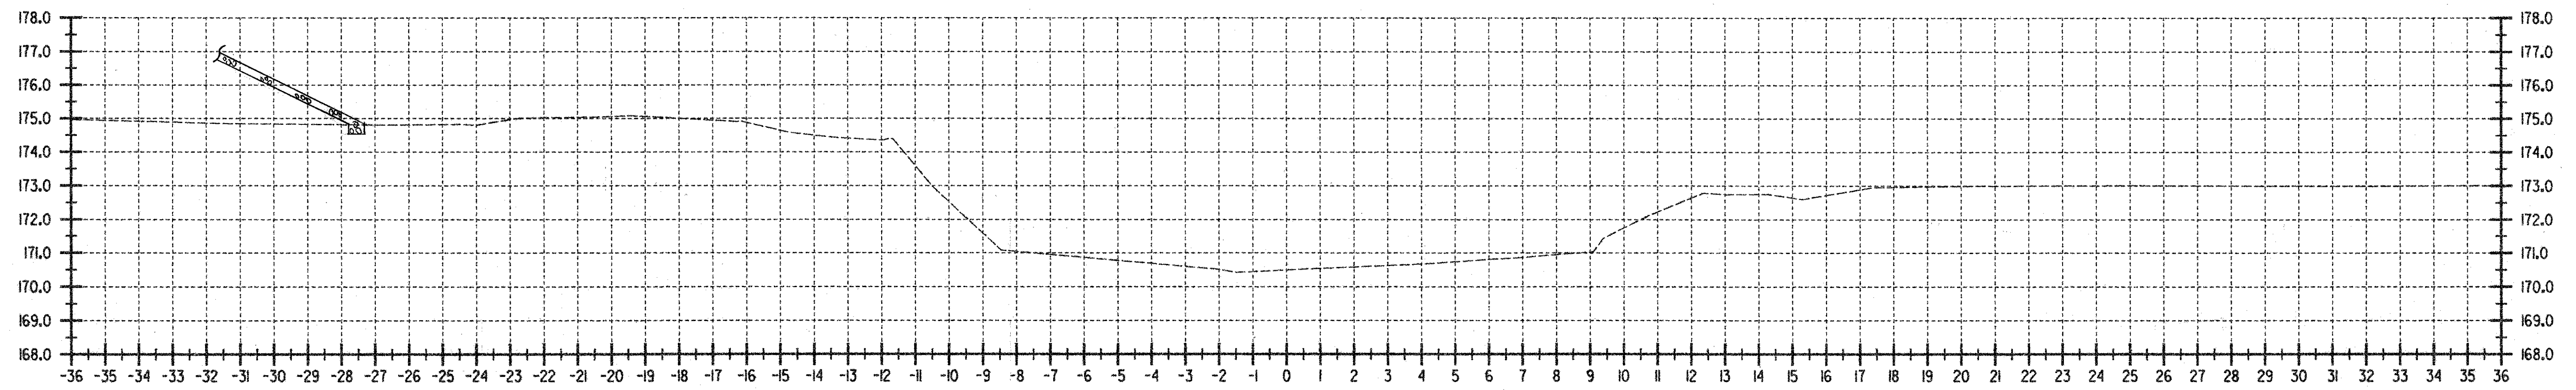

WR 1+400  
WALLOOMSAC RIVER

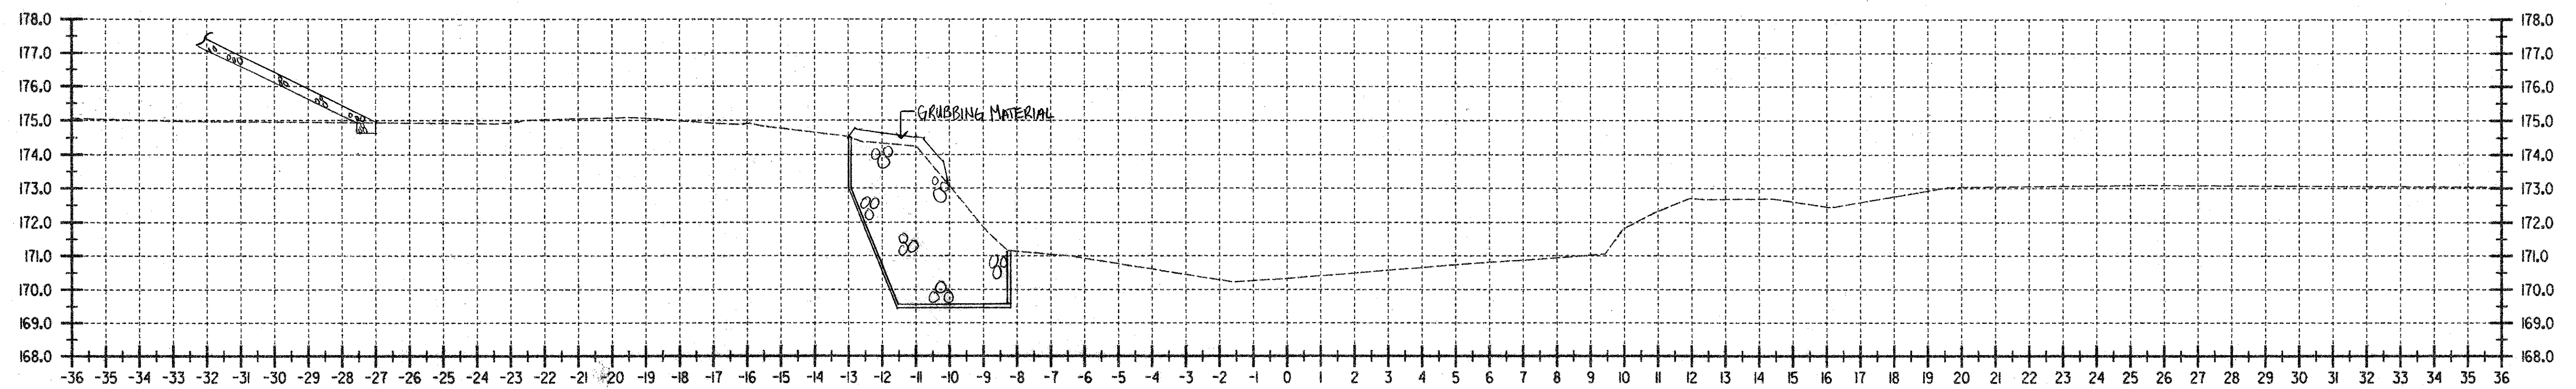

WR 1+390  
WALLOOMSAC RIVER

DATUM	
VERTICAL	NAVD 88
HORIZONTAL	NAD 83 (1992)

ALL DIMENSIONS IN MILLIMETERS  
EXCEPT AS INDICATED

2 0 2 m

H 1:100  
V 1:100

SURVEYED BY C.H.A. & V.S.E. DATE 12/93  
 DRAWN BY J.S.L. DATE 6/98  
 SQUAD LEADER T.P.K.  
 DESIGN FILE NO. /5116/VAQT/VTSECT3.D  
 IPARM \_\_\_\_\_ DATE \_\_\_\_\_  
 FILE \_\_\_\_\_ PLOTTED \_\_\_\_\_  
 PROJ. NAME BENNINGTON - HOOSICK  
 D.P.I. 0146(1) c/4  
 PROJ. NO. P.I.N. 1306.60  
 SHEET 375 OF 385 SHEETS