



Z10+100
EXISTING RAMP AB

C=104
F=0

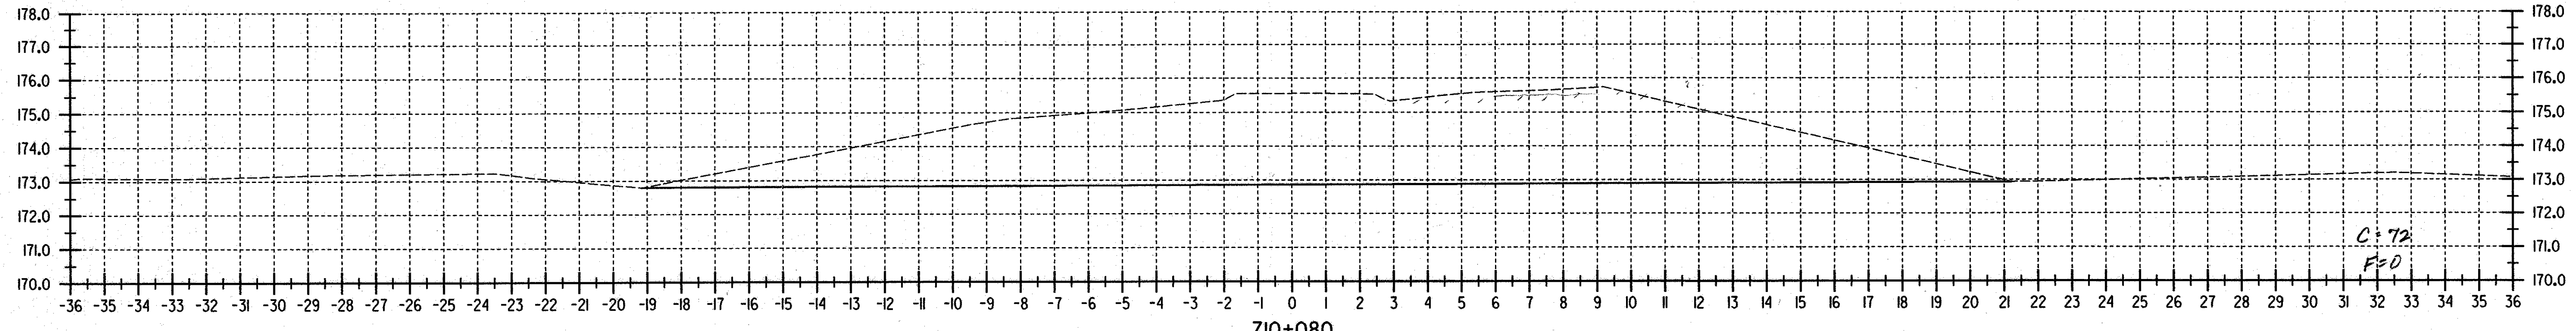

Z10+080
EXISTING RAMP AB

C=72
F=0

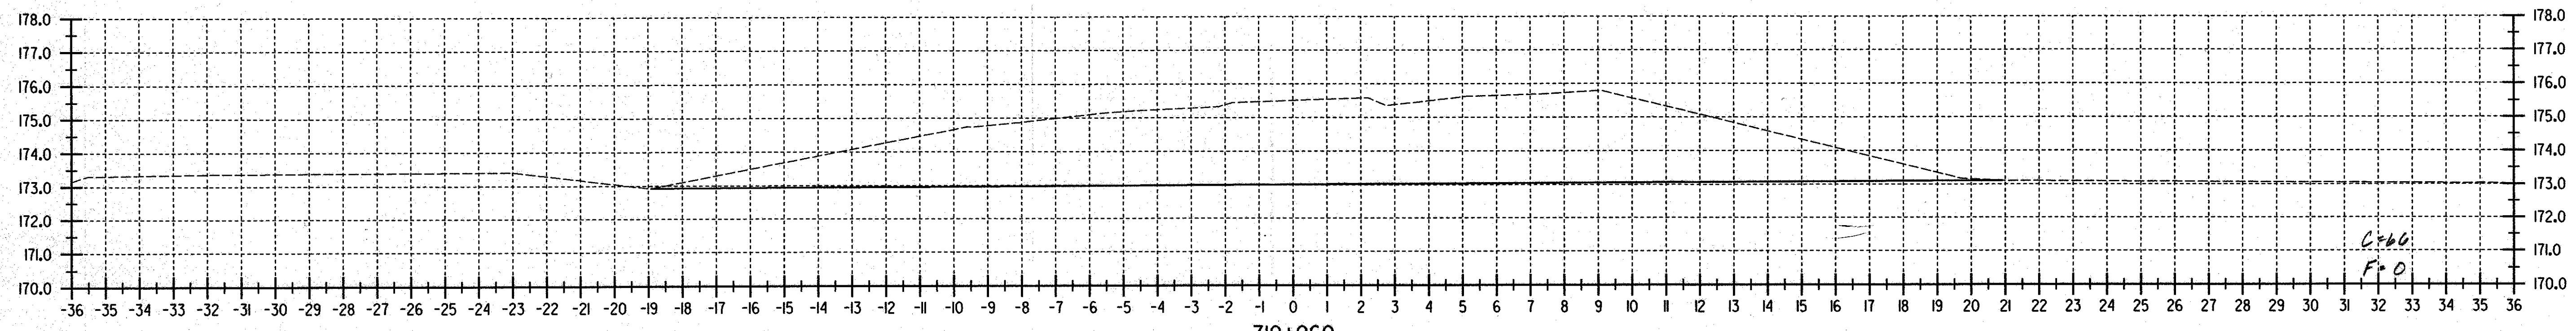

Z10+060
EXISTING RAMP AB

C=60
F=0

FILE NAME = \$FILE\$
DATE/TIME = \$DATE\$
USER = \$NTUSER\$

DATUM
VERTICAL NAVD 88
HORIZONTAL NAD 83 (1992)

ALL DIMENSIONS IN MILLIMETERS
EXCEPT AS INDICATED
2 0 2 m
H 1:100
V 1:100

SURVEYED BY C.H.A. & V.S.E. DATE 12/93
DRAWN BY J.S.L. DATE 6/98
SQUAD LEADER T.P.K.
DESIGN FILE NO. /5116/VAOT/EXRAMPAB
IPARM _____ DATE _____
FILE _____ DATE PLOTTED _____
PROJ. NAME BENNINGTON - HOOSICK
D.P.I. 0146(1) C/4
PROJ. NO. P.I.N. 1306.60
SHEET 382 OF 385 SHEETS