



Z10+160
EXISTING RAMP AB

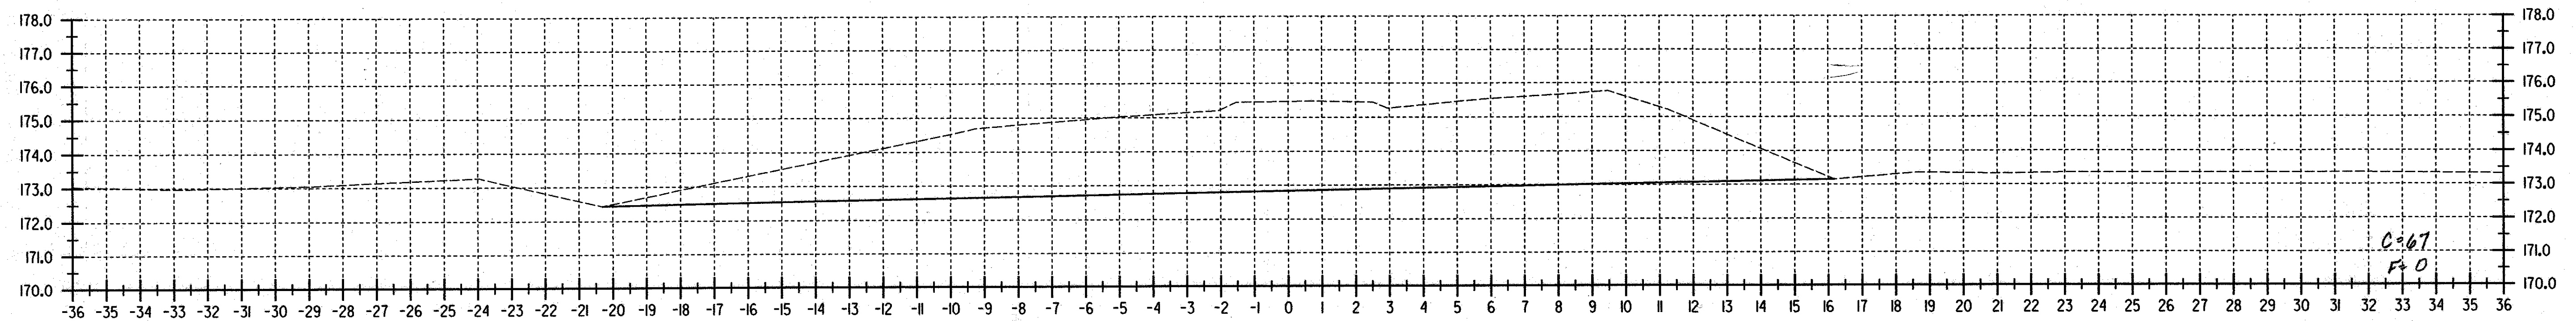

Z10+140
EXISTING RAMP AB

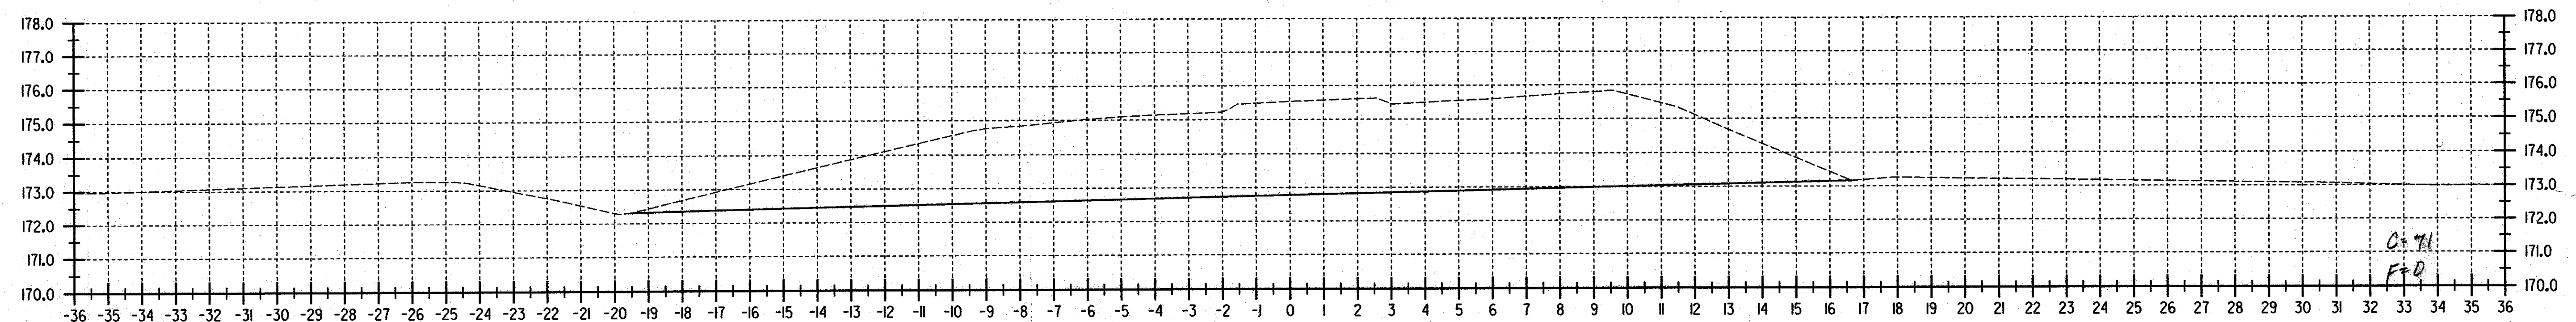

Z10+120
EXISTING RAMP AB

FILE NAME = \$FILE\$
DATE/TIME = \$DATE\$
USER = \$NTUSER\$

DATUM	
VERTICAL	NAVD 88
HORIZONTAL	NAD 83 (1992)

ALL DIMENSIONS IN MILLIMETERS
EXCEPT AS INDICATED
2 0 2 m
H 1:100
V 1:100

SURVEYED BY	C.H.A. & V.S.E.	DATE	12/93
DRAWN BY	J.S.L.	DATE	6/98
SQUAD LEADER	T.P.K.		
DESIGN FILE NO.	/5116/VA0T/EXRAMPAB		
IPARM FILE		DATE PLOTTED	
PROJ. NAME	BENNINGTON - HOOSICK D.P.L. 0146(1) C/4		
PROJ. NO.	P.I.N. 1306.60		
SHEET	383	OF	385 SHEETS