



Z10+220
EXISTING RAMP AB

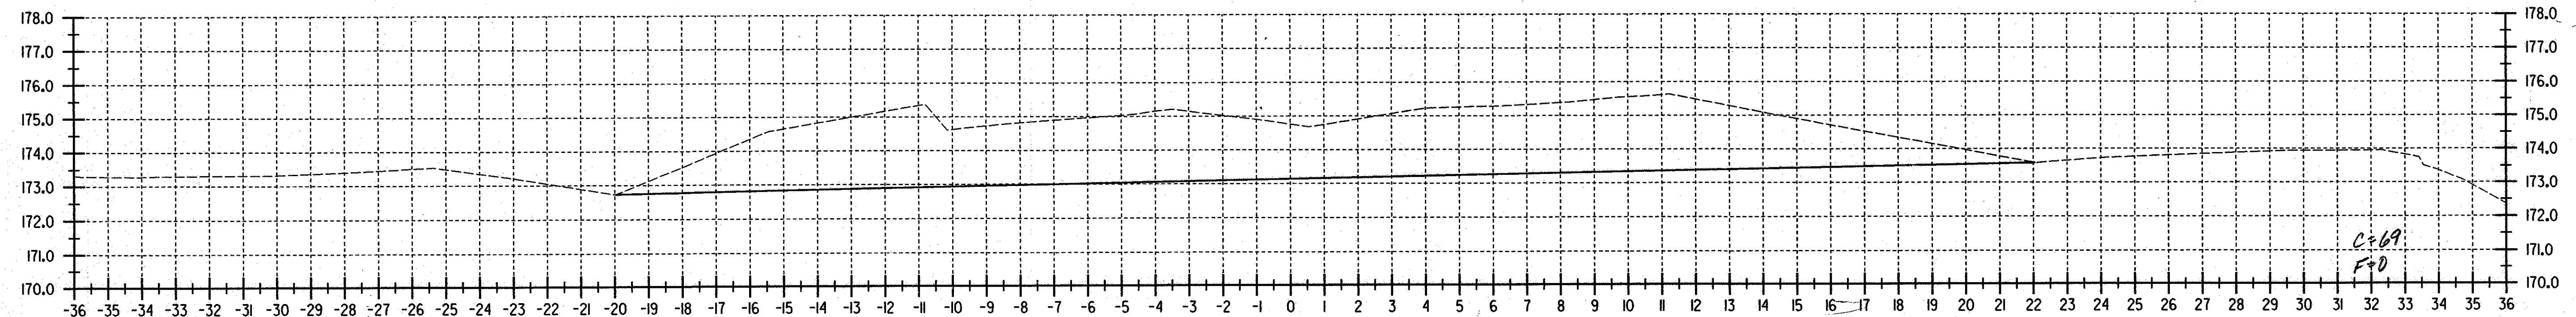

Z10+200
EXISTING RAMP AB

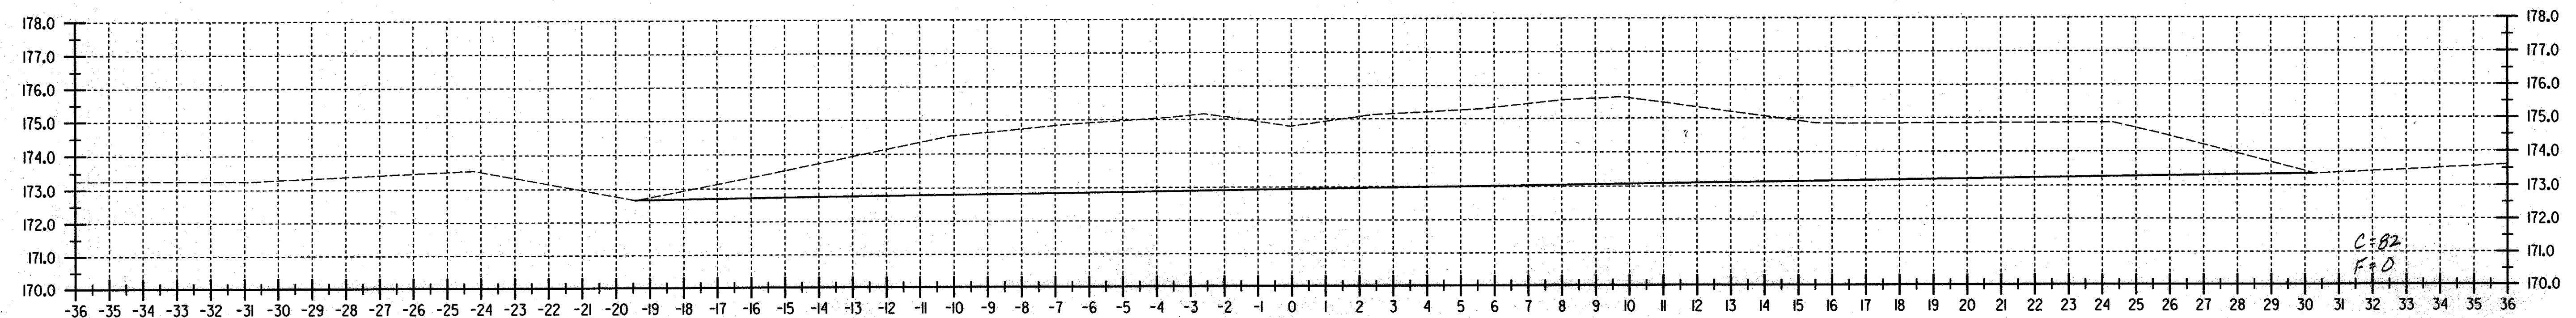

Z10+180
EXISTING RAMP AB

FILE NAME = \$FILE\$
DATE/TIME = \$DATE\$
USER = \$USER\$

DATUM
VERTICAL NAVD 88
HORIZONTAL NAD 83 (1992)

ALL DIMENSIONS IN MILLIMETERS
EXCEPT AS INDICATED
2 0 2 m
H 1:100
V 1:100

SURVEYED BY C.H.A. & V.S.E. DATE 12/93
DRAWN BY J.S.L. DATE 6/98
SQUAD LEADER T.P.K.
DESIGN FILE NO. /5116/VAOT/EXRAMPAB
IPARM FILE DATE PLOTTED
PROJ. NAME BENNINGTON - HOOSICK
D.P.J. 0146(1) C/4
PROJ. NO. P.I.N. 1306.60
SHEET 304 OF 305 SHEETS