


646.412 DURABLE 4 INCH YELLOW LINE, THERMOPLASTIC
 (ALL LINES WILL INCLUDE C/L BREAKS FOR TOWN HIGHWAYS)
 HISTORIC VT. ROUTE 7A:
 STA. 127+19.52 - STA. 134+00.00, DOUBLE SOLID C/L

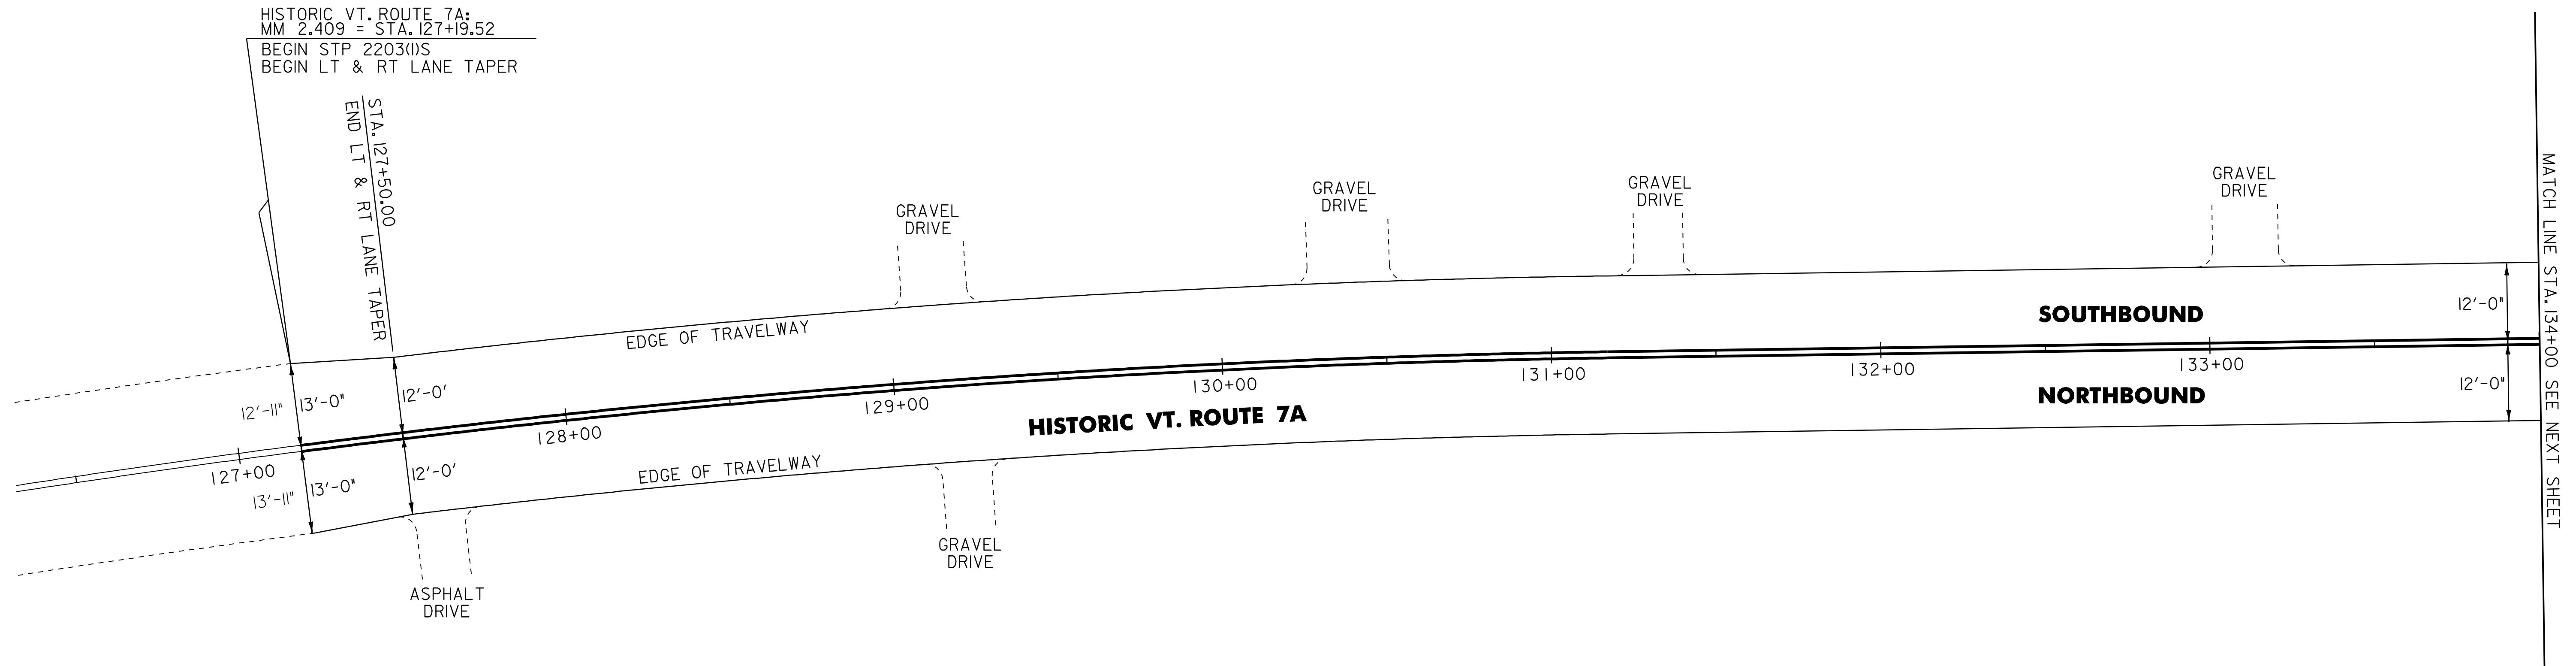

HISTORIC VT. ROUTE 7A:
 MM 2.409 = STA. 127+19.52
 BEGIN STP 2203(I)S
 BEGIN LT & RT LANE TAPER

STA. 127+50.00
 END LT & RT LANE TAPER

NOT TO SCALE

PROJECT LAYOUT SHEET #1	PROJECT NAME: MANCHESTER	
	PROJECT NUMBER: STP 2203(I)S	
	FILE NAME: p99c158.dgn	PLOT DATE: 09-MAY-2008
PROJECT LEADER: D.E.G.	DRAWN BY: C.A.K.	
DESIGNED BY: M.J.M.	CHECKED BY: D.W.E.	
IPARM FILE: p99c158101.l	SHEET 15 OF 68	