


646.412 DURABLE 4 INCH YELLOW LINE, THERMOPLASTIC
 (ALL LINES WILL INCLUDE C/L BREAKS FOR
 TOWN HIGHWAYS)
 HISTORIC VT. ROUTE 7A:
 STA. 155+00.00 - STA. 163+00.00 DOUBLE SOLID C/L

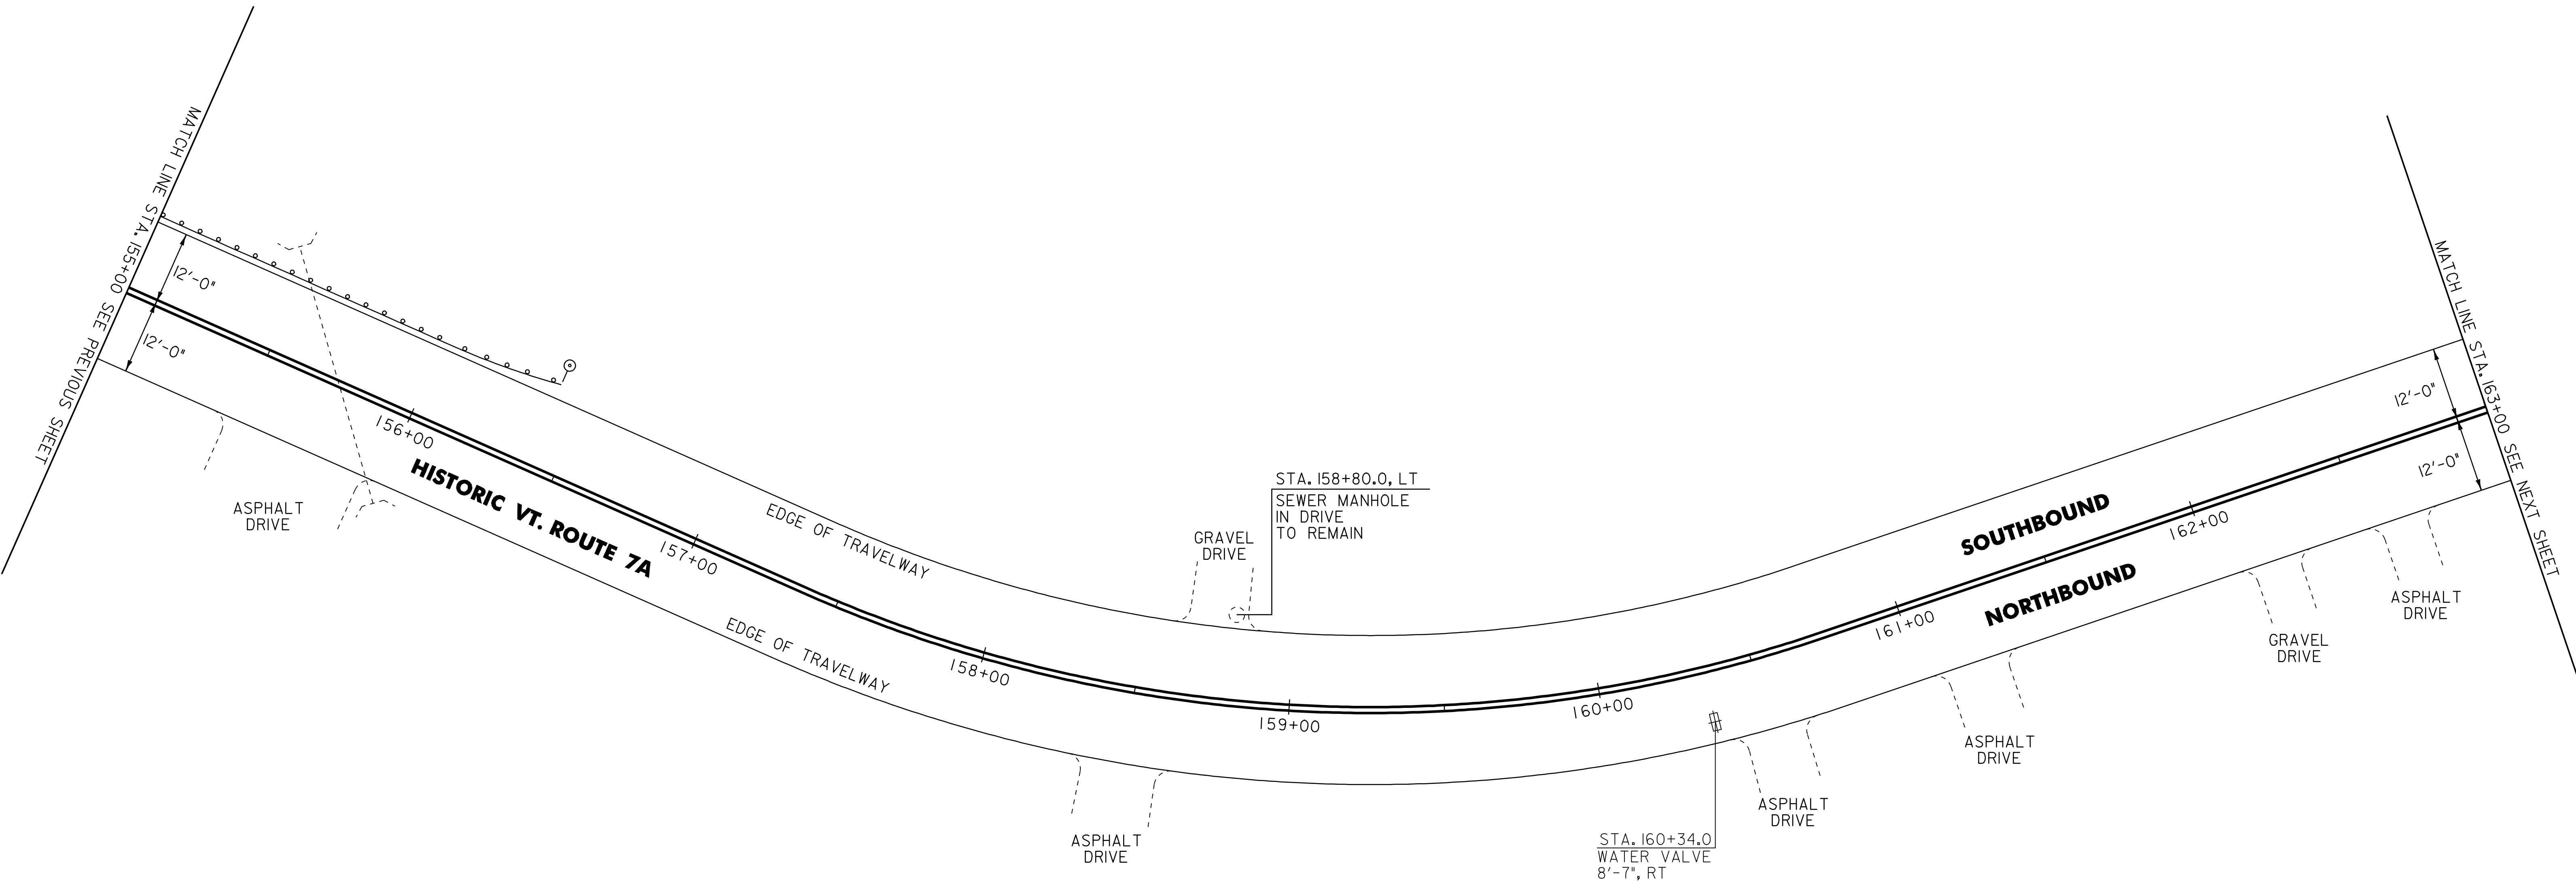

621.20 STEEL BEAM GUARDRAIL, GALVANIZED

HISTORIC VT. ROUTE 7A:
 STA. 155+00.0 - STA. 156+02.5 LT (102.5 LF)

621.50 MANUFACTURED TERMINAL SECTION, FLARED

HISTORIC VT. ROUTE 7A:
 STA. 156+02.5 - STA. 156+40.0 LT

621.80 REMOVAL AND DISPOSAL OF GUARDRAIL

HISTORIC VT. ROUTE 7A:
 STA. 155+00.0 - STA. 156+40.0 LT (140.0 LF)

629.20 ADJUST ELEVATION OF VALVE BOX

HISTORIC VT. ROUTE 7A:
 STA. 160+34.0 RT

676.10 DELINEATOR WITH STEEL POST

☉ TYPE 1 WHITE

HISTORIC VT. ROUTE 7A:
 STA. 156+40.0 LT

NOT TO SCALE

PROJECT LAYOUT SHEET #5	PROJECT NAME: MANCHESTER	
	PROJECT NUMBER: STP 2203(1)S	
	FILE NAME: p99c158.dgn	PLOT DATE: 09-MAY-2008
DESIGNED BY: M.J.M.	DRAWN BY: C.A.K.	
IPARM FILE: p99c158105.1	CHECKED BY: D.W.E.	
	SHEET 19 OF 68	