

646.412 DURABLE 4 INCH YELLOW LINE, THERMOPLASTIC
 (ALL LINES WILL INCLUDE C/L BREAKS FOR TOWN HIGHWAYS) S=SOLID, D=DASHED
 HISTORIC VT. ROUTE 7A:
 STA. 191+00.00 - STA. 199+00.00 DOUBLE SOLID C/L
 STA. 193+88.16 DOUBLE SOLID LT, SEMINARY AVENUE
 STA. 194+04.00 DOUBLE SOLID LT, TH-2

646.612 TEMPORARY 4 INCH YELLOW LINE, PAINT
 (ALL LINES WILL INCLUDE C/L BREAKS FOR TOWN HIGHWAYS) S=SOLID, D=DASHED
 HISTORIC VT. ROUTE 7A:
 STA. 191+00.00 - STA. 195+00.00 DOUBLE SOLID C/L
 STA. 193+88.16 DOUBLE SOLID LT, SEMINARY AVENUE
 STA. 194+04.00 DOUBLE SOLID LT, TH-2

646.481 DURABLE 24 INCH STOP BAR, TYPE ITAPE
 HISTORIC VT. ROUTE 7A:
 STA. 193+88.16 LT, SEMINARY AVENUE
 STA. 194+04.00 LT, TH-2

646.682 TEMPORARY 24 INCH STOP BAR, PAINT
 HISTORIC VT. ROUTE 7A:
 STA. 193+88.16 LT, SEMINARY AVENUE
 STA. 194+04.00 LT, TH-2

646.491 DURABLE LETTER OR SYMBOL, TYPE ITAPE
 HISTORIC VT. ROUTE 7A:
 STA. 193+88.16 LT, SEMINARY AVENUE, "S,T,O,P" (4 EA)
 STA. 194+04.00 LT, TH-2, "S,T,O,P" (4 EA)


675.50 REMOVING SIGNS
 AS SHOWN - 6
 675.60 ERECTING SALVAGED SIGNS
 AS SHOWN - 3

646.501 DURABLE CROSSWALK MARKING, TYPE ITAPE
 HISTORIC VT. ROUTE 7A:
 STA. 193+77.00 LT/RT
 STA. 193+88.16 LT, SEMINARY AVENUE

646.692 TEMPORARY LETTER OR SYMBOL, PAINT
 HISTORIC VT. ROUTE 7A:
 STA. 193+88.16 LT, SEMINARY AVENUE, "S,T,O,P" (8 EA)
 STA. 194+04.00 LT, TH-2, "S,T,O,P" (8 EA)

646.702 TEMPORARY CROSSWALK MARKING, PAINT
 HISTORIC VT. ROUTE 7A:
 STA. 193+77.00 LT/RT
 STA. 193+88.16 LT, SEMINARY AVENUE

900.680 SPECIAL PROVISION, (BITUMINOUS CONCRETE PAVEMENT SURFACE PREPARATION) (PG 64-28)
 HISTORIC VT. ROUTE 7A:
 STA. 195+00 - 199+00 LT/RT

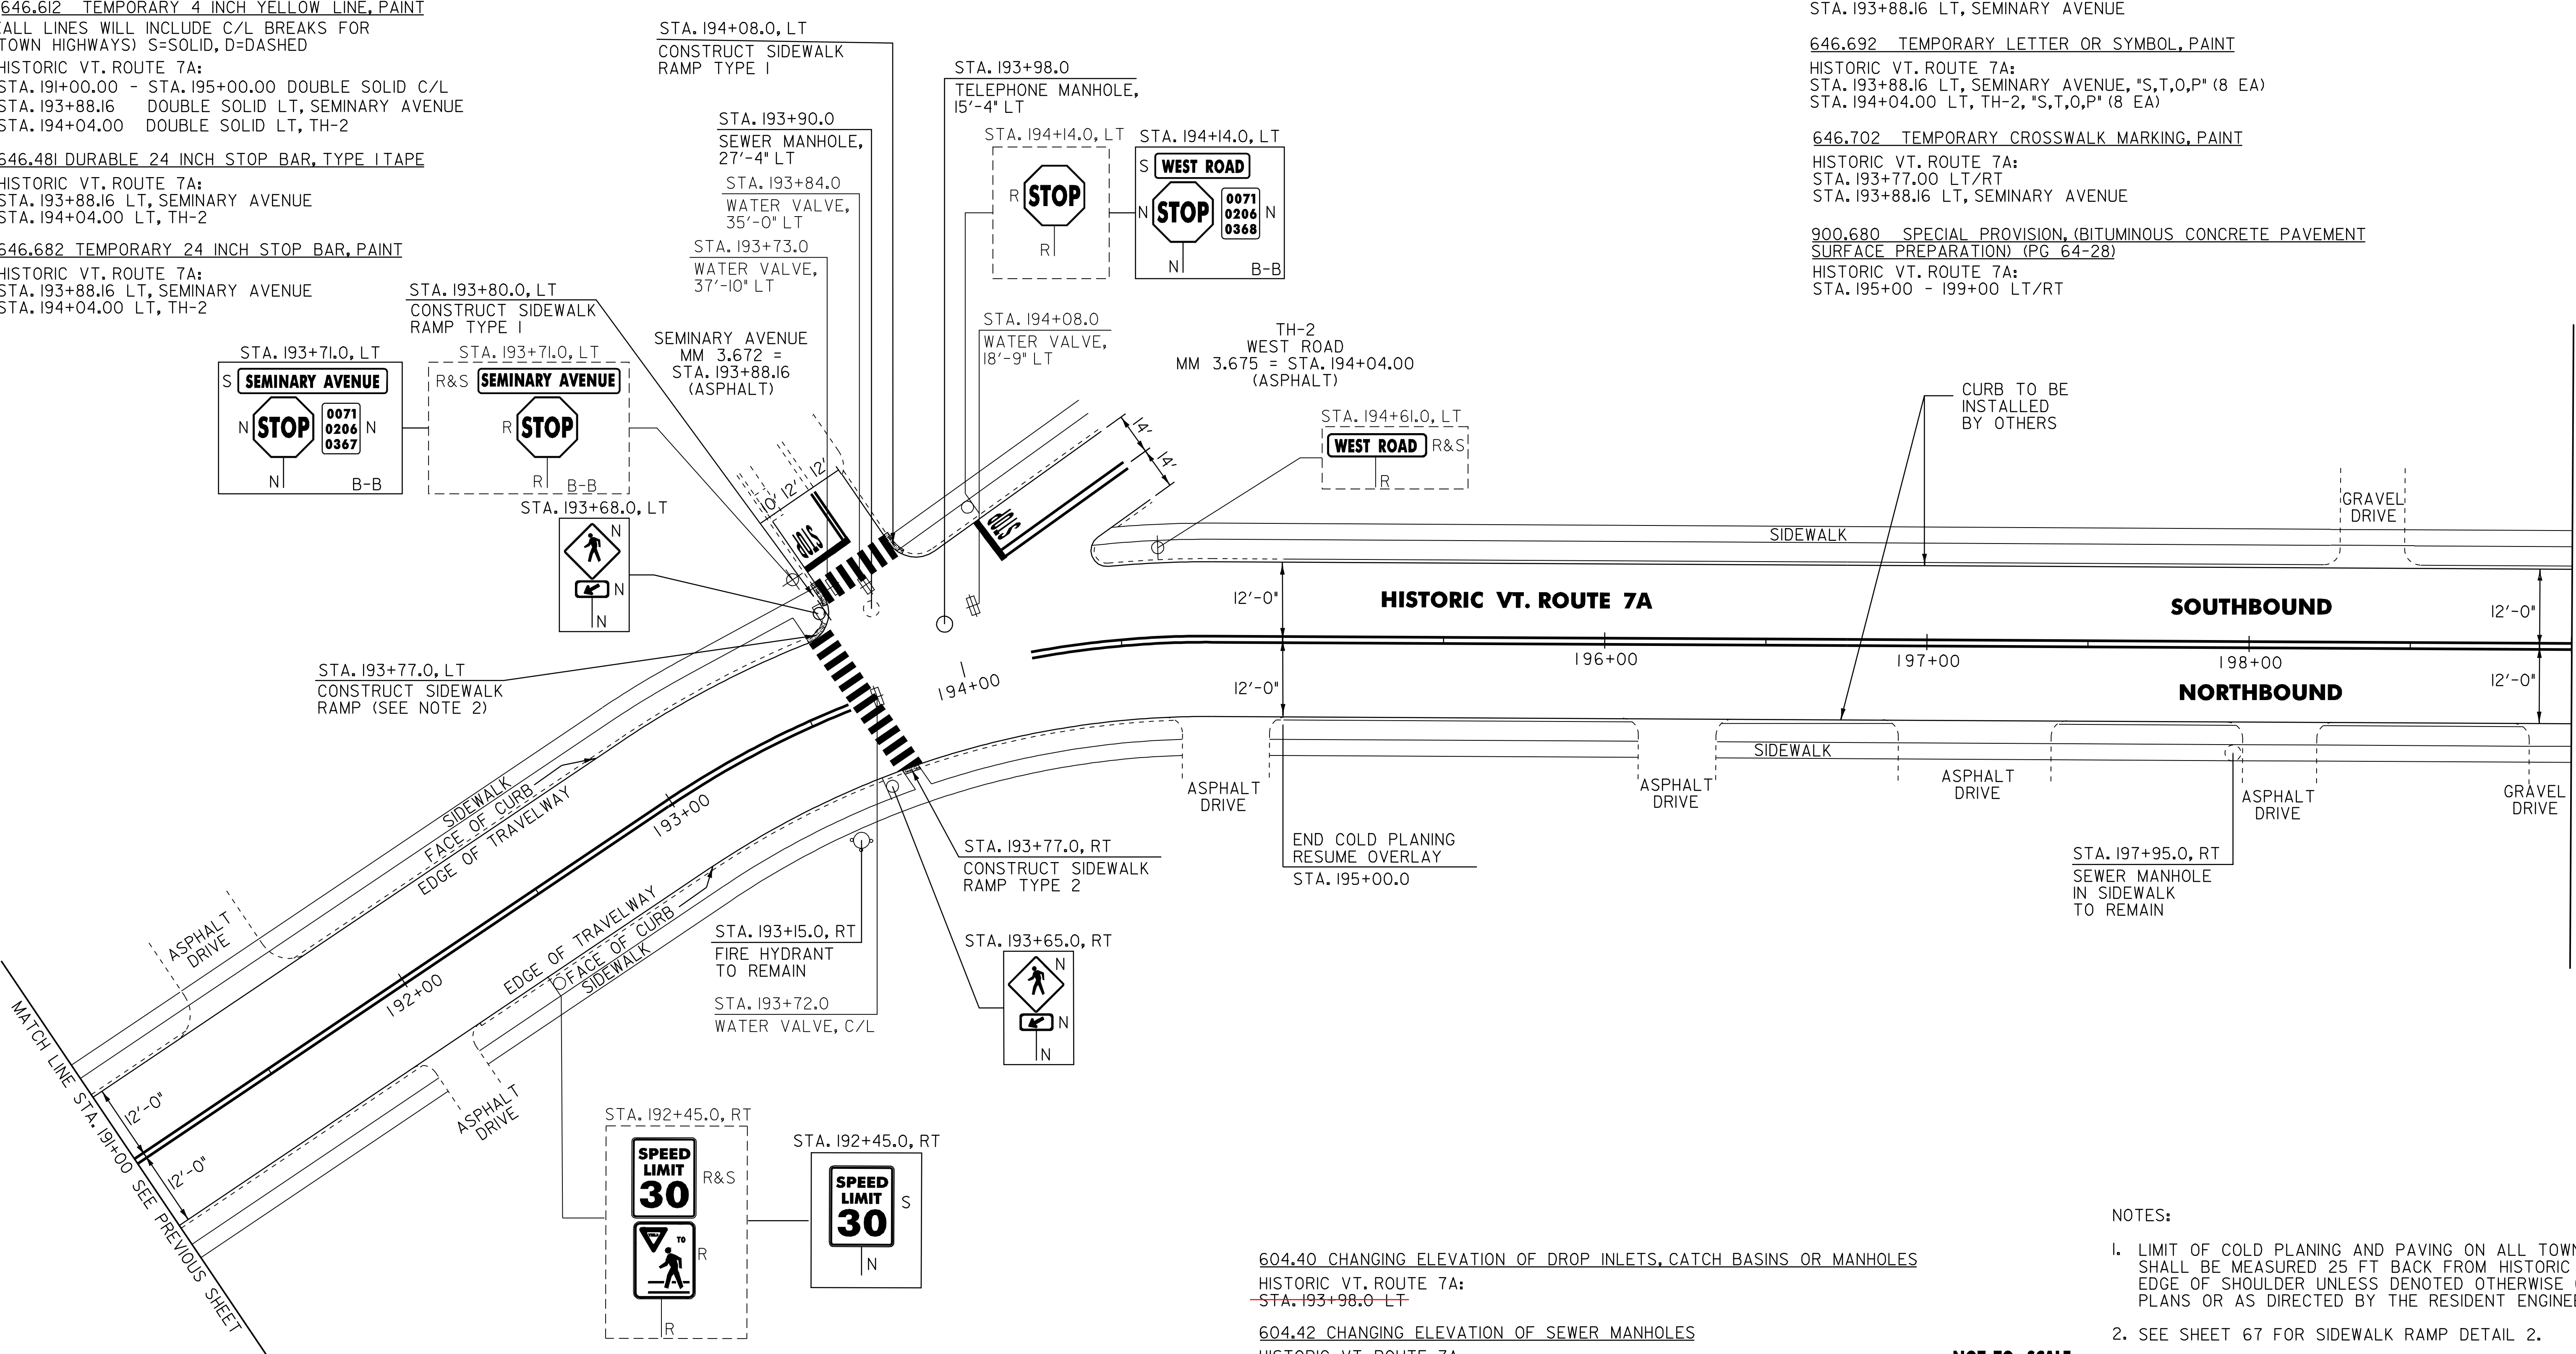

MATCH LINE STA. 191+00 SEE PREVIOUS SHEET

MATCH LINE STA. 199+00 SEE NEXT SHEET

604.40 CHANGING ELEVATION OF DROP INLETS, CATCH BASINS OR MANHOLES
 HISTORIC VT. ROUTE 7A:
~~STA. 193+98.0 LT~~

604.42 CHANGING ELEVATION OF SEWER MANHOLES
 HISTORIC VT. ROUTE 7A:
~~STA. 193+90.0 LT~~

629.20 ADJUST ELEVATION OF VALVE BOX
 HISTORIC VT. ROUTE 7A:
 STA. 193+72.0 CL
 STA. 193+73.0 LT
 STA. 193+84.0 LT
 STA. 194+08.0 LT

SIGN LEGEND
 R = REMOVE
 S = SALVAGE
 N = NEW
 RET = RETAIN
 B-B = BACK TO BACK
 EXISTING = - - - - -
 NEW = _____

NOTES:
 1. LIMIT OF COLD PLANING AND PAVING ON ALL TOWN HIGHWAYS SHALL BE MEASURED 25 FT BACK FROM HISTORIC VT. ROUTE 7A EDGE OF SHOULDER UNLESS DENOTED OTHERWISE ON THE PLANS OR AS DIRECTED BY THE RESIDENT ENGINEER.
 2. SEE SHEET 67 FOR SIDEWALK RAMP DETAIL 2.

PROJECT LAYOUT SHEET #10	PROJECT NAME: MANCHESTER	
	PROJECT NUMBER: STP 2203(I)S	
FILE NAME: p99c158.dgn	PLOT DATE: 09-MAY-2008	
PROJECT LEADER: D.E.G.	DRAWN BY: C.A.K.	
DESIGNED BY: M.J.M.	CHECKED BY: D.W.E.	
IPARM FILE: p99c158110.1	SHEET 24 OF 68	