


646.412 DURABLE 4 INCH YELLOW LINE, THERMOPLASTIC  
 (ALL LINES WILL INCLUDE C/L BREAKS FOR  
 TOWN HIGHWAYS)  
 HISTORIC VT. ROUTE 7A:  
 STA. 220+00.00 - STA. 227+00.00 DOUBLE SOLID C/L

900.680 SPECIAL PROVISION (BITUMINOUS CONCRETE PAVEMENT  
 SURFACE PREPARATION) (PG 64-28)  
 HISTORIC VT. ROUTE 7A:  
 STA. 220+00 - 227+00 LT/RT

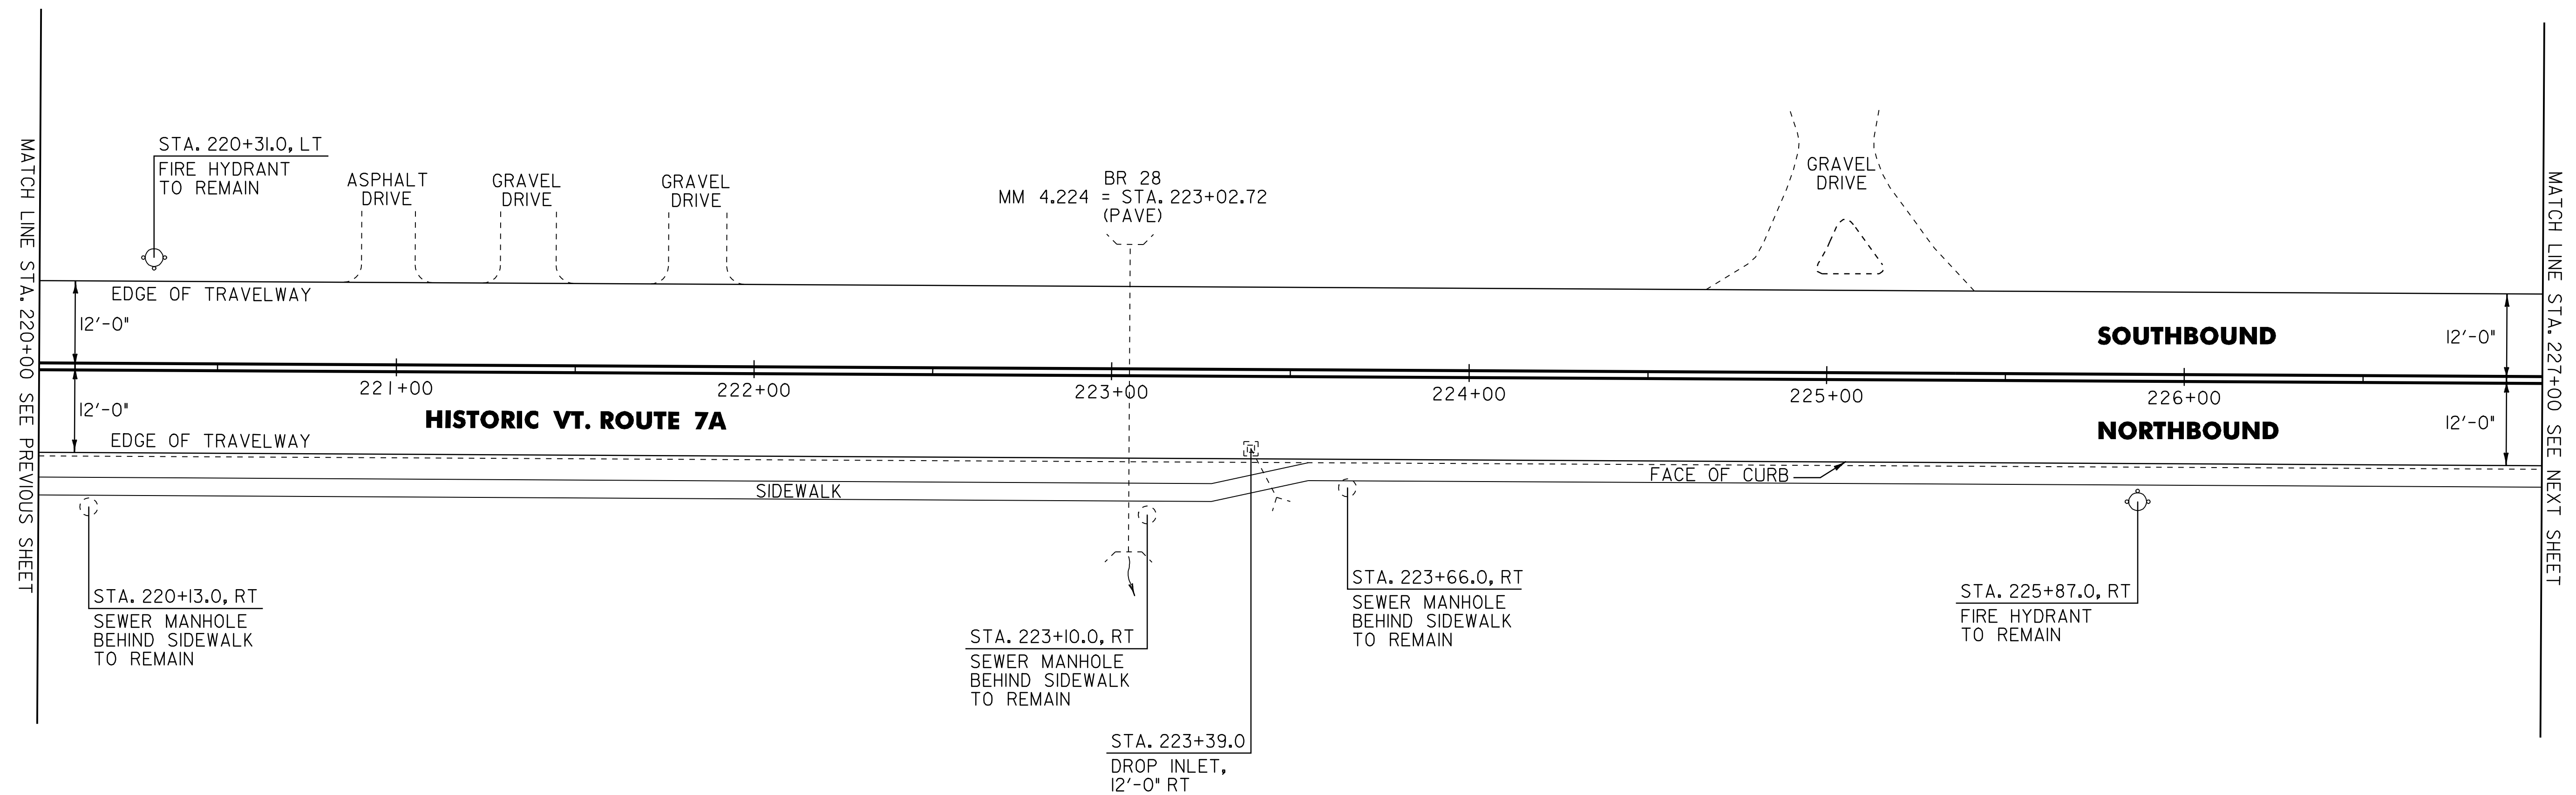

~~604.412 REHAB. DROP INLETS, CATCH BASINS, OR MANHOLES, CLASS 1~~  
 604.40 CHANGING ELEV. DI, CB, OR MH  
 HISTORIC VT. ROUTE 7A:  
 STA. 223+39.0 RT

NOT TO SCALE

**PROJECT  
 LAYOUT  
 SHEET #14**

PROJECT NAME: MANCHESTER  
 PROJECT NUMBER: STP 2203(I)S

FILE NAME: p99c158.dgn  
 PROJECT LEADER: D.E.G.  
 DESIGNED BY: M.J.M.  
 IPARM FILE: p99c158114.1

PLOT DATE: 09-MAY-2008  
 DRAWN BY: C.A.K.  
 CHECKED BY: D.W.E.  
 SHEET 28 OF 68