

646.402 DURABLE 4 INCH WHITE LINE, THERMOPLASTIC  
 (ALL LINES WILL INCLUDE EDGE LINE BREAKS AND RADIUS FOR TOWN HIGHWAYS)

VT. ROUTE 11:  
 STA. 21+87.00 - STA. 23+00.00 EDGE LINE LT/RT  
 STA. 22+75.00 - STA. 23+00.00 SOLID LANE LINE RT

646.412 DURABLE 4 INCH YELLOW LINE, THERMOPLASTIC  
 (ALL LINES WILL INCLUDE C/L BREAKS FOR TOWN HIGHWAYS)

VT. ROUTE 11:  
 STA. 16+00.00 - STA. 21+87.00 SOLID/DASHED TURN LANE LINES LT/RT  
 STA. 21+87.00 - STA. 23+00.00 DOUBLE SOLID LT

646.491 DURABLE LETTER OR SYMBOL, TYPE ITAPE

VT. ROUTE 11:  
 STA. 17+48.00 C/L, ARROW (1 EA)  
 STA. 17+59.00 C/L, ARROW (1 EA)  
 STA. 19+67.00 C/L, ARROW (1 EA)  
 STA. 19+78.00 C/L, ARROW (1 EA)  
 STA. 21+73.00 C/L, ARROW (1 EA)  
 STA. 21+84.00 C/L, ARROW (1 EA)  
 STA. 22+79.00 C/L, ARROW (1 EA)

646.602 TEMPORARY 4 INCH WHITE LINE, PAINT  
 (ALL LINES WILL INCLUDE EDGE LINE BREAKS AND RADIUS FOR TOWN HIGHWAYS)

VT. ROUTE 11:  
 STA. 21+87.00 - STA. 23+00.00 EDGE LINE LT/RT  
 STA. 22+75.00 - STA. 23+00.00 SOLID LANE LINE RT


646.612 TEMPORARY 4 INCH YELLOW LINE, PAINT  
 (ALL LINES WILL INCLUDE C/L BREAKS FOR TOWN HIGHWAYS)

VT. ROUTE 11:  
 STA. 16+00.00 - STA. 21+87.00 SOLID/DASHED TURN LANE LINES LT/RT  
 STA. 21+87.00 - STA. 23+00.00 DOUBLE SOLID LT

646.692 TEMPORARY LETTER OR SYMBOL, PAINT

VT. ROUTE 11:  
 STA. 17+48.00 C/L, ARROW (2 EA)  
 STA. 17+59.00 C/L, ARROW (2 EA)  
 STA. 19+67.00 C/L, ARROW (2 EA)  
 STA. 19+78.00 C/L, ARROW (2 EA)  
 STA. 21+73.00 C/L, ARROW (2 EA)  
 STA. 21+84.00 C/L, ARROW (2 EA)  
 STA. 22+79.00 C/L, ARROW (2 EA)

675.50 REMOVING SIGNS  
 AS SHOWN - 5

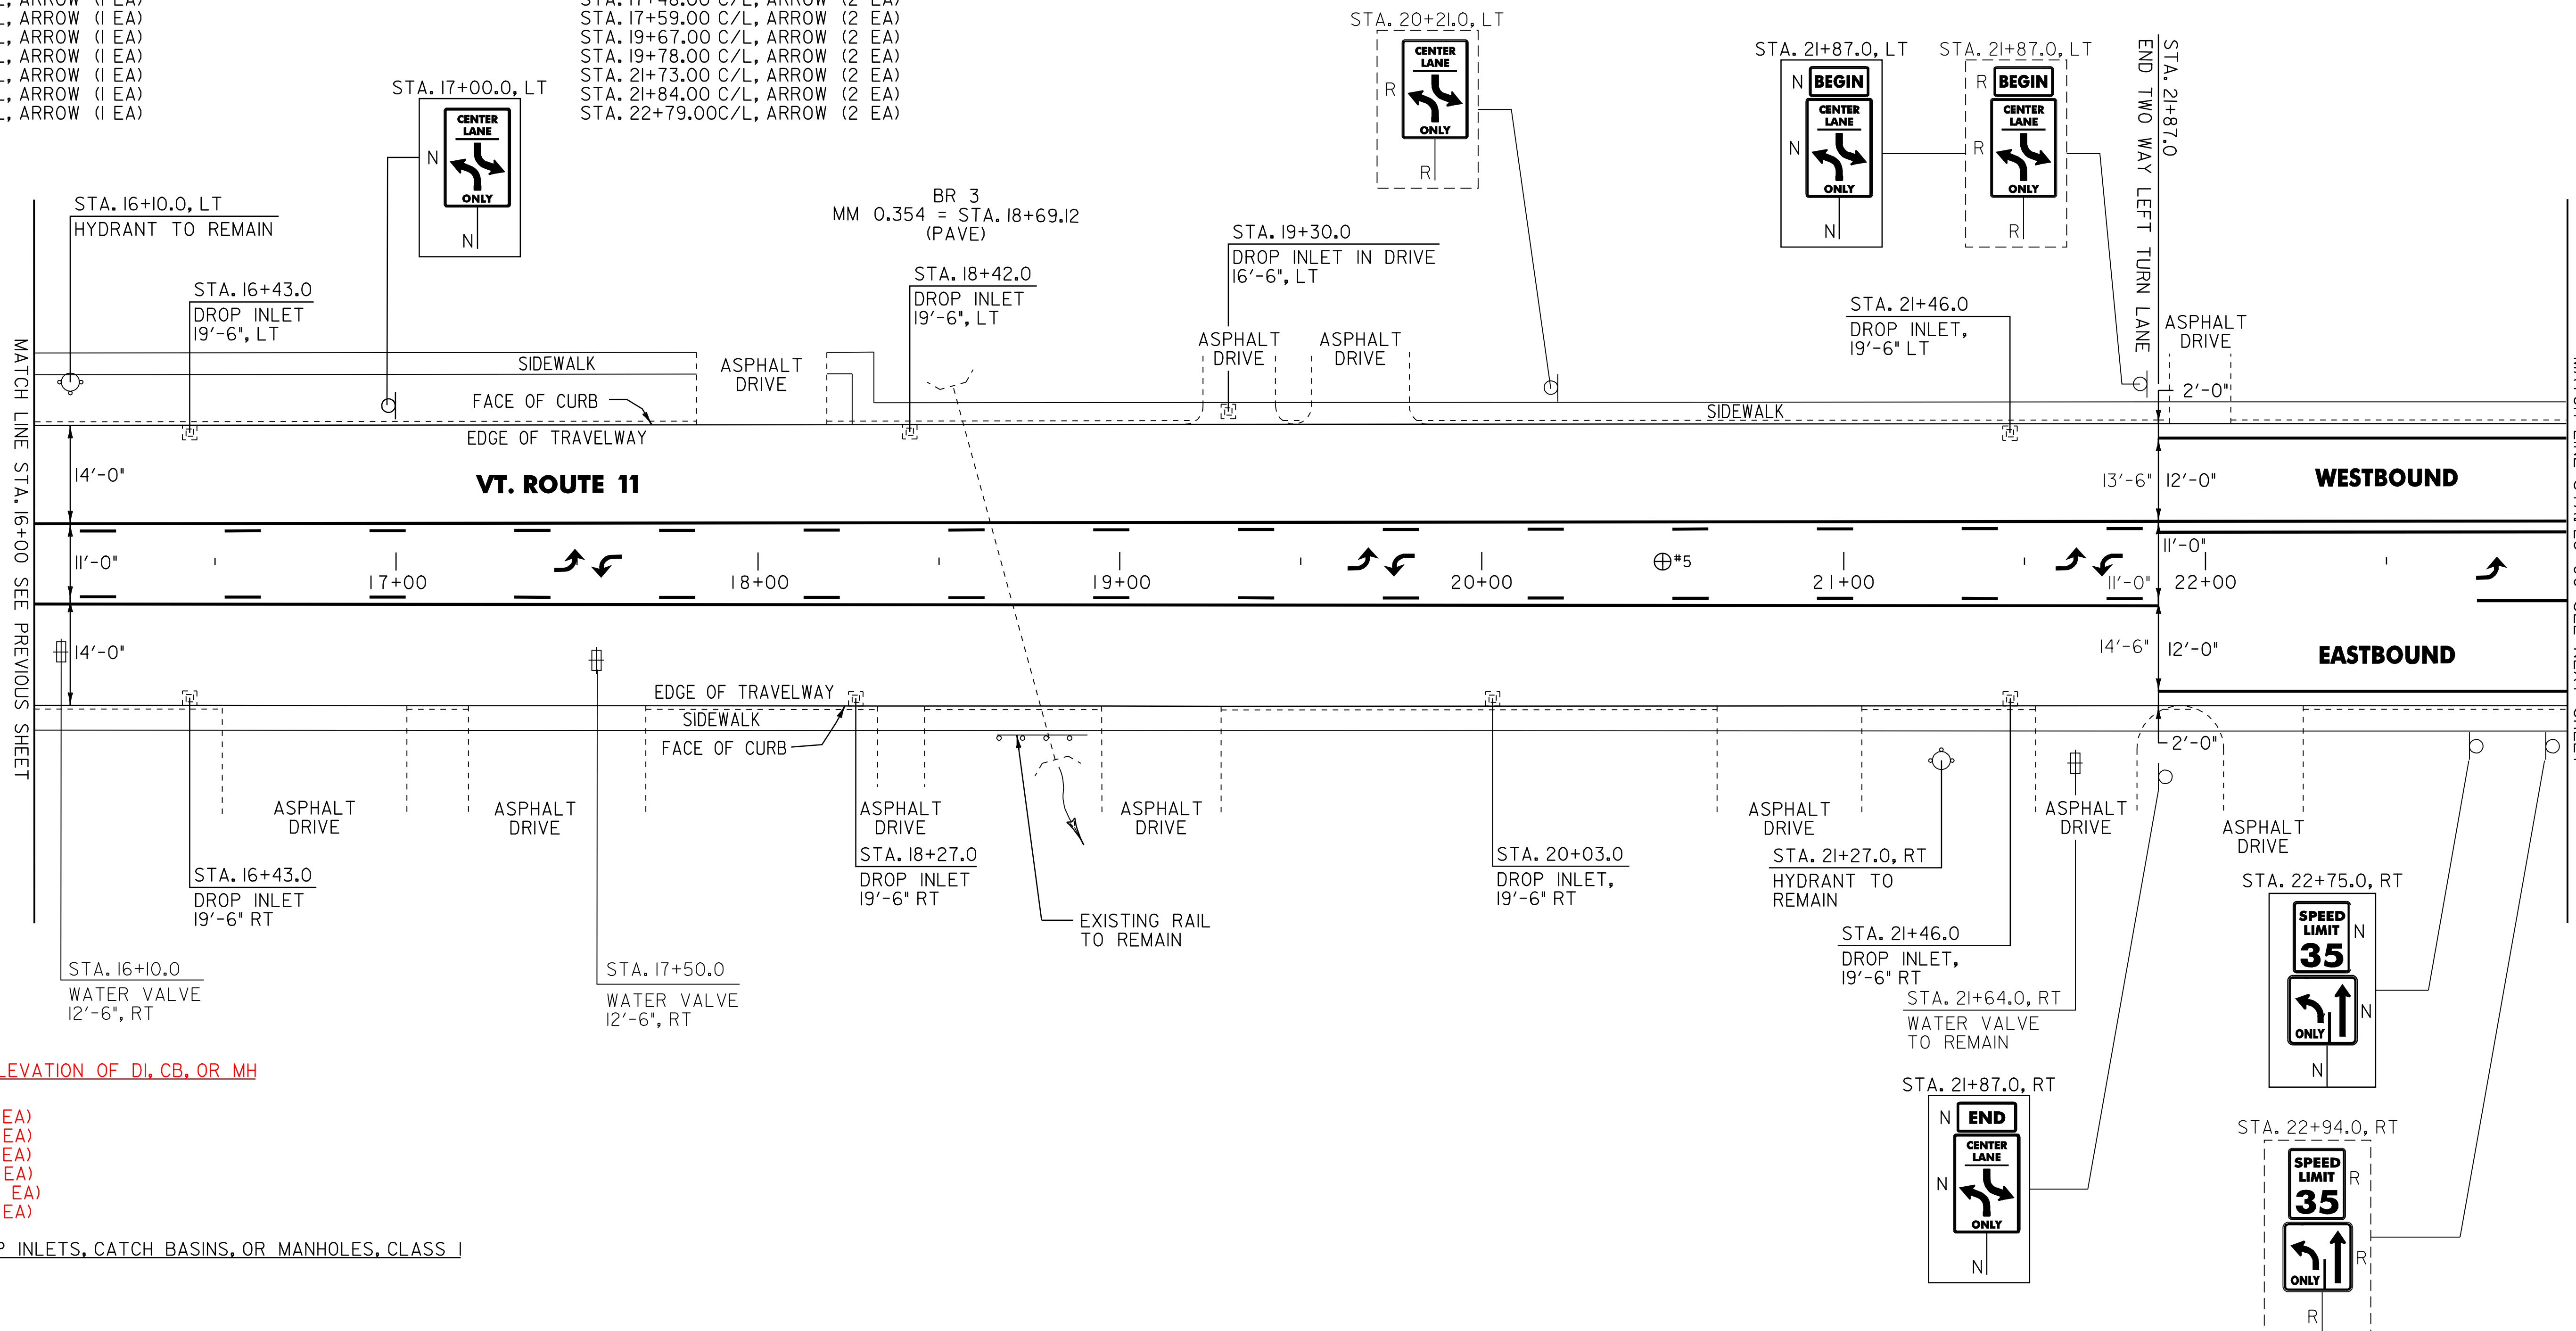

604.40 CHANGING ELEVATION OF DI, CB, OR MH

VT. ROUTE 11:  
 STA. 16+43 LT (0.5 EA)  
 STA. 16+43 RT (0.5 EA)  
 STA. 18+27 RT (0.5 EA)  
 STA. 18+50 LT (0.5 EA)  
 STA. 20+03 RT (0.5 EA)  
 STA. 21+46 LT (0.5 EA)

604.412 REHAB. DROP INLETS, CATCH BASINS, OR MANHOLES, CLASS I

VT. ROUTE 11:  
~~STA. 16+43.0 LT~~  
~~STA. 16+43.0 RT~~  
~~STA. 18+27.0 RT~~  
~~STA. 18+42.0 LT~~  
~~STA. 19+30.0 LT~~  
~~STA. 20+03.0 RT~~  
~~STA. 21+46.0 LT~~  
~~STA. 21+46.0 RT~~

629.20 ADJUST ELEVATION OF VALVE BOX

VT. ROUTE 11:  
 STA. 16+10.0 RT  
 STA. 17+50.0 RT

PAVEMENT CORES = ⊕

#	TOTAL DEPTH (INCH)	PCC	COMMENTS
5	7	NO	

SIGN LEGEND  
 R = REMOVE  
 S = SALVAGE  
 N = NEW  
 RET = RETAIN  
 B-B = BACK TO BACK  
 EXISTING = - - - - -  
 NEW = \_\_\_\_\_

NOT TO SCALE

**PROJECT LAYOUT SHEET #26**

PROJECT NAME: MANCHESTER  
 PROJECT NUMBER: STP 2203(I)S

FILE NAME: p99c158.dgn  
 PROJECT LEADER: D.E.G.  
 DESIGNED BY: M.J.M.  
 IPARM FILE: p99c158126.dgn

PLOT DATE: 09-MAY-2008  
 DRAWN BY: C.A.K.  
 CHECKED BY: D.W.E.  
 SHEET 40 OF 68