


646.402 DURABLE 4 INCH WHITE LINE, THERMOPLASTIC
 VT. ROUTE 30:
 STA. 9+00.00 - STA. 14+00.00 EDGE LINE, LT/RT

646.602 TEMPORARY 4 INCH WHITE LINE, PAINT
 VT. ROUTE 30:
 STA. 9+00.00 - STA. 14+00.00 EDGE LINE, LT/RT

646.412 DURABLE 4 INCH YELLOW LINE, THERMOPLASTIC
 (ALL LINES WILL INCLUDE C/L BREAKS FOR TOWN HIGHWAYS)
 VT. ROUTE 30:
 STA. 9+00.00 - STA. 14+00.00 DOUBLE SOLID C/L

646.612 TEMPORARY 4 INCH YELLOW LINE, PAINT
 (ALL LINES WILL INCLUDE C/L BREAKS FOR TOWN HIGHWAYS)
 VT. ROUTE 30:
 STA. 9+00.00 - STA. 14+00.00 DOUBLE SOLID C/L

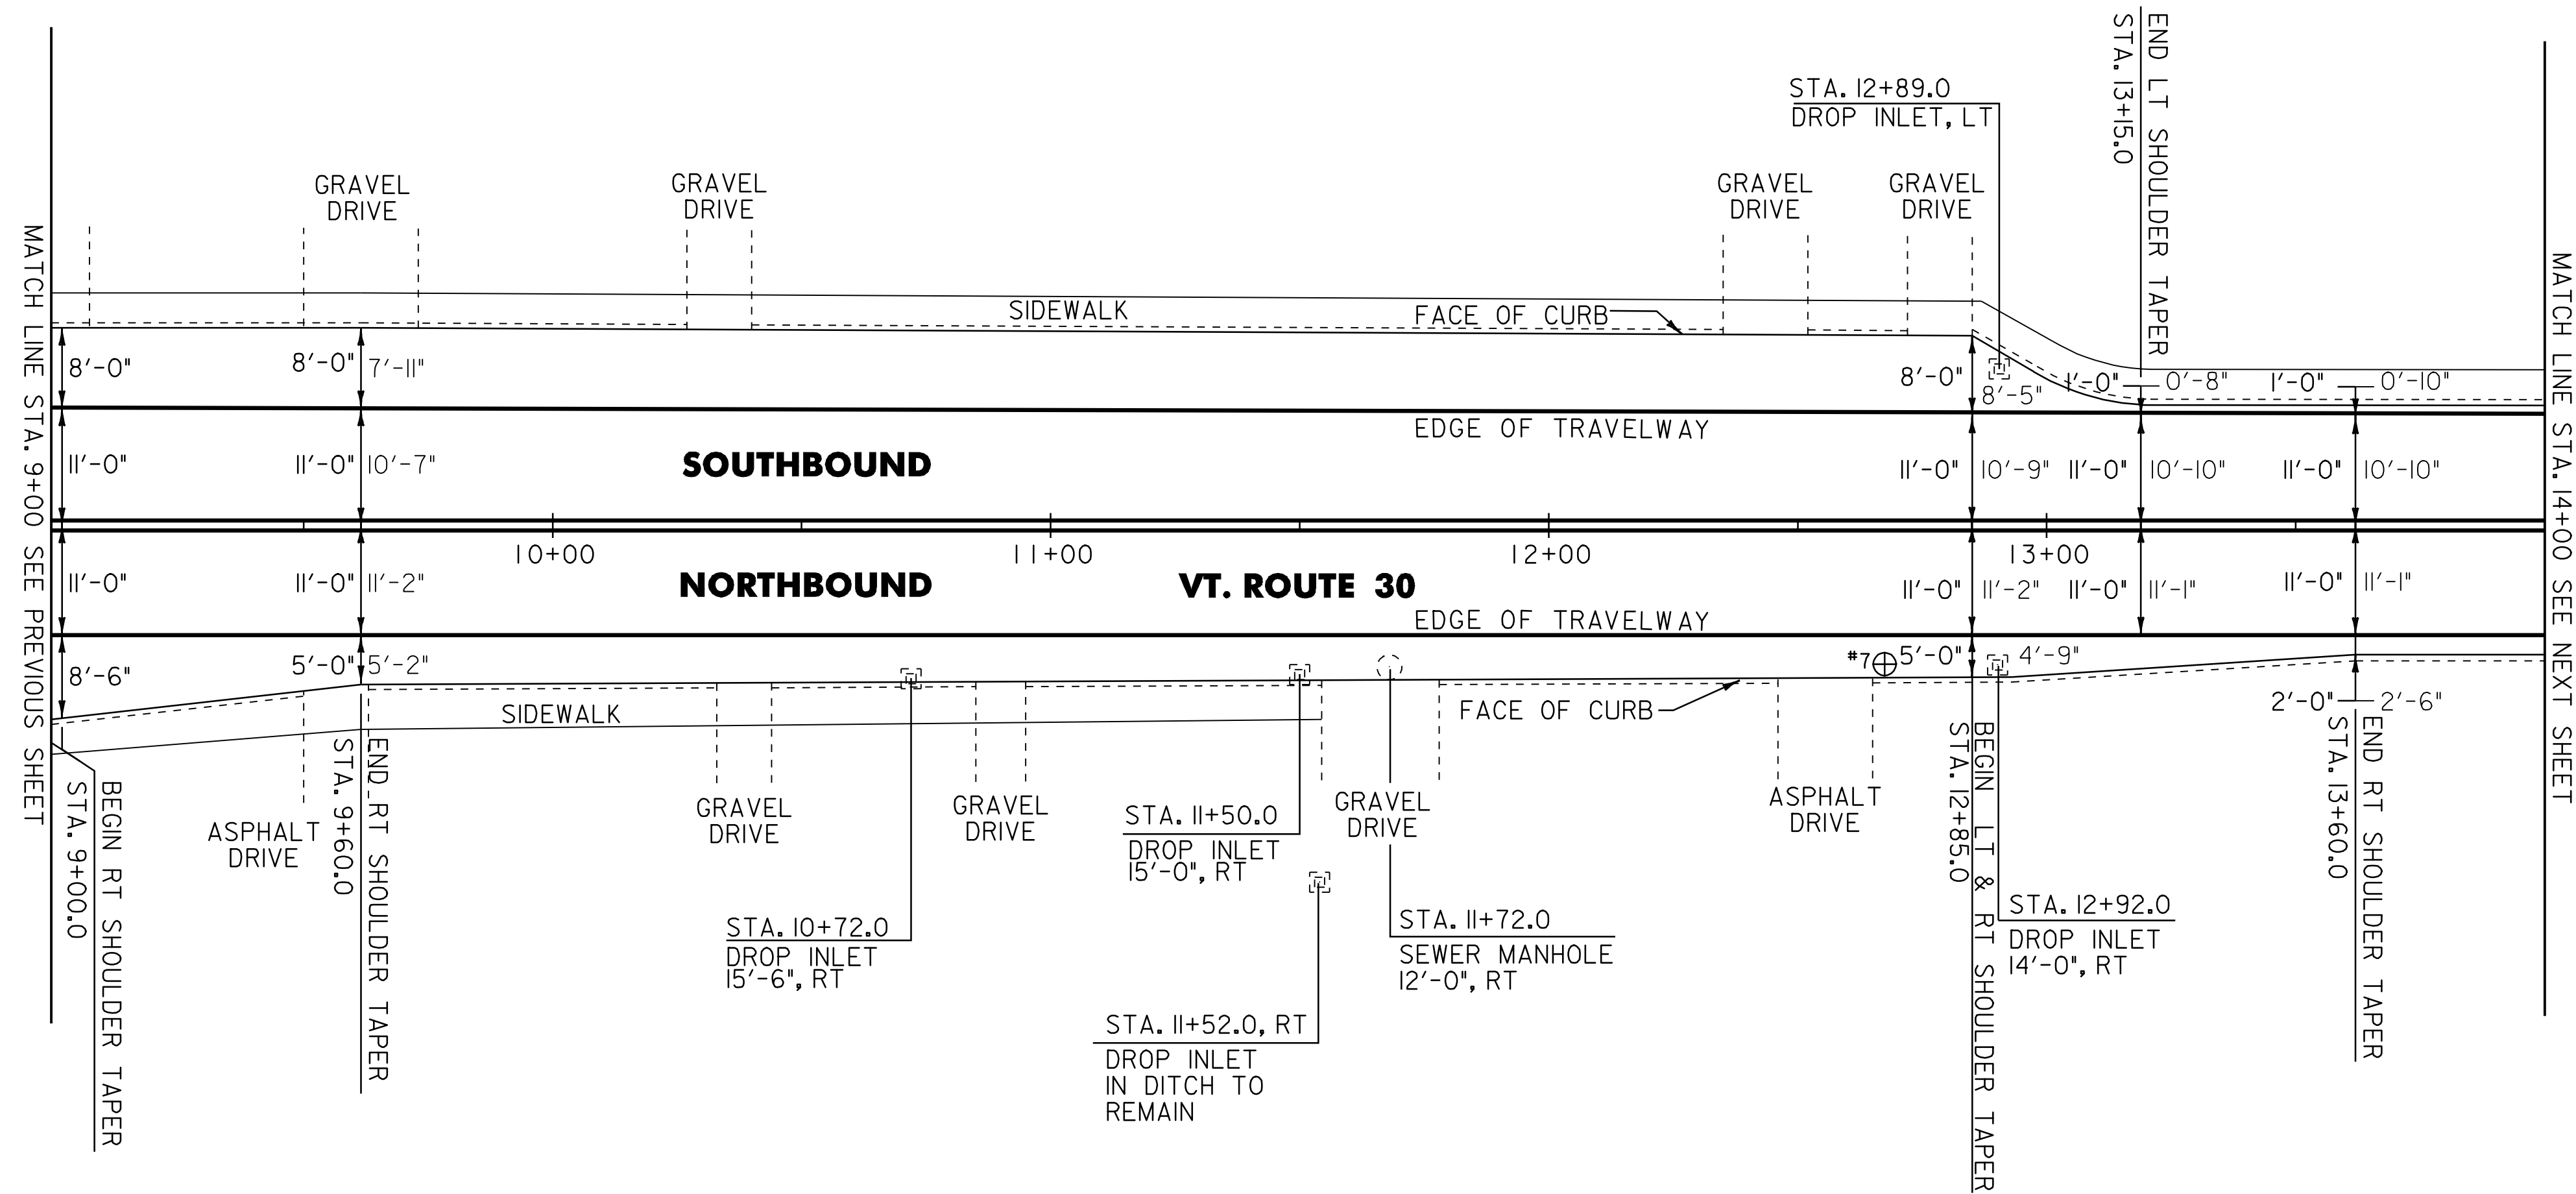

604.40 CHANGING ELEVATION OF DI, CB, OR MH
 VT. ROUTE 30:
 STA. 11+50 RT (0.5 EA)

604.412 REHAB. DROP INLETS, CATCH BASINS, OR MANHOLES, CLASS I
 VT. ROUTE 30:
~~STA. 10+72.0 RT~~
~~STA. 11+50.0 RT~~
~~STA. 12+89.0 LT~~
~~STA. 12+92.0 RT~~

604.42 CHANGING ELEVATION OF SEWER MANHOLES
 VT. ROUTE 30:
~~STA. 11+72.0 RT~~

PAVEMENT CORES = ⊕

#	TOTAL DEPTH (INCH)	PCC	COMMENTS
7	6 1/2	NO	

NOT TO SCALE

PROJECT LAYOUT SHEET #29

PROJECT NAME: MANCHESTER
 PROJECT NUMBER: STP 2203(I)S

FILE NAME: p99c158.dgn
 PROJECT LEADER: D.E.G.
 DESIGNED BY: M.J.M.
 IPARM FILE: p99c158129.1

PLOT DATE: 09-MAY-2008
 DRAWN BY: C.A.K.
 CHECKED BY: D.W.E.
 SHEET 43 OF 68