


SHOULDER WIDENING - COLD PLANE

LOCATION


WILDER STATE HIGHWAY
STA H 0+50 TO H 16+98 LT
STA H 0+85 TO H 14+60 RT

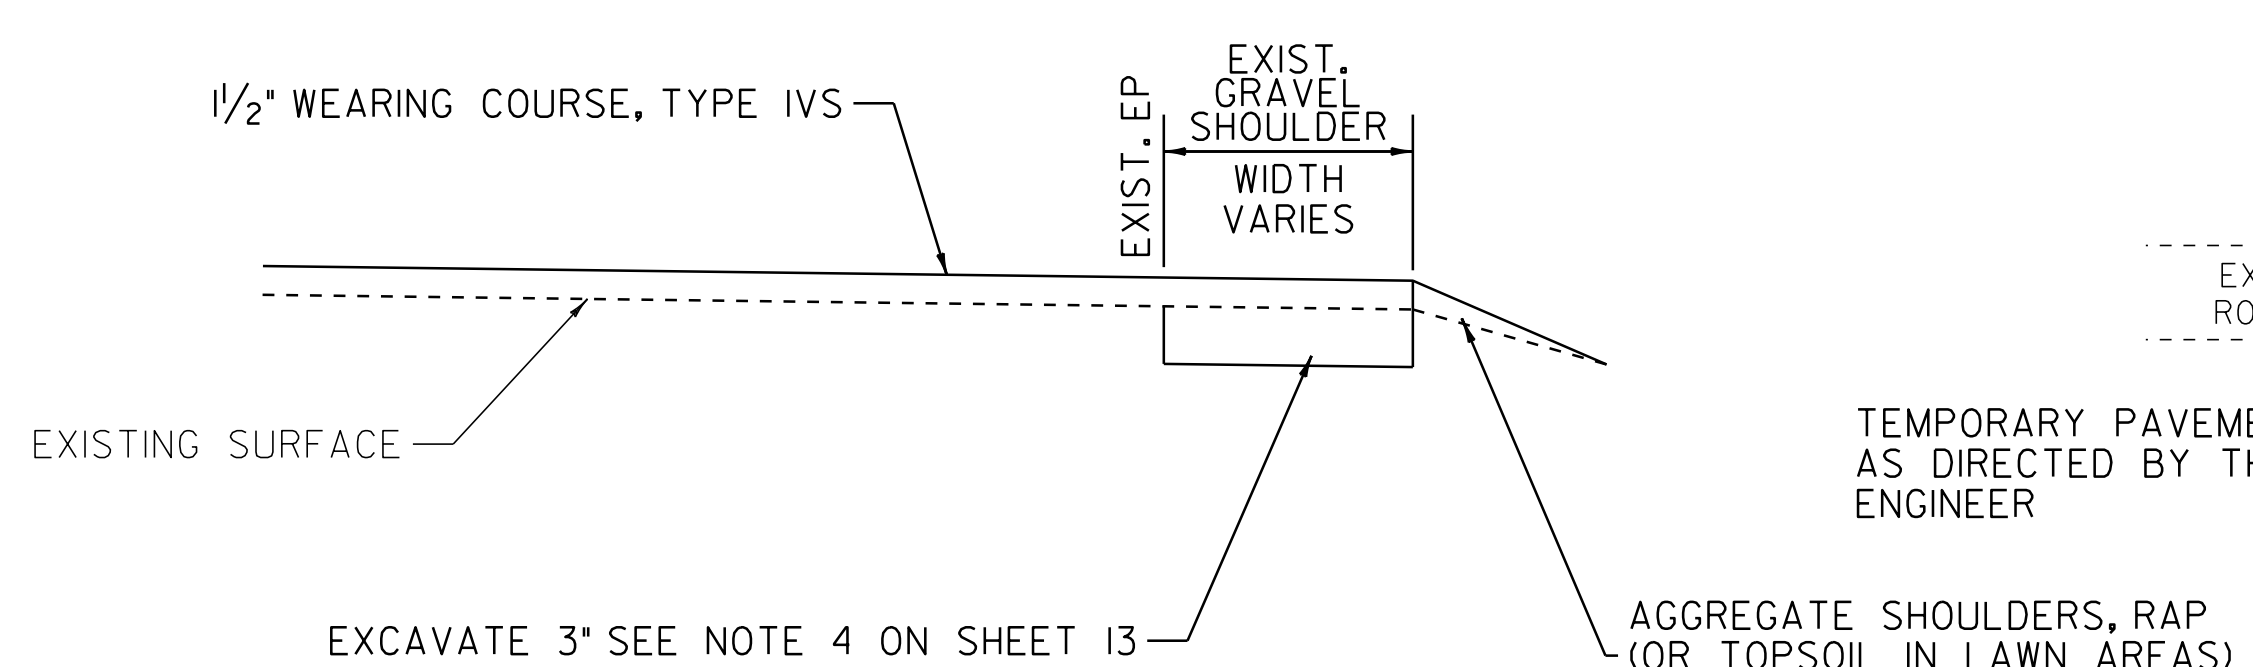

SHOULDER WIDENING - OVERLAY

LOCATION


US ROUTE 5
STA 377+00 TO 395+98 RT
STA 377+61 TO 383+02 LT
STA 383+99 TO 392+13 LT
STA 392+50 TO 398+66 LT
STA 396+76 TO 398+66 RT
STA 0+00 TO 18+97 LT
STA 0+00 TO 19+27 RT

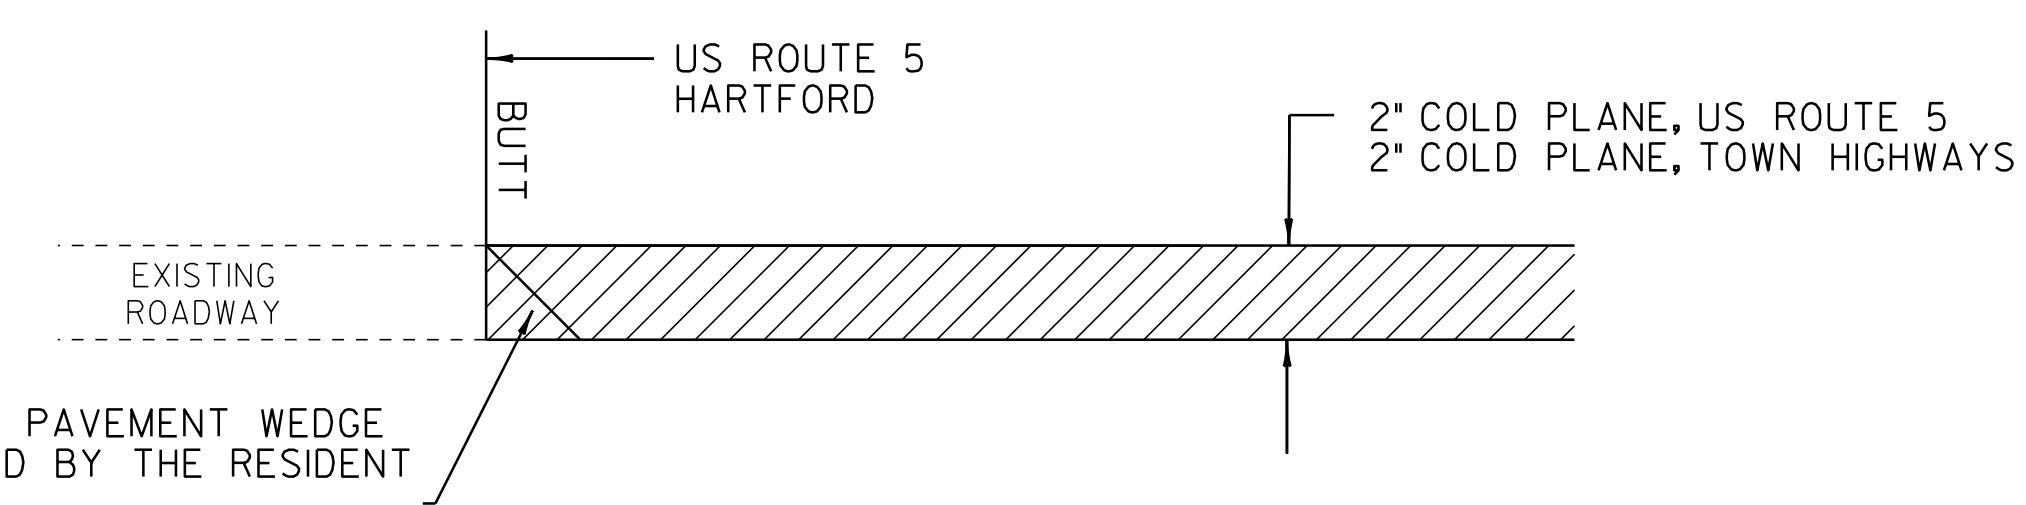

APPROACH AREA DETAIL - BUTT

NOT TO SCALE
LOCATION


STA H 0+13 WSH - BEGIN WILDER STATE HIGHWAY
STA H 38+60 WSH - END COLD PLANING
STA 254+18 US RTE 5 - BEGIN COLD PLANING RAMP AND TOWN HIGHWAYS
STA H 17+09 I-91 RAMP D - END COLD PLANING
STA H 17+17 I-91 RAMP B - END COLD PLANING
STA H 21+90 I-91 RAMP C - END COLD PLANING
STA H 21+89 I-91 RAMP A - END COLD PLANING
STA 271+20 US RTE 5 (TH 252) - END COLD PLANING
STA 279+59 US RTE 5 (TH 33) - END COLD PLANING
STA 280+28 US RTE 5 (TH 91) - END COLD PLANING
STA 288+54 US RTE 5 (TH 123) - END COLD PLANING
STA 293+88 US RTE 5 (TH 90) - END COLD PLANING
STA 295+91 US RTE 5 (TH 90) - END COLD PLANING
STA 297+60 US RTE 5 (TH 32) - END COLD PLANING
STA 297+63 US RTE 5 (TH 31) - END COLD PLANING
STA 301+15 US RTE 5 (TH 88) - END COLD PLANING
STA 301+16 US RTE 5 (TH 88) - END COLD PLANING
STA 304+65 US RTE 5 (TH 87) - END COLD PLANING
STA 304+65 US RTE 5 (TH 87) - END COLD PLANING
STA 307+39 US RTE 5 (TH 86) - END COLD PLANING
STA 307+39 US RTE 5 (TH 86) - END COLD PLANING
STA 310+94 US RTE 5 (TH 83) - END COLD PLANING
STA 314+37 US RTE 5 (TH 29) - END COLD PLANING
STA 317+52 US RTE 5 (TH 30) - END COLD PLANING
STA 318+96 US RTE 5 (COLONIAL DR) - END COLD PLANING
STA 332+54 US RTE 5 (TH 143) - END COLD PLANING

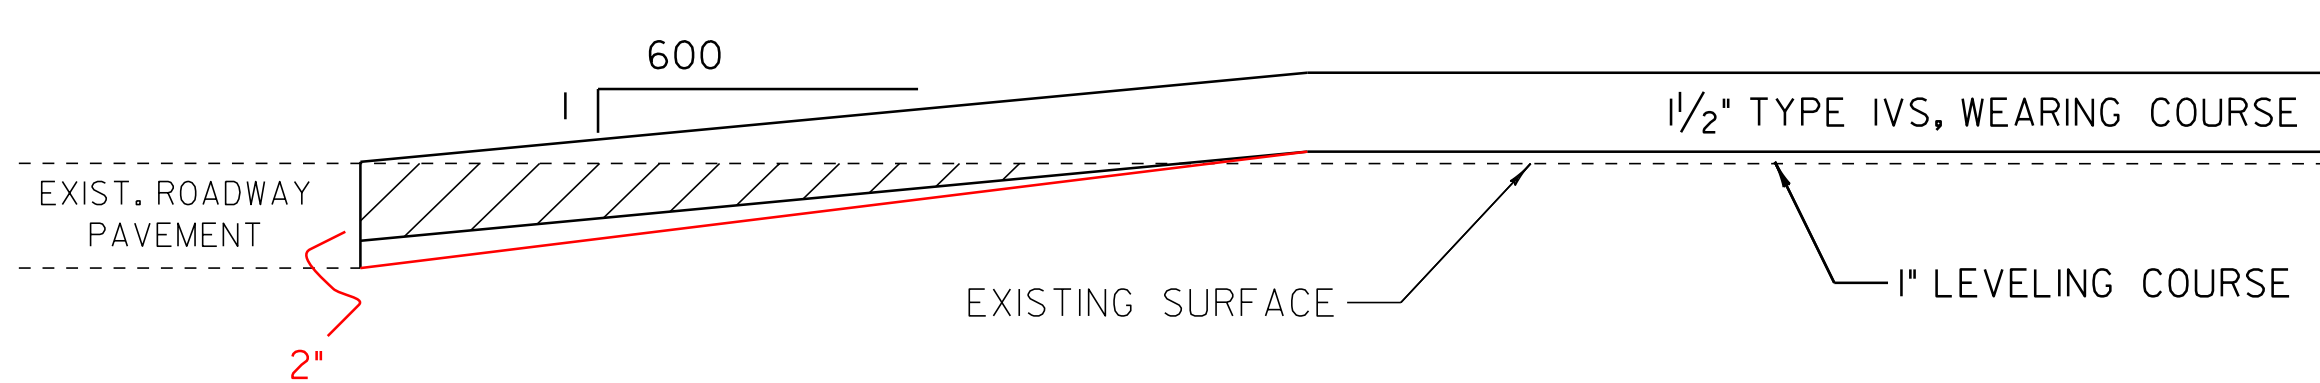

APPROACH AREA DETAIL - TAPER

NOT TO SCALE
LOCATION


HARTFORD
US 5 STA 343+20 TO 343+95 - RESUME OVERLAY
NORWICH
US 5 STA 40+95 TO 41+70 - END OVERLAY

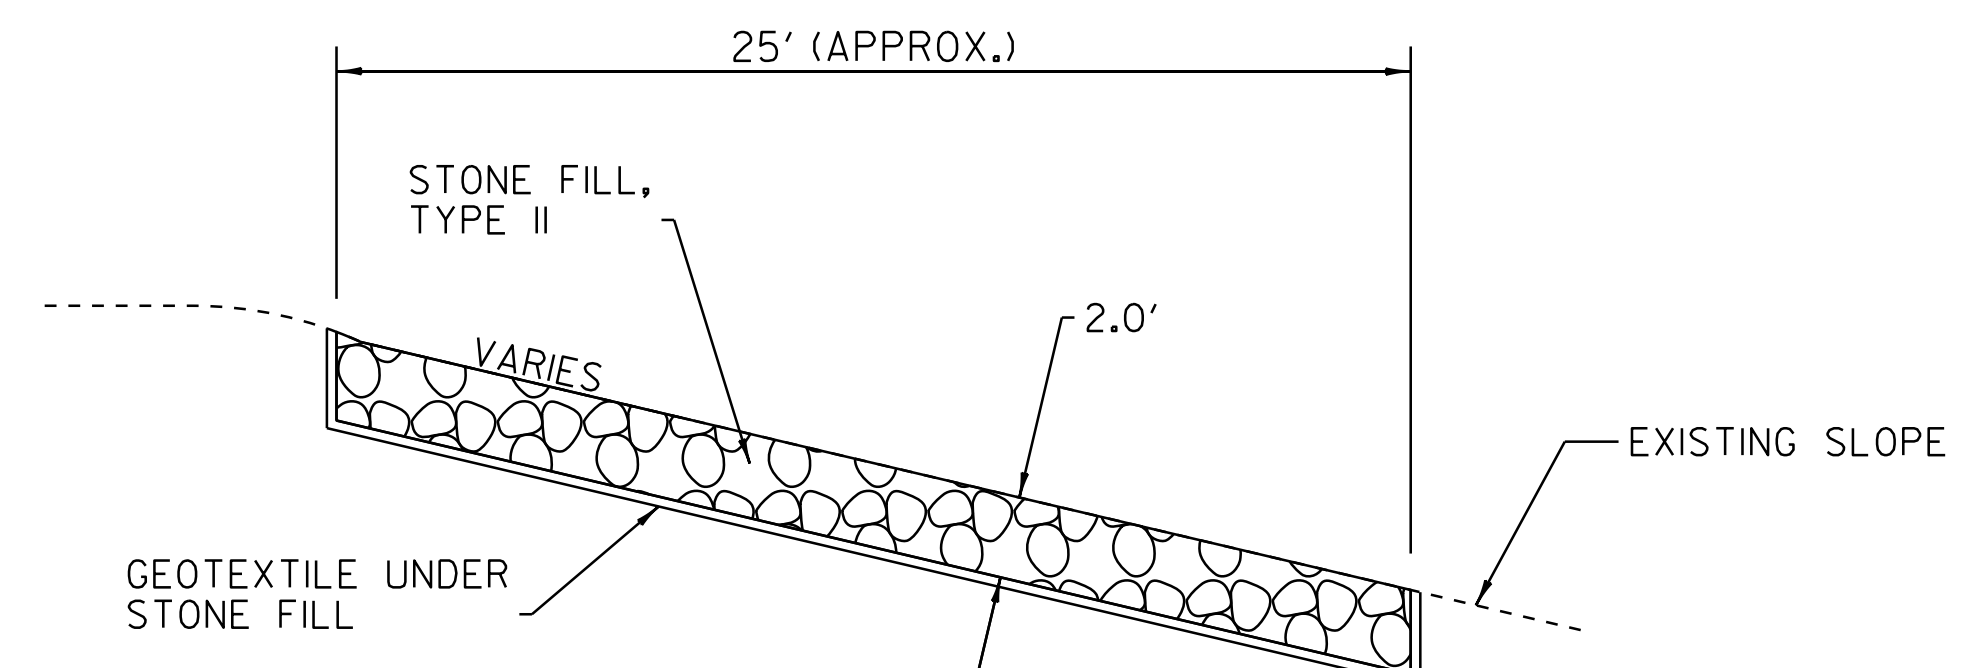

STONE FILL DETAIL

LOCATION


WILDER STATE HIGHWAY
H 32+70 TO H 33+04 RT

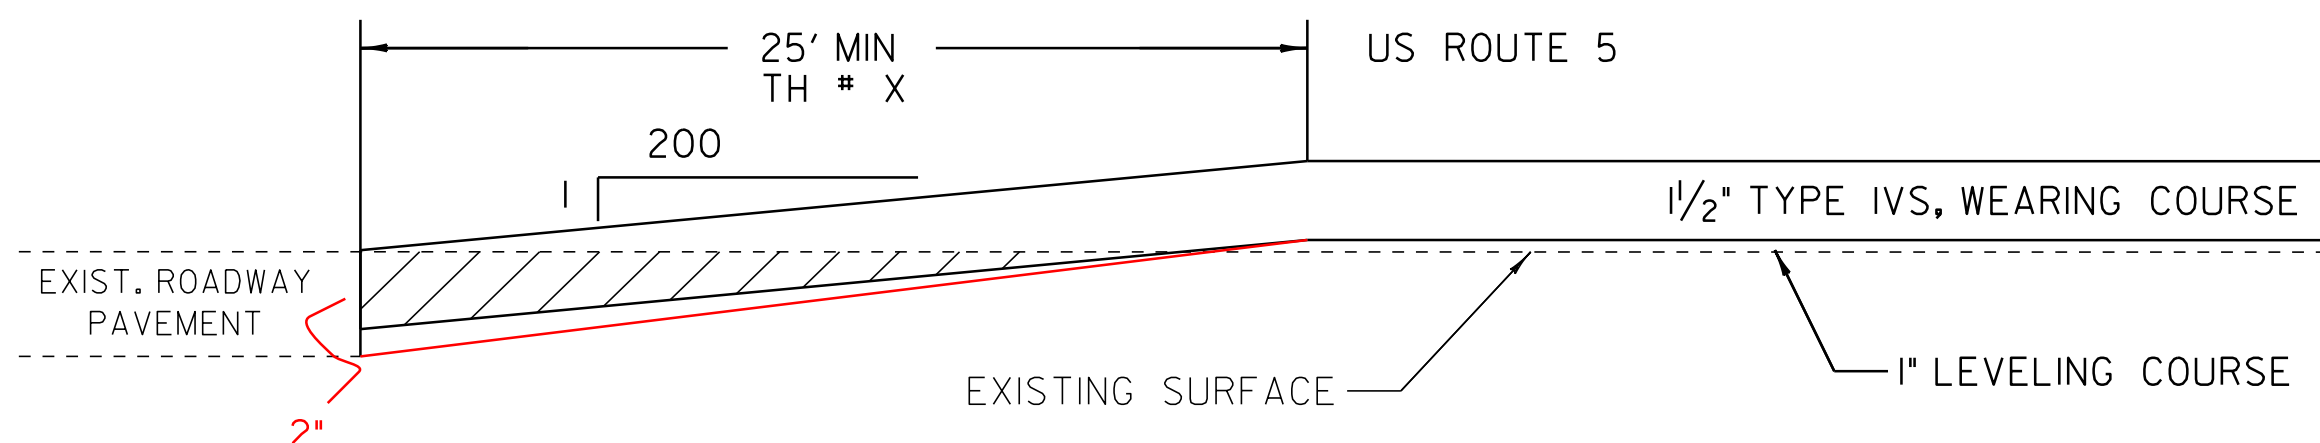

APPROACH AREA DETAIL - TAPER

NOT TO SCALE
LOCATION


TOWN HIGHWAYS
TH 9 STA 360+44 LT
TH 285 STA 364+30 RT
SCHOOL STA 372+56 LT
TH 18 STA 377+48 LT
TH 287 STA 383+51 LT
TH 286 STA 392+31 LT
TH 270 STA 396+41 RT
TH 58 STA 19+19 LT
TH 83 STA 38+10 RT

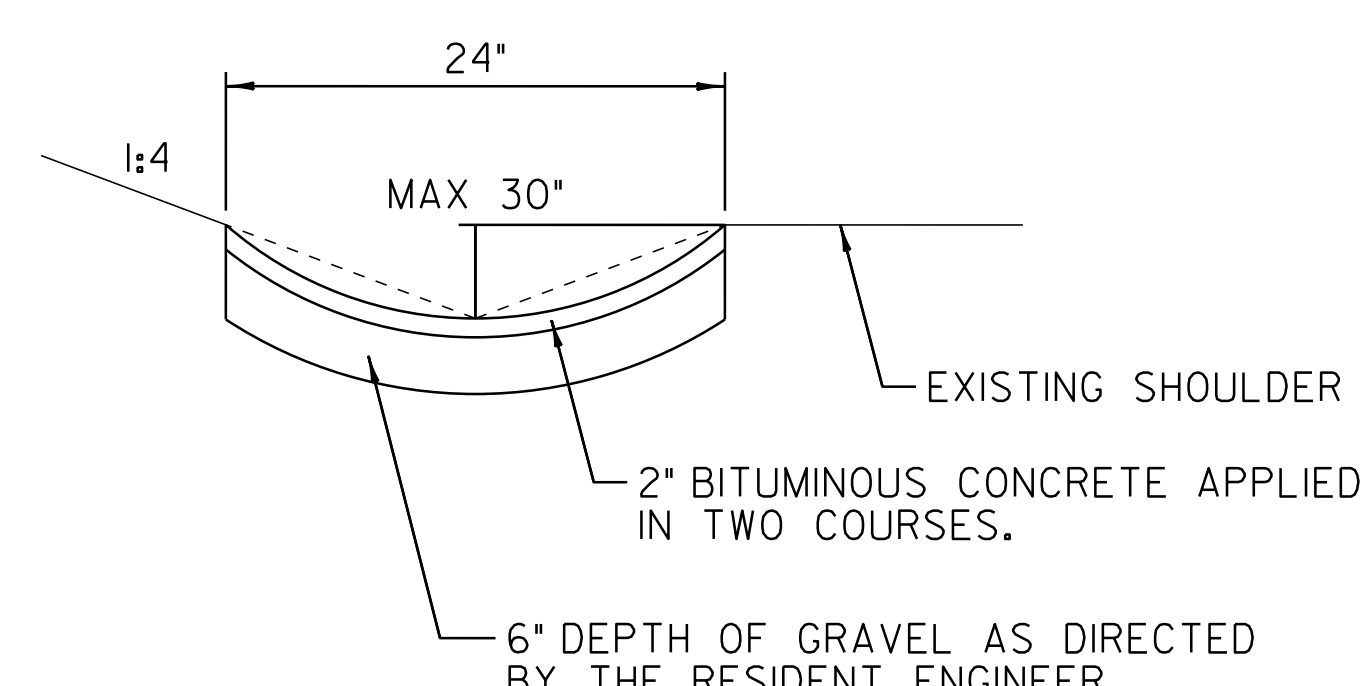

BITUMINOUS CONCRETE GUTTERS AND TRAFFIC ISLANDS

NOT TO SCALE
LOCATION

US ROUTE 5
STA 271+43 TO 272+28 LT
STA 301+40 TO 301+96 RT
STA 352+30 TO 353+67 RT

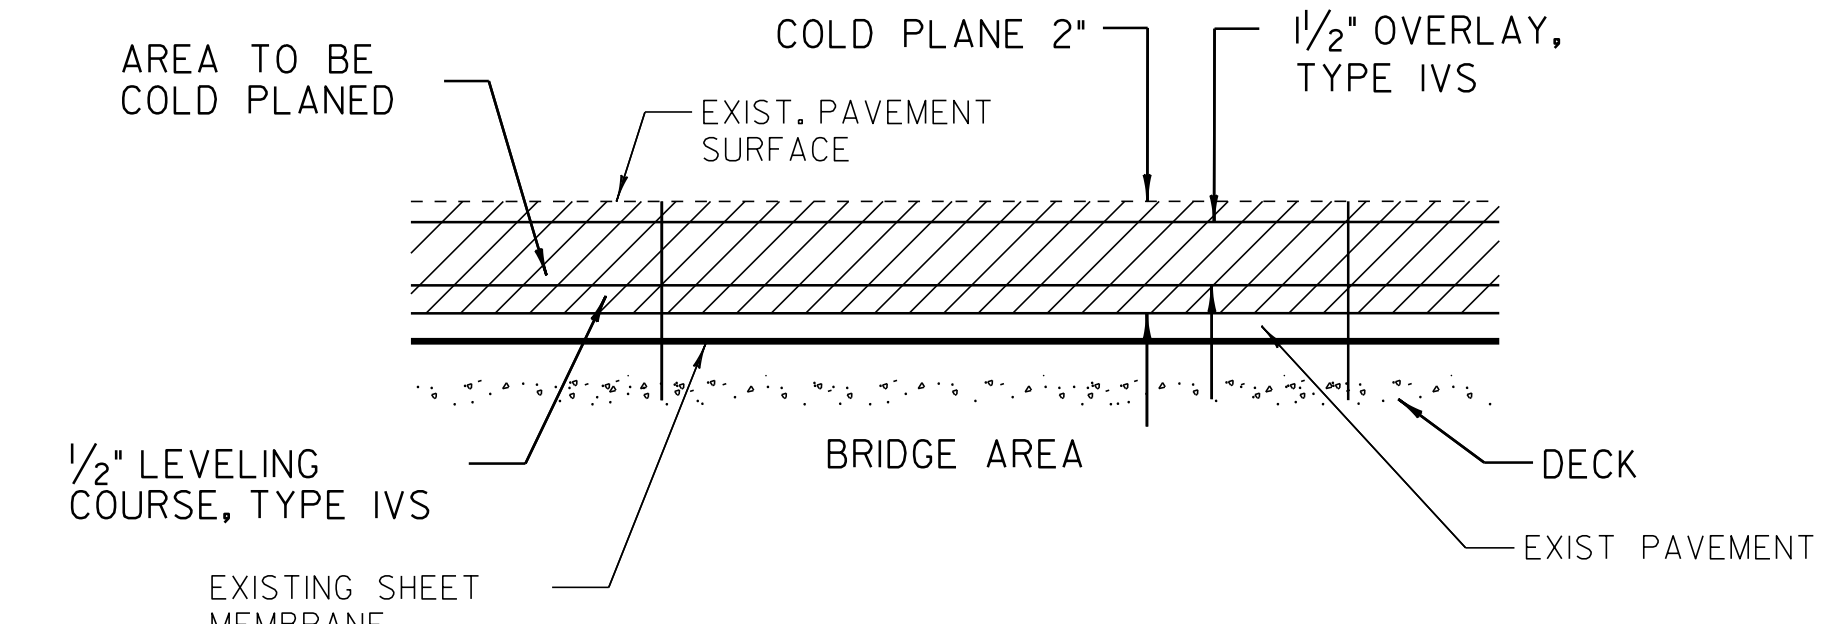

BRIDGE COLD PLANE DETAIL

LOCATION

BRIDGE #75 STA 332+86 TO STA 333+29

PROJECT TYPICAL SHEET 2

PROJECT NAME: HARTFORD-NORWICH	PLOT DATE: 14-FEB-2012 15:49
PROJECT NUMBER: STP 2206(I)S	DRAWN BY: MRS
FILE NAME: /pave/99cl64/pci64	CHECKED BY: NLL
PROJECT LEADER: PTS	SHEET 14 OF 137
DESIGNED BY: NLL	
IPARM FILE NAME: pci64+y02.i	