

TEMPORARY 4" WHITE LINE, PAINT  
 DURABLE 4" WHITE LINE, THERMOPLASTIC  
 STA H 0+01 TO H 3+00 SOLID LT  
 STA H 0+34 TO H 3+00 SOLID RT

TEMPORARY 4" YELLOW LINE, PAINT  
 DURABLE 4" YELLOW LINE, THERMOPLASTIC  
 STA H 0+18 TO H 3+00 SOLID LT & RT

TEMPORARY LETTER OR SYMBOL, PAINT  
 DURABLE LETTER OR SYMBOL, THERMOPLASTIC  
 STA H 0+26 LT - "STOP"


TEMPORARY 24" STOP BAR, PAINT  
 DURABLE 24" STOP BAR, THERMOPLASTIC  
 STA H 0+18 LT

CHANGING ELEVATION  
 OF SEWER MANHOLES (NON PART.)  
 STA H 0+10 LT

REMOVING SIGNS  
 AS SHOWN - 1

ERECTING SALVAGED SIGNS  
 AS SHOWN - 1

**BEGIN STP 2206(1)S  
 WILDER STATE HIGHWAY  
 STA H 0+00.00  
 (MM 0.000)  
 BEGIN COLD PLANE  
 AND OVERLAY**

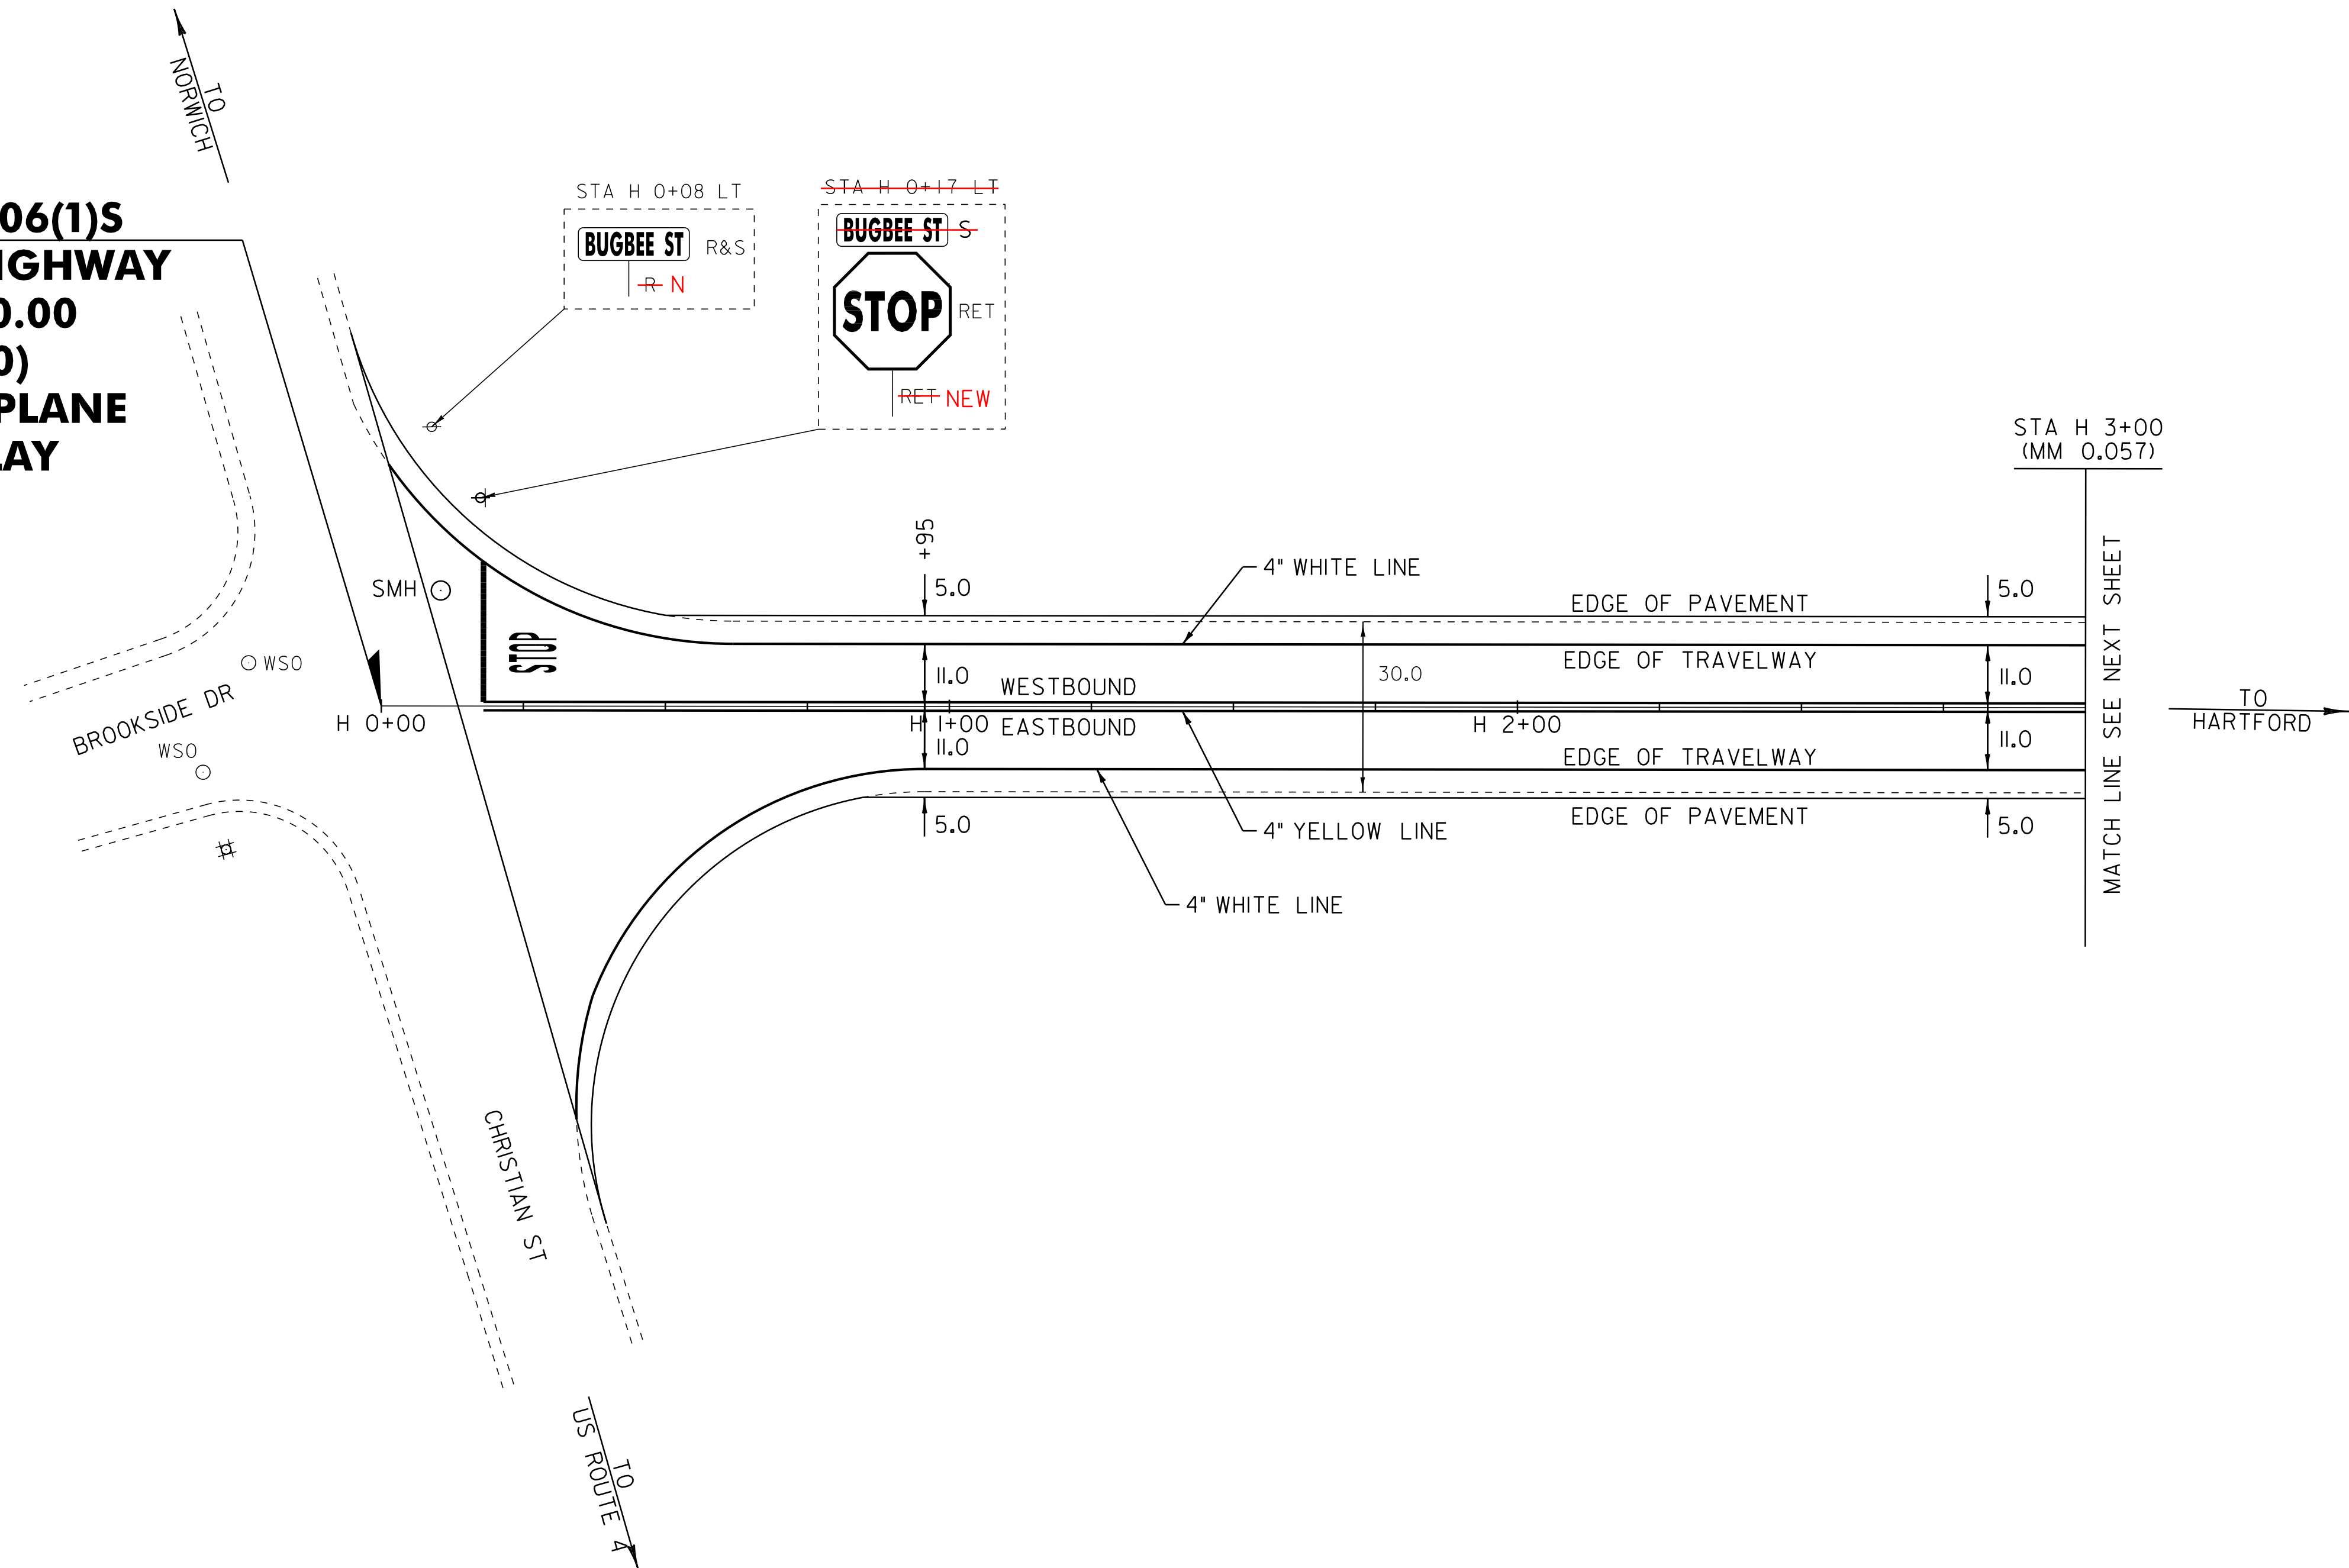

**LEGEND**

- R = REMOVE EXISTING
- S = SALVAGE
- R&S = REMOVE AND SALVAGE
- N = NEW
- RET = RETAIN
- B-B = BACK TO BACK
- — — = EXISTING GUARDRAIL
- — — = PROPOSED GUARDRAIL
- ∩ = TYPE I DELINEATOR, WHITE

NOT TO SCALE

<b>PAVING LAYOUT 1</b>	PROJECT NAME: HARTFORD-NORWICH	
	PROJECT NUMBER: STP 2206(1)S	
	FILE NAME: /pave/99c164/pcl64	PLOT DATE: 14-FEB-2012 15:49
	PROJECT LEADER: PTS	DRAWN BY: MRS
DESIGNED BY: NULL	CHECKED BY: NULL	
IPARM FILE NAME: pcl64la01.i		SHEET 25 OF 137