

TEMPORARY 4" WHITE LINE, PAINT
 DURABLE 4" WHITE LINE, THERMOPLASTIC
 STA H 8+50 TO H 14+00 SOLID LT & RT

TEMPORARY 4" YELLOW LINE, PAINT
 DURABLE 4" YELLOW LINE, THERMOPLASTIC
 STA H 8+50 TO H 14+00 SOLID LT & RT


REMOVAL AND DISPOSAL OF GUARDRAIL
 STA H 10+88.0 TO H 14+00.0 LT

STEEL BEAM GUARDRAIL, GALVANIZED W/8' POSTS
 STA H ~~11+25.5~~ TO H 14+00.0 LT
 10+82.5

MANUFACTURED TERMINAL SECTION, FLARED
 DELINEATOR WITH STEEL POST
~~STA H 10+88.0 LT~~
 STA 10+45 LT

BITUMINOUS CONCRETE CURB, TYPE A
 STA H 11+~~50~~ TO H 14+00 LT
 22

NOTE:
 1. H 11+90 TO H 14+00 LT
 LEVEL SHOULDER WITH 2" TYPE IVS
 PRIOR TO ROADWAY LEVELING.

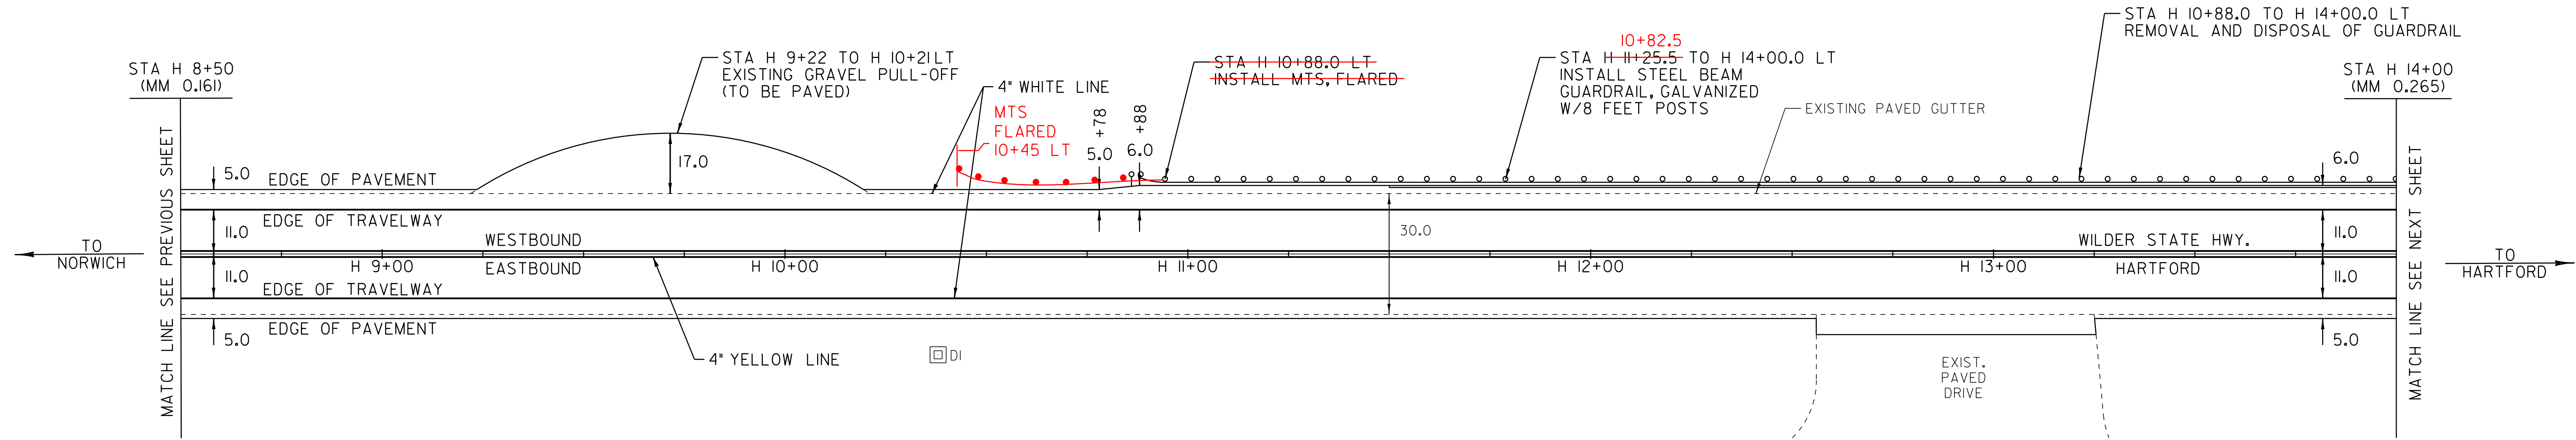

LEGEND

- R = REMOVE EXISTING
- S = SALVAGE
- R&S = REMOVE AND SALVAGE
- N = NEW
- RET = RETAIN
- B-B = BACK TO BACK
- — — = EXISTING GUARDRAIL
- — — = PROPOSED GUARDRAIL
- ∩ = TYPE I DELINEATOR, WHITE

PAVING LAYOUT 3	PROJECT NAME: HARTFORD-NORWICH	
	PROJECT NUMBER: STP 2206(1)S	
	FILE NAME: /pave/99cl64/pci64	PLOT DATE: 14-FEB-2012 15:49
	PROJECT LEADER: PTS	DRAWN BY: MRS
DESIGNED BY: NULL	CHECKED BY: NULL	
IPARM FILE NAME: pci64la03.1		SHEET 27 OF 137

NOT TO SCALE