

TEMPORARY 4" WHITE LINE, PAINT  
 DURABLE 4" WHITE LINE, THERMOPLASTIC  
 STA H 34+50 TO H 37+50 SOLID LT & RT

TEMPORARY 4" YELLOW LINE, PAINT  
 DURABLE 4" YELLOW LINE, THERMOPLASTIC  
 STA H 34+50 TO H 36+35 SOLID LT & RT  
 STA H 36+35 TO H 37+50 DOUBLE SOLID LT & RT

DURABLE 8" YELLOW LINE, THERMOPLASTIC  
 STA H 36+35 TO H 37+50 SOLID LT & RT (GORE)

REMOVAL AND DISPOSAL OF GUARDRAIL  
 STA H ~~36+28.0~~ TO H 37+50.0 RT  
 35+63


STEEL BEAM GUARDRAIL, GALVANIZED  
 STA H ~~36+28.0~~ TO H 37+50.0 RT  
 35+63

CHANGE ELEV  
~~REHAB DROP~~ INLETS, CATCH BASINS,  
 OR MANHOLES, CLASS I, CLASS II OR CLASS III  
 STA H 37+32 LT (DI)

~~STONE FILL, TYPE I~~  
~~STA H 35+00 LT~~  
~~STA H 36+28 RT~~  
~~STA H 36+46 LT~~

BITUMINOUS CONCRETE CURB, TYPE A  
 STA 36+30 TO 37+50 RT  
 28

SHOULDER BERM REMOVAL 10  
 STA H 34+50 TO H 37+30 LT  
 STA H 34+50 TO H 36+25 RT  
 28

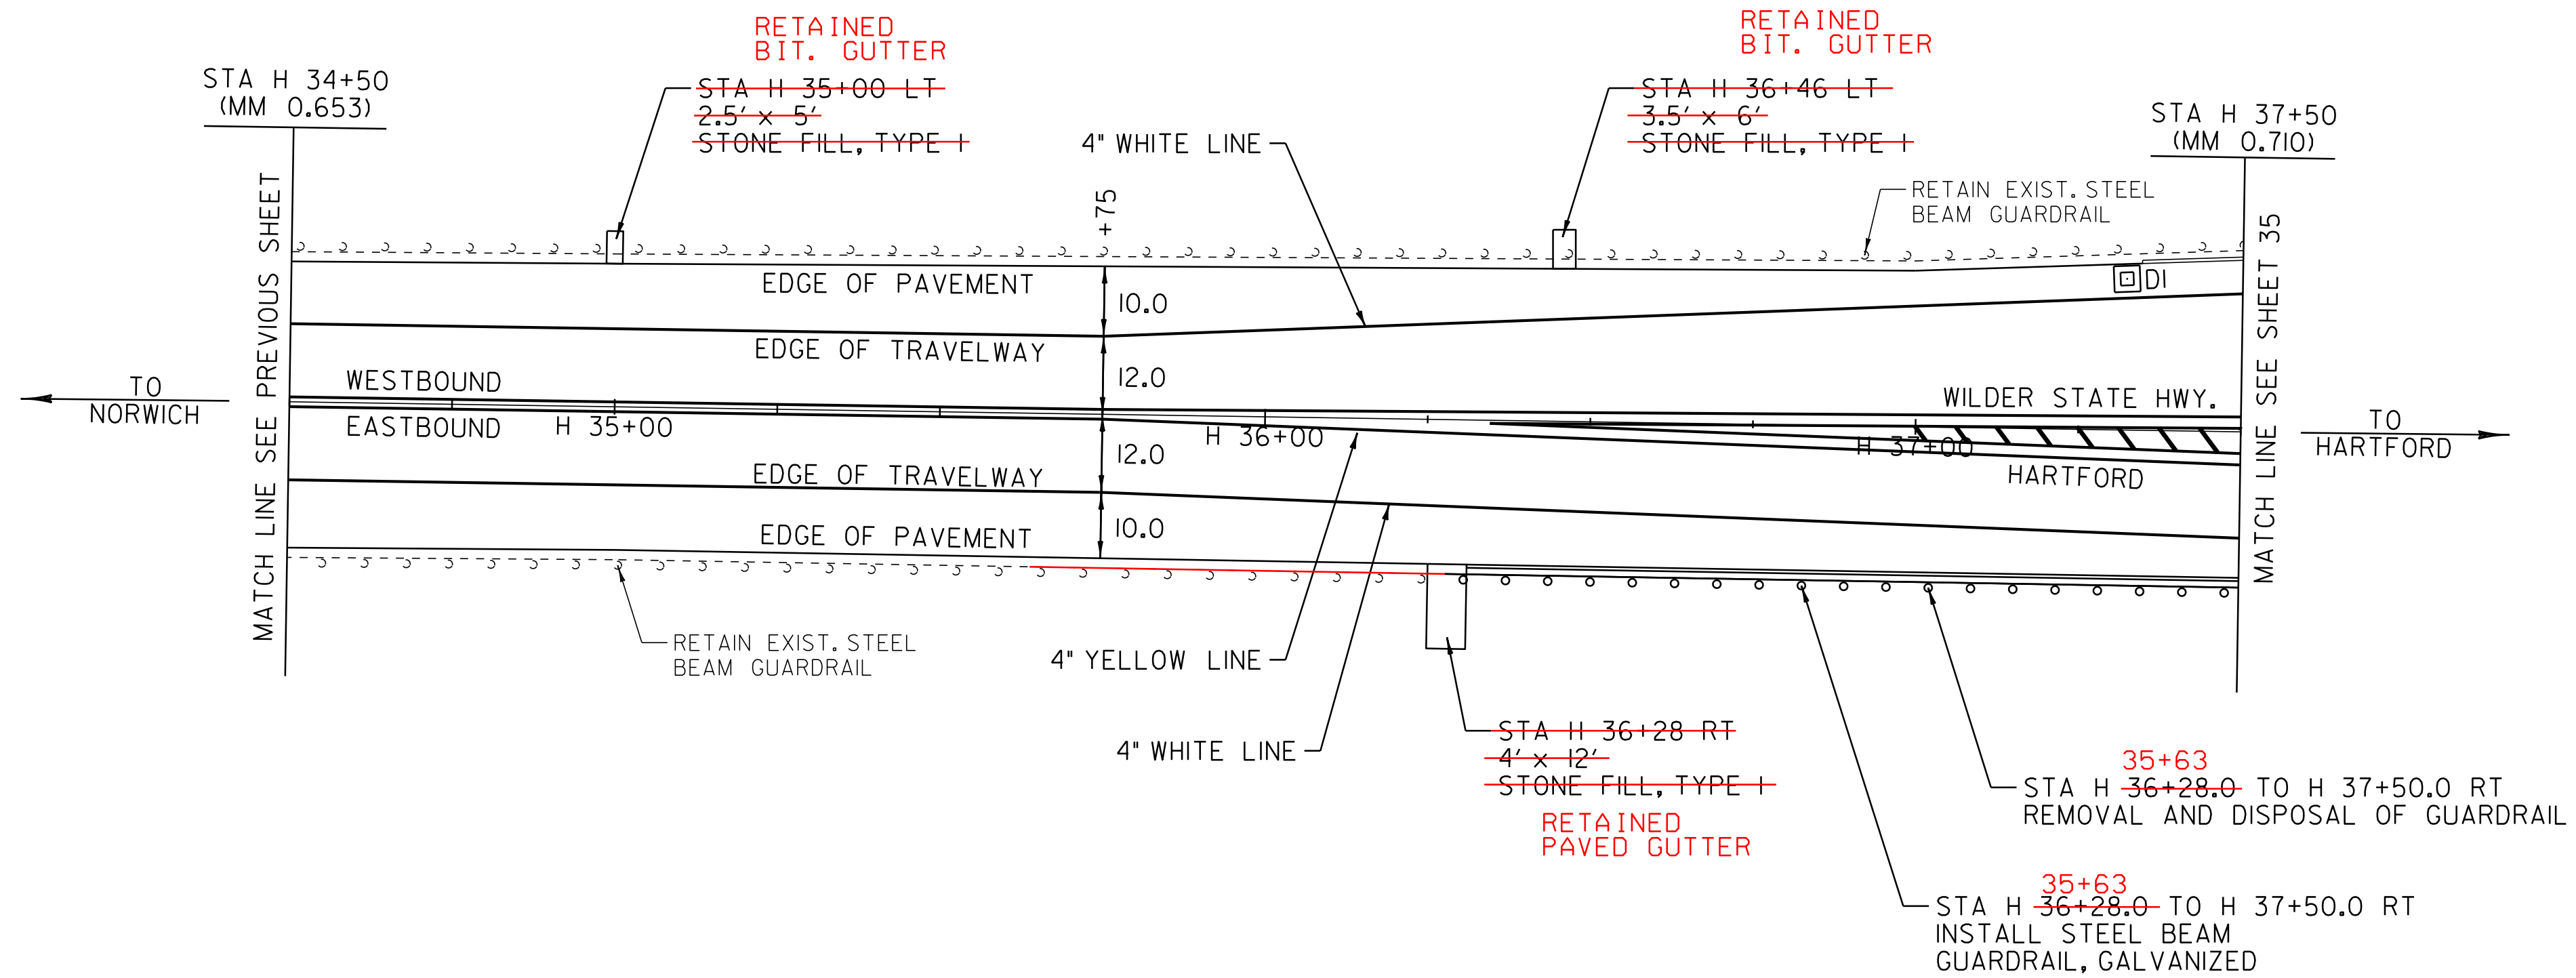

LEGEND

- R = REMOVE EXISTING
- S = SALVAGE
- R&S = REMOVE AND SALVAGE
- N = NEW
- RET = RETAIN
- B-B = BACK TO BACK
- = EXISTING GUARDRAIL
- = PROPOSED GUARDRAIL
- ∩ = TYPE I DELINEATOR, WHITE

NOT TO SCALE

<b>PAVING LAYOUT SHEET 8</b>	PROJECT NAME: HARTFORD-NORWICH	PLOT DATE: 14-FEB-2012 15:50
	PROJECT NUMBER: STP 2206(I)S	DRAWN BY: MRS
	FILE NAME: /pave/99cl64/pcl64	CHECKED BY: NULL
	DESIGNED BY: NULL	SHEET 32 OF 137