


~~TEMPORARY 4" WHITE LINE, PAINT~~
~~DURABLE 4" WHITE LINE, THERMOPLASTIC~~
~~STA 254+18 TO 255+00 SOLID LT & RT~~

~~TEMPORARY 4" YELLOW LINE, PAINT~~
~~DURABLE 4" YELLOW LINE, THERMOPLASTIC~~
~~STA 254+18 TO 254+62 SOLID LT & RT~~
~~STA 254+62 TO 255+00 DOUBLE SOLID LT & RT~~

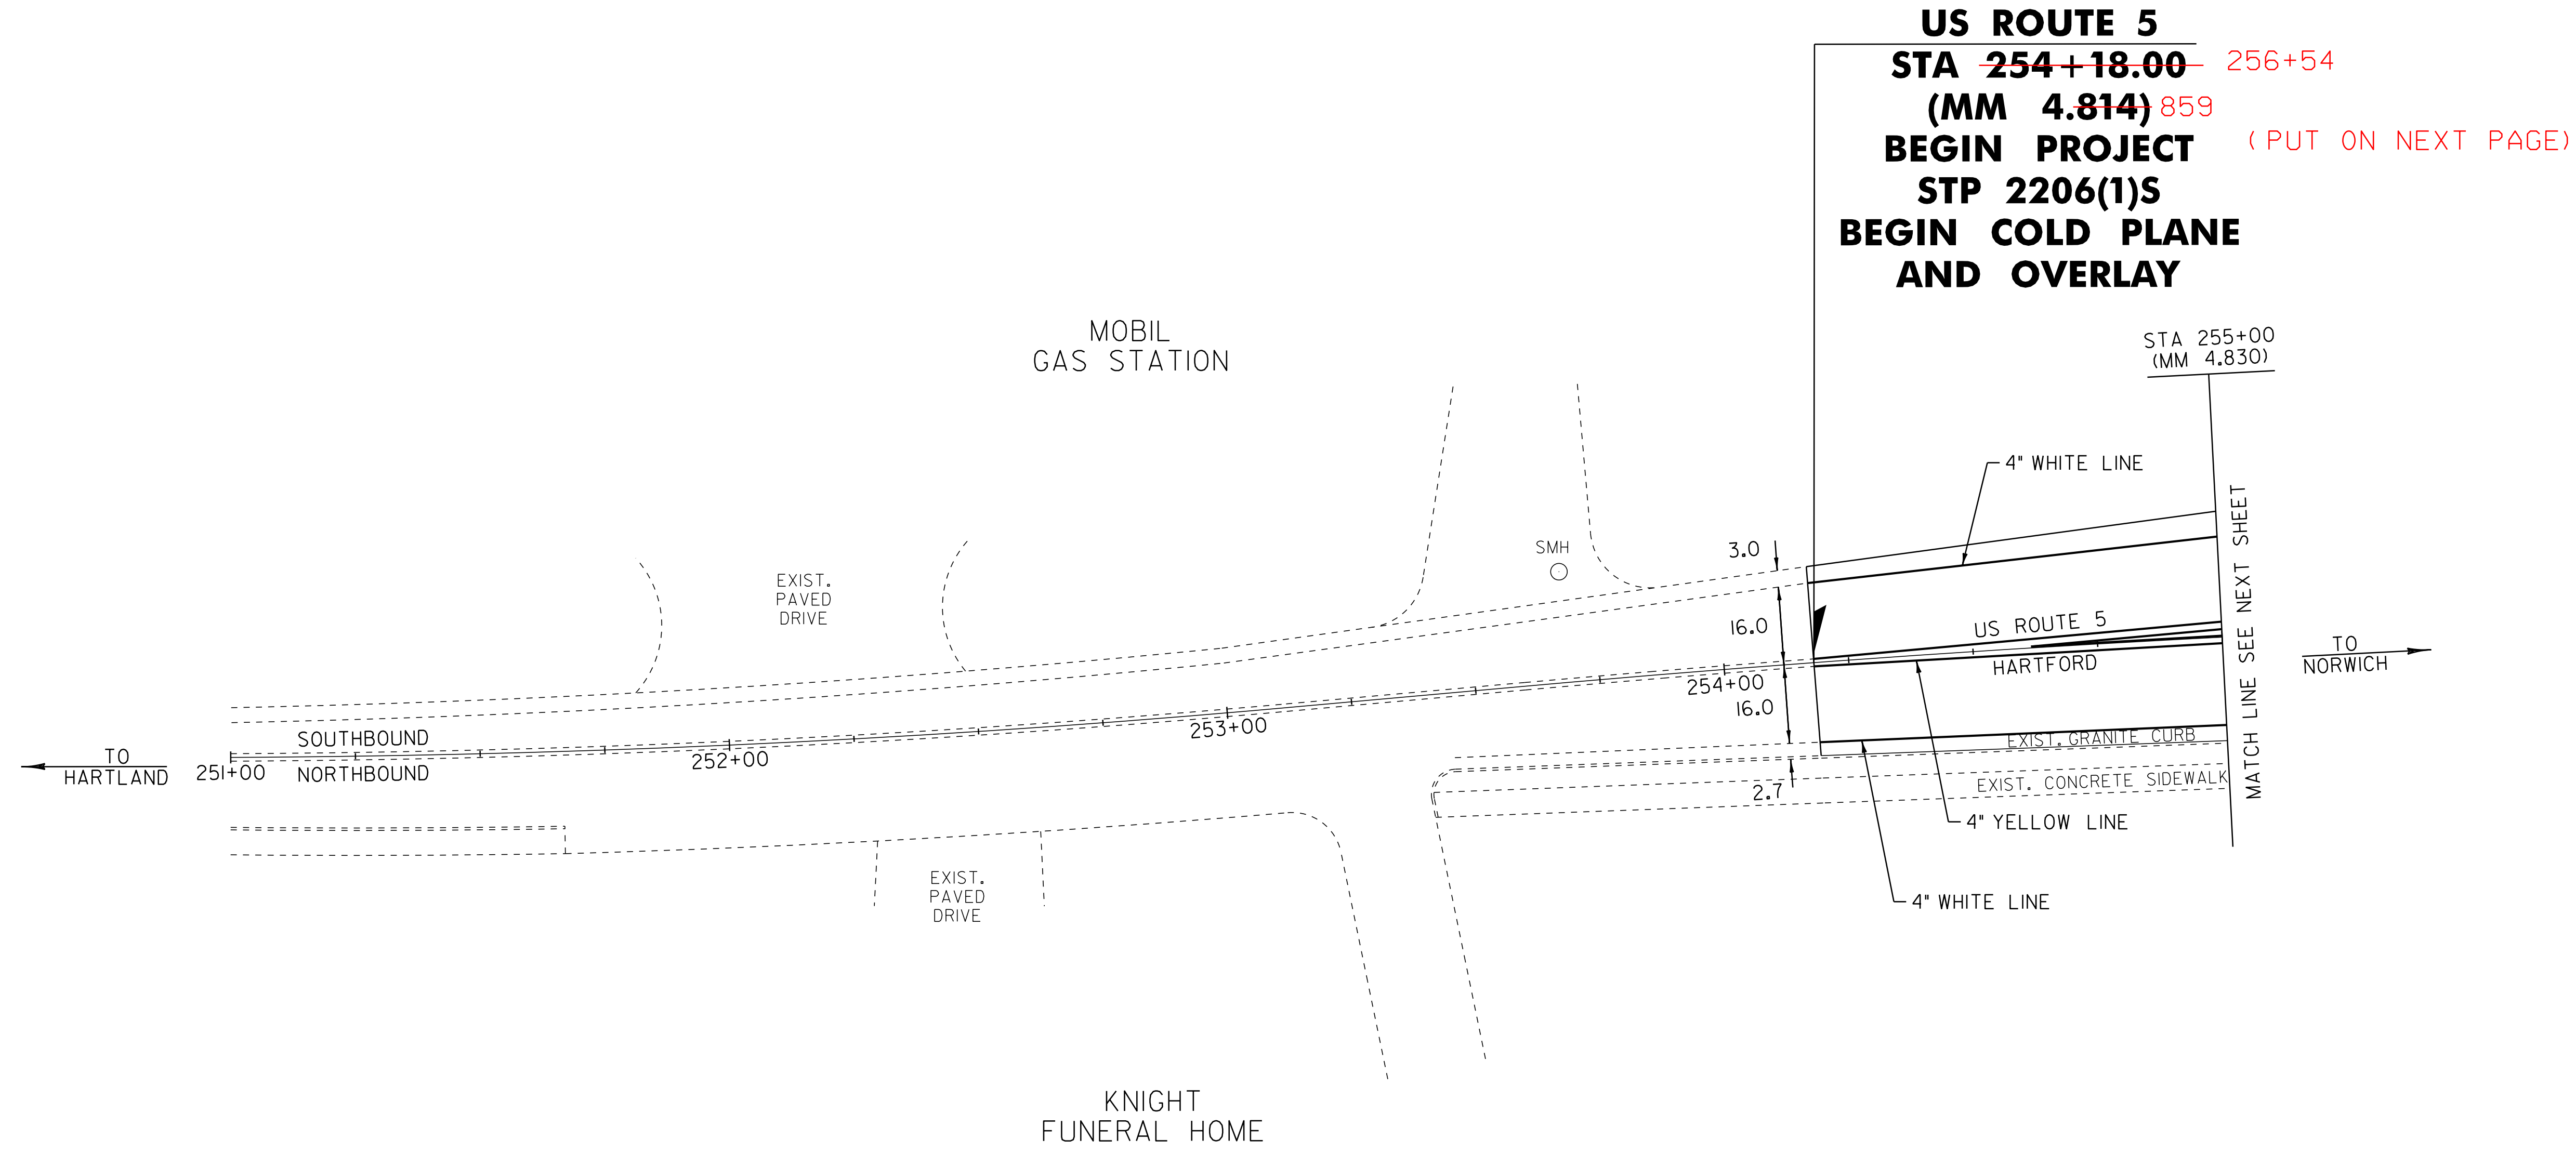

US ROUTE 5
~~STA 254+18.00~~ 256+54
 (MM 4.814) 859
BEGIN PROJECT (PUT ON NEXT PAGE)
STP 2206(1)S
BEGIN COLD PLANE AND OVERLAY

LEGEND

- R = REMOVE EXISTING
- S = SALVAGE
- R&S = REMOVE AND SALVAGE
- N = NEW
- RET = RETAIN
- B-B = BACK TO BACK
- — — = EXISTING GUARDRAIL
- — — = PROPOSED GUARDRAIL
- ∩ = TYPE I DELINEATOR, WHITE

NOT TO SCALE

PAVING LAYOUT SHEET 9	PROJECT NAME: HARTFORD-NORWICH	PLOT DATE: 14-FEB-2012 15:50
	PROJECT NUMBER: STP 2206(1)S	DRAWN BY: MRS
	DESIGNED BY: NULL	CHECKED BY: NULL
	IPARM FILE NAME: pci64la09.i	SHEET 33 OF 137