

TEMPORARY 4" WHITE LINE, PAINT  
 DURABLE 4" WHITE LINE, THERMOPLASTIC  
 256+54 STA ~~255+00~~ TO 259+50 SOLID LT & RT  
 STA 256+60 TO 259+50 DASHED LT  
 STA 257+32 TO 258+75 DOTTED RT  
 STA 257+50 TO 259+50 DASHED RT  
 STA 258+75 TO 259+50 SOLID RT LANE LINE

TEMPORARY 4" YELLOW LINE, PAINT  
 DURABLE 4" YELLOW LINE, THERMOPLASTIC  
 256+54 STA ~~255+00~~ TO 256+57 DOUBLE SOLID LT  
 256+54 STA ~~255+00~~ TO 256+70 DOUBLE SOLID RT  
 STA 256+57 TO 259+50 SOLID LT ( ISLAND)  
 STA 256+70 TO 259+50 SOLID LT ( ISLAND)

~~DURABLE 8" YELLOW LINE, THERMOPLASTIC~~  
~~STA 255+00 TO 256+56 SOLID LT (GORE)~~

TEMPORARY LETTER OR SYMBOL, PAINT  
 STA 259+25 LT - LEFT TURN ARROW

DURABLE LETTER OR SYMBOL, THERMOPLASTIC  
 STA 258+79 LT - " ONLY"  
 STA 259+25 LT - LEFT TURN ARROW

PAINTED CURB  
 STA 256+57 TO 256+87 LT ( ISLAND)  
 STA 256+57 TO 256+87 LT ( ISLAND)  
 STA 258+45 TO 259+05 LT ( ISLAND)

REMOVAL AND DISPOSAL OF GUARDRAIL  
 STA 258+00.0 TO 259+50.0 LT



STEEL BEAM GUARDRAIL, GALVANIZED  
 STA 257+98.0 TO 259+50.0 LT

ANCHOR FOR STEEL BEAM RAIL  
 STA 257+98.0 LT

REHAB DROP INLETS, CATCH BASINS  
 OR MANHOLES, CLASS I, CLASS II OR CLASS III  
 STA 256+04 RT ( CB)  
 STA 257+89 RT ( CB)  
 STA 259+14 LT ( CB)

ADJUST ELEVATION  
 OF VALVE BOX (NON PART.)  
 STA 257+87 RT

REMOVING SIGNS  
 AS SHOWN - 3

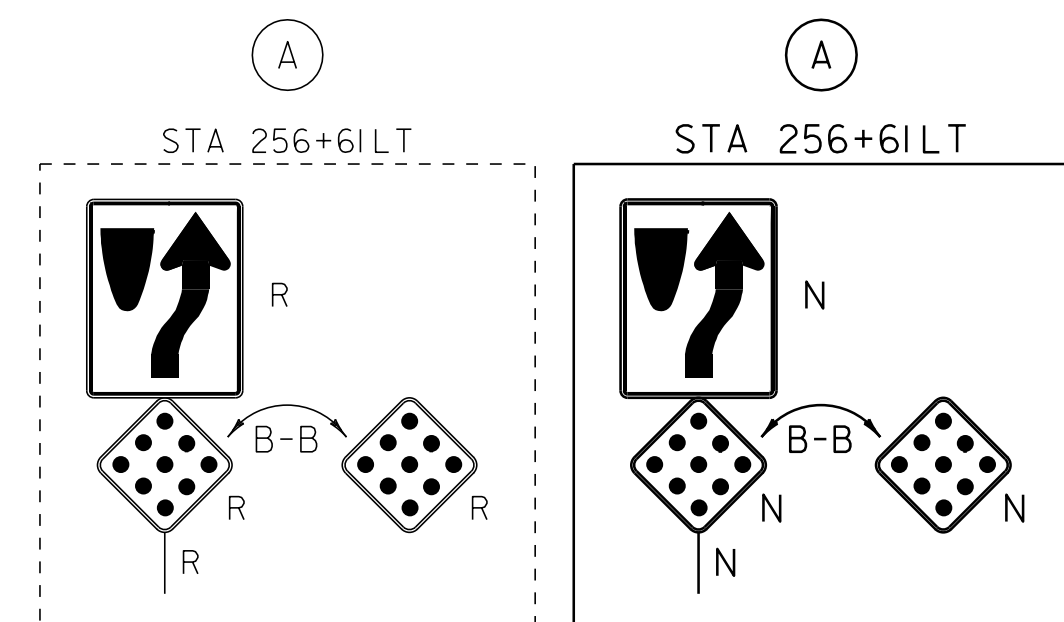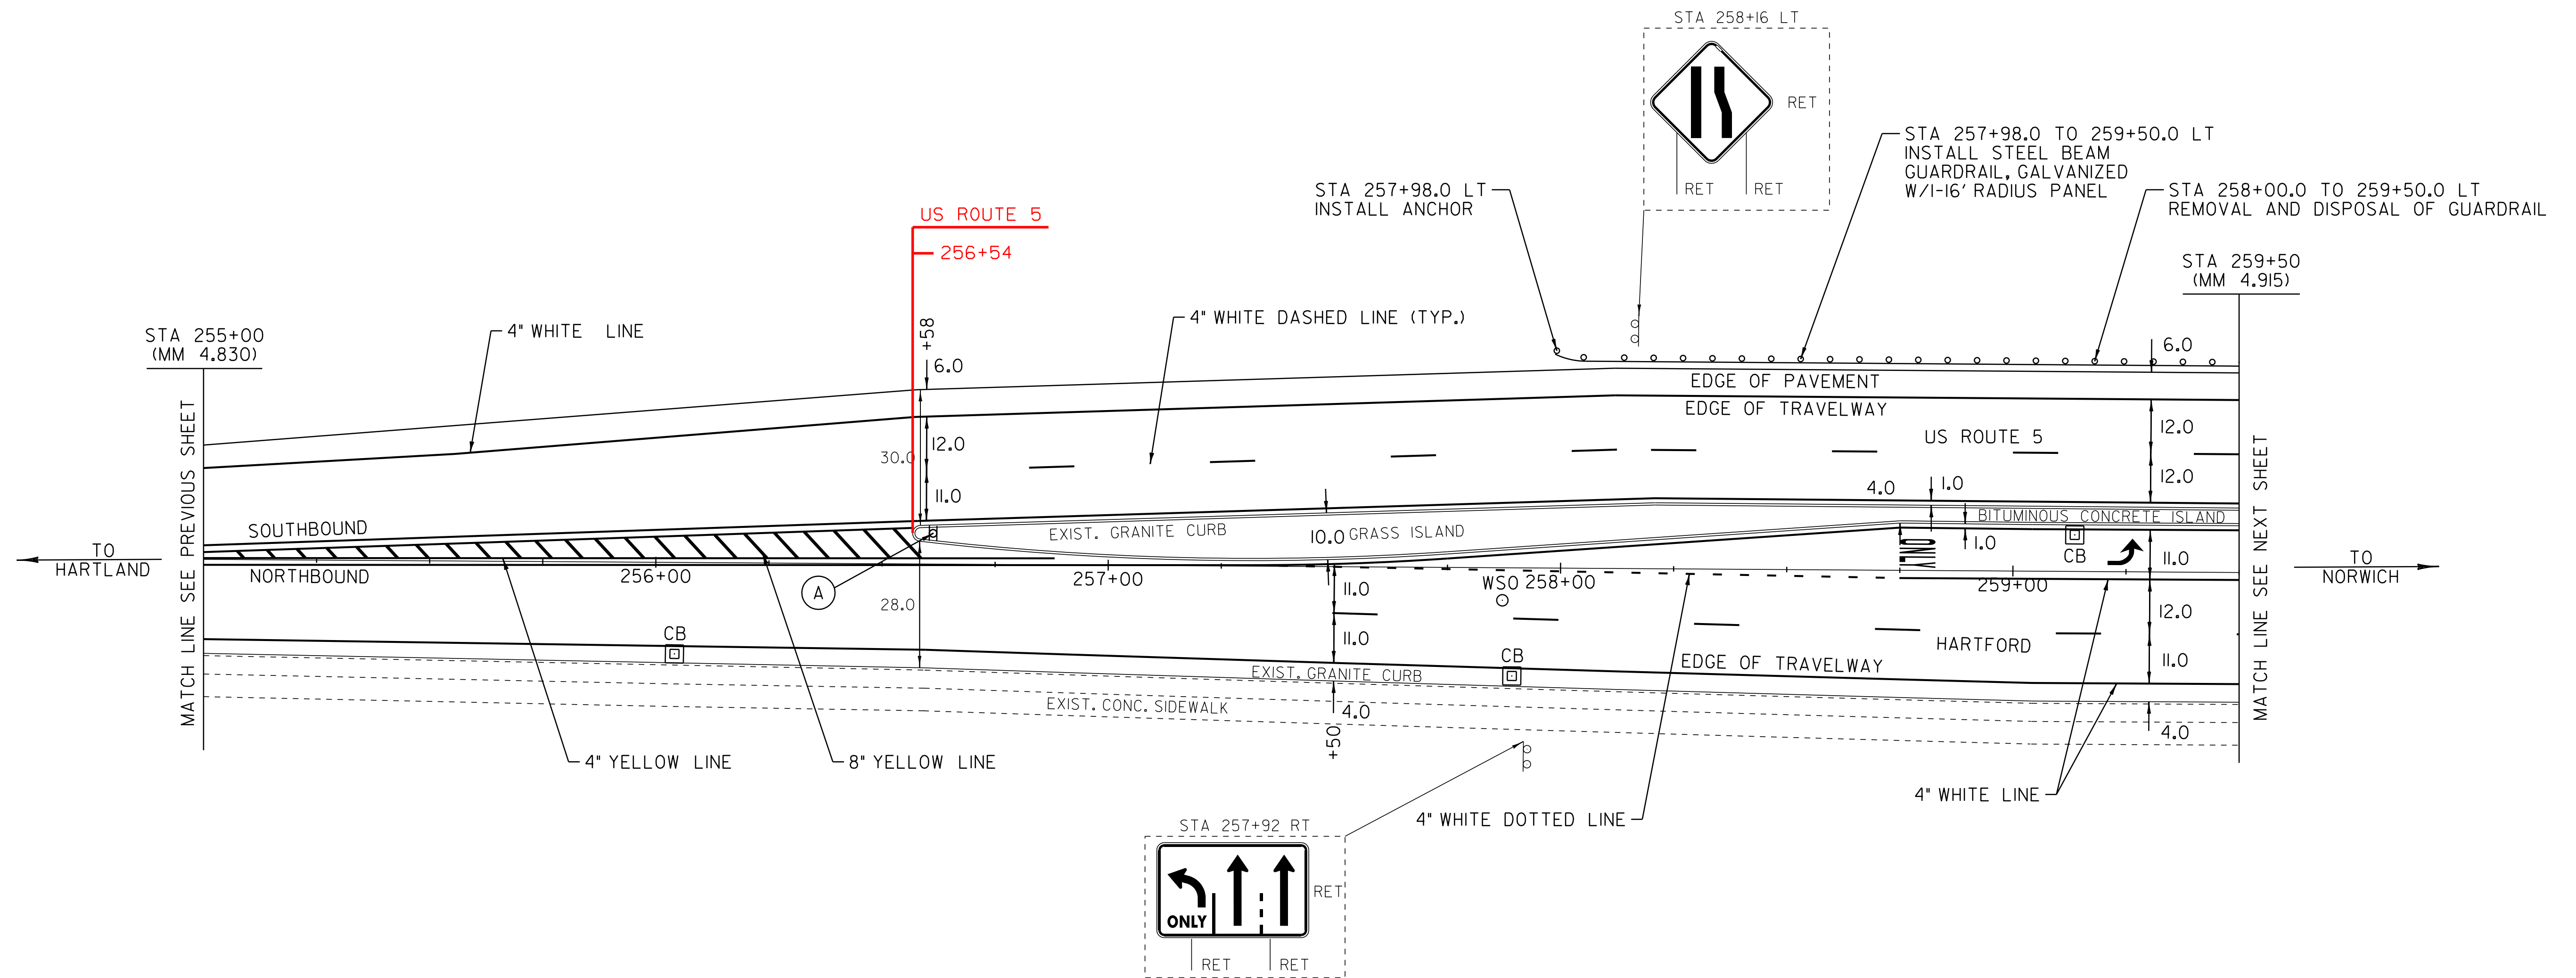

NOT TO SCALE

LEGEND

- R = REMOVE EXISTING
- S = SALVAGE
- R&S = REMOVE AND SALVAGE
- N = NEW
- RET = RETAIN
- B-B = BACK TO BACK
- ⊞ = EXISTING GUARDRAIL
- ⊞ = PROPOSED GUARDRAIL
- ⊞ = TYPE I DELINEATOR, WHITE

<b>PAVING LAYOUT SHEET 10</b>	PROJECT NAME: HARTFORD-NORWICH	PLOT DATE: 14-FEB-2012 15:50
	PROJECT NUMBER: STP 2206(1)S	DRAWN BY: MRS
	FILE NAME: /pave/99cl64/pci64	CHECKED BY: NLL
	DESIGNED BY: NLL	SHEET 34 OF 137
	IPARM FILE NAME: pci64l0.i	