

TEMPORARY 4" WHITE LINE, PAINT  
 DURABLE 4" WHITE LINE, THERMOPLASTIC  
 STA 265+00 TO 270+50 SOLID LT & RT

TEMPORARY 4" YELLOW LINE, PAINT  
 DURABLE 4" YELLOW LINE, THERMOPLASTIC  
 STA 265+00 TO 265+31 DOUBLE SOLID LT & RT  
 STA 265+31 TO 270+50 SOLID LT & RT

DURABLE 8" YELLOW LINE, THERMOPLASTIC  
 STA 265+00 TO 265+31 SOLID LT & RT (CORE)

REMOVAL AND DISPOSAL OF GUARDRAIL  
 STA 265+97.0 TO 267+25.0 LT


STEEL BEAM GUARDRAIL, GALVANIZED  
 STA 265+98.0 TO 267+23.0 LT

ANCHOR FOR STEEL BEAM RAIL  
 STA 265+98.0 LT  
 STA 267+23.0 LT

REHAB. DROP INLETS, CATCH BASINS,  
 OR MANHOLES, CLASS I, CLASS II OR CLASS III  
 STA 265+81 RT (CB) (D GRATE)  
 STA 267+39 RT (CB) (E GRATE)  
 STA 270+43 RT (CB) (E GRATE)

ADJUST ELEVATION  
 OF VALVE BOX (NON PART.)  
 STA 266+03 RT  
 STA 266+11 RT

CHANGING ELEVATION  
 OF SEWER MANHOLES (NON PART.)  
 STA 266+28 LT

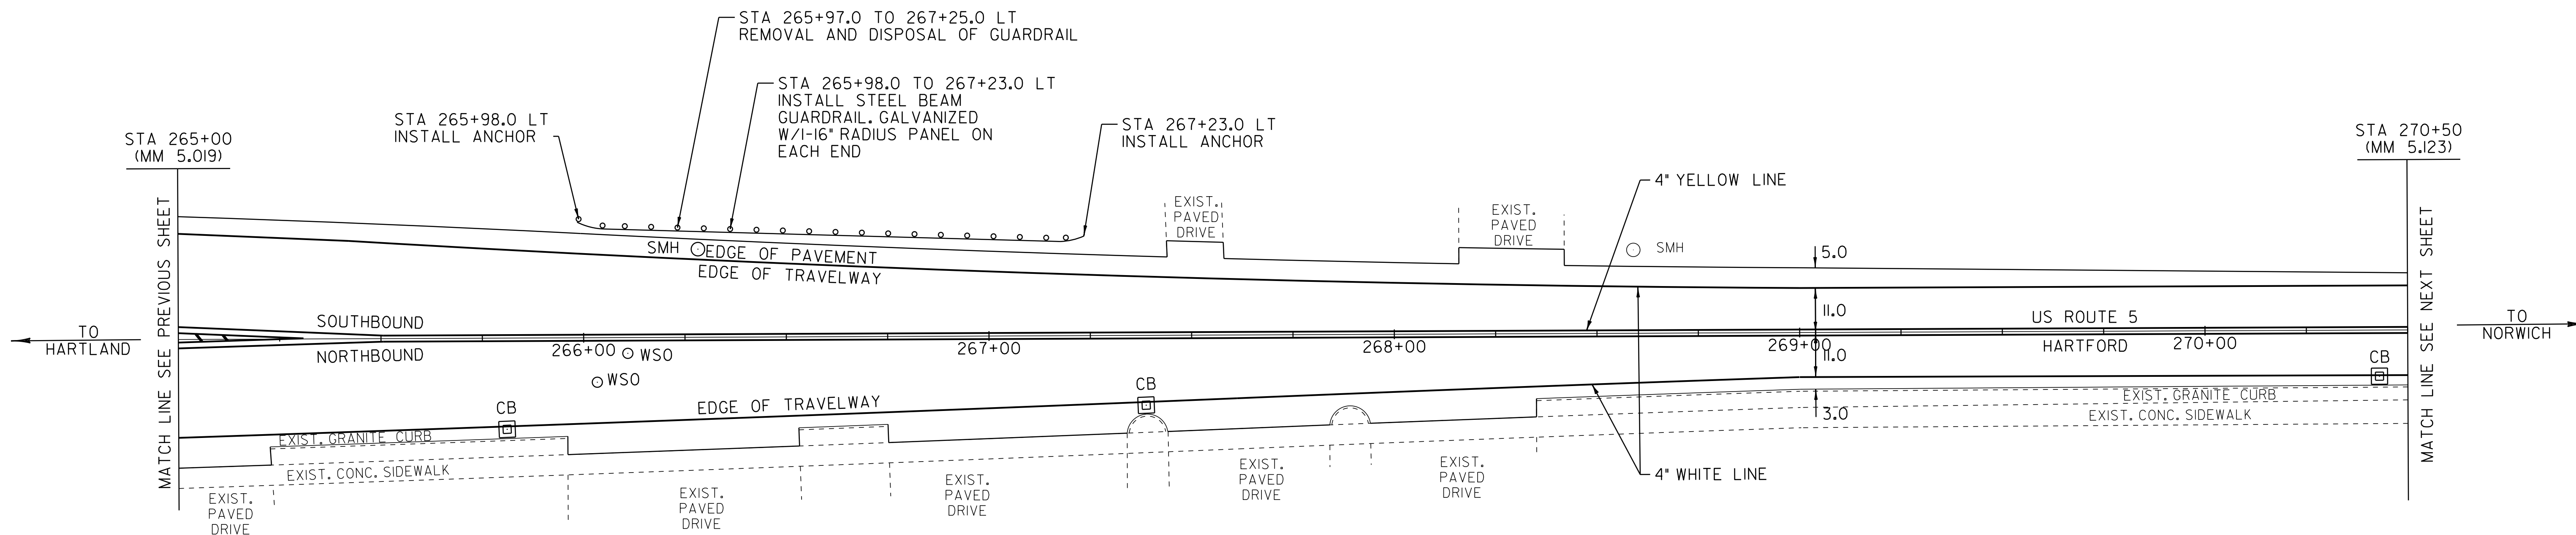

CUMBERLAND FARM  
 GAS STATION

NOTE:  
 STA 265+00 TO 268+35 RT  
 PAVE TO FACE OF CURB OR  
 EXIST. CONCRETE SIDEWALK.

LEGEND

- R = REMOVE EXISTING
- S = SALVAGE
- R&S = REMOVE AND SALVAGE
- N = NEW
- RET = RETAIN
- B-B = BACK TO BACK
- = EXISTING GUARDRAIL
- - - = PROPOSED GUARDRAIL
- ∩ = TYPE I DELINEATOR, WHITE

<b>PAVING LAYOUT SHEET 12</b>	PROJECT NAME: HARTFORD-NORWICH	PLOT DATE: 14-FEB-2012 15:50
	PROJECT NUMBER: STP 2206(1)S	DRAWN BY: MRS
	DESIGNED BY: NLL	CHECKED BY: NLL
	IPARM FILE NAME: pci64l2.i	SHEET 36 OF 137