

TEMPORARY 4" WHITE LINE, PAINT
 DURABLE 4" WHITE LINE, THERMOPLASTIC
 STA 270+50 TO 270+80 SOLID LT
 STA 270+50 TO 276+00 SOLID RT
 STA 271+60 TO 276+00 SOLID LT

TEMPORARY 4" YELLOW LINE, PAINT
 DURABLE 4" YELLOW LINE, THERMOPLASTIC
 STA 270+50 TO 271+00 SOLID LT & RT
 STA 271+20 DOUBLE SOLID LT (TH 252)
 STA 271+40 TO 276+00 SOLID LT & RT

TEMPORARY 24" STOP BAR, PAINT
 DURABLE 24" STOP BAR, THERMOPLASTIC
 STA 270+99 TO 271+19 LT (TH 252)

TEMPORARY LETTER OR SYMBOL, PAINT
 DURABLE LETTER OR SYMBOL, THERMOPLASTIC
 STA 271+12 LT - "STOP" (TH 252)


REHAB. DROP INLETS, CATCH BASINS,
 OR MANHOLES, CLASS I, CLASS II OR CLASS III
 STA 274+96 RT (CB) (D GRATE)
 STA 275+60 LT (CB) (D GRATE)

CHANGING ELEVATION
 OF SEWER MANHOLES (NON PART.)
 STA 271+22 LT (TH 252)
 STA 274+27 LT

ADJUST ELEVATION
 OF VALVE BOX (NON PART.)
 STA 271+19 RT
 STA 271+26 LT
 STA 271+60 LT

BITUMINOUS CONCRETE
 GUTTERS AND TRAFFIC ISLANDS
 STA 271+43 TO ~~272+28~~ LT
~~40~~ ~~276+00~~

THINNING AND TRIMMING FOR SIGNS
 STA 271+40 LT

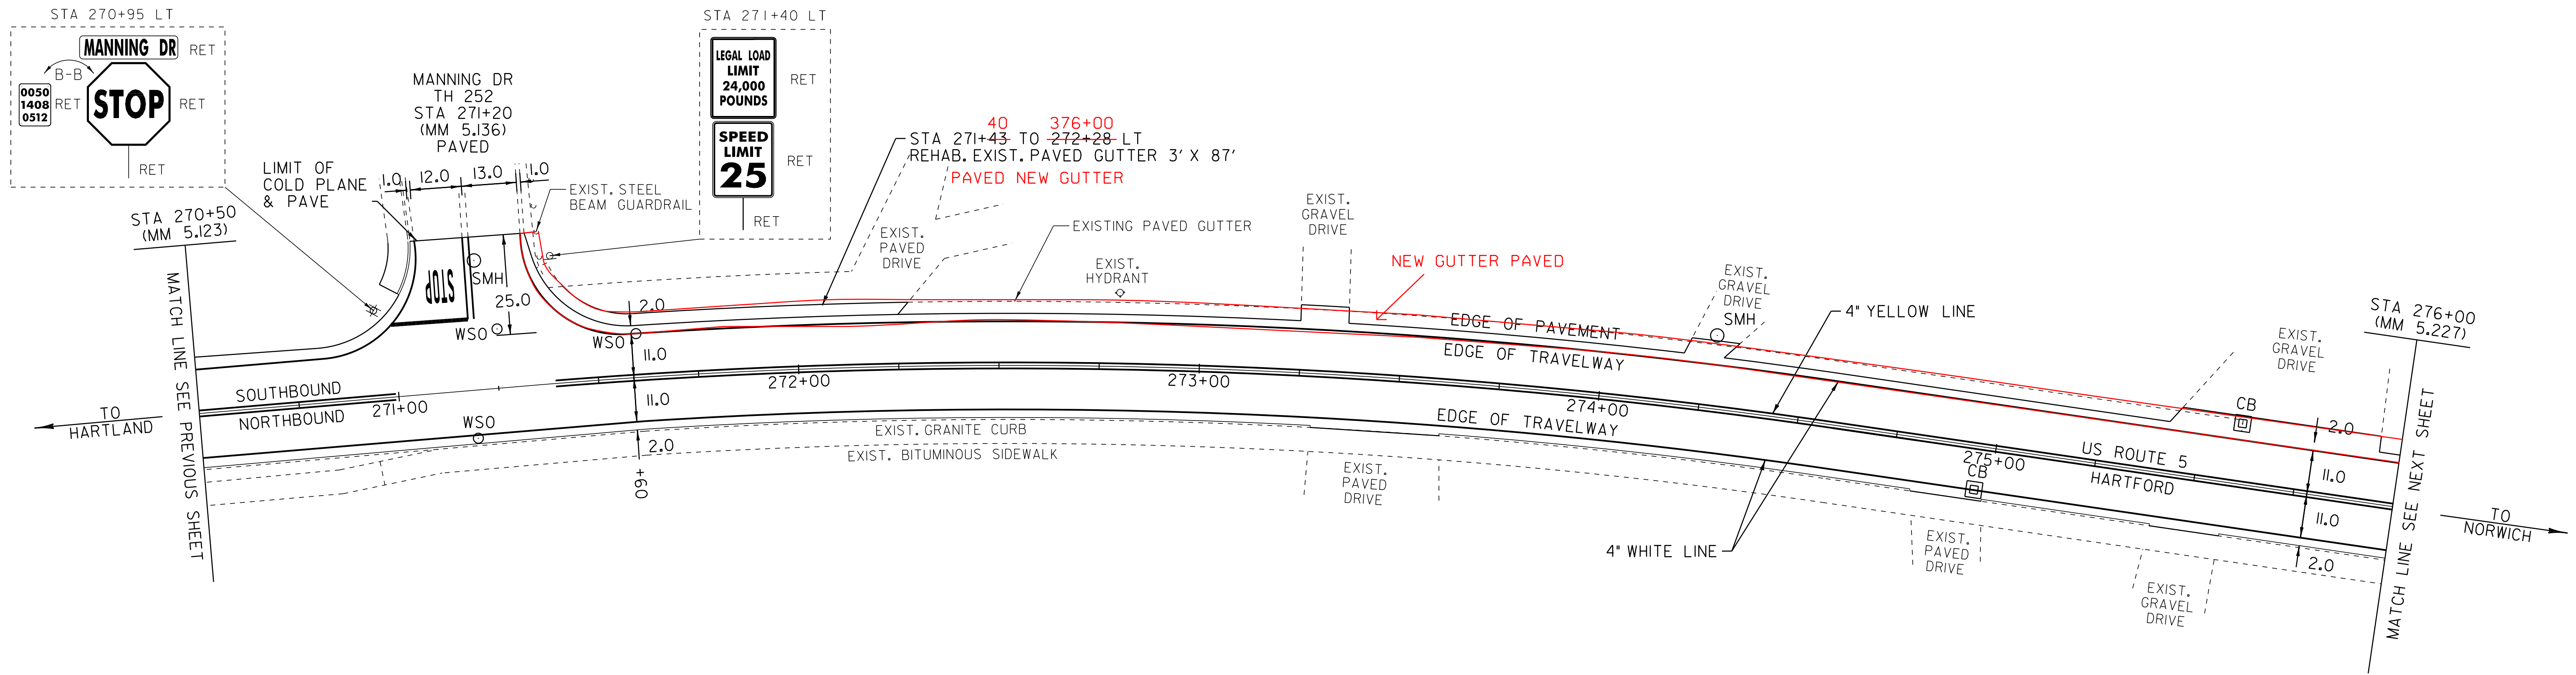

LEGEND

- R = REMOVE EXISTING
- S = SALVAGE
- R&S = REMOVE AND SALVAGE
- N = NEW
- RET = RETAIN
- B-B = BACK TO BACK
- ⊕ = EXISTING GUARDRAIL
- ⊕ = PROPOSED GUARDRAIL
- ⊕ = TYPE I DELINEATOR, WHITE

PAVING LAYOUT SHEET 13	PROJECT NAME: HARTFORD-NORWICH	PLOT DATE: 14-FEB-2012 15:50
	PROJECT NUMBER: STP 2206(1)S	DRAWN BY: MRS
	DESIGNED BY: NULL	CHECKED BY: NULL
	IPARM FILE NAME: pcl64lcl3.i	SHEET 37 OF 137

NOT TO SCALE