

TEMPORARY 4" WHITE LINE, PAINT  
DURABLE 4" WHITE LINE, THERMOPLASTIC

STA 276+00 TO 279+52 SOLID LT  
STA 276+00 TO 279+93 SOLID RT  
STA 279+83 TO 281+00 SOLID LT  
STA 280+04 TO 280+13 SOLID RT (TH 91)  
STA 280+39 TO 280+43 SOLID RT (TH 91)  
STA 280+51 TO 281+00 SOLID RT

TEMPORARY 4" YELLOW LINE, PAINT  
DURABLE 4" YELLOW LINE, THERMOPLASTIC

STA 276+00 TO 279+40 SOLID LT & RT  
STA 279+60 DOUBLE SOLID LT (TH 33)  
STA 279+80 TO 280+05 SOLID LT & RT  
STA 280+25 DOUBLE SOLID RT (TH 91)  
STA 280+45 TO 281+00 SOLID LT & RT

TEMPORARY LETTER OR SYMBOL, PAINT  
DURABLE LETTER OR SYMBOL, THERMOPLASTIC

STA 279+48 LT - "STOP" (TH 33)  
STA 280+32 RT - "STOP" (TH 91)

**BITUMINOUS GUTTER**  
276+00 - 276+51 LT

**BITUMINOUS SIDEWALK**  
278+75 - 279+80 RT

TEMPORARY 24" STOP BAR, PAINT  
DURABLE 24" STOP BAR, THERMOPLASTIC

STA 279+31 TO 279+60 LT (TH 33)  
STA 280+26 TO 280+40 RT (TH 91)

TEMPORARY CROSSWALK MARKING, PAINT  
DURABLE CROSSWALK MARKING, THERMOPLASTIC

STA 280+01 TO 280+45 RT (TH 91)

PORTLAND CEMENT CONCRETE SIDEWALK, 5 INCH  
STA 279+83 TO 279+99 RT (RAMP TYPE 1)  
STA 280+46 TO 280+62 RT (RAMP TYPE 1)

VERTICAL GRANITE CURB

STA 279+83 TO 279+99 RT  
~~STA 280+46 TO 280+62 RT~~

INSTALLED BY TOWN

DETECTABLE WARNING SURFACE

STA 279+95 RT  
STA 280+51 RT

REMOVAL AND DISPOSAL OF GUARDRAIL  
STA 277+00.0 TO 279+00.0 LT  
STA 278+10.0 TO 279+72.0 RT

STEEL BEAM GUARDRAIL, GALVANIZED  
STA 277+00.0 TO 279+00.0 LT 12.5  
~~STA 278+09.5 TO 279+72.0 RT~~  
278+47 - 279+84.5 RT

ANCHOR FOR STEEL BEAM RAIL

STA 277+00.0 LT  
STA 278+09.5 RT  
STA 279+00.0 LT 12.5  
STA 279+72.0 RT  
279+84.5

REHAB. DROP INLETS, CATCH BASINS,  
OR MANHOLES, CLASS I, CLASS II OR CLASS II

STA 276+35 LT (CB)  
STA 278+70 RT (CB)  
279+60 RT (CB)

CHANGING ELEVATION  
OF SEWER MANHOLES (NON PART.)  
STA 279+73 LT (TH 33)

**STEEL BEAM GUARDRAIL, GALV (MOD.) W/ 8' POSTS**

STA 278+72 - 279+47 RT  
STA 278+12 - 278+87 LT


ADJUST ELEVATION  
OF VALVE BOX (NON PART.)

STA 279+73 LT  
STA 280+36 LT  
STA 280+67 LT  
STA 280+72 LT

REMOVING SIGNS  
AS SHOWN - 12

ERECTING SALVAGED SIGNS  
AS SHOWN - 10

STA 279+00 TO 281+00  
MAY HAVE SEWER MANHOLES  
HIDDEN BY PAVEMENT.

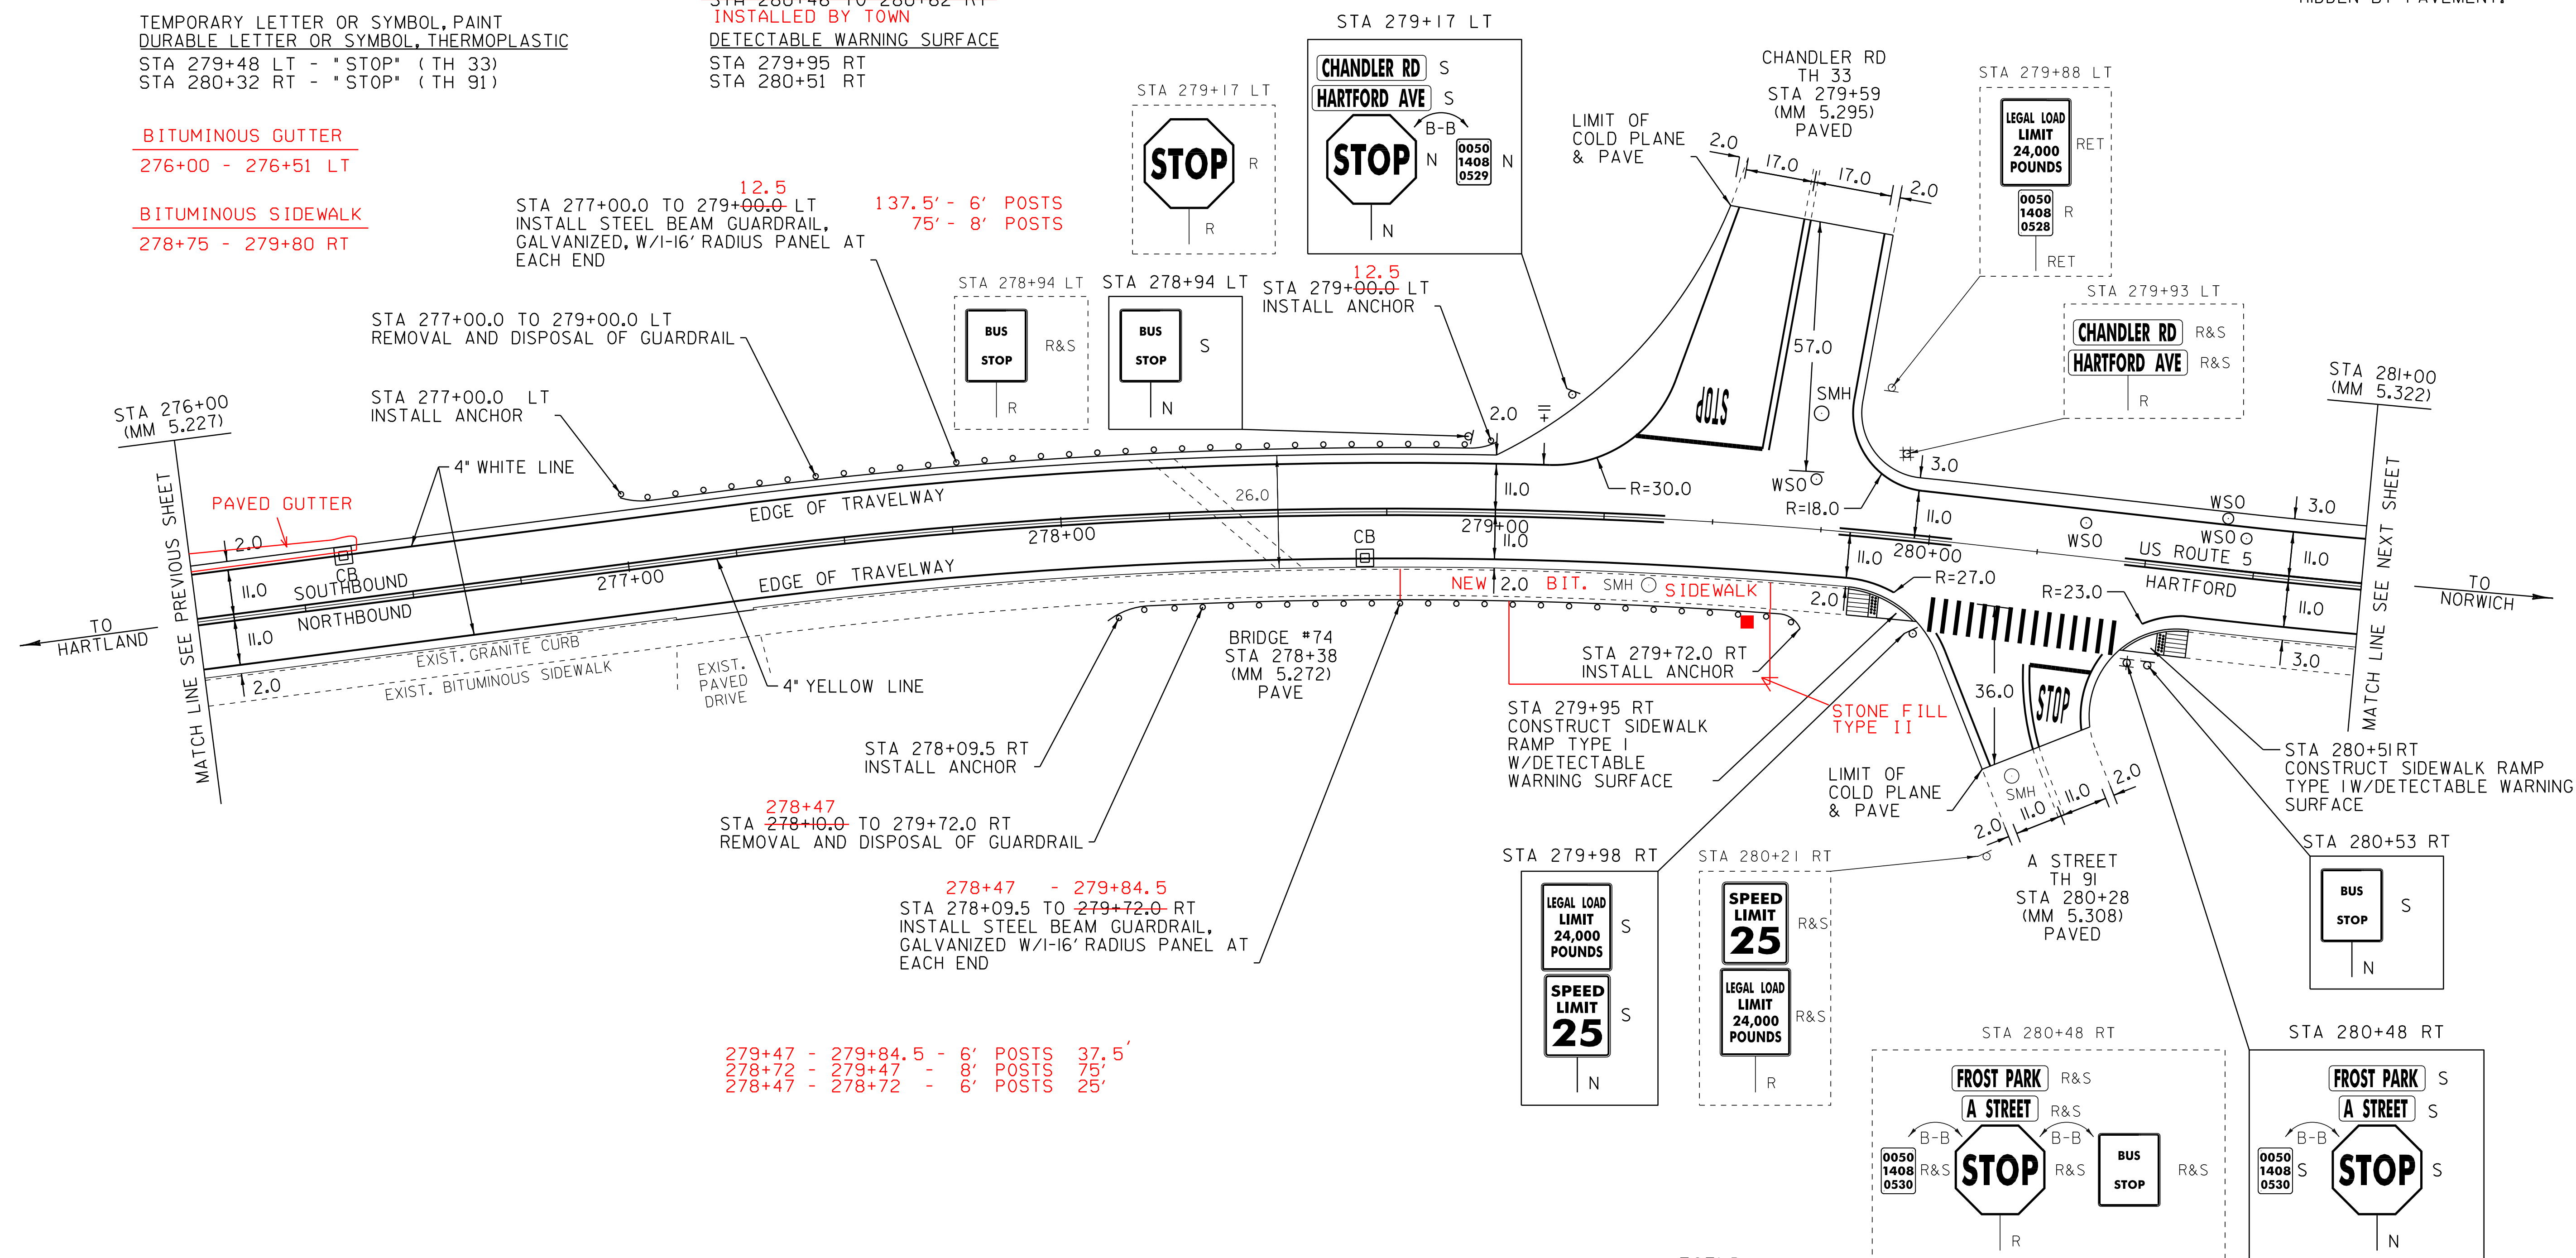

279+47 - 279+84.5 - 6' POSTS 37.5'  
278+72 - 279+47 - 8' POSTS 75'  
278+47 - 278+72 - 6' POSTS 25'

- LEGEND**
- R = REMOVE EXISTING
  - S = SALVAGE
  - R&S = REMOVE AND SALVAGE
  - N = NEW
  - RET = RETAIN
  - B-B = BACK TO BACK
  - = EXISTING GUARDRAIL
  - - - = PROPOSED GUARDRAIL
  - ⋈ = TYPE I DELINEATOR, WHITE

<h2>PAVING LAYOUT SHEET 14</h2>	PROJECT NAME: HARTFORD-NORWICH	PLOT DATE: 14-FEB-2012 15:50
	PROJECT NUMBER: STP 2206(1)S	DRAWN BY: MRS
	FILE NAME: /pave/99c164/pci64	DESIGNED BY: NULL
	PROJECT LEADER: PTS	CHECKED BY: NULL
	IPARM FILE NAME: pci64l14.i	SHEET 38 OF 137

NOT TO SCALE