

TEMPORARY 4" WHITE LINE, PAINT
 DURABLE 4" WHITE LINE, THERMOPLASTIC
 STA 286+00 TO 288+14 SOLID RT
 STA 286+00 TO 291+50 SOLID LT
 STA 288+94 TO 291+50 SOLID LT

TEMPORARY 4" YELLOW LINE, PAINT
 DURABLE 4" YELLOW LINE, THERMOPLASTIC
 STA 286+00 TO 288+33 SOLID LT & RT
 STA 288+73 TO 291+50 SOLID LT & RT

TEMPORARY CROSSWALK MARKING, PAINT
 DURABLE CROSSWALK MARKING, THERMOPLASTIC
 STA 288+42 TO 288+64 RT (TH 123)

PORTLAND CEMENT CONCRETE SIDEWALK, 5 INCH
 STA 288+25 TO 288+41 RT (RAMP TYPE 1)
 STA 288+66 TO 288+91 RT (RAMP TYPE 1)

VERTICAL GRANITE CURB
~~STA 288+25 TO 288+41 RT~~ INSTALLED
~~STA 288+66 TO 288+91 RT~~ BY TOWN

DETECTABLE WARNING SURFACE
 STA 288+38 RT
 STA 288+69 RT


~~REMOVAL AND DISPOSAL OF GUIDE POSTS~~
~~STA 291+29 LT (1)~~

CHANGING ELEVATION
 OF SEWER MANHOLES (NON PART.)
 STA 289+53 CL

ADJUST ELEVATION
 OF VALVE BOX (NON PART.)
 STA 286+40 LT
 STA 287+69 LT
 STA 291+17 LT

REMOVING SIGNS
 AS SHOWN - 2

STA 286+00 TO 291+50
 MAY HAVE SEWER MANHOLES
 HIDDEN BY PAVEMENT.

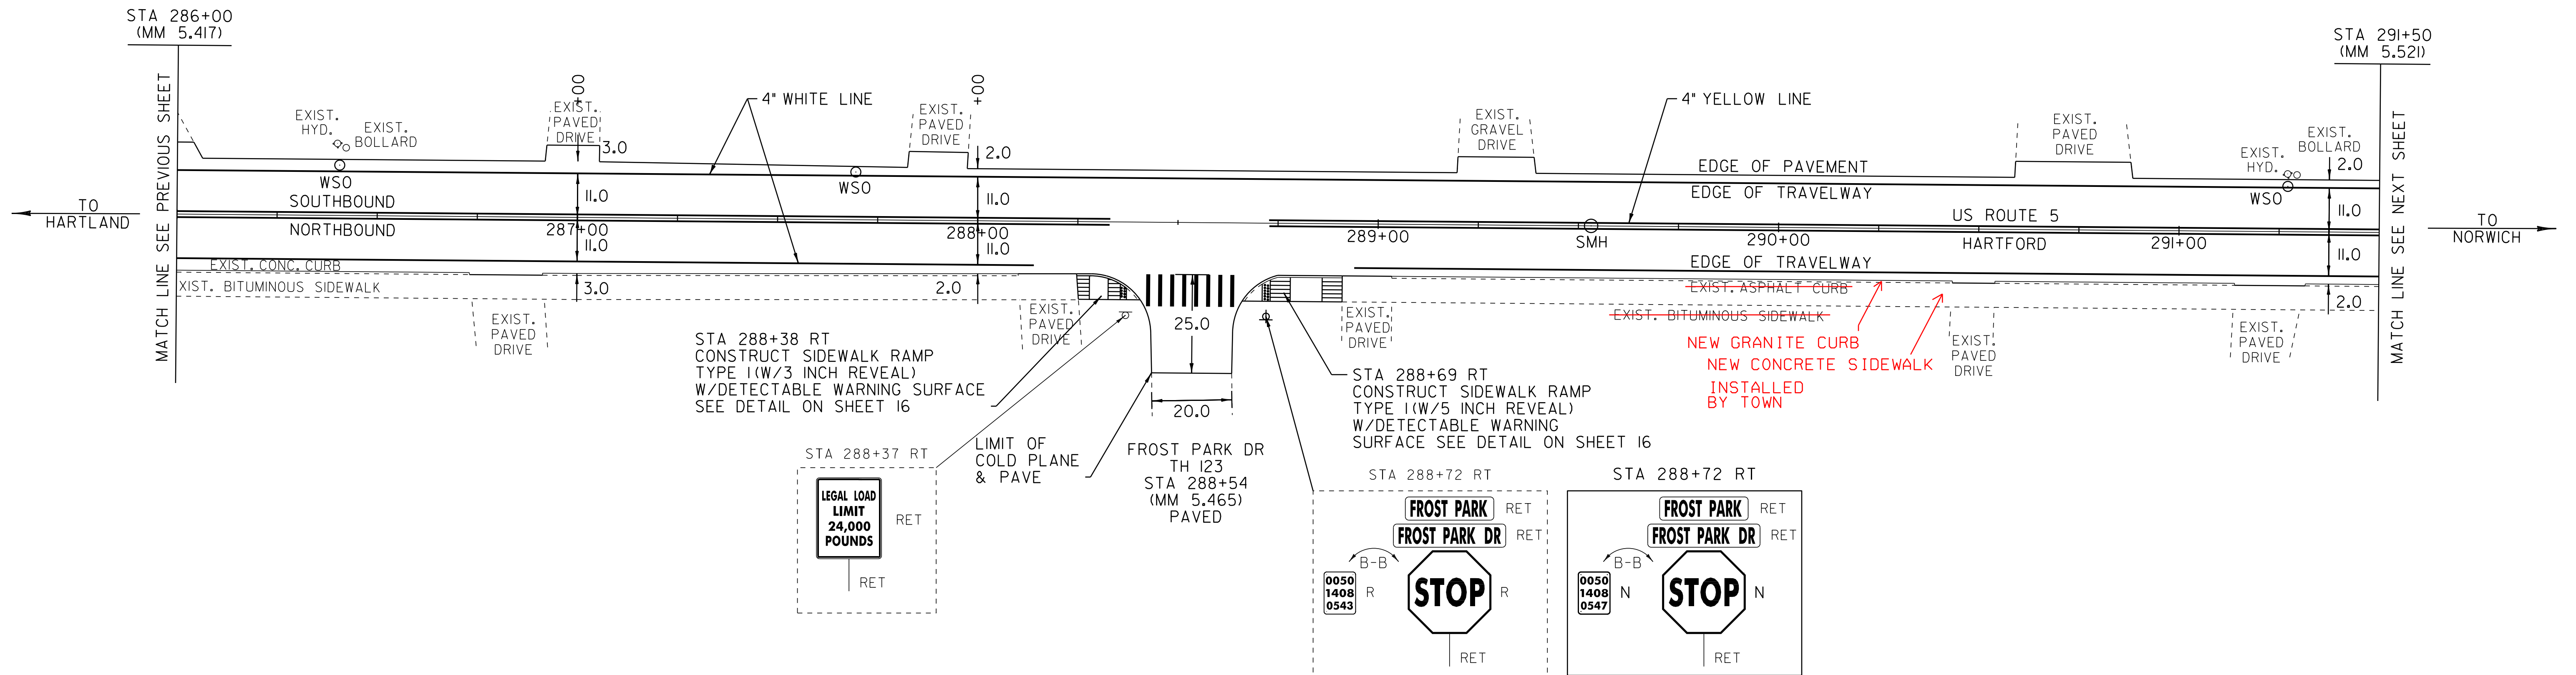

LEGEND

- R = REMOVE EXISTING
- S = SALVAGE
- R&S = REMOVE AND SALVAGE
- N = NEW
- RET = RETAIN
- B-B = BACK TO BACK
- — — = EXISTING GUARDRAIL
- — — = PROPOSED GUARDRAIL
- ⚡ = TYPE I DELINEATOR, WHITE

PAVING LAYOUT SHEET 16	PROJECT NAME: HARTFORD-NORWICH	PLOT DATE: 14-FEB-2012 15:50
	PROJECT NUMBER: STP 2206(1)S	DRAWN BY: MRS
	FILE NAME: /pave/99cl64/pci64	CHECKED BY: NULL
	DESIGNED BY: NULL	SHEET 40 OF 137

NOT TO SCALE