

TEMPORARY 4" WHITE LINE, PAINT  
DURABLE 4" WHITE LINE, THERMOPLASTIC

STA 297+00 TO 297+42 SOLID LT  
STA 297+00 TO 297+41 SOLID RT  
STA 297+42 TO 297+54 SOLID LT (TH 32)  
STA 297+48 TO 297+49 SOLID RT (TH 31)  
STA 297+71 TO 297+73 SOLID RT (TH 31)  
STA 297+73 TO 297+77 SOLID LT (TH 32)  
STA 297+84 TO 300+75 SOLID LT  
STA 297+84 TO 300+76 SOLID RT  
STA 301+55 TO 302+50 SOLID LT  
STA 301+56 TO 302+50 SOLID RT

TEMPORARY 4" YELLOW LINE, PAINT  
DURABLE 4" YELLOW LINE, THERMOPLASTIC

STA 297+00 TO 297+42 SOLID LT & RT  
STA 297+60 DOUBLE SOLID LT (TH 32)  
STA 297+63 DOUBLE SOLID RT (TH 31)  
STA 297+80 TO 300+96 SOLID LT & RT  
STA 301+36 TO 302+50 SOLID LT & RT

TEMPORARY LETTER OR SYMBOL, PAINT  
DURABLE LETTER OR SYMBOL, THERMOPLASTIC

STA 297+57 LT - "STOP" (TH 32)  
STA 297+68 RT - "STOP" (TH 31)

TEMPORARY 24" STOP BAR, PAINT  
DURABLE 24" STOP BAR, THERMOPLASTIC

STA 297+52 TO 297+61 LT (TH 32)  
STA 297+62 TO 297+73 RT (TH 31)

TEMPORARY CROSSWALK MARKING, PAINT  
DURABLE CROSSWALK MARKING, THERMOPLASTIC

STA 297+46 TO 297+77 RT (TH 31)  
STA 297+81 LT TO RT  
STA 301+05 TO 301+26 LT (TH 88)  
301+05 TO 301+26 RT (TH 88)

PORTLAND CEMENT CONCRETE SIDEWALK, 8 INCH

STA 297+41 TO 297+46 RT (LANDING)  
STA 297+73 TO 298+05 RT (RAMP TYPE 6)

VERTICAL GRANITE CURB

STA 297+40 TO 297+46 RT  
STA 297+73 TO 298+05 RT  
STA 297+78 TO 297+80 RT (BACK CURB)  
STA 297+93 TO 298+05 RT (BACK CURB)

DETECTABLE WARNING SURFACE

STA 297+43 RT  
STA 297+81 RT

CHANGING ELEVATION OF DROP INLETS,  
CATCH BASINS, OR MANHOLES

STA 297+53 LT (DMH)  
STA 297+57 RT (DMH)  
STA 301+10 LT (DMH) (TH 88)  
STA 301+13 RT (DMH) (TH 88)RET  
STA 301+35 LT (CB)  
STA 301+40 RT (CB)  
297+85 LT (CB)

CHANGING ELEVATION  
OF SEWER MANHOLES (NON PART.)

STA 297+64 LT  
STA 300+01 LT

ADJUST ELEVATION  
OF VALVE BOX (NON PART.)

STA 297+63 LT (TH 32)  
STA 297+67 LT (TH 32)  
STA 297+69 LT  
STA 297+70 LT (TH 32)  
STA 297+71 LT  
STA 297+72 LT  
STA 297+74 LT  
STA 298+59 RT  
STA 298+64 RT  
STA 301+21 LT (TH 88)


REMOVING SIGNS  
AS SHOWN - 10

ERECTING SALVAGED SIGNS  
AS SHOWN - 7

STA 297+00 TO 302+50  
MAY HAVE SEWER MANHOLES  
HIDDEN BY PAVEMENT.

BITUMINOUS CONCRETE GUTTERS  
AND TRAFFIC ISLANDS

STA 301+40 TO 301+96 RT (REHAB.)

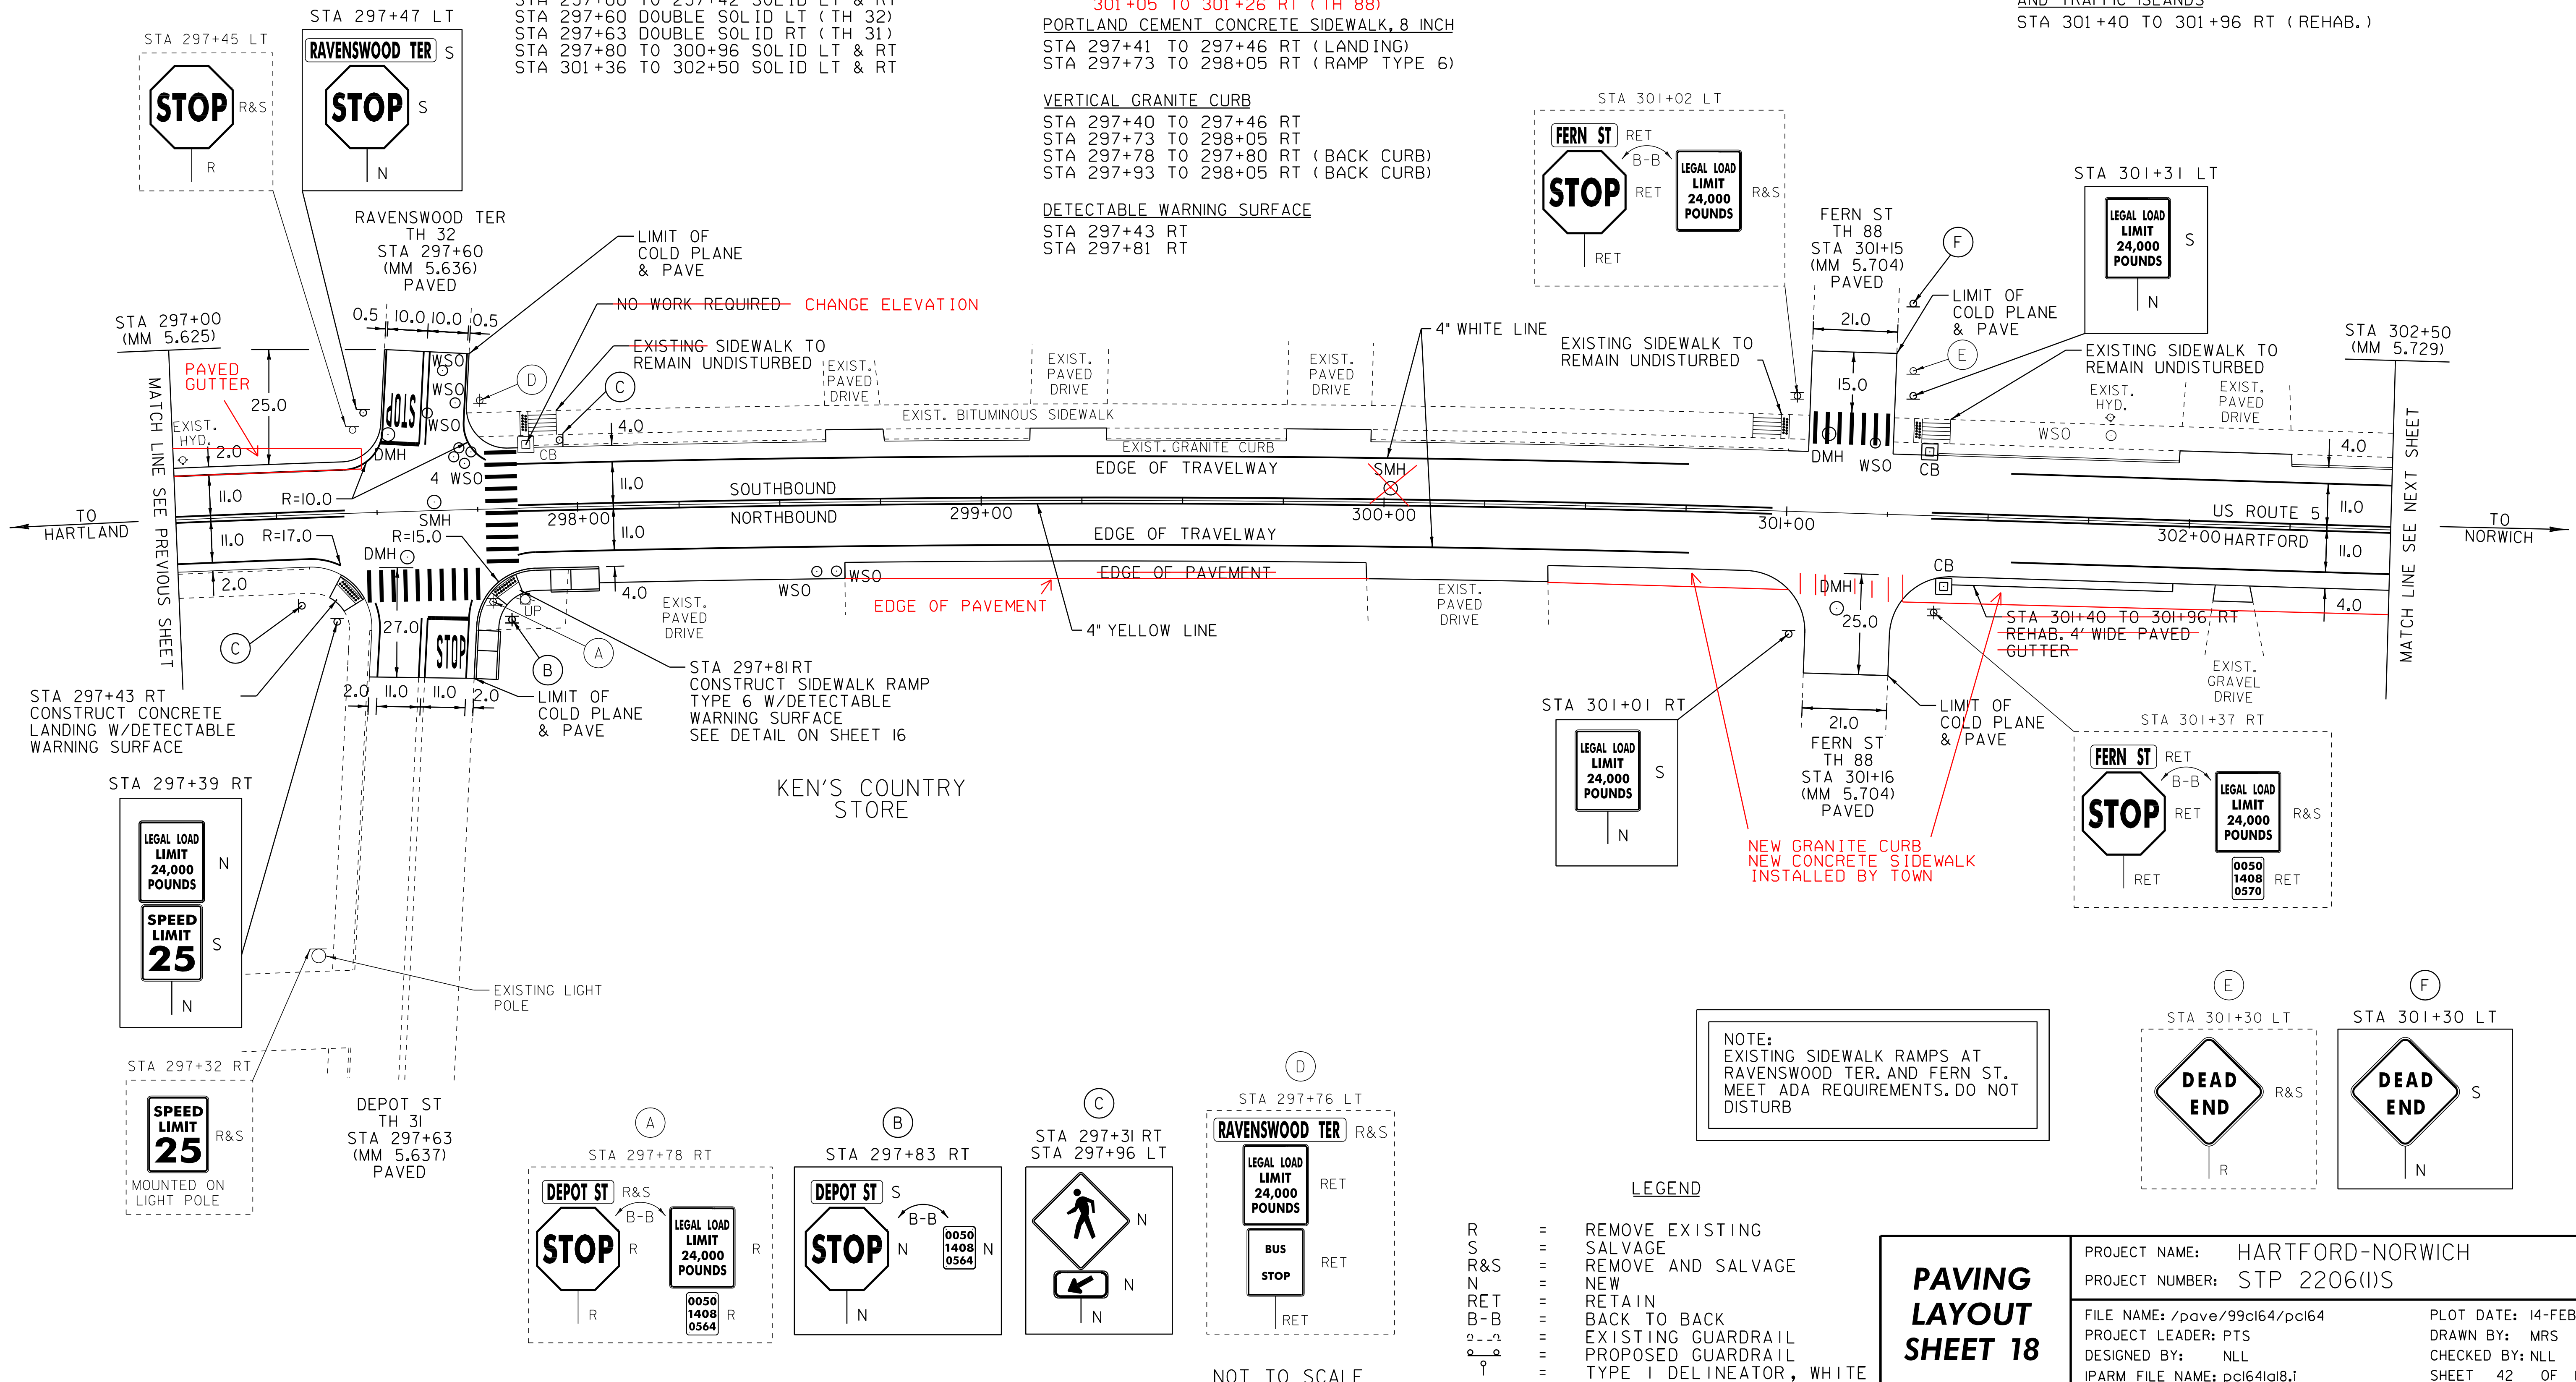

NOT TO SCALE

LEGEND

- R = REMOVE EXISTING
- S = SALVAGE
- R&S = REMOVE AND SALVAGE
- N = NEW
- RET = RETAIN
- B-B = BACK TO BACK
- = EXISTING GUARDRAIL
- - - = PROPOSED GUARDRAIL
- ⚡ = TYPE I DELINEATOR, WHITE

PAVING LAYOUT SHEET 18

PROJECT NAME: HARTFORD-NORWICH	PLOT DATE: 14-FEB-2012 15:50
PROJECT NUMBER: STP 2206(1)S	DRAWN BY: MRS
FILE NAME: /pave/99cl64/pci64	DESIGNED BY: NULL
PROJECT LEADER: PTS	CHECKED BY: NULL
IPARM FILE NAME: pci64l18.i	SHEET 42 OF 137