

TEMPORARY 4" WHITE LINE, PAINT  
 DURABLE 4" WHITE LINE, THERMOPLASTIC  
 STA 302+50 TO 304+25 SOLID LT & RT  
 STA 305+05 TO 306+99 SOLID LT & RT

TEMPORARY 4" YELLOW LINE, PAINT  
 DURABLE 4" YELLOW LINE, THERMOPLASTIC  
 STA 302+50 TO 304+45 SOLID LT & RT  
 STA 304+85 TO 307+00 SOLID LT & RT

TEMPORARY CROSSWALK MARKING, PAINT  
 DURABLE CROSSWALK MARKING, THERMOPLASTIC  
 STA 304+55 TO 304+75 LT (TH 87)  
 304+55 TO 304+75 RT (TH 87)


CHANGING ELEVATION OF DROP INLETS,  
 CATCH BASINS, OR MANHOLES  
 STA 304+57 RT (DMH) (TH 87)  
 STA 304+84 LT (CB)  
 STA 304+84 RT (CB)

REMOVING SIGNS  
 AS SHOWN - 6  
 ERECTING SALVAGED SIGNS  
 AS SHOWN - 2


REHAB. DROP INLETS, CATCH BASINS,  
 OR MANHOLES, CLASS I, CLASS II OR CLASS III  
 STA 306+00 RT (CB)

STA 302+50 TO 307+00  
 MAY HAVE SEWER MANHOLES  
 HIDDEN BY PAVEMENT.

ADJUST ELEVATION  
 OF VALVE BOX (NON PART.)  
 STA 303+46 LT  
 STA 304+58 LT  
 STA 304+64 LT  
 STA 304+65 LT  
 STA 304+71 LT

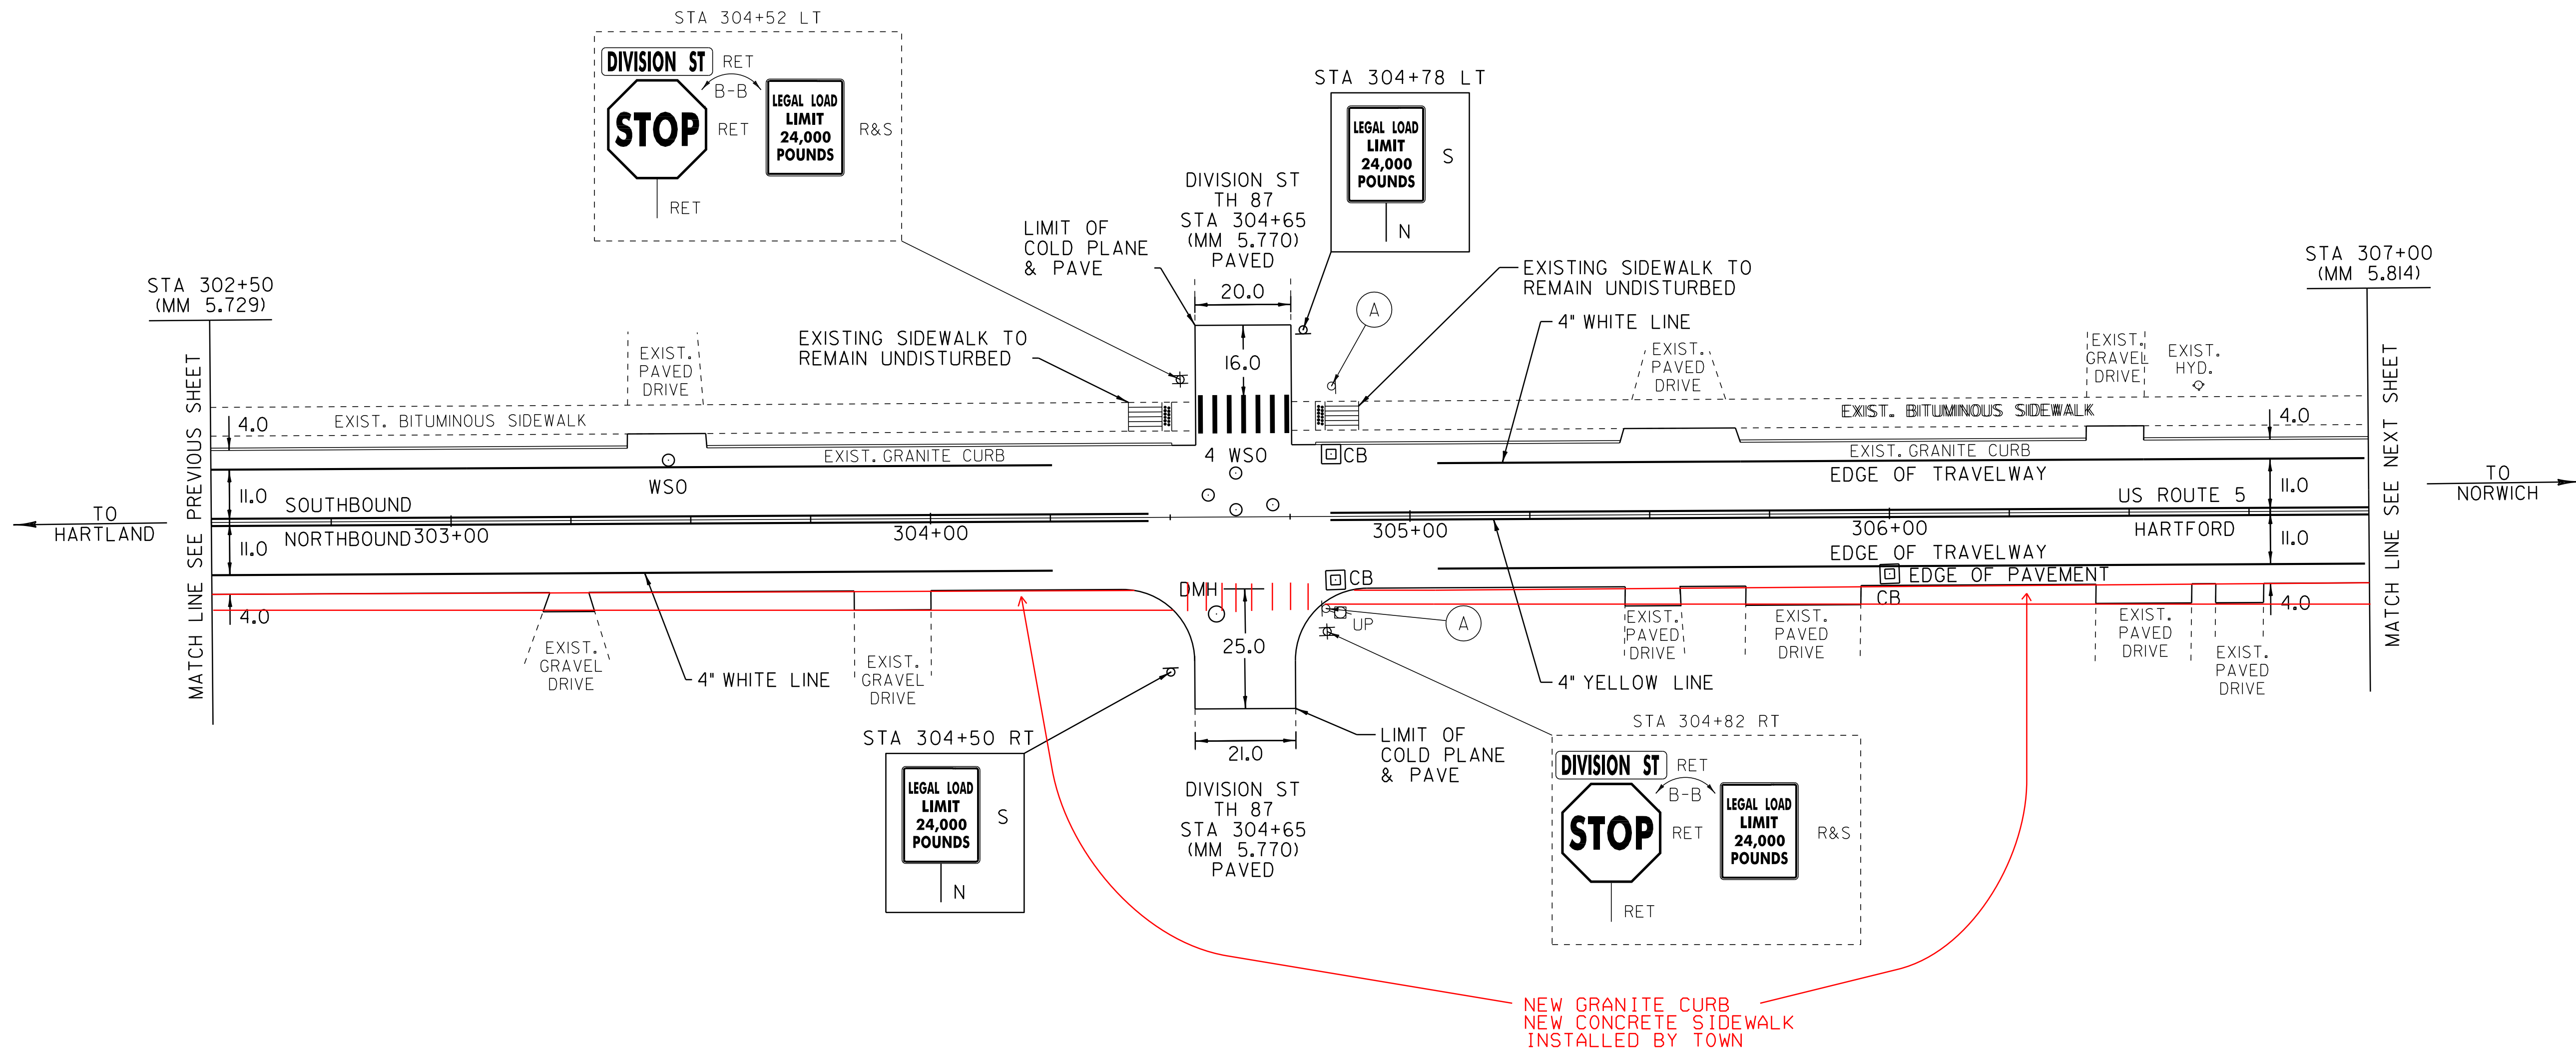

NOTE:  
 EXISTING SIDEWALK RAMPS AT  
 DIVISION ST. MEET ADA REQUIREMENTS.  
 DO NOT DISTURB

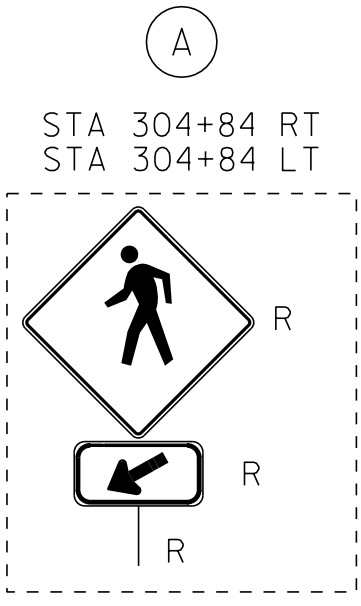

- LEGEND
- R = REMOVE EXISTING
  - S = SALVAGE
  - R&S = REMOVE AND SALVAGE
  - N = NEW
  - RET = RETAIN
  - B-B = BACK TO BACK
  - — — = EXISTING GUARDRAIL
  - — — = PROPOSED GUARDRAIL
  - ⚡ = TYPE I DELINEATOR, WHITE

<b>PAVING LAYOUT SHEET 19</b>	PROJECT NAME: HARTFORD-NORWICH	PLOT DATE: 14-FEB-2012 15:50
	PROJECT NUMBER: STP 2206(1)S	DRAWN BY: MRS
	FILE NAME: /pave/99cl64/pcl64	CHECKED BY: NLL
	DESIGNED BY: NLL	SHEET 43 OF 137

NOT TO SCALE