

TEMPORARY 4" WHITE LINE, PAINT
 DURABLE 4" WHITE LINE, THERMOPLASTIC
 STA 312+50 TO 314+20 SOLID RT
 STA 312+50 TO 314+69 SOLID LT
 STA 314+49 TO 314+69 SOLID RT
 STA 314+76 TO 317+00 SOLID RT

TEMPORARY 4" YELLOW LINE, PAINT
 DURABLE 4" YELLOW LINE, THERMOPLASTIC
 STA 312+50 TO 314+17 SOLID LT & RT
 STA 314+37 DOUBLE SOLID RT (TH 29)
 STA 314+54 TO 314+67 SOLID LT & RT
 STA 314+75 TO 317+00 SOLID LT & RT

TEMPORARY LETTER OR SYMBOL, PAINT
 DURABLE LETTER OR SYMBOL, THERMOPLASTIC
 STA 314+48 RT - "STOP" (TH 29)

TEMPORARY 24" STOP BAR, PAINT
 DURABLE 24" STOP BAR, THERMOPLASTIC
 STA 314+38 TO 314+63 RT (TH 29)

TEMPORARY CROSSWALK MARKING, PAINT
 DURABLE CROSSWALK MARKING, THERMOPLASTIC
 STA 314+70 TO 314+73 LT TO RT

PORTLAND CEMENT CONCRETE SIDEWALK, 5 INCH
 STA 314+67 TO 314+72 LT (CONCRETE PAD)
 STA 314+69 TO 314+75 RT (CONCRETE PAD)

REMOVING AND RESETTING CURB
 STA 314+67 TO 314+72 LT

DETECTABLE WARNING SURFACE
 STA 314+70 LT
 STA 314+73 RT


CHANGING ELEVATION OF DROP INLETS,
 CATCH BASINS, OR MANHOLES
 STA 314+36 RT (DMH) (TH 29)

CHANGING ELEVATION
 OF SEWER MANHOLES (NON PART.)
 STA 314+35 RT
 STA 314+52 RT
 STA 315+18 LT

ADJUST ELEVATION
 OF VALVE BOX (NON PART.)
 STA 314+62 RT
 STA 314+65 RT

REMOVING SIGNS
 AS SHOWN - 2

STA 312+50 TO 314+00
 MAY HAVE SEWER MANHOLES
 HIDDEN BY PAVEMENT.

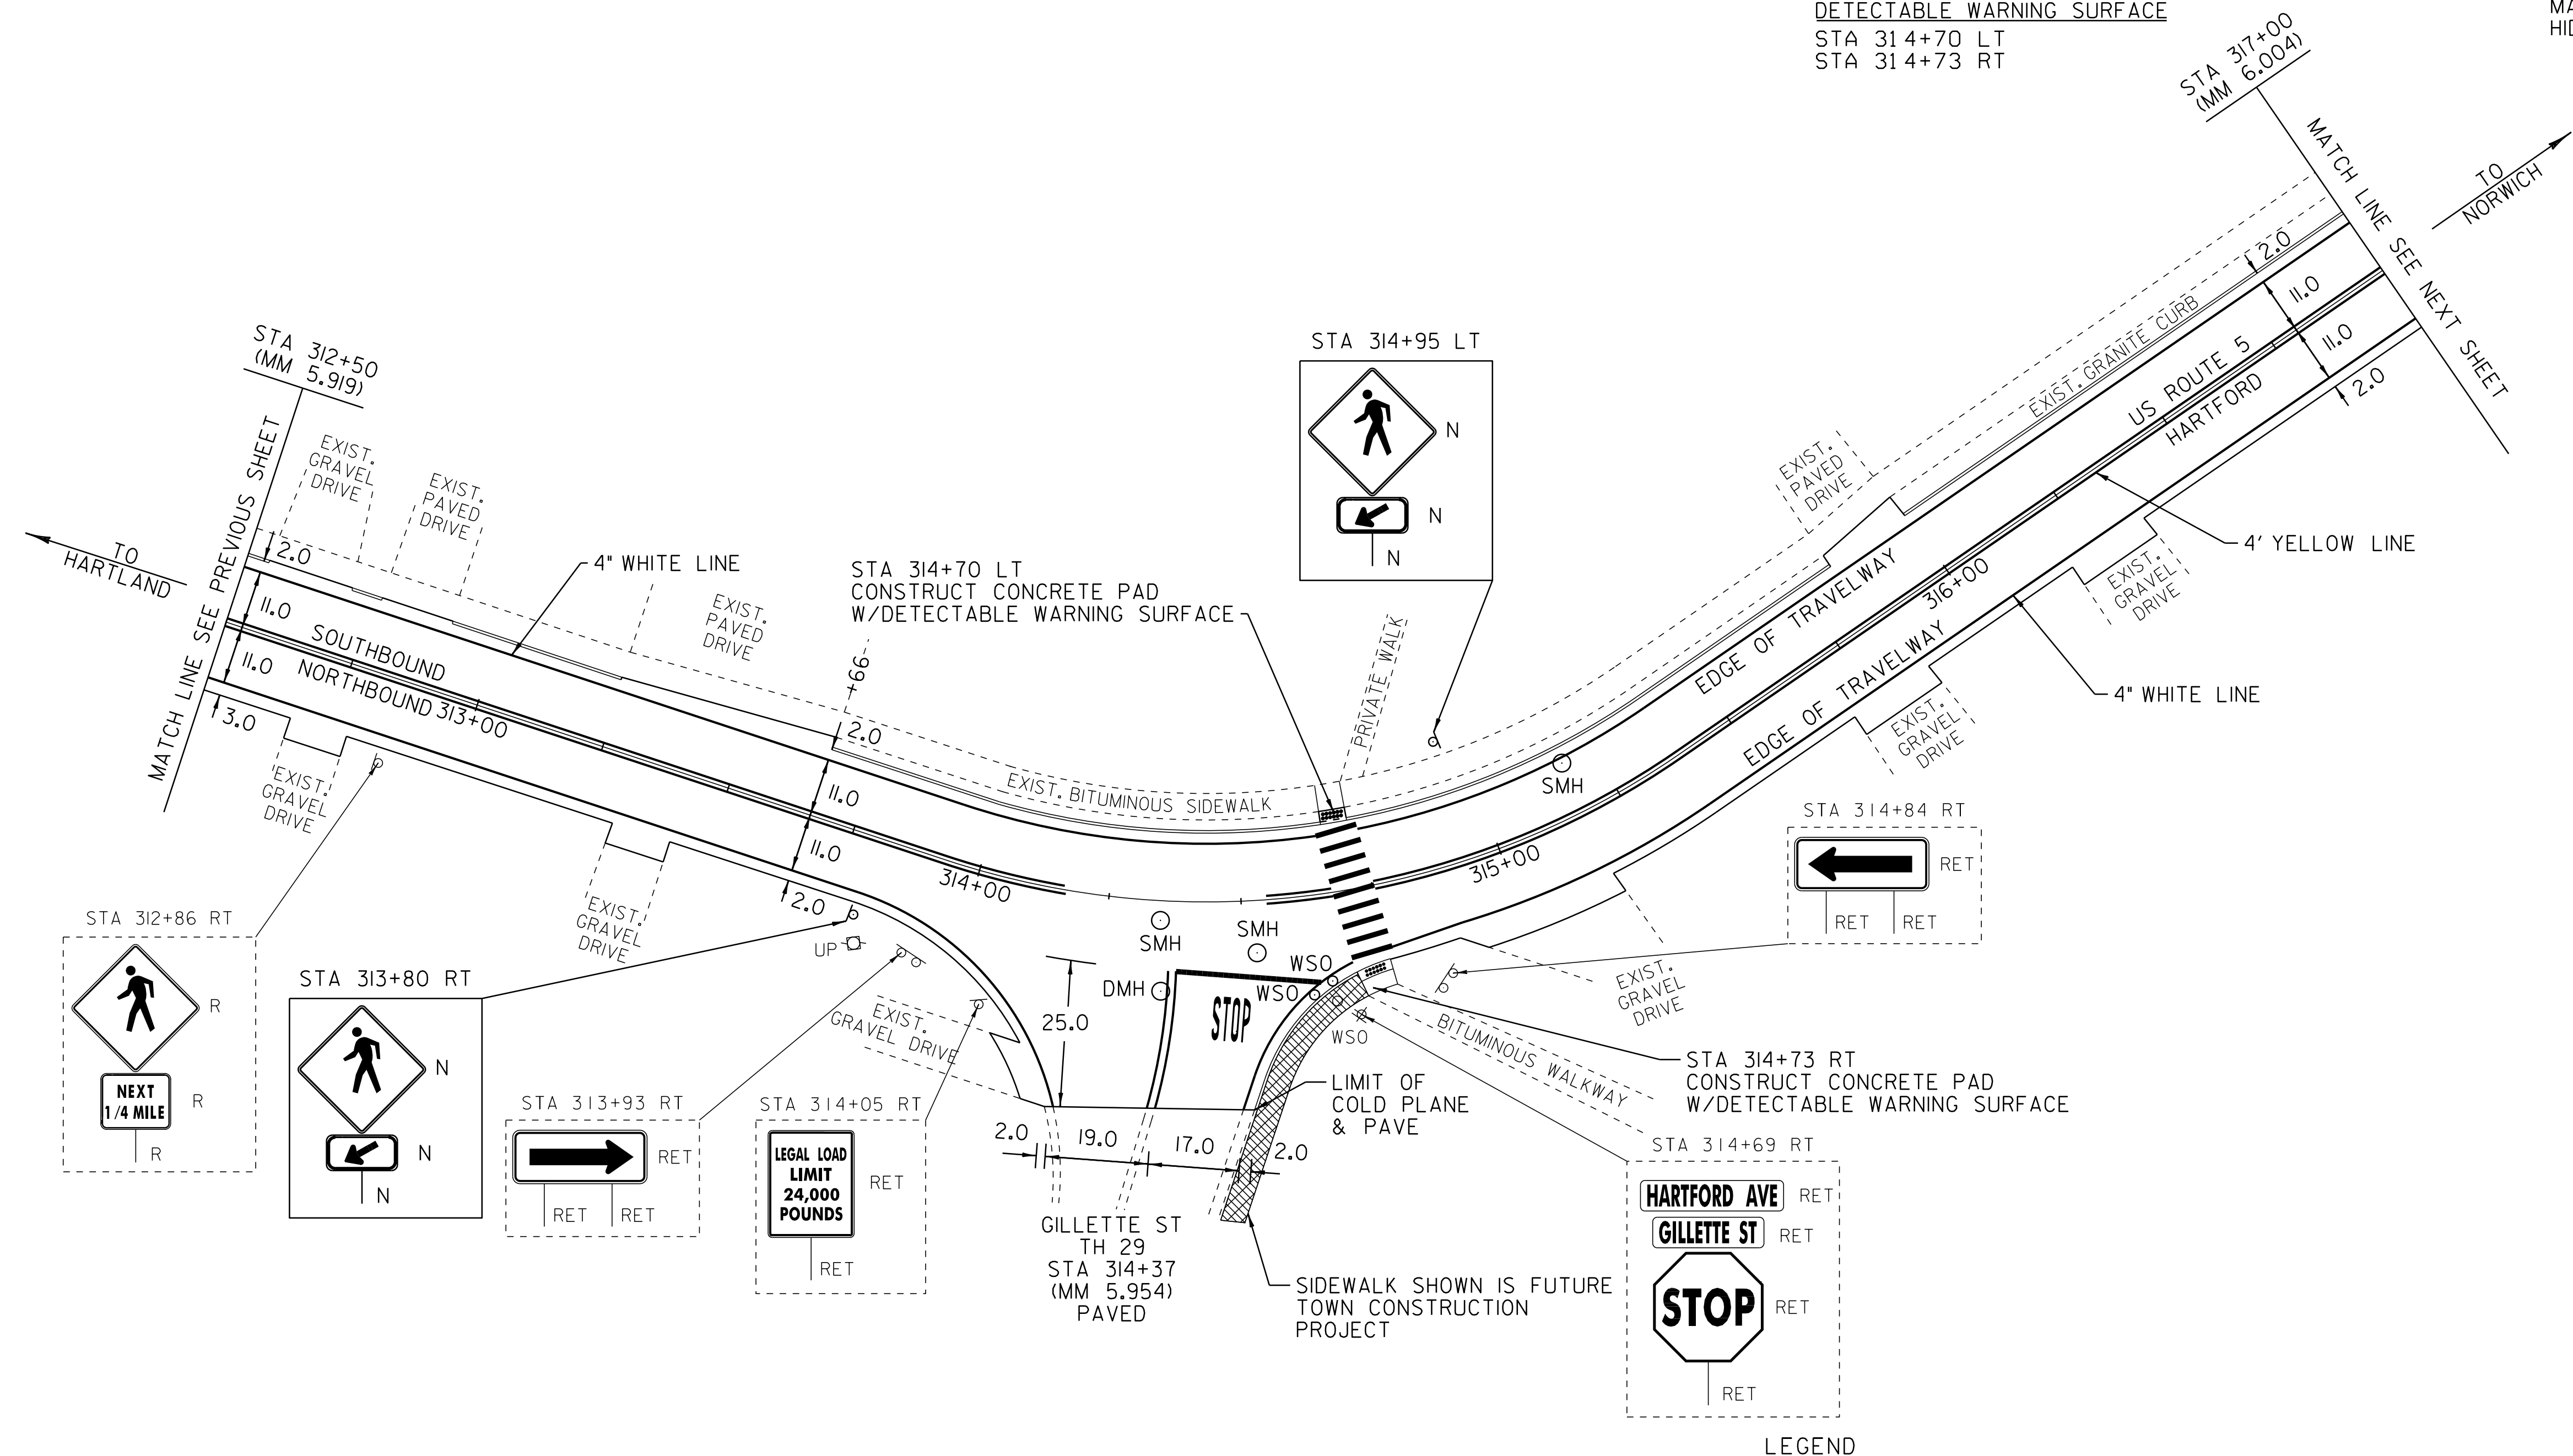

- LEGEND
- R = REMOVE EXISTING
 - S = SALVAGE
 - R&S = REMOVE AND SALVAGE
 - N = NEW
 - RET = RETAIN
 - B-B = BACK TO BACK
 - — — = EXISTING GUARDRAIL
 - — — = PROPOSED GUARDRAIL
 - ⚡ = TYPE I DELINEATOR, WHITE

PAVING LAYOUT SHEET 21	PROJECT NAME: HARTFORD-NORWICH	PLOT DATE: 14-FEB-2012 15:50
	PROJECT NUMBER: STP 2206(1)S	DRAWN BY: MRS
	FILE NAME: /pave/99cl64/pci64	CHECKED BY: NLL
	PROJECT LEADER: PTS	SHEET 45 OF 137
	DESIGNED BY: NLL	
	IPARM FILE NAME: pci64la2li	

NOT TO SCALE