

TEMPORARY 4" WHITE LINE, PAINT
 DURABLE 4" WHITE LINE, THERMOPLASTIC
 STA 317+00 TO 317+23 SOLID RT
 STA 317+00 TO 318+52 SOLID LT
 STA 317+23 TO 317+49 SOLID RT (TH 30)
 STA 317+70 TO 317+99 SOLID RT (TH 30)
 STA 317+99 TO 322+50 SOLID RT
 STA 319+30 TO 322+50 SOLID LT

TEMPORARY 4" YELLOW LINE, PAINT
 DURABLE 4" YELLOW LINE, THERMOPLASTIC
 STA 317+00 TO 317+32 SOLID LT & RT
 STA 317+52 DOUBLE SOLID RT (TH 30)
 STA 317+72 TO 318+68 SOLID LT & RT
 STA 318+88 DOUBLE SOLID LT (COLONIAL DR)
 STA 319+08 TO 322+50 SOLID LT & RT

TEMPORARY LETTER OR SYMBOL, PAINT
 DURABLE LETTER OR SYMBOL, THERMOPLASTIC
 STA 317+64 RT - "STOP" (TH 30)
 STA 318+83 LT - "STOP" (COLONIAL DR)

TEMPORARY 24" STOP BAR, PAINT
 DURABLE 24" STOP BAR, THERMOPLASTIC
 STA 317+57 TO 317+78 RT (TH 30)
 STA 318+73 TO 318+87 LT (COLONIAL DR)

TEMPORARY CROSSWALK MARKING, PAINT
 DURABLE CROSSWALK MARKING, THERMOPLASTIC
 STA 318+69 TO 319+03 LT (COLONIAL DR)

REMOVAL AND DISPOSAL OF GUARDRAIL
 STA 318+65.0 TO ~~319+77.5~~ RT 319+65 RT
 STA 319+17.0 TO 319+89.0 LT

STEEL BEAM GUARDRAIL, GALVANIZED
 STA 318+65.0 TO ~~319+77.5~~ RT 318+77.5 RT
 STA 319+17.0 TO 319+92.0 LT
 319+40 - 319+52.5 RT

ANCHOR FOR STEEL BEAM RAIL

STA 318+65.0 RT
 STA 319+17.0 LT
 STA 319+77.5 RT
 STA 319+92.0 LT

PORTLAND CEMENT CONCRETE SIDEWALK, 5 INCH
 STA 318+64 TO 318+70 LT (LANDING)

DETECTABLE WARNING SURFACE
 STA 318+69 LT

STEEL BEAM GUARDRAIL, GALV. (MOD)
 318+77.5 - 319+40 RT

CHANGING ELEVATION OF SEWER MANHOLES (NON PART.)
 STA 317+52 RT (PAVED OVER)
 STA 318+89 LT
 STA 320+09 LT
 STA 321+30 LT


ADJUST ELEVATION OF VALVE BOX (NON PART.)

STA 317+64 RT
 STA 317+73 RT
 STA 317+90 RT
 STA 318+12 LT

~~THINNING AND TRIMMING FOR SIGNS~~
~~STA 319+03 LT~~

REMOVING SIGNS
 AS SHOWN - 5

ERECTING SALVAGED SIGNS
 AS SHOWN - 2

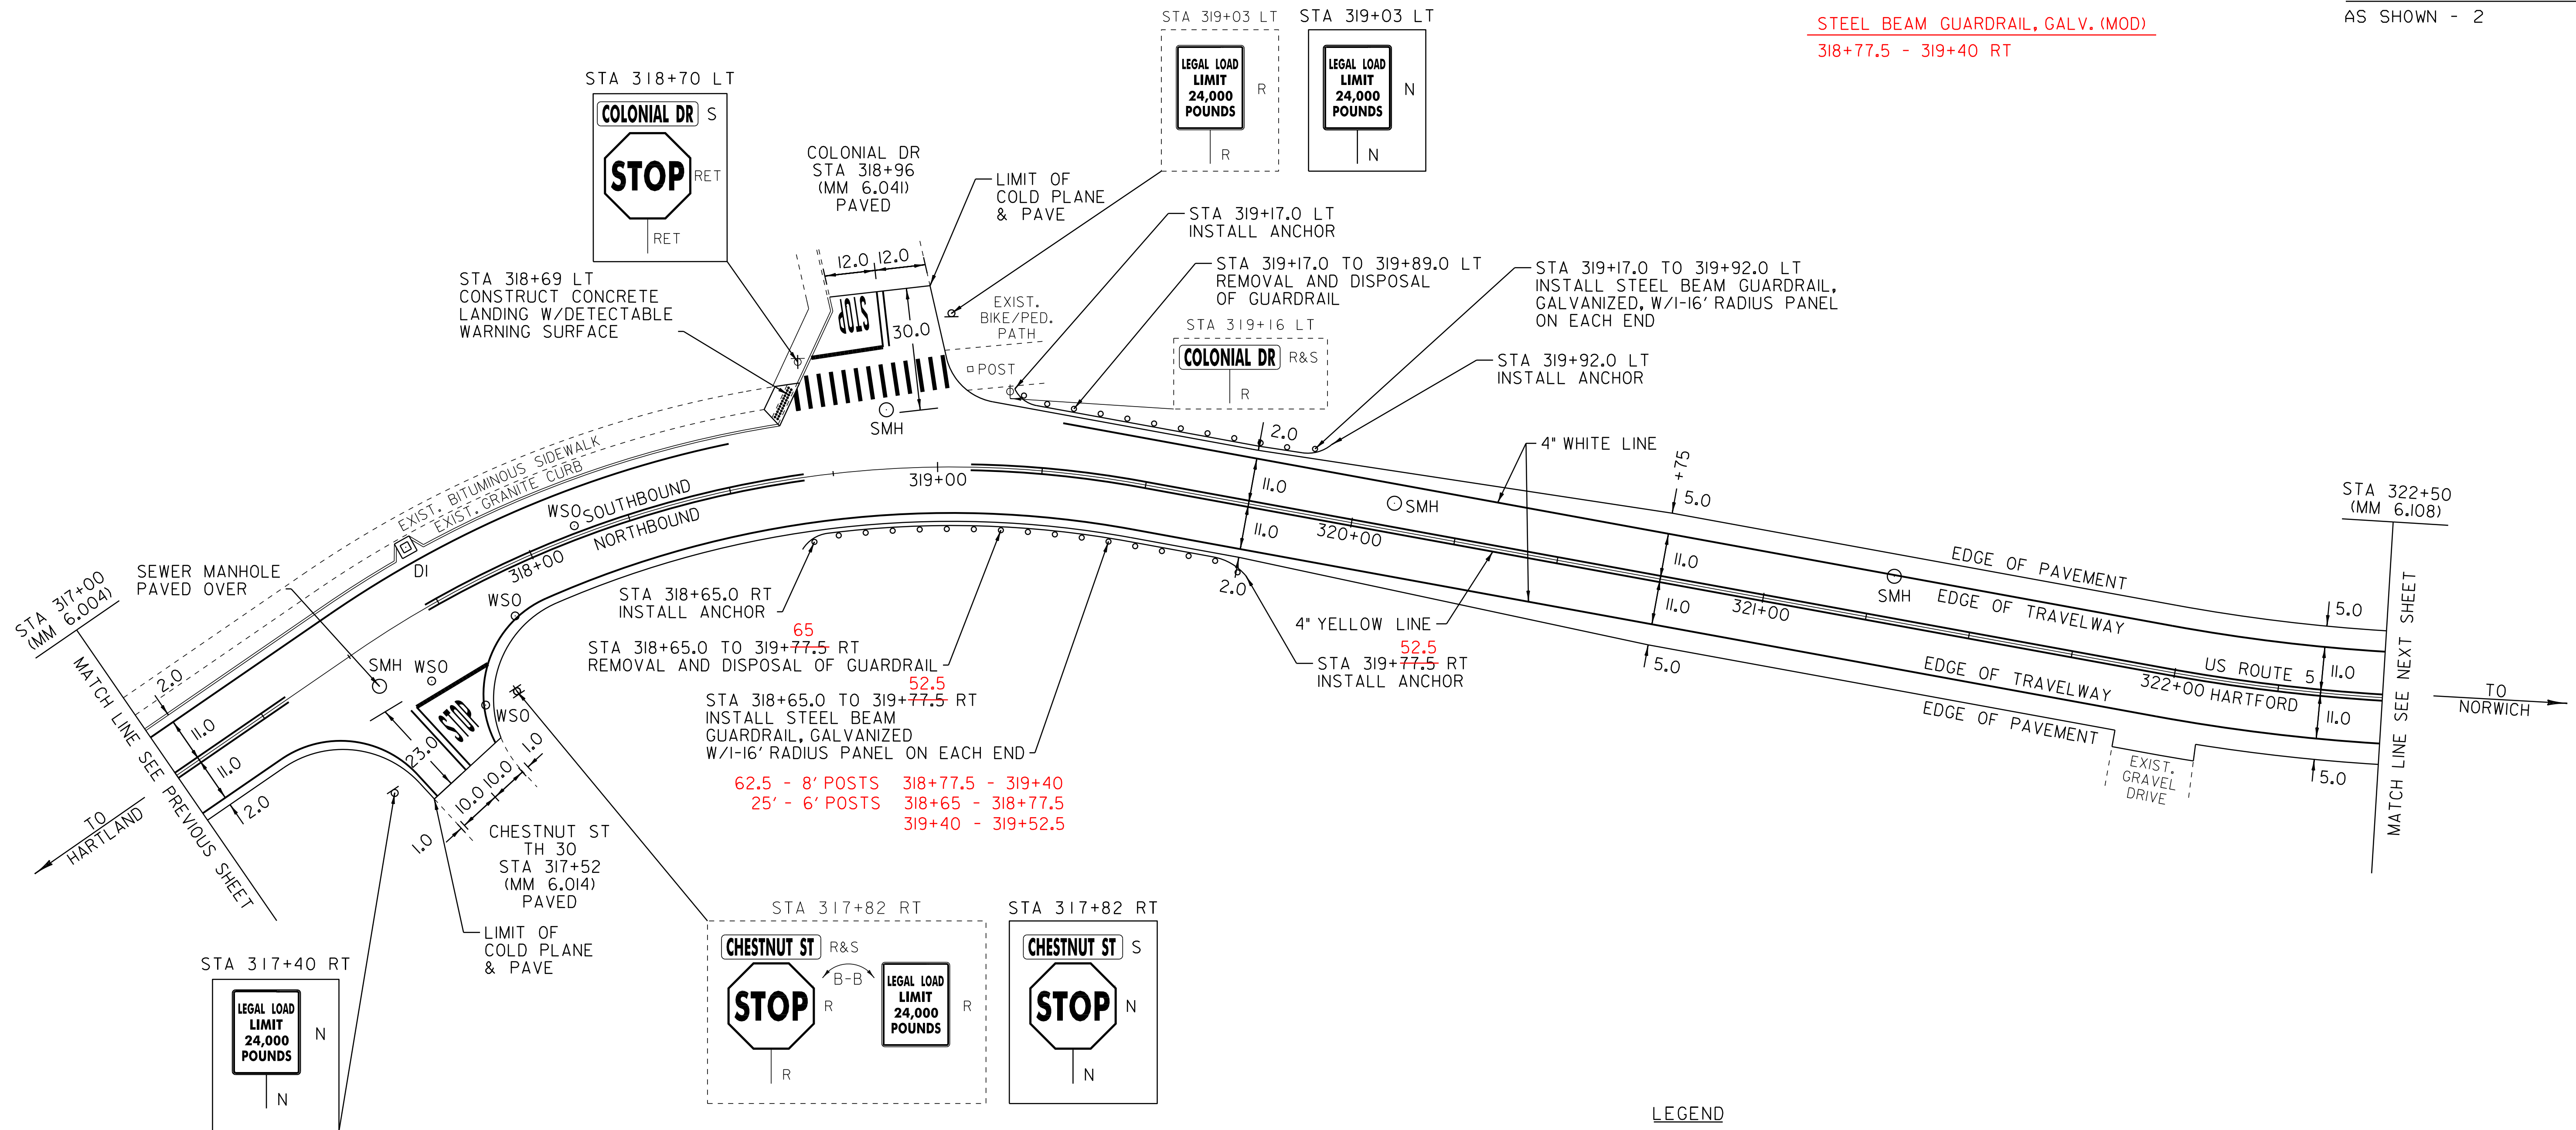

LEGEND

- R = REMOVE EXISTING
- S = SALVAGE
- R&S = REMOVE AND SALVAGE
- N = NEW
- RET = RETAIN
- B-B = BACK TO BACK
- — — = EXISTING GUARDRAIL
- — — = PROPOSED GUARDRAIL
- ⊙ = TYPE I DELINEATOR, WHITE

NOT TO SCALE

PAVING LAYOUT SHEET 22	PROJECT NAME: HARTFORD-NORWICH	PLOT DATE: 14-FEB-2012 15:50
	PROJECT NUMBER: STP 2206(1)S	DRAWN BY: MRS
	FILE NAME: /pave/99cl64/pci64	CHECKED BY: NLL
	PROJECT LEADER: PTS	SHEET 46 OF 137
	DESIGNED BY: NLL	
	IPARM FILE NAME: pci64la22.i	