


TEMPORARY 4" WHITE LINE, PAINT
 DURABLE 4" WHITE LINE, THERMOPLASTIC
 STA 322+50 TO 327+00 SOLID LT & RT

TEMPORARY 4" YELLOW LINE, PAINT
 DURABLE 4" YELLOW LINE, THERMOPLASTIC
 STA 322+50 TO 327+00 SOLID LT & RT

REMOVAL AND DISPOSAL OF GUARDRAIL
 STA 322+52.0 TO 326+77.0 RT
 STEEL BEAM GUARDRAIL, GALVANIZED
 STA 322+52.0 TO ~~327+00.0 RT~~
 326+89.5 RT
 ANCHOR FOR STEEL BEAM RAIL
 STA 322+52.0 RT
 STA 326+89.5 RT

CHANGING ELEVATION
 OF SEWER MANHOLES (NON PART.)
 STA 323+10 LT
 STA 324+96 LT

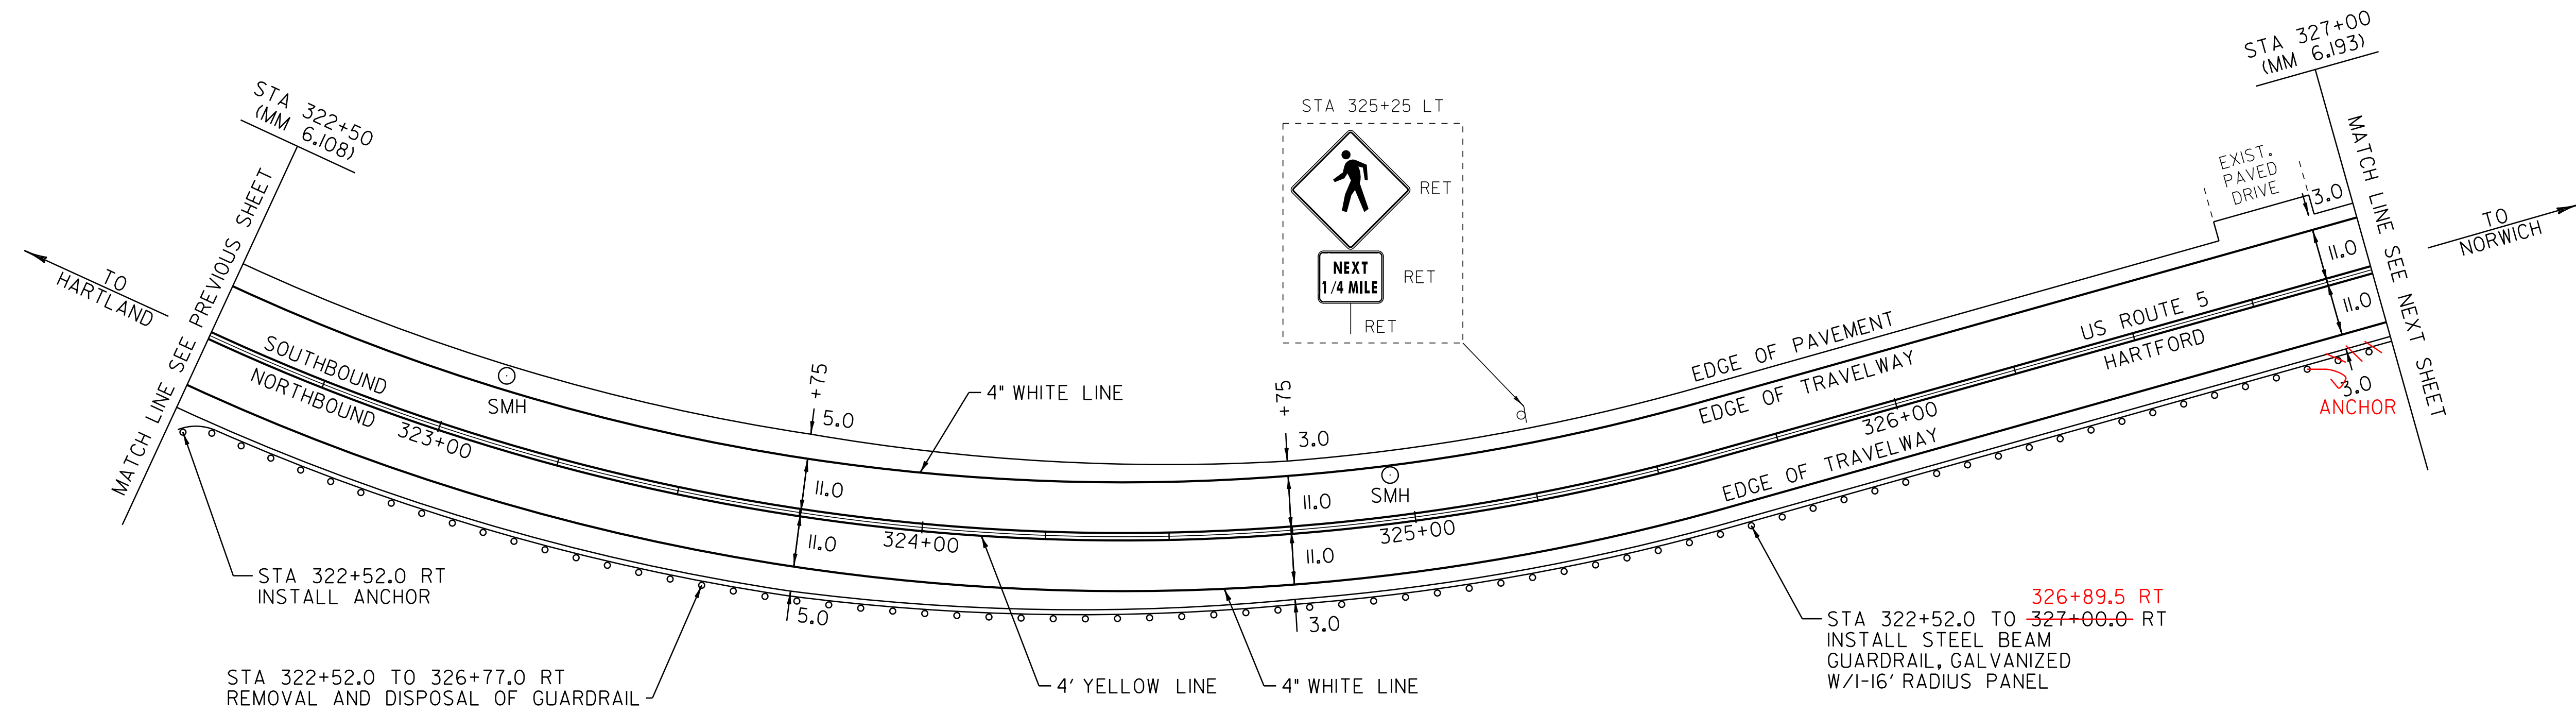

LEGEND

- R = REMOVE EXISTING
- S = SALVAGE
- R&S = REMOVE AND SALVAGE
- N = NEW
- RET = RETAIN
- B-B = BACK TO BACK
- — — = EXISTING GUARDRAIL
- — — = PROPOSED GUARDRAIL
- ⌢ = TYPE I DELINEATOR, WHITE

NOT TO SCALE

| | | |
|---------------------------------------|--------------------------------|------------------------------|
| PAVING LAYOUT SHEET 23 | PROJECT NAME: HARTFORD-NORWICH | PLOT DATE: 14-FEB-2012 15:51 |
| | PROJECT NUMBER: STP 2206(1)S | DRAWN BY: MRS |
| | FILE NAME: /pave/99cl64/pci64 | CHECKED BY: NULL |
| | PROJECT LEADER: PTS | SHEET 47 OF 137 |
| | DESIGNED BY: NULL | |
| | IPARM FILE NAME: | |