


TEMPORARY 4" WHITE LINE, PAINT  
 DURABLE 4" WHITE LINE, THERMOPLASTIC  
 STA 327+00 TO 331+00 SOLID LT & RT

TEMPORARY 4" YELLOW LINE, PAINT  
 DURABLE 4" YELLOW LINE, THERMOPLASTIC  
 STA 327+00 TO 331+00 SOLID LT & RT

~~STEEL BEAM GUARDRAIL, GALVANIZED  
 STA 327+00.0 TO 327+25.0 RT  
 ANCHOR FOR STEEL BEAM RAIL  
 STA 327+25.0 RT~~

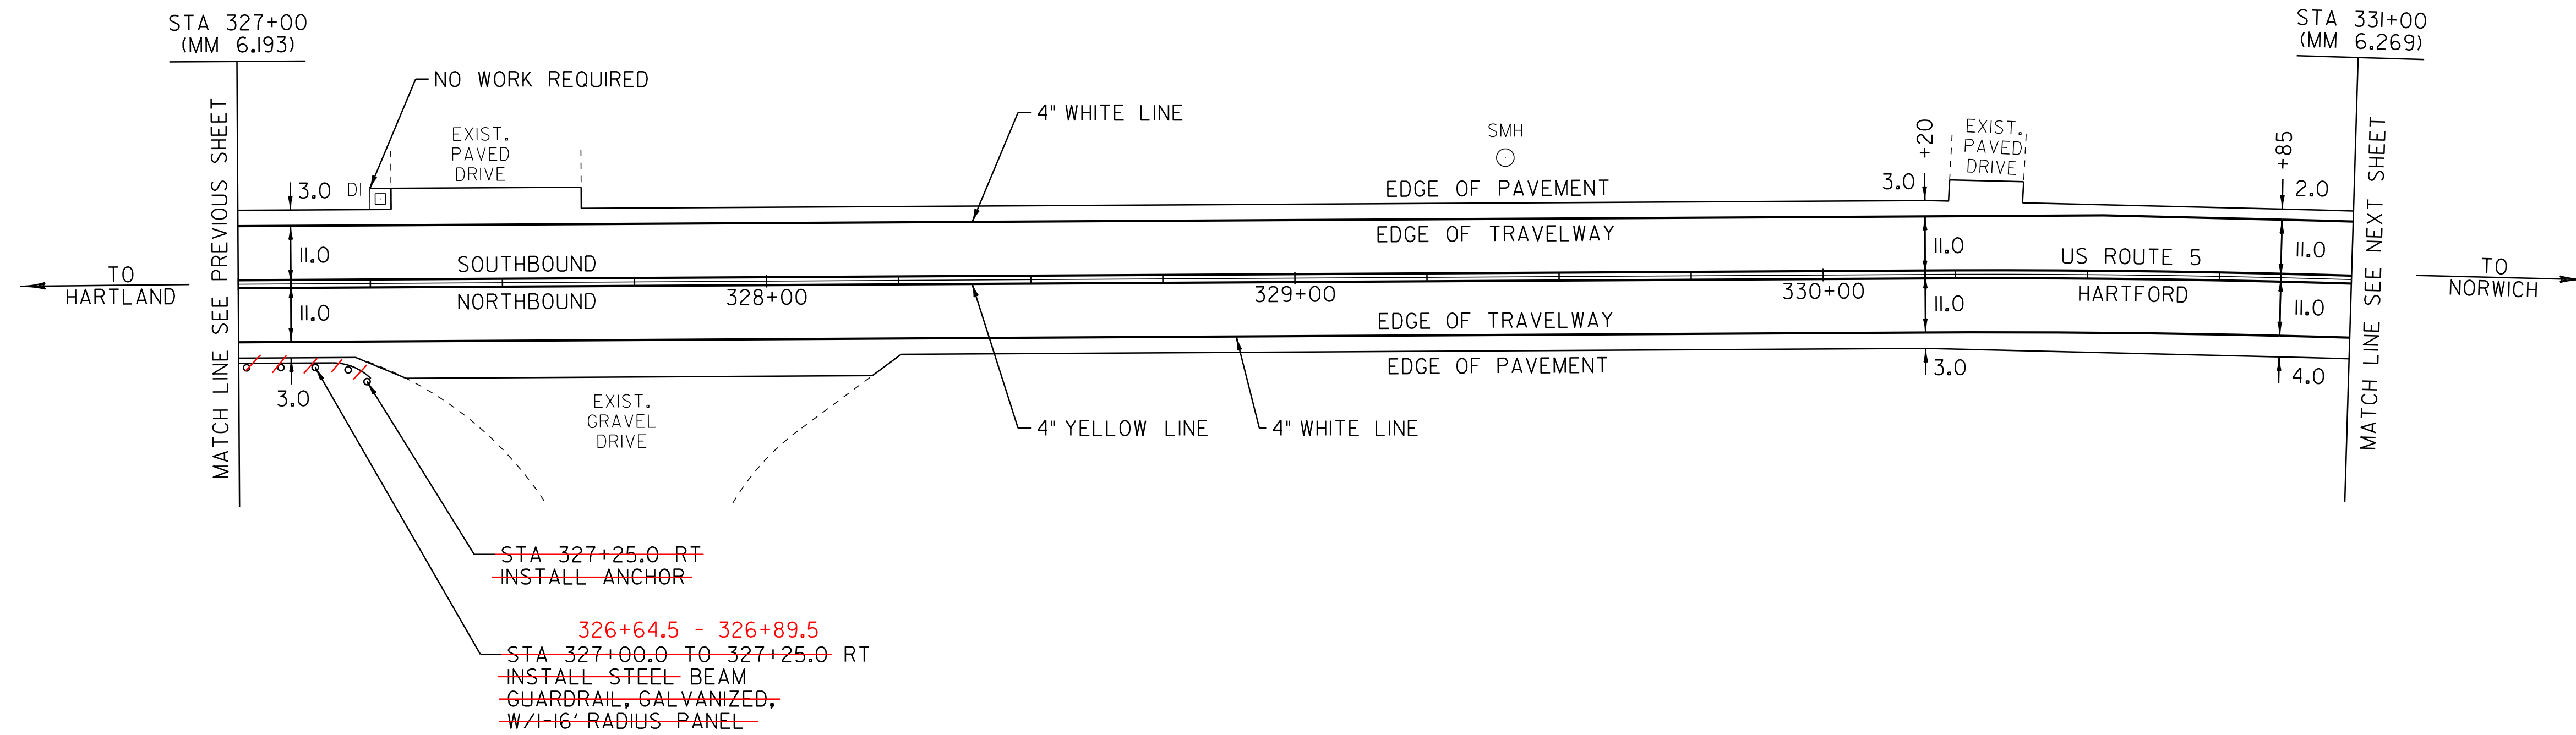

~~STA 327+25.0 RT  
 INSTALL ANCHOR~~  
~~326+64.5 - 326+89.5  
 STA 327+00.0 TO 327+25.0 RT  
 INSTALL STEEL BEAM  
 GUARDRAIL, GALVANIZED,  
 W/16' RADIUS PANEL~~

LEGEND

- R = REMOVE EXISTING
- S = SALVAGE
- R&S = REMOVE AND SALVAGE
- N = NEW
- RET = RETAIN
- B-B = BACK TO BACK
- — — = EXISTING GUARDRAIL
- — — = PROPOSED GUARDRAIL
- ⊙ = TYPE I DELINEATOR, WHITE

<b>PAVING LAYOUT SHEET 24</b>	PROJECT NAME: HARTFORD-NORWICH	
	PROJECT NUMBER: STP 2206(1)S	
	FILE NAME: /pave/99cl64/pcl64	PLOT DATE: 14-FEB-2012 15:51
	PROJECT LEADER: PTS	DRAWN BY: MRS
DESIGNED BY: NLL	CHECKED BY: NLL	
IPARM FILE NAME: pcl64la24.i	SHEET 48 OF 137	

NOT TO SCALE