


TEMPORARY 4" WHITE LINE, PAINT
 DURABLE 4" WHITE LINE, THERMOPLASTIC
 STA 336+00 TO 340+50 SOLID LT & RT

TEMPORARY 4" YELLOW LINE, PAINT
 DURABLE 4" YELLOW LINE, THERMOPLASTIC
 STA 336+00 TO 340+50 SOLID LT & RT

SHOULDER BERM REMOVAL
 STA 337+88 TO 340+50 LT 71' RT SIDE
 70' LT SIDE
 SNOW BARRIER - GALVANIZED W/ ALUMINUM MESH
 BRIDGE #75A (SB OVERPASS) 60 FT EACH SIDE
 BRIDGE #75A (NB OVERPASS) 60 FT EACH SIDE
 64' RT SIDE - 71' LT SIDE

CHANGE ELEV. OF SMH
 336+29 RT

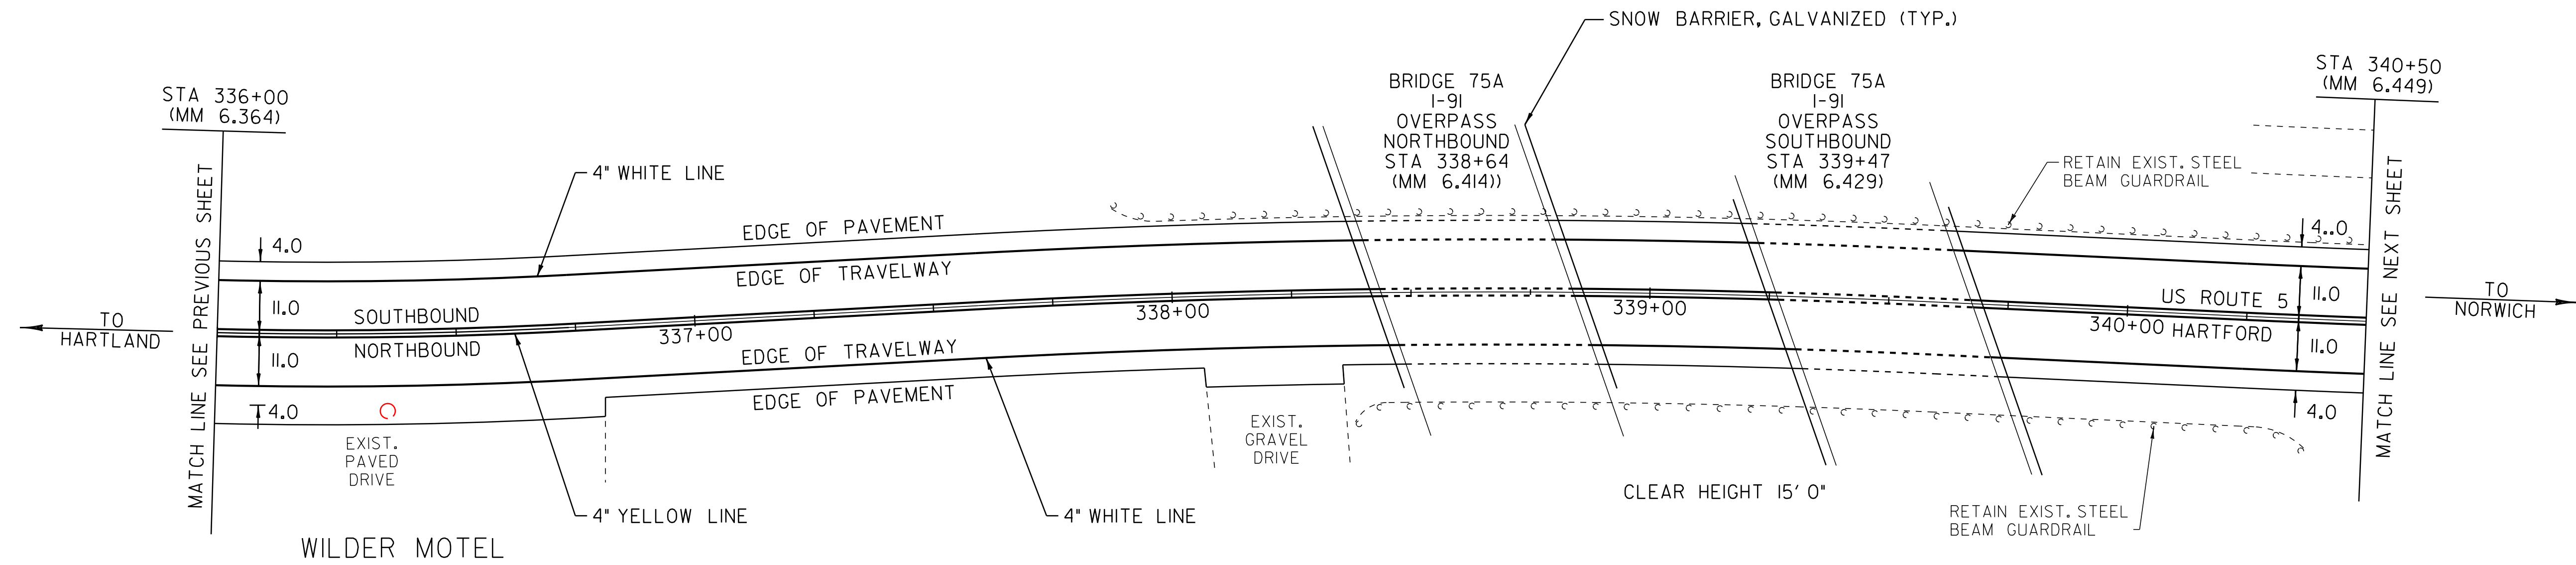

LEGEND

- R = REMOVE EXISTING
- S = SALVAGE
- R&S = REMOVE AND SALVAGE
- N = NEW
- RET = RETAIN
- B-B = BACK TO BACK
- — — = EXISTING GUARDRAIL
- — — = PROPOSED GUARDRAIL
- ↑ = TYPE I DELINEATOR, WHITE

NOT TO SCALE

PAVING LAYOUT SHEET 26	PROJECT NAME: HARTFORD-NORWICH	PLOT DATE: 14-FEB-2012 15:51
	PROJECT NUMBER: STP 2206(1)S	DRAWN BY: MRS
	DESIGNED BY: NULL	CHECKED BY: NULL
	IPARM FILE NAME: pcl64la26.i	SHEET 50 OF 137