


TEMPORARY 4" WHITE LINE, PAINT
 DURABLE 4" WHITE LINE, THERMOPLASTIC
 STA 340+50 TO 345+50 SOLID LT & RT

TEMPORARY 4" YELLOW LINE, PAINT
 DURABLE 4" YELLOW LINE, THERMOPLASTIC
 STA 340+50 TO 345+50 SOLID LT & RT

CHANGING ELEVATION
 OF SEWER MANHOLES (NON PART.)
 STA 342+14 RT

~~SHOULDER BERM REMOVAL
 STA 340+50 TO 340+63 LT~~

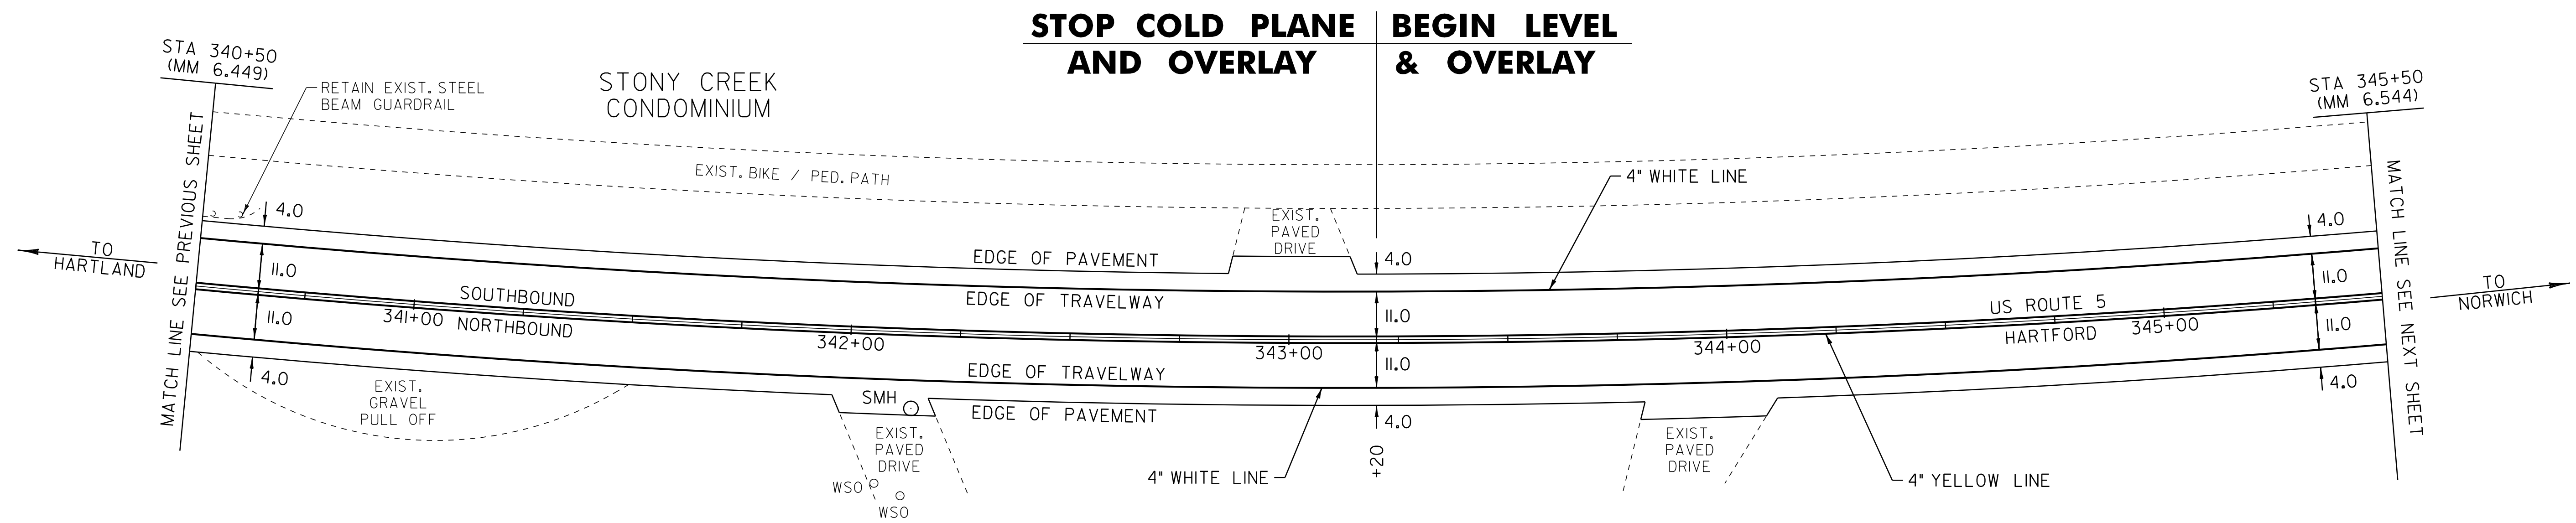

STOP COLD PLANE AND OVERLAY | BEGIN LEVEL & OVERLAY

STONY CREEK CONDOMINIUM

LEGEND

- R = REMOVE EXISTING
- S = SALVAGE
- R&S = REMOVE AND SALVAGE
- N = NEW
- RET = RETAIN
- B-B = BACK TO BACK
- = EXISTING GUARDRAIL
- - - = PROPOSED GUARDRAIL
- ↑ = TYPE I DELINEATOR, WHITE

PAVING LAYOUT SHEET 27	PROJECT NAME: HARTFORD-NORWICH	PLOT DATE: 14-FEB-2012 15:51
	PROJECT NUMBER: STP 2206(1)S	DRAWN BY: MRS
	FILE NAME: /pave/99c164/pci64	CHECKED BY: NULL
	DESIGNED BY: NULL	SHEET 51 OF 137
	IPARM FILE NAME: pci64la27.i	

NOT TO SCALE