

TEMPORARY 4" WHITE LINE, PAINT
 DURABLE 4" WHITE LINE, THERMOPLASTIC
 STA 351+00 TO 356+50 SOLID LT & RT

TEMPORARY 4" YELLOW LINE, PAINT
 DURABLE 4" YELLOW LINE, THERMOPLASTIC
 STA 351+00 TO 356+50 SOLID LT & RT


REMOVAL AND DISPOSAL OF GUARDRAIL
 STA 353+50.0 TO 356+50.0 LT
 353+72

STEEL BEAM GUARDRAIL, GALVANIZED W/8' POSTS
 STA 353+50.0 TO 356+50.0 LT W/ 104' OF 6' POSTS
 353+72

ANCHOR FOR STEEL BEAM RAIL
 STA 353+50.0 LT
 353+72

REHAB. DROP INLETS, CATCH BASINS,
 OR MANHOLES, CLASS I, CLASS II OR CLASS III
 STA 352+30 RT (CB)

BITUMINOUS CONCRETE GUTTERS
 AND TRAFFIC ISLANDS
 STA 352+30 TO 353+67 RT

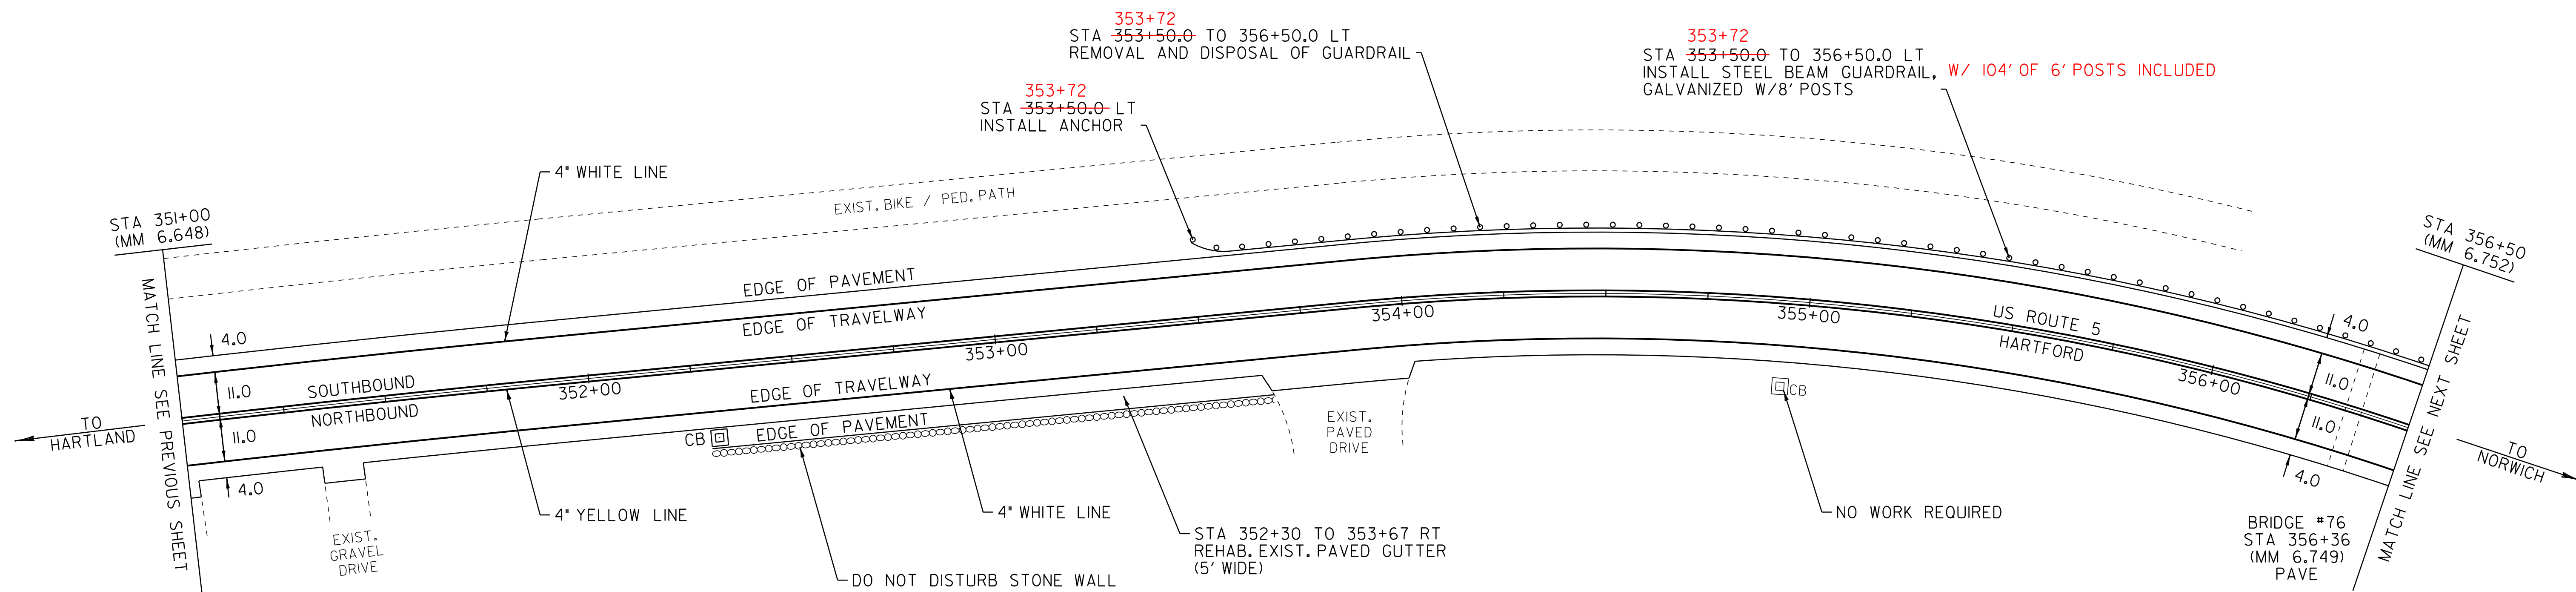

LEGEND

- R = REMOVE EXISTING
- S = SALVAGE
- R&S = REMOVE AND SALVAGE
- N = NEW
- RET = RETAIN
- B-B = BACK TO BACK
- = EXISTING GUARDRAIL
- - - = PROPOSED GUARDRAIL
- ↑ = TYPE I DELINEATOR, WHITE

NOT TO SCALE

PAVING LAYOUT SHEET 29	PROJECT NAME: HARTFORD-NORWICH	PLOT DATE: 14-FEB-2012 15:51
	PROJECT NUMBER: STP 2206(I)S	DRAWN BY: MRS
	FILE NAME: /pave/99cl64/pci64	CHECKED BY: NULL
	DESIGNED BY: NULL	SHEET 53 OF 137
	IPARM FILE NAME: pci64la29.i	