

TEMPORARY 4" WHITE LINE, PAINT  
 DURABLE 4" WHITE LINE, THERMOPLASTIC  
 STA 362+50 TO 362+78 SOLID LT LANE LINE  
 STA 362+50 TO 364+05 SOLID RT  
 STA 362+50 TO 363+85 SOLID LT  
 STA 362+78 TO 363+85 DOTTED LT LANE LINE  
 STA 364+40 SOLID RT LANE LINE (TH 285)  
 STA 364+65 TO 368+00 SOLID LT  
 STA 364+55 TO 368+00 SOLID RT

TEMPORARY 4" YELLOW LINE, PAINT  
 DURABLE 4" YELLOW LINE, THERMOPLASTIC  
 STA 362+50 TO 364+08 SOLID LT & RT  
 STA 364+28 DOUBLE SOLID RT (TH 285)  
 STA 364+48 TO 366+73 SOLID LT & RT  
 STA 366+73 TO 368+00 DOUBLE SOLID LT & RT  
 DURABLE 8" YELLOW LINE, THERMOPLASTIC  
 STA 366+73 TO 368+00 SOLID LT & RT (GORE)

TEMPORARY LETTER OR SYMBOL, PAINT  
 STA 364+22 LT - "STOP" (SCHOOL)  
 STA 364+34 RT - "STOP" (TH 285)  
 STA 364+47 RT - "STOP" (TH 285)


REMOVING SIGNS  
 AS SHOWN - 12

ERECTING SALVAGED SIGNS  
 AS SHOWN - 1

DURABLE LETTER OR SYMBOL, THERMOPLASTIC  
 STA 362+74 LT - "ONLY"  
 STA 364+22 LT - "STOP" (SCHOOL)  
 STA 364+34 RT - "STOP" (TH 285)  
 STA 364+47 RT - "STOP" (TH 285)

TEMPORARY 24" STOP BAR, PAINT  
 DURABLE 24" STOP BAR, THERMOPLASTIC  
 STA 364+07 TO 364+36 LT (EXIST. PAVED DRIVE)  
 STA 364+28 TO 364+72 RT (TH 285)

ADJUST ELEVATION  
 OF VALVE BOX (NON PART.)  
 STA 364+21 LT

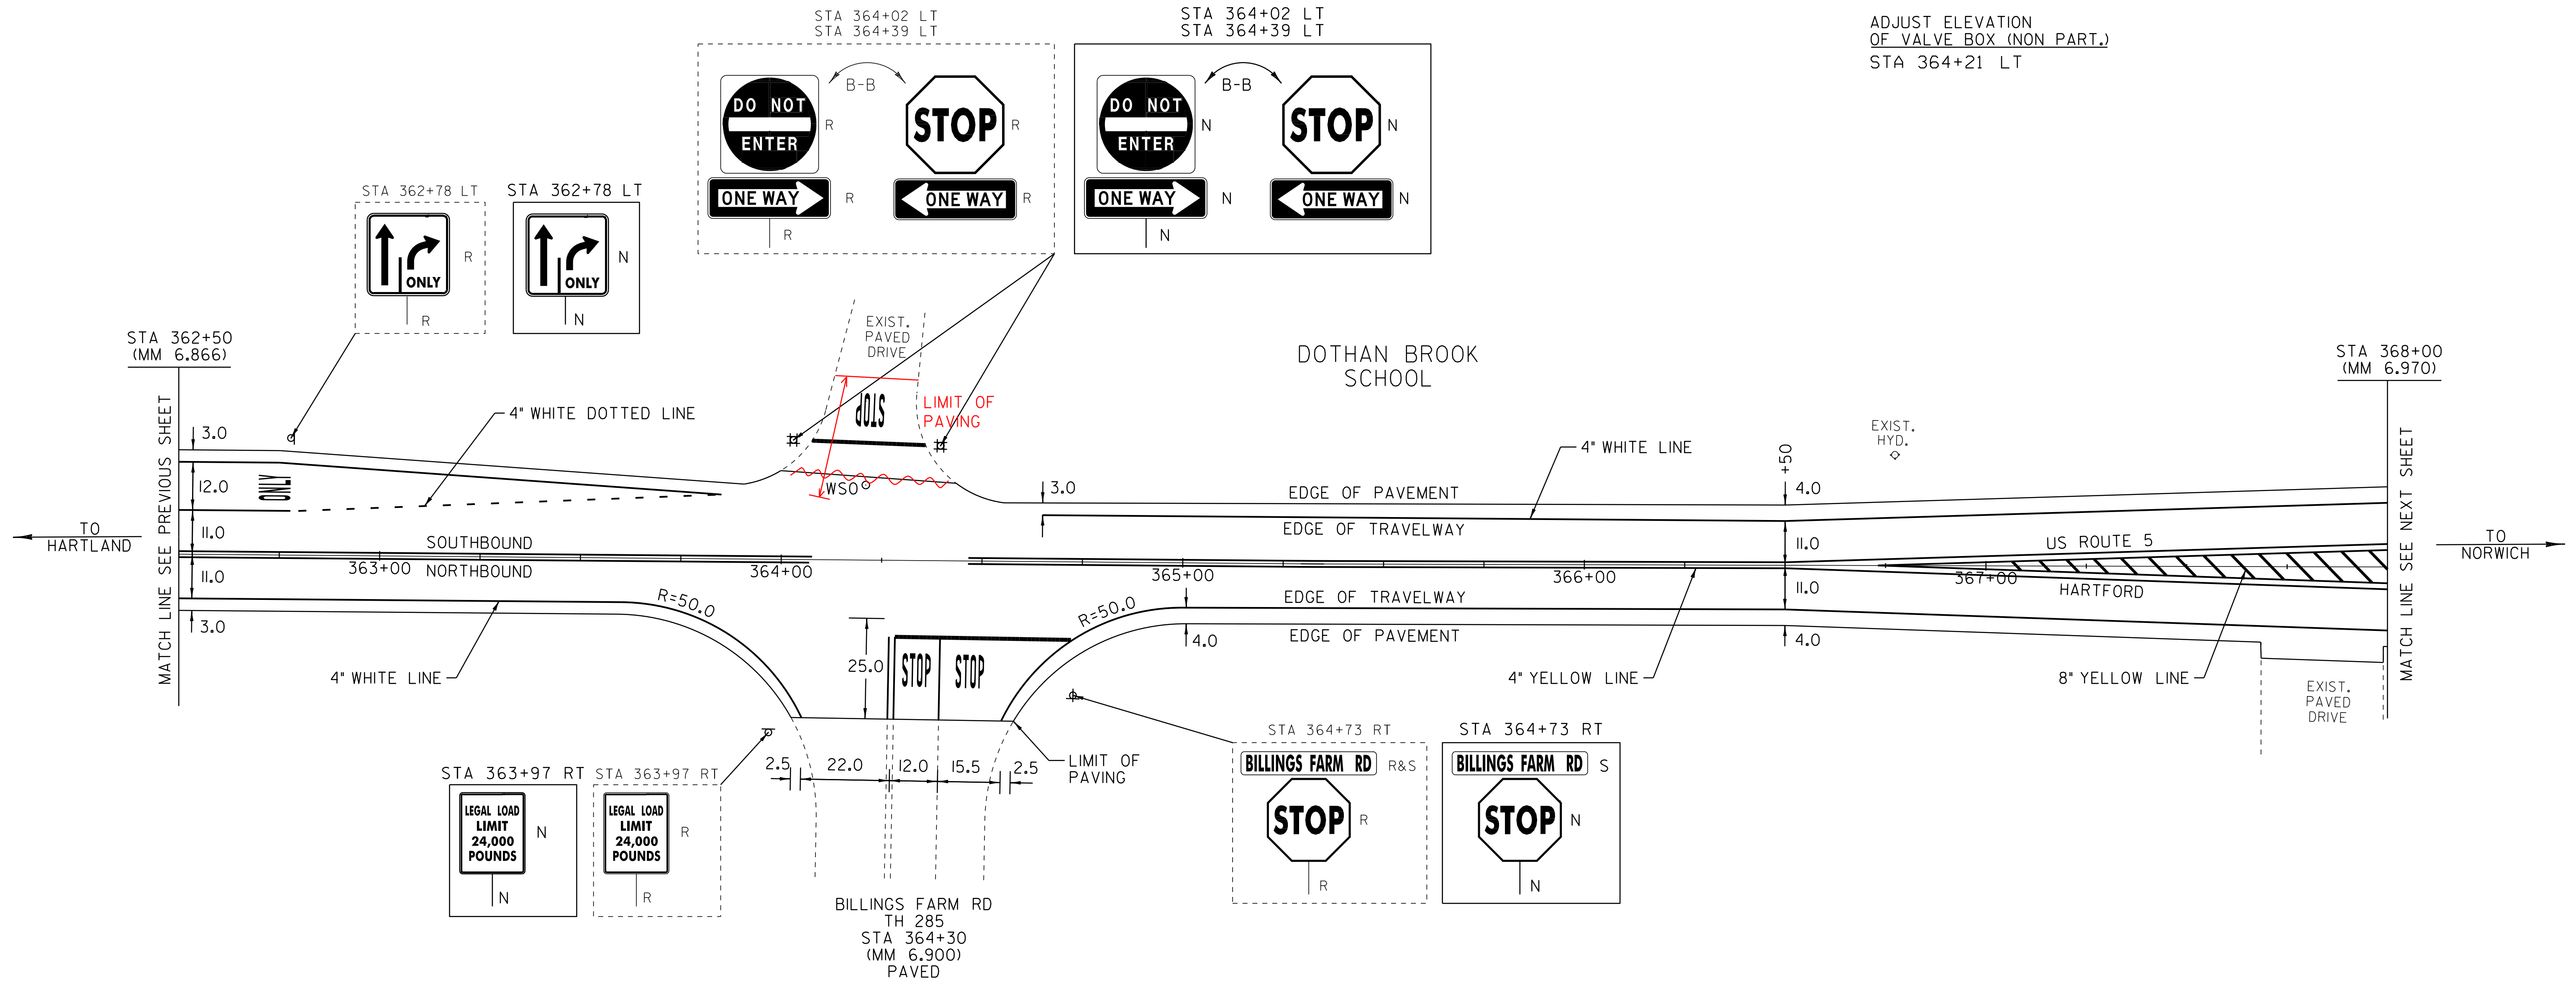

LEGEND

- R = REMOVE EXISTING
- S = SALVAGE
- R&S = REMOVE AND SALVAGE
- N = NEW
- RET = RETAIN
- B-B = BACK TO BACK
- — — = EXISTING GUARDRAIL
- — — = PROPOSED GUARDRAIL
- ∩ = TYPE I DELINEATOR, WHITE

NOT TO SCALE

<b>PAVING LAYOUT SHEET 31</b>	PROJECT NAME: HARTFORD-NORWICH	PLOT DATE: 14-FEB-2012 15:51
	PROJECT NUMBER: STP 2206(1)S	DRAWN BY: MRS
	FILE NAME: /pave/99cl64/pcl64	CHECKED BY: NLL
	PROJECT LEADER: PTS	SHEET 55 OF 137
	DESIGNED BY: NLL	
	IPARM FILE NAME: pcl64la3li	