

TEMPORARY 4" WHITE LINE, PAINT
 DURABLE 4" WHITE LINE, THERMOPLASTIC
 STA 373+50 TO 377+37 SOLID LT
 STA 373+50 TO 379+00 SOLID RT
 STA 377+61 TO 379+00 SOLID LT

TEMPORARY 4" YELLOW LINE, PAINT
 DURABLE 4" YELLOW LINE, THERMOPLASTIC
 STA 373+50 TO 374+79 DOUBLE SOLID LT & RT
 STA 374+79 TO 377+28 SOLID LT & RT
 STA 377+48 DOUBLE SOLID LT (TH 18)
 STA 377+68 TO 379+00 SOLID LT & RT

DURABLE 8" YELLOW LINE, THERMOPLASTIC
 STA 373+50 TO 374+79 SOLID LT & RT (GORE)

TEMPORARY LETTER OR SYMBOL, PAINT
 DURABLE LETTER OR SYMBOL, THERMOPLASTIC
 STA 377+41 LT - "STOP" (TH 18)
 STA 378+10 LT - "SCHOOL"

TEMPORARY 24" STOP BAR, PAINT
 DURABLE 24" STOP BAR, THERMOPLASTIC
 STA 377+26 TO 377+48 LT (TH 18)

CHANGING ELEVATION OF DROP INLETS,
 CATCH BASINS, OR MANHOLES
 STA 377+52 LT (CB) (TH 18)


ADJUST ELEVATION
 OF VALVE BOX (NON PART.)
 STA 375+05 LT
 STA 377+49 LT
 STA 377+70 LT
 STA 378+00 LT

REMOVING SIGNS
 AS SHOWN - 5

ERECTING SALVAGED SIGNS
 AS SHOWN - 1

CHANGE ELEV. OF
 SEWER MANHOLE
 374+80 RT

~~THINNING AND TRIMMING FOR SIGNS~~
~~STA 377+30 LT~~

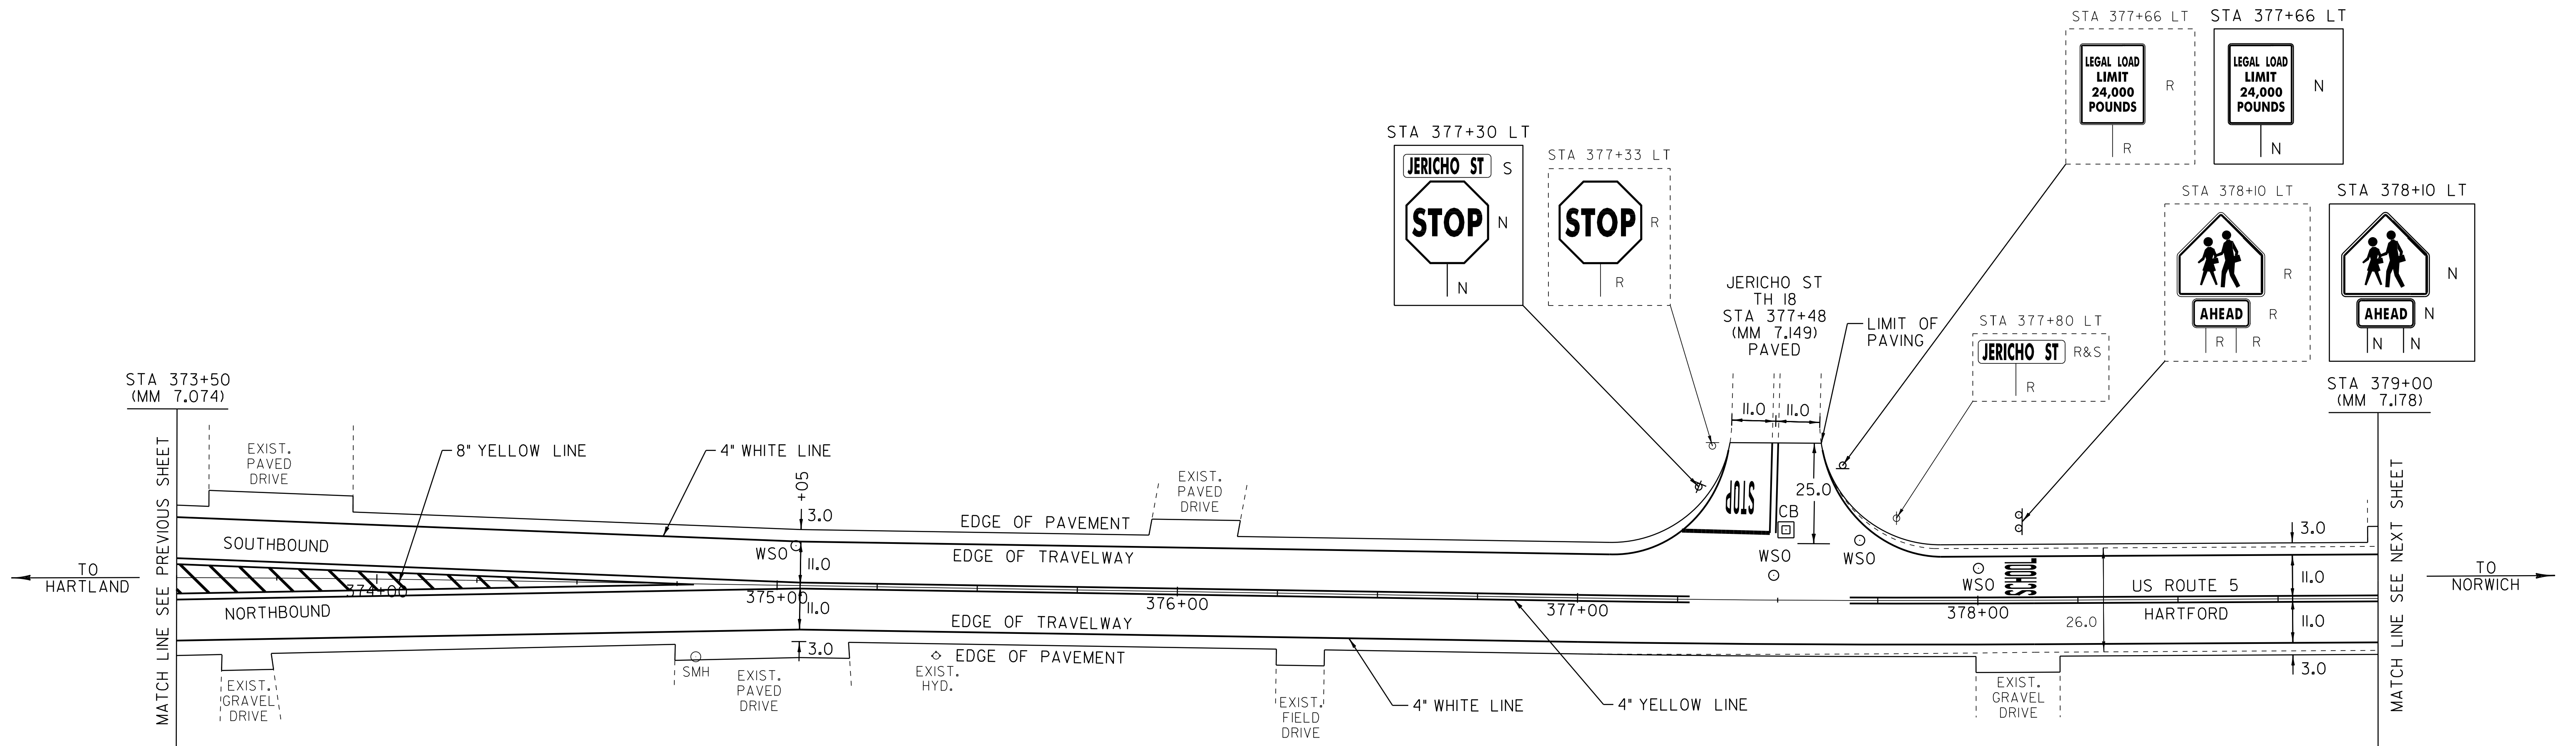

LEGEND

- R = REMOVE EXISTING
- S = SALVAGE
- R&S = REMOVE AND SALVAGE
- N = NEW
- RET = RETAIN
- B-B = BACK TO BACK
- — — = EXISTING GUARDRAIL
- — — = PROPOSED GUARDRAIL
- ⊙ = TYPE I DELINEATOR, WHITE

NOT TO SCALE

PAVING LAYOUT SHEET 33	PROJECT NAME: HARTFORD-NORWICH	PLOT DATE: 14-FEB-2012 15:51
	PROJECT NUMBER: STP 2206(1)S	DRAWN BY: MRS
	FILE NAME: /pave/99cl64/pci64	CHECKED BY: NLL
	DESIGNED BY: NLL	SHEET 57 OF 137
	IPARM FILE NAME: pci64la33.i	