

TEMPORARY 4" WHITE LINE, PAINT
 DURABLE 4" WHITE LINE, THERMOPLASTIC
 STA 379+00 TO 383+28 SOLID LT
 STA 379+00 TO 384+50 SOLID RT
 STA 383+75 TO 384+50 SOLID LT

TEMPORARY 4" YELLOW LINE, PAINT
 DURABLE 4" YELLOW LINE, THERMOPLASTIC
 STA 379+00 TO 383+31 SOLID LT & RT
 STA 383+51 DOUBLE SOLID LT (TH 287)
 STA 383+71 TO 384+50 SOLID LT & RT

TEMPORARY LETTER OR SYMBOL, PAINT
 DURABLE LETTER OR SYMBOL, THERMOPLASTIC
 STA 383+37 LT - "STOP" (TH 287)

TEMPORARY 24" STOP BAR, PAINT
 DURABLE 24" STOP BAR, THERMOPLASTIC
 STA 383+12 TO 383+51 LT (TH 287)

~~CHANGING ELEVATION
 OF SEWER MANHOLES (NON PART.)
 STA 374+80 RT~~


ADJUST ELEVATION
 OF VALVE BOX (NON PART.)
 STA 379+16 LT
 STA 383+63 LT (TH 287)

REHAB DROP INLETS, CATCH BASINS,
 OR MANHOLES, CLASS I, CLASS II OR CLASS III
 STA 382+69 LT

REMOVING SIGNS
 AS SHOWN - 3

ERECTING SALVAGED SIGNS
 AS SHOWN - 1

STONE FILL, TYPE I
 384+00 - 384+50 LT

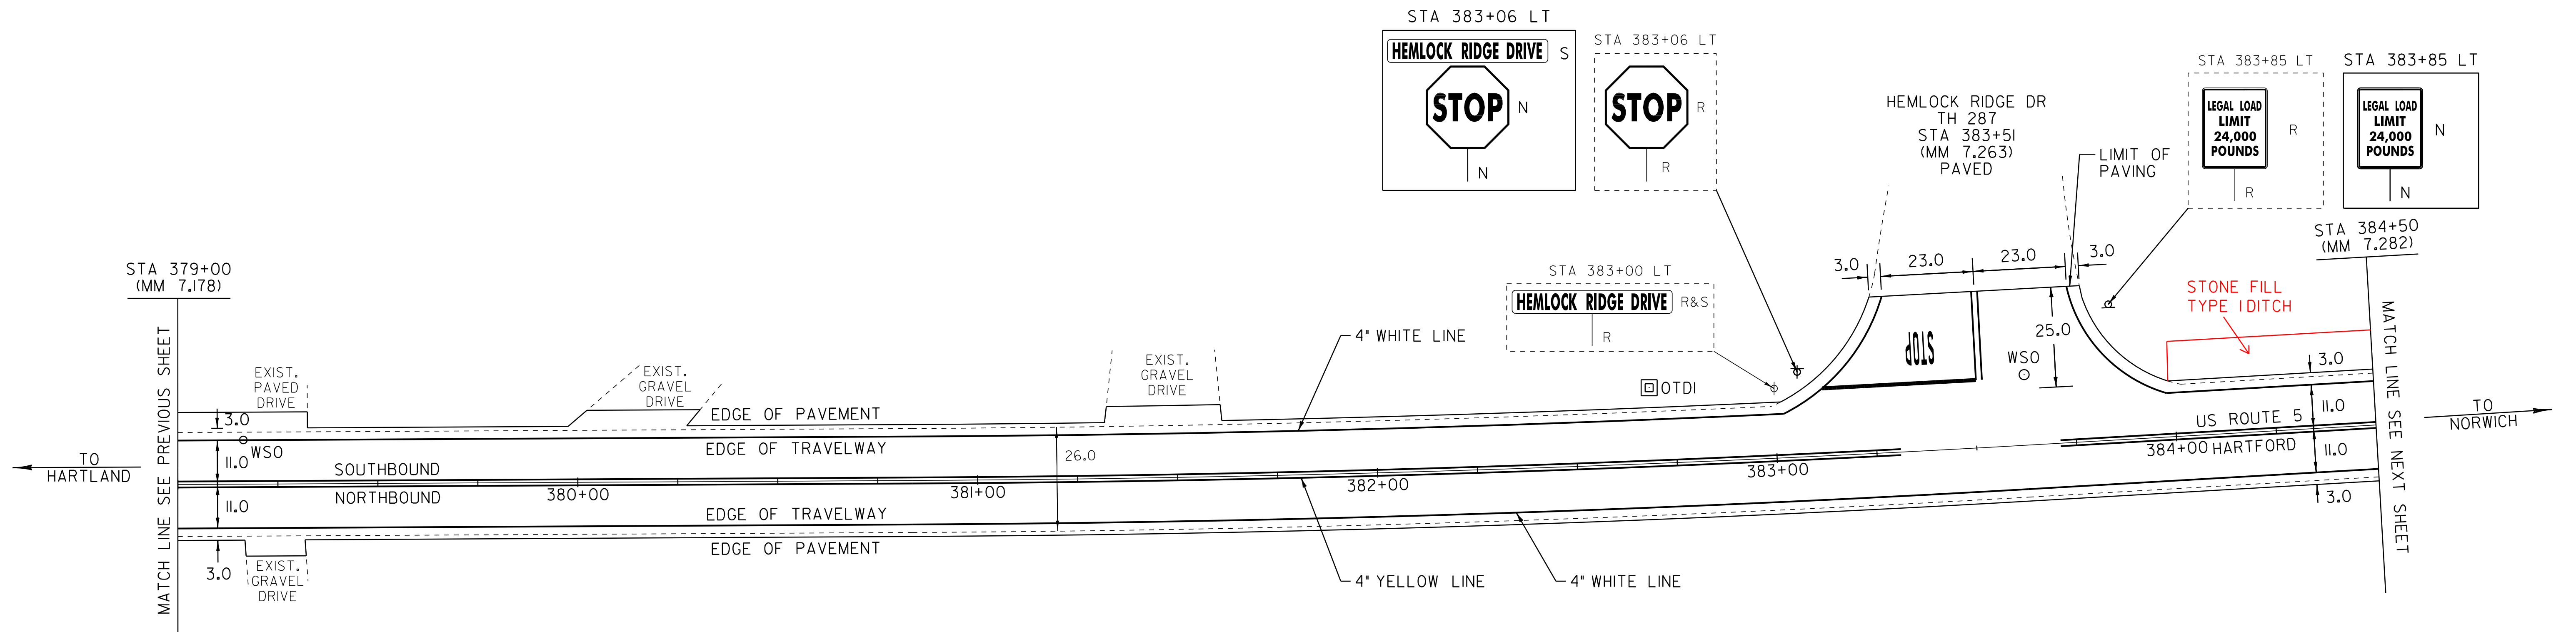

LEGEND

- R = REMOVE EXISTING
- S = SALVAGE
- R&S = REMOVE AND SALVAGE
- N = NEW
- RET = RETAIN
- B-B = BACK TO BACK
- — — = EXISTING GUARDRAIL
- — — = PROPOSED GUARDRAIL
- ⌢ = TYPE I DELINEATOR, WHITE

NOT TO SCALE

PAVING LAYOUT SHEET 34	PROJECT NAME: HARTFORD-NORWICH	
	PROJECT NUMBER: STP 2206(1)S	
	FILE NAME: /pave/99cl64/pci64	PLOT DATE: 14-FEB-2012 15:51
	PROJECT LEADER: PTS	DRAWN BY: MRS
DESIGNED BY: NLL	CHECKED BY: NLL	
IPARM FILE NAME: pci64la34.i	SHEET 58 OF 137	