

TEMPORARY 4" WHITE LINE, PAINT  
 DURABLE 4" WHITE LINE, THERMOPLASTIC  
 STA 384+50 TO 390+00 SOLID LT & RT

TEMPORARY 4" YELLOW LINE, PAINT  
 DURABLE 4" YELLOW LINE, THERMOPLASTIC  
 STA 384+50 TO 390+00 SOLID LT & RT

REMOVAL AND DISPOSAL OF GUARDRAIL  
 65 STA 385+55.0 TO 387+50.0 RT  
 STA 386+53.0 TO 387+78.0 LT

~~STONE FILL, TYPE I~~  
~~STA 385+58 RT~~  
~~STA 386+67 RT~~


STEEL BEAM GUARDRAIL, GALVANIZED  
 385+65 STA 385+92.5 TO 387+17.5 RT  
 STA 386+53.0 TO 389+03.0 LT (INCLUDES 62.5' LF W/ 8' POSTS)  
 40.5  
 ANCHOR FOR STEEL BEAM RAIL  
 STA 386+53.0 LT  
 STA 389+03.0 LT 385+65 LT  
 40.5

MANUFACTURED TERMINAL SECTION, FLARED  
 DELINEATOR WITH STEEL POST  
~~STA 385+55.0 RT~~  
 STA 387+55.0 RT

STONE FILL, TYPE I  
 384+50 - 386+00 LT  
 386+67 RT  
 388+05 RT

BITUMINOUS CONCRETE CURB, TYPE A  
 STA 385+59 TO 386+66 RT  
 STA 386+68 TO 387+46 RT

BITUMINOUS GUTTER  
 388+10 - 388+34 RT

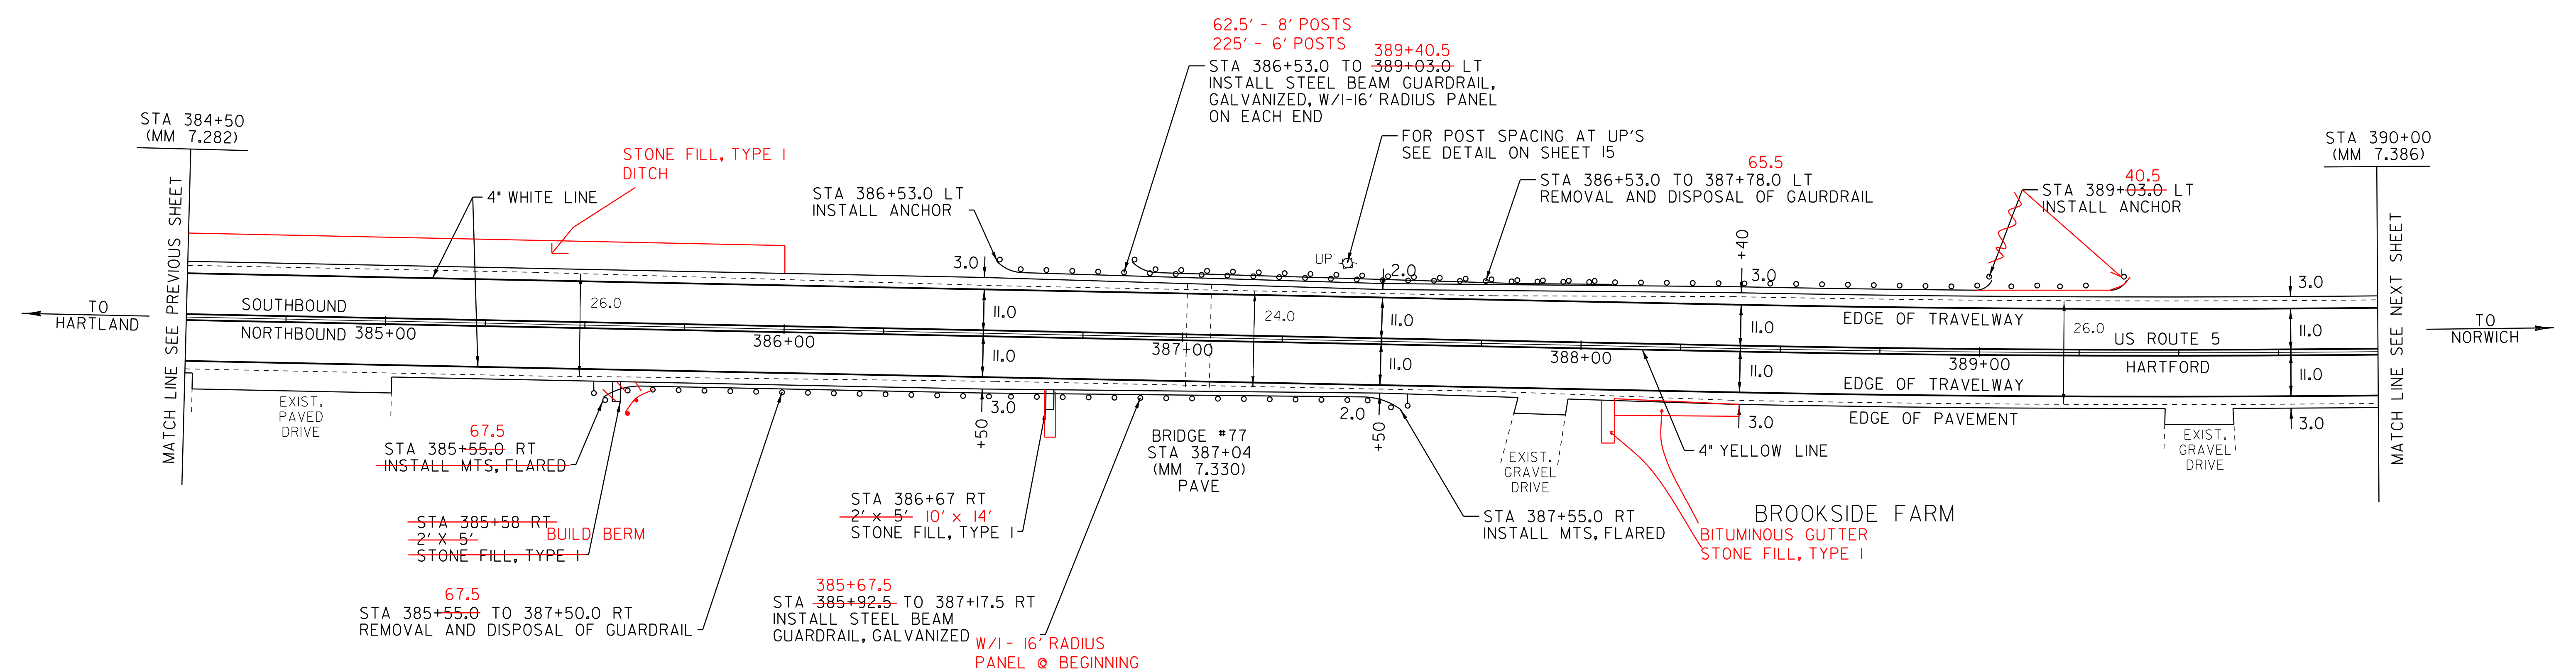

LEGEND

- R = REMOVE EXISTING
- S = SALVAGE
- R&S = REMOVE AND SALVAGE
- N = NEW
- RET = RETAIN
- B-B = BACK TO BACK
- = EXISTING GUARDRAIL
- = PROPOSED GUARDRAIL
- ∩ = TYPE I DELINEATOR, WHITE

NOT TO SCALE

<h3>PAVING LAYOUT SHEET 35</h3>	PROJECT NAME: HARTFORD-NORWICH	PLOT DATE: 14-FEB-2012 15:51
	PROJECT NUMBER: STP 2206(1)S	DRAWN BY: MRS
	FILE NAME: /pave/99cl64/pci64	CHECKED BY: NULL
	DESIGNED BY: NULL	SHEET 59 OF 137