

TEMPORARY 4" WHITE LINE, PAINT  
 DURABLE 4" WHITE LINE, THERMOPLASTIC  
 STA 390+00 TO 392+21 SOLID LT  
 STA 390+00 TO 395+50 SOLID RT  
 STA 392+43 TO 395+50 SOLID LT

TEMPORARY 4" YELLOW LINE, PAINT  
 DURABLE 4" YELLOW LINE, THERMOPLASTIC  
 STA 390+00 TO 392+11 SOLID LT & RT  
 STA 392+31 DOUBLE SOLID LT (TH 286)  
 STA 392+51 TO 395+50 SOLID LT & RT


TEMPORARY LETTER OR SYMBOL, PAINT  
 DURABLE LETTER OR SYMBOL, THERMOPLASTIC  
 STA 392+25 LT - "STOP" (TH 286)

TEMPORARY 24" STOP BAR, PAINT  
 DURABLE 24" STOP BAR, THERMOPLASTIC  
 STA 392+13 TO 392+31 LT (TH 286)

ADJUST ELEVATION  
 OF VALVE BOX (NON PART.)  
 STA 392+35 LT (TH 286)

REMOVING SIGNS  
 AS SHOWN - 2

ERECTING SALVAGED SIGNS  
 AS SHOWN - 1

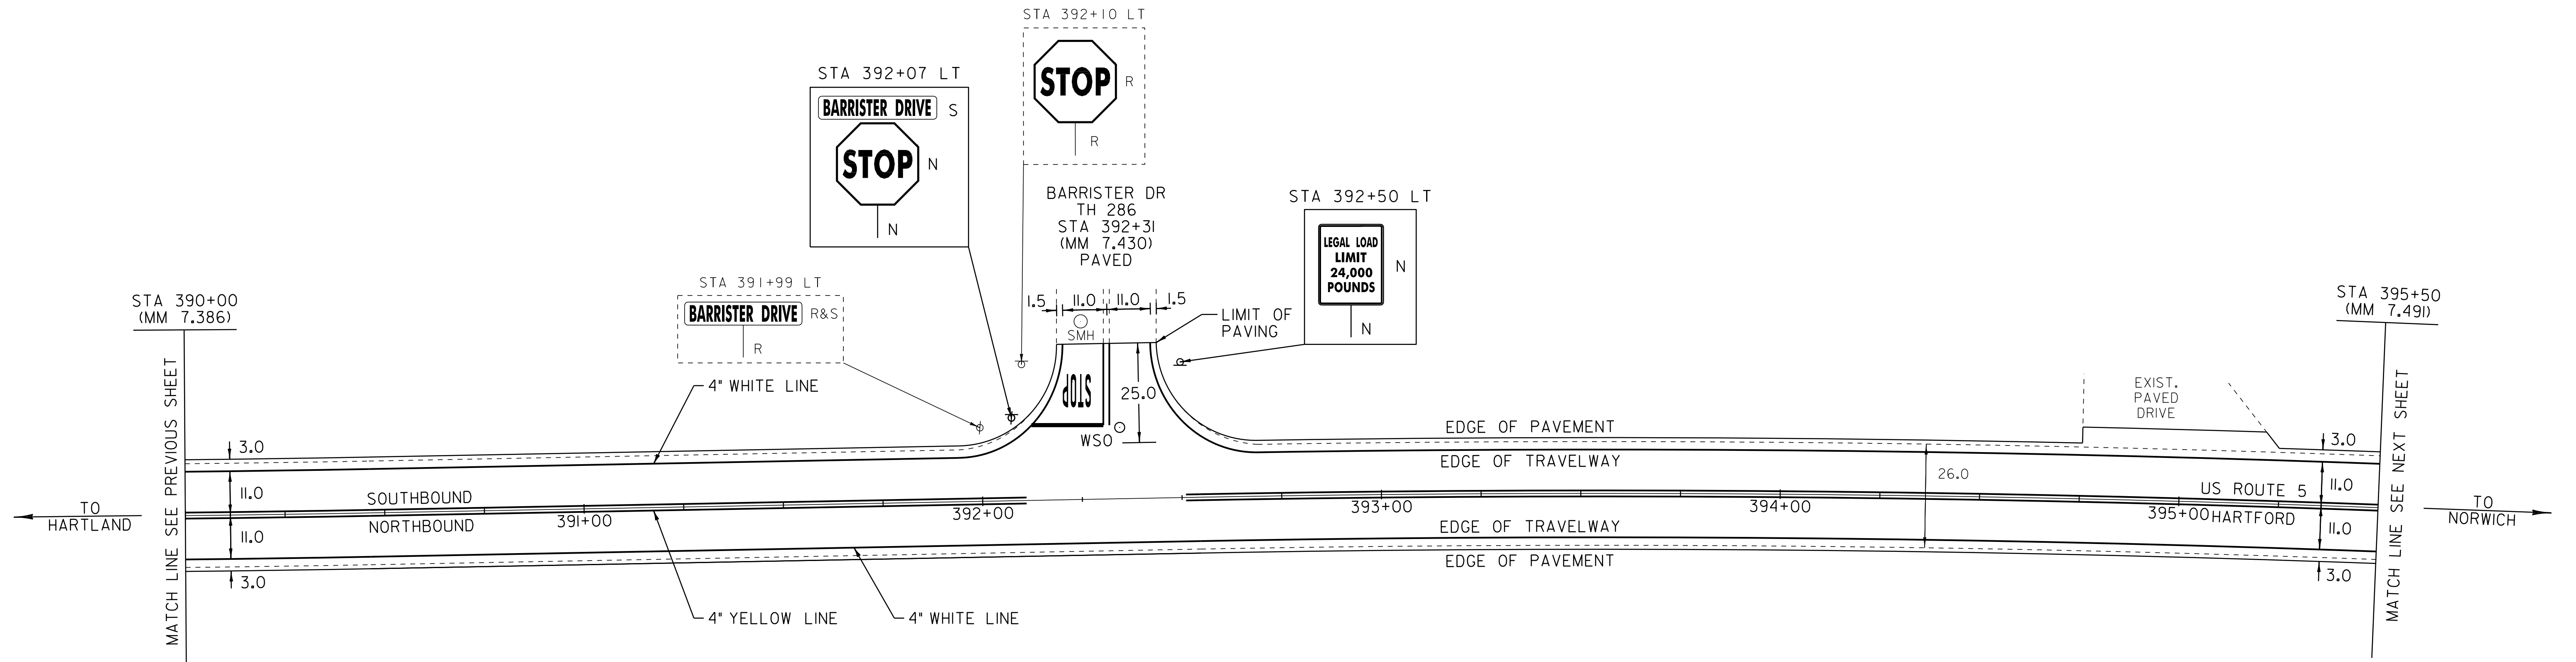

LEGEND

- R = REMOVE EXISTING
- S = SALVAGE
- R&S = REMOVE AND SALVAGE
- N = NEW
- RET = RETAIN
- B-B = BACK TO BACK
- — — = EXISTING GUARDRAIL
- — — = PROPOSED GUARDRAIL
- ↑ = TYPE I DELINEATOR, WHITE

NOT TO SCALE

<b>PAVING LAYOUT SHEET 36</b>	PROJECT NAME: HARTFORD-NORWICH	
	PROJECT NUMBER: STP 2206(1)S	
FILE NAME: /pave/99cl64/pcl64	PLOT DATE: 14-FEB-2012 15:51	
PROJECT LEADER: PTS	DRAWN BY: MRS	
DESIGNED BY: NULL	CHECKED BY: NULL	
IPARM FILE NAME: pcl64la36.i	SHEET 60 OF 137	