


TEMPORARY 4" WHITE LINE, PAINT
 DURABLE 4" WHITE LINE, THERMOPLASTIC
 STA 8+00 TO 13+50 SOLID LT & RT

TEMPORARY 4" YELLOW LINE, PAINT
 DURABLE 4" YELLOW LINE, THERMOPLASTIC
 STA 8+00 TO 13+50 SOLID LT & RT

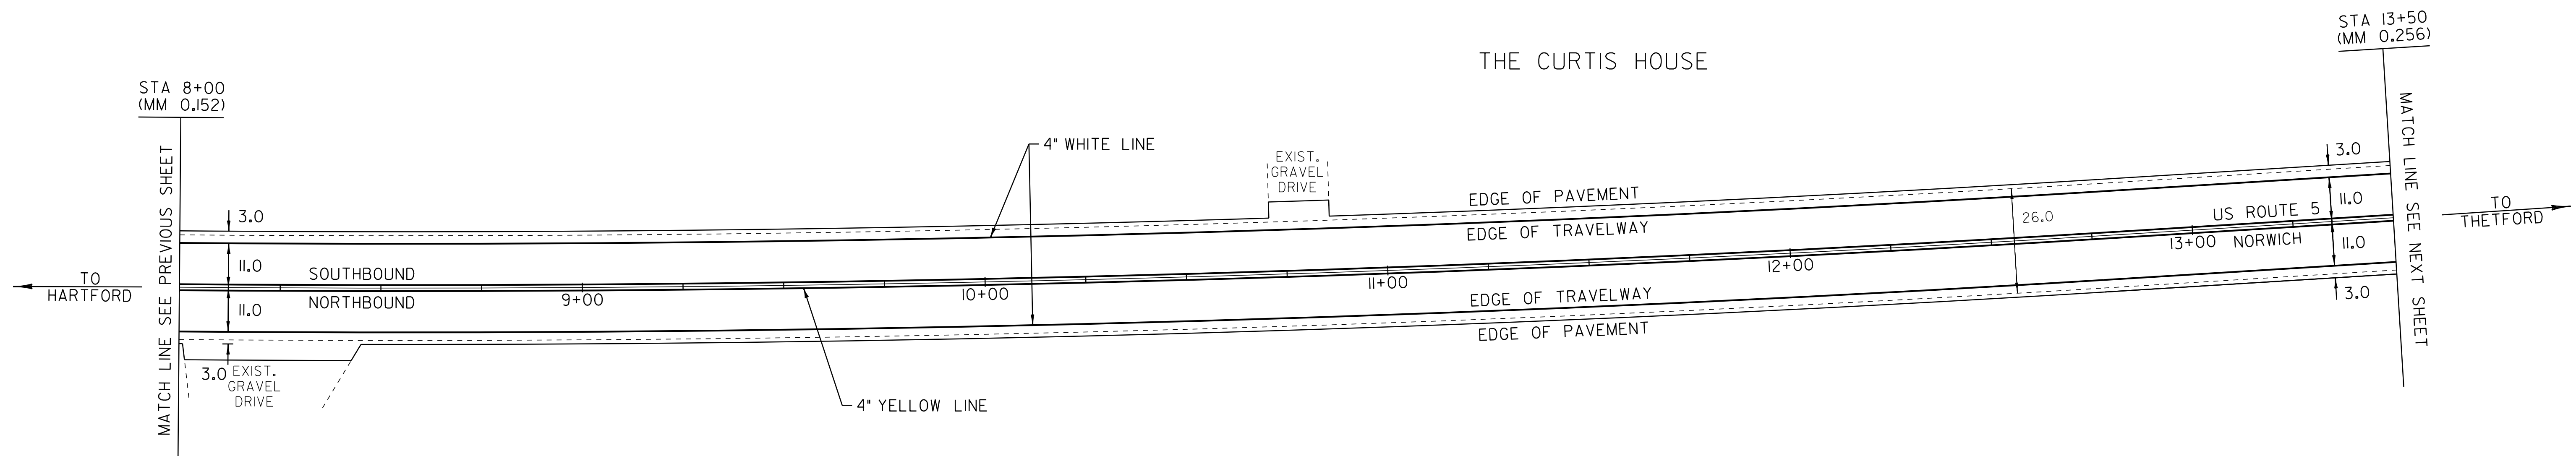

LEGEND

- R = REMOVE EXISTING
- S = SALVAGE
- R&S = REMOVE AND SALVAGE
- N = NEW
- RET = RETAIN
- B-B = BACK TO BACK
- — — = EXISTING GUARDRAIL
- — — = PROPOSED GUARDRAIL
- ↑ = TYPE I DELINEATOR, WHITE

NOT TO SCALE

PAVING LAYOUT SHEET 39	PROJECT NAME: HARTFORD-NORWICH	
	PROJECT NUMBER: STP 2206(1)S	
FILE NAME: /pave/99cl64/pci64	PLOT DATE: 14-FEB-2012 15:51	
PROJECT LEADER: PTS	DRAWN BY: MRS	
DESIGNED BY: NULL	CHECKED BY: NULL	
IPARM FILE NAME: pci64la39.i	SHEET 63 OF 137	