


TEMPORARY 4" WHITE LINE, PAINT
 DURABLE 4" WHITE LINE, THERMOPLASTIC
 STA 18+00 TO 19+06 SOLID LT
 STA 18+00 TO 23+50 SOLID RT
 STA 19+28 TO 23+50 SOLID LT

TEMPORARY 4" YELLOW LINE, PAINT
 DURABLE 4" YELLOW LINE, THERMOPLASTIC
 STA 18+00 TO 18+99 SOLID LT & RT
 STA 19+19 DOUBLE SOLID LT (TH 58)
 STA 19+39 TO 23+50 SOLID LT & RT

TEMPORARY LETTER OR SYMBOL, PAINT
 DURABLE LETTER OR SYMBOL, THERMOPLASTIC
 STA 19+11 LT - "STOP" (TH 58)
 TEMPORARY 24" STOP BAR, PAINT
 DURABLE 24" STOP BAR, THERMOPLASTIC
 STA 18+98 TO 19+17 LT (TH 58)

REMOVING SIGNS
 AS SHOWN - 1

ERECTING SALVAGED SIGNS
 AS SHOWN - 1

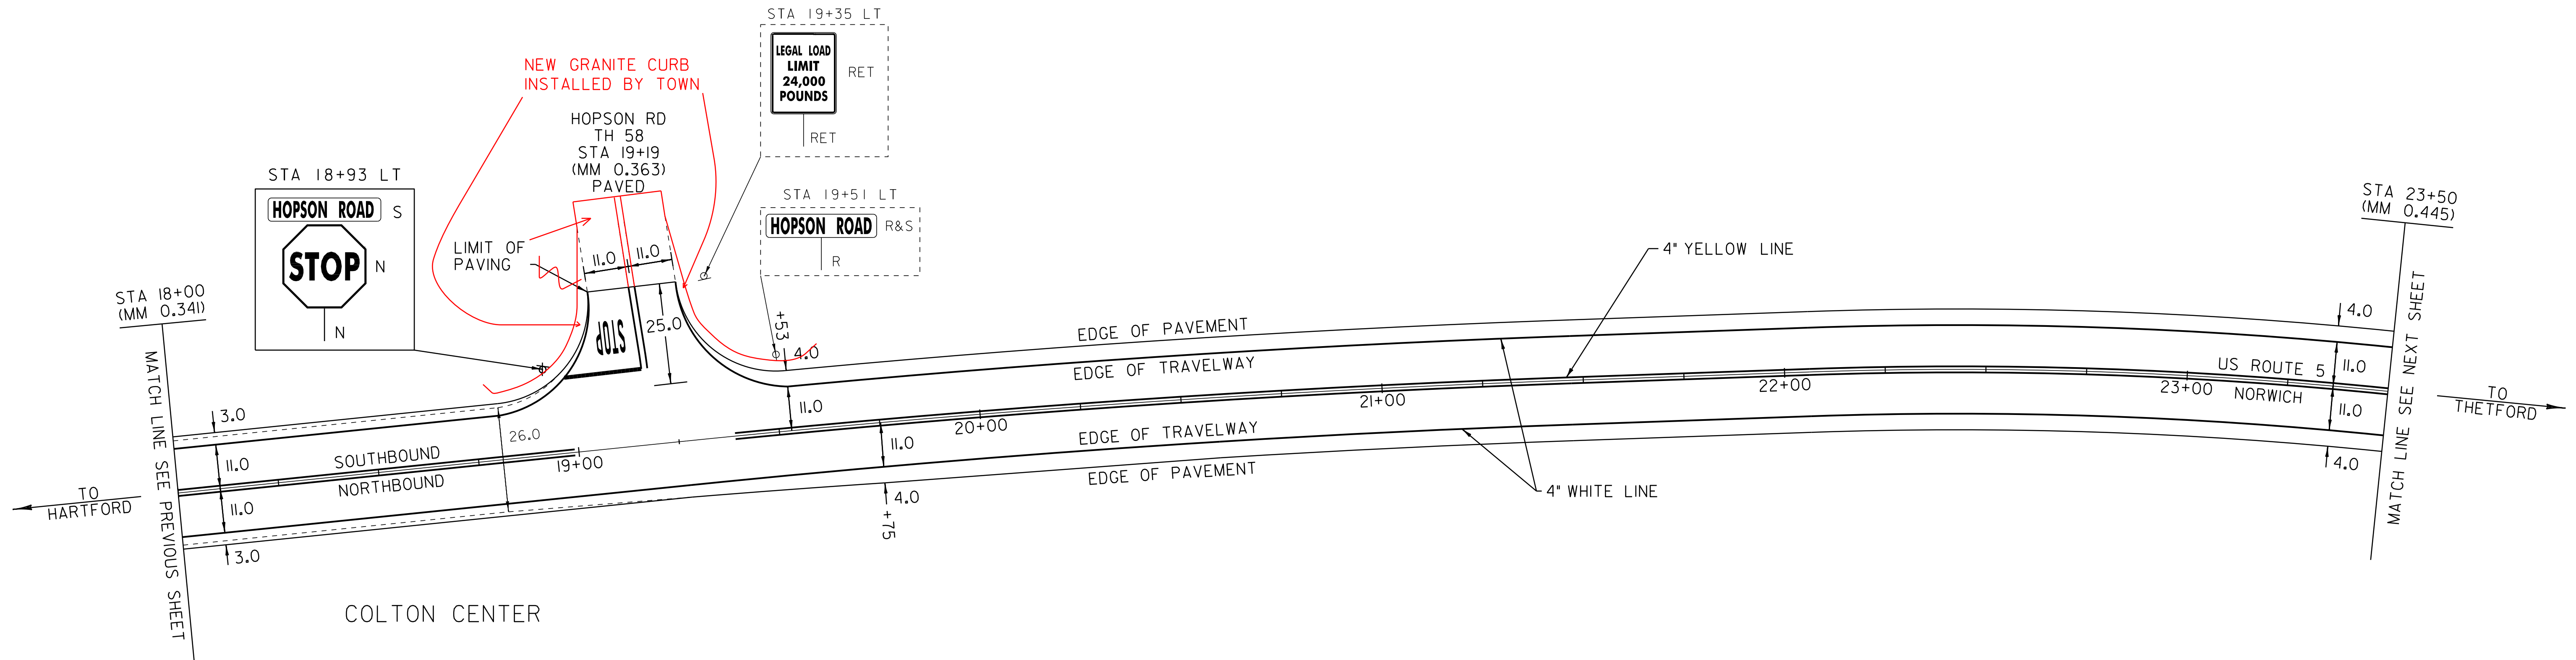

LEGEND

- R = REMOVE EXISTING
- S = SALVAGE
- R&S = REMOVE AND SALVAGE
- N = NEW
- RET = RETAIN
- B-B = BACK TO BACK
- — — = EXISTING GUARDRAIL
- — — = PROPOSED GUARDRAIL
- ⚓ = TYPE I DELINEATOR, WHITE

PAVING LAYOUT SHEET 41	PROJECT NAME: HARTFORD-NORWICH	PLOT DATE: 14-FEB-2012 15:51
	PROJECT NUMBER: STP 2206(1)S	DRAWN BY: MRS
	DESIGNED BY: NULL	CHECKED BY: NULL
	IPARM FILE NAME: pcl64la4li	SHEET 65 OF 137

NOT TO SCALE