


TEMPORARY 4" WHITE LINE, PAINT
 DURABLE 4" WHITE LINE, THERMOPLASTIC
 STA 28+50 TO 34+00 SOLID LT & RT

TEMPORARY 4" YELLOW LINE, PAINT
 DURABLE 4" YELLOW LINE, THERMOPLASTIC
 STA 28+50 TO 34+00 SOLID LT & RT

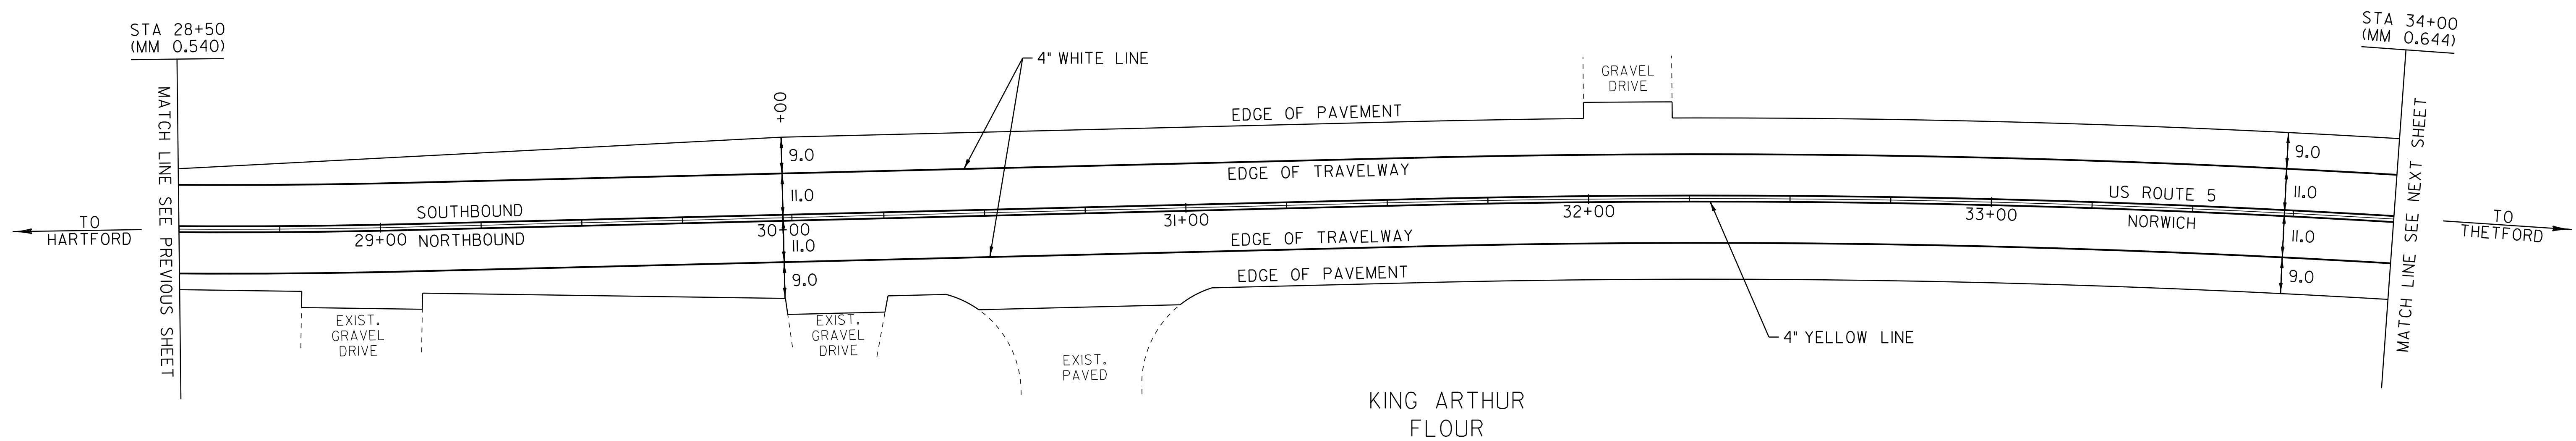

LEGEND

- R = REMOVE EXISTING
- S = SALVAGE
- R&S = REMOVE AND SALVAGE
- N = NEW
- RET = RETAIN
- B-B = BACK TO BACK
- = EXISTING GUARDRAIL
- - - = PROPOSED GUARDRAIL
- ↑ = TYPE I DELINEATOR, WHITE

NOT TO SCALE

PAVING LAYOUT SHEET 43	PROJECT NAME: HARTFORD-NORWICH	
	PROJECT NUMBER: STP 2206(1)S	
FILE NAME: /pave/99cl64/pcl64	PLOT DATE: 14-FEB-2012 15:52	
PROJECT LEADER: PTS	DRAWN BY: MRS	
DESIGNED BY: NLL	CHECKED BY: NLL	
IPARM FILE NAME: pcl64la43.i	SHEET 67 OF 137	