

TEMPORARY 4" WHITE LINE, PAINT  
 DURABLE 4" WHITE LINE, THERMOPLASTIC  
 STA 34+00 TO 39+50 SOLID LT  
 STA 34+00 TO 37+98 SOLID RT  
 STA 38+25 TO 39+50 SOLID RT







TEMPORARY 4" YELLOW LINE, PAINT  
 DURABLE 4" YELLOW LINE, THERMOPLASTIC  
 STA 34+00 TO 37+90 SOLID LT & RT  
 STA 38+10 DOUBLE SOLID RT ( TH 83)  
 STA 38+30 TO 39+50 SOLID LT & RT

TEMPORARY LETTER OR SYMBOL, PAINT  
 DURABLE LETTER OR SYMBOL, THERMOPLASTIC  
 STA 38+15 RT - "STOP" ( TH 83)

TEMPORARY 24" STOP BAR, PAINT  
 DURABLE 24" STOP BAR, THERMOPLASTIC  
 STA 38+11 TO 38+23 RT ( TH 83)

REMOVING SIGNS  
 AS SHOWN - 3

ERECTING SALVAGED SIGNS  
 AS SHOWN - 1

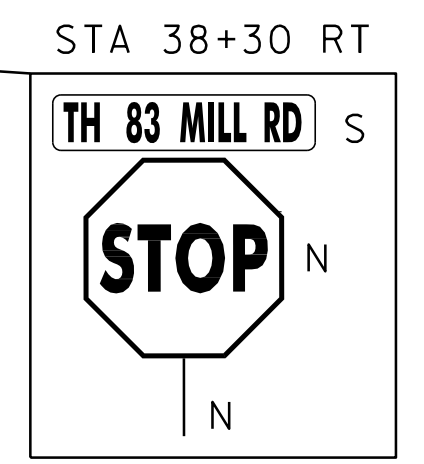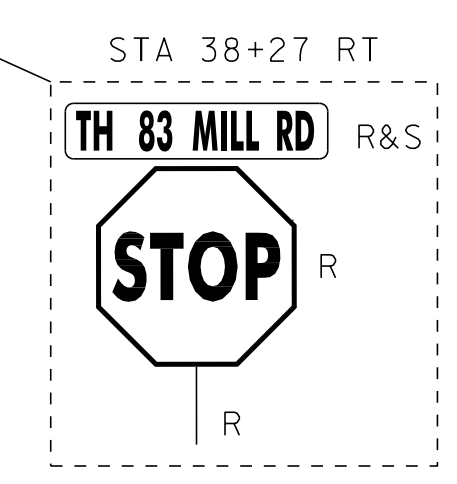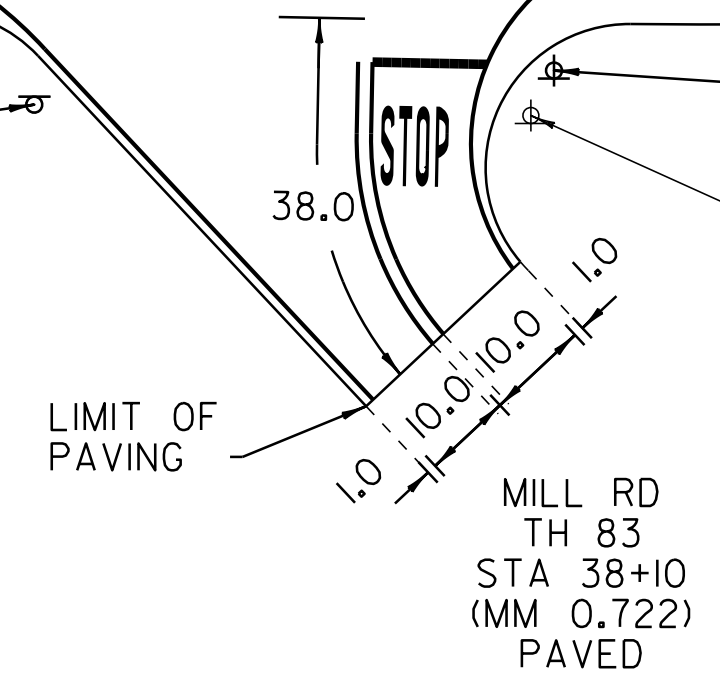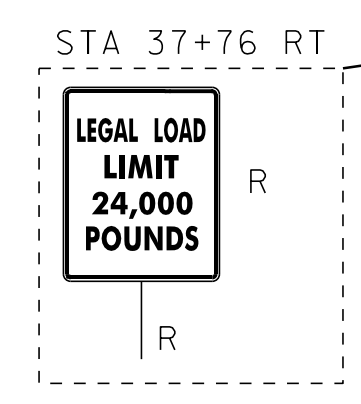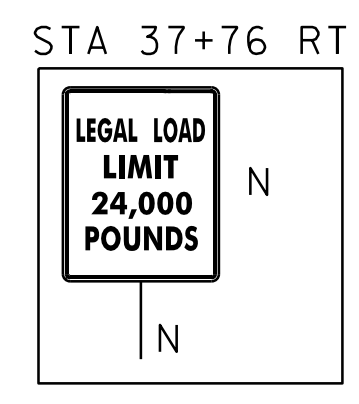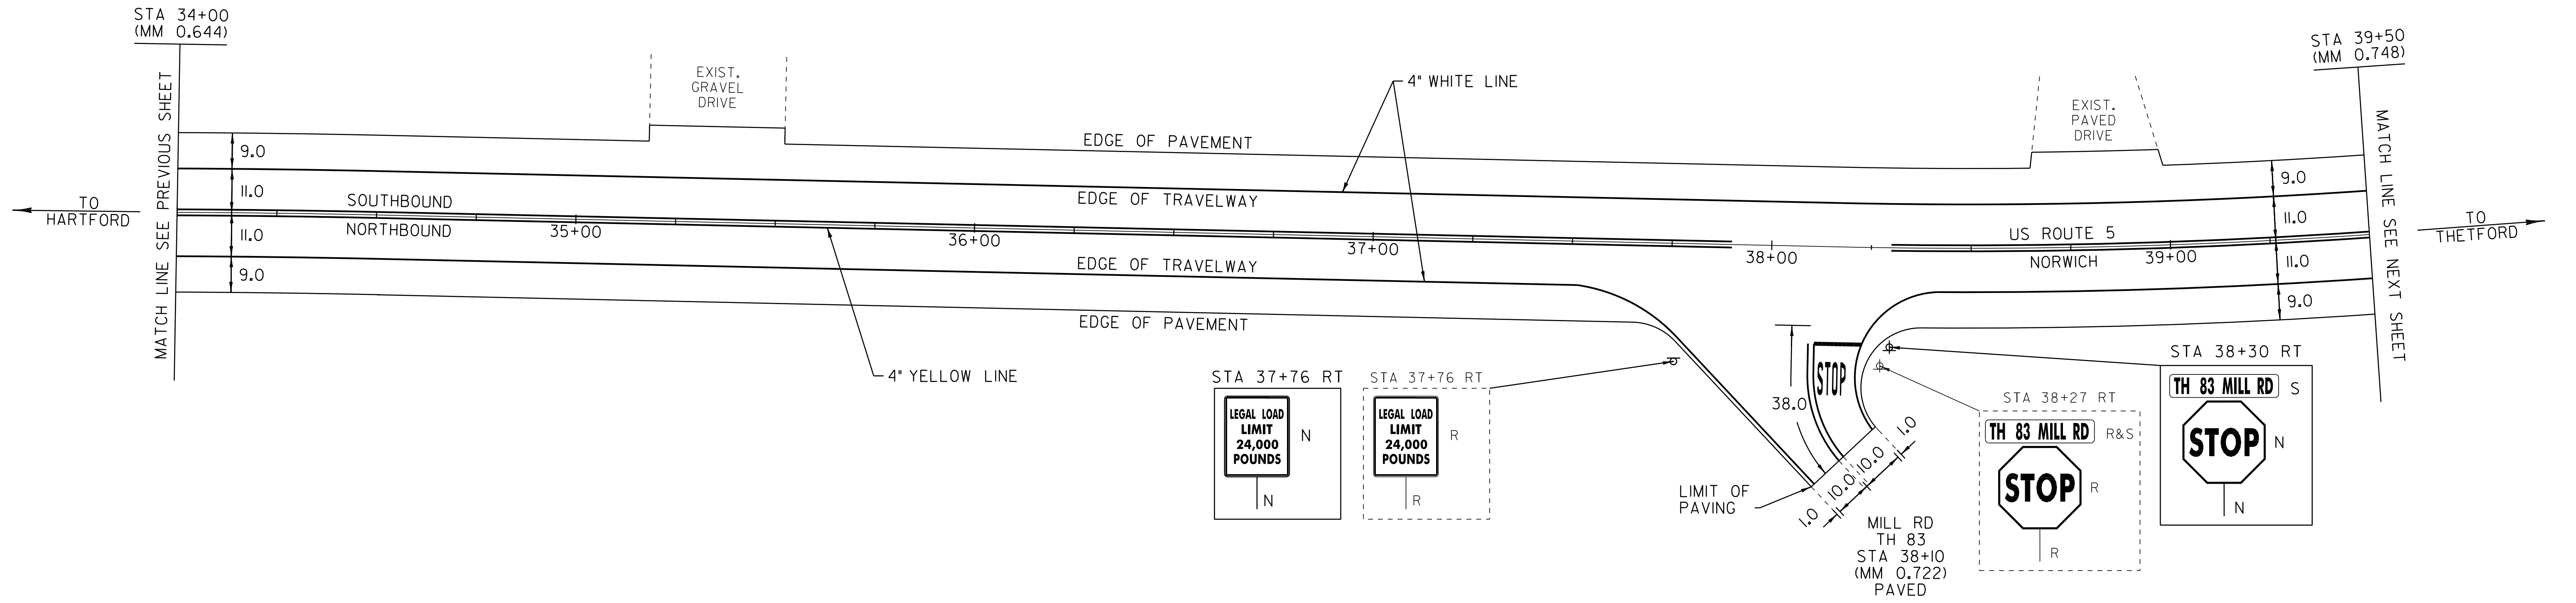

LEGEND

- R = REMOVE EXISTING
- S = SALVAGE
- R&S = REMOVE AND SALVAGE
- N = NEW
- RET = RETAIN
- B-B = BACK TO BACK
- — — = EXISTING GUARDRAIL
- — — = PROPOSED GUARDRAIL
- ↑ = TYPE I DELINEATOR, WHITE

NOT TO SCALE

<b>PAVING LAYOUT SHEET 44</b>	PROJECT NAME: HARTFORD-NORWICH	
	PROJECT NUMBER: STP 2206(1)S	
FILE NAME: /pave/99c164/pci64	PLOT DATE: 14-FEB-2012 15:52	
PROJECT LEADER: PTS	DRAWN BY: MRS	
DESIGNED BY: NLL	CHECKED BY: NLL	
IPARM FILE NAME: pci64la44.i	SHEET 68 OF 137	