


TEMPORARY 4" WHITE LINE, PAINT
 DURABLE 4" WHITE LINE, THERMOPLASTIC
 STA 39+50 TO 44+35 SOLID LT & RT

TEMPORARY 4" YELLOW LINE, PAINT
 DURABLE 4" YELLOW LINE, THERMOPLASTIC
 STA 39+50 TO 44+35 SOLID LT & RT

BITUMINOUS CONCRETE, CURB TYPE A
 42+60 - 44+35 LT

**US ROUTE 5
 STA 44+35.0
 (MM 0.840)
 END PROJECT
 STP 2206(1)S
 END COLD PLANE
 AND OVERLAY**

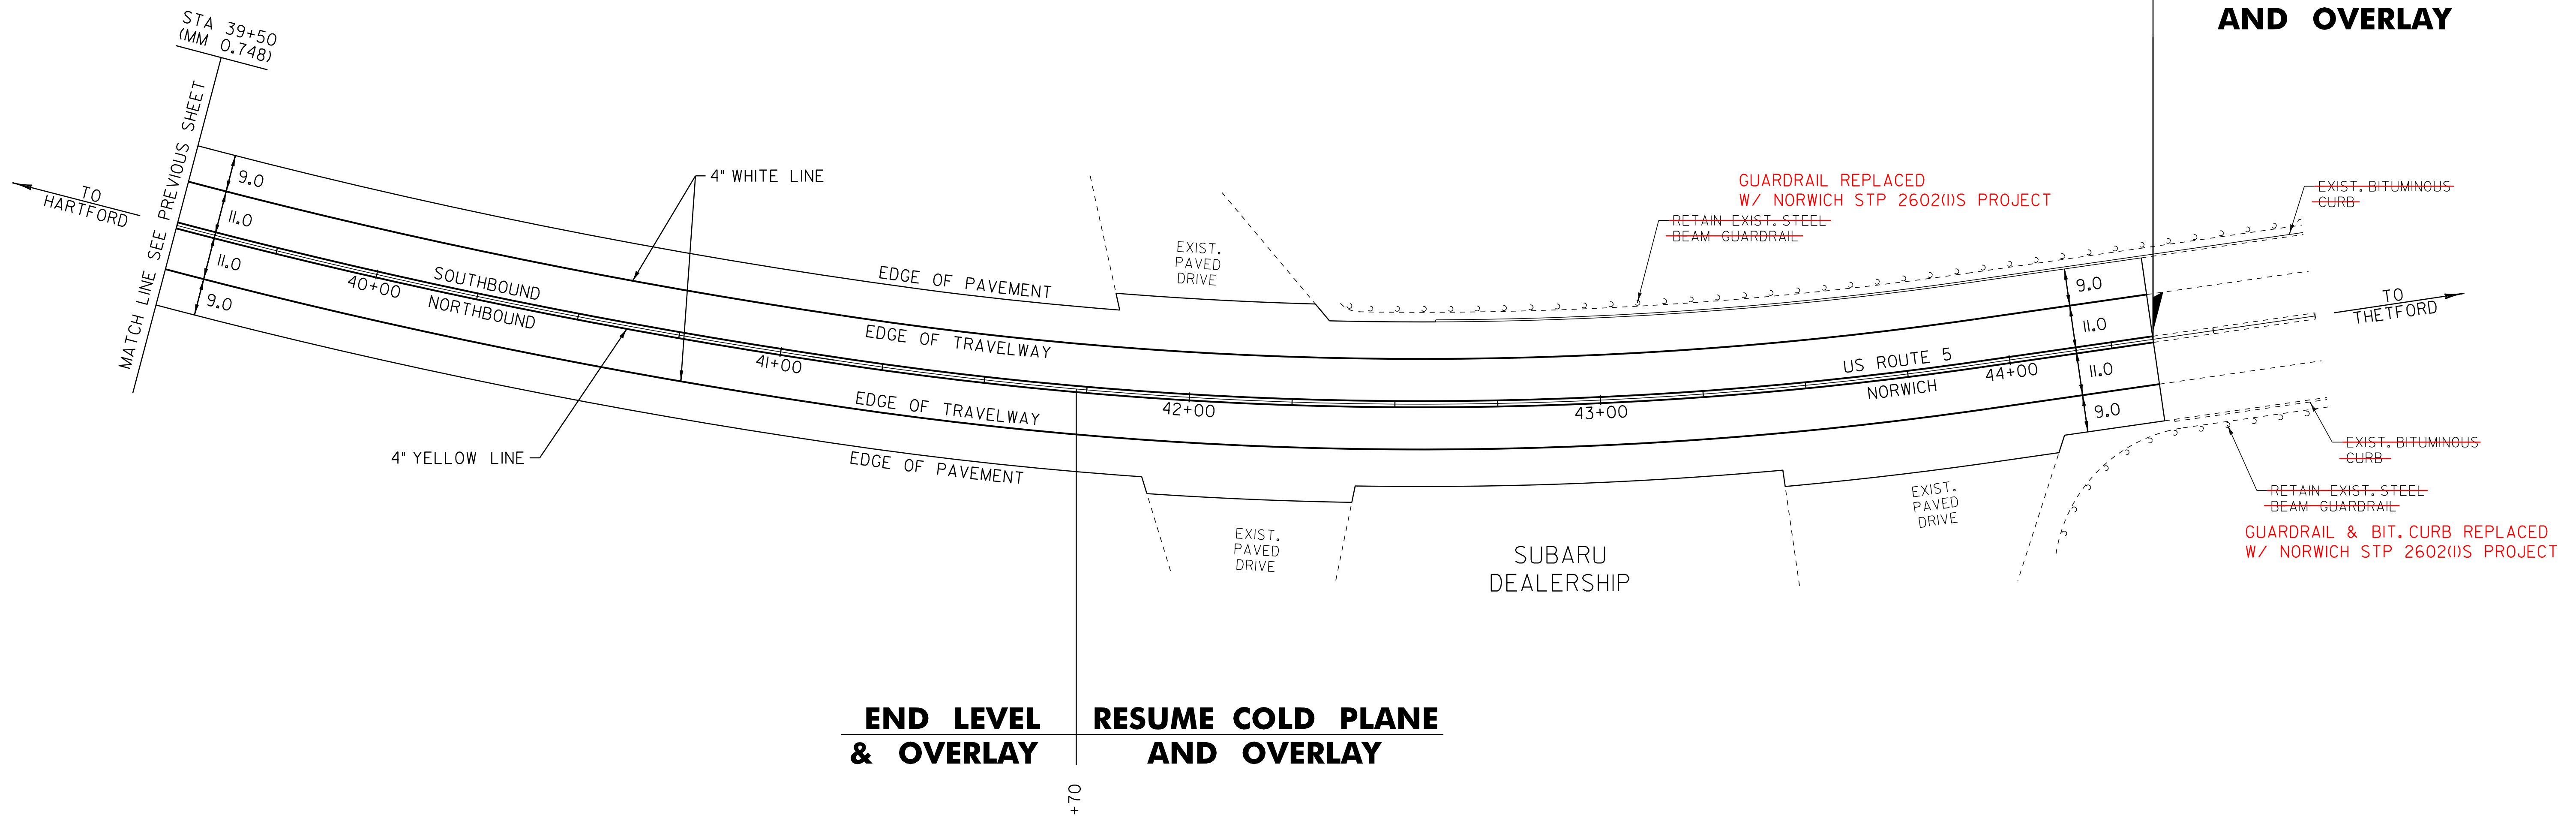

END LEVEL & OVERLAY | **RESUME COLD PLANE AND OVERLAY**

+70

LEGEND

- R = REMOVE EXISTING
- S = SALVAGE
- R&S = REMOVE AND SALVAGE
- N = NEW
- RET = RETAIN
- B-B = BACK TO BACK
- = EXISTING GUARDRAIL
- = PROPOSED GUARDRAIL
- = TYPE I DELINEATOR, WHITE

PAVING LAYOUT SHEET 45	PROJECT NAME: HARTFORD-NORWICH	PLOT DATE: 14-FEB-2012 15:52
	PROJECT NUMBER: STP 2206(1)S	DRAWN BY: MRS
	DESIGNED BY: NULL	CHECKED BY: NULL
	IPARM FILE NAME: pci64la45.i	SHEET 69 OF 137

NOT TO SCALE