

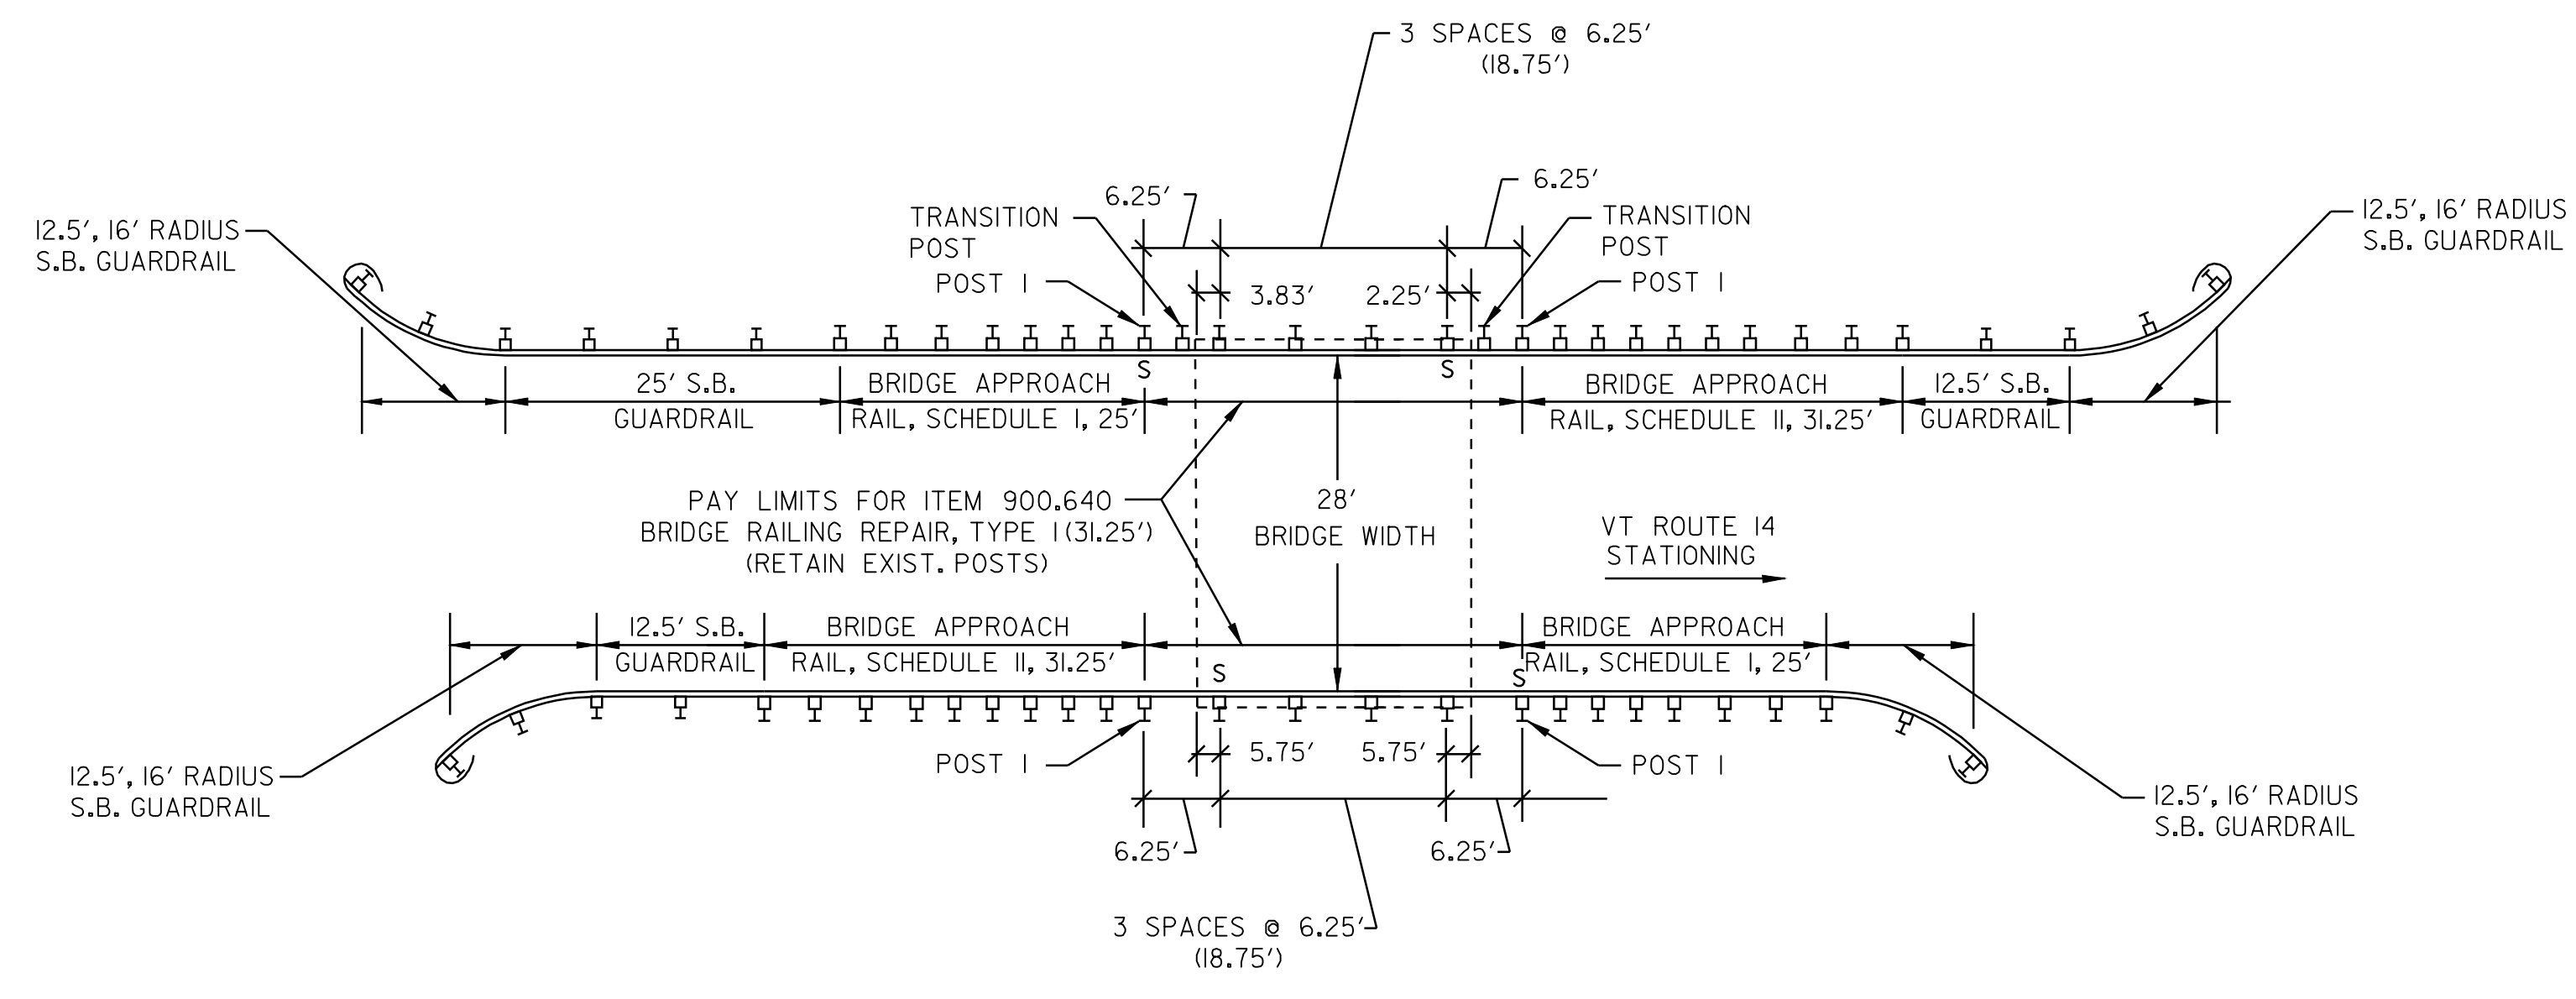


WILLIAMSTOWN BRIDGE #57
FIELD STA. 207+04 - MM 3.921

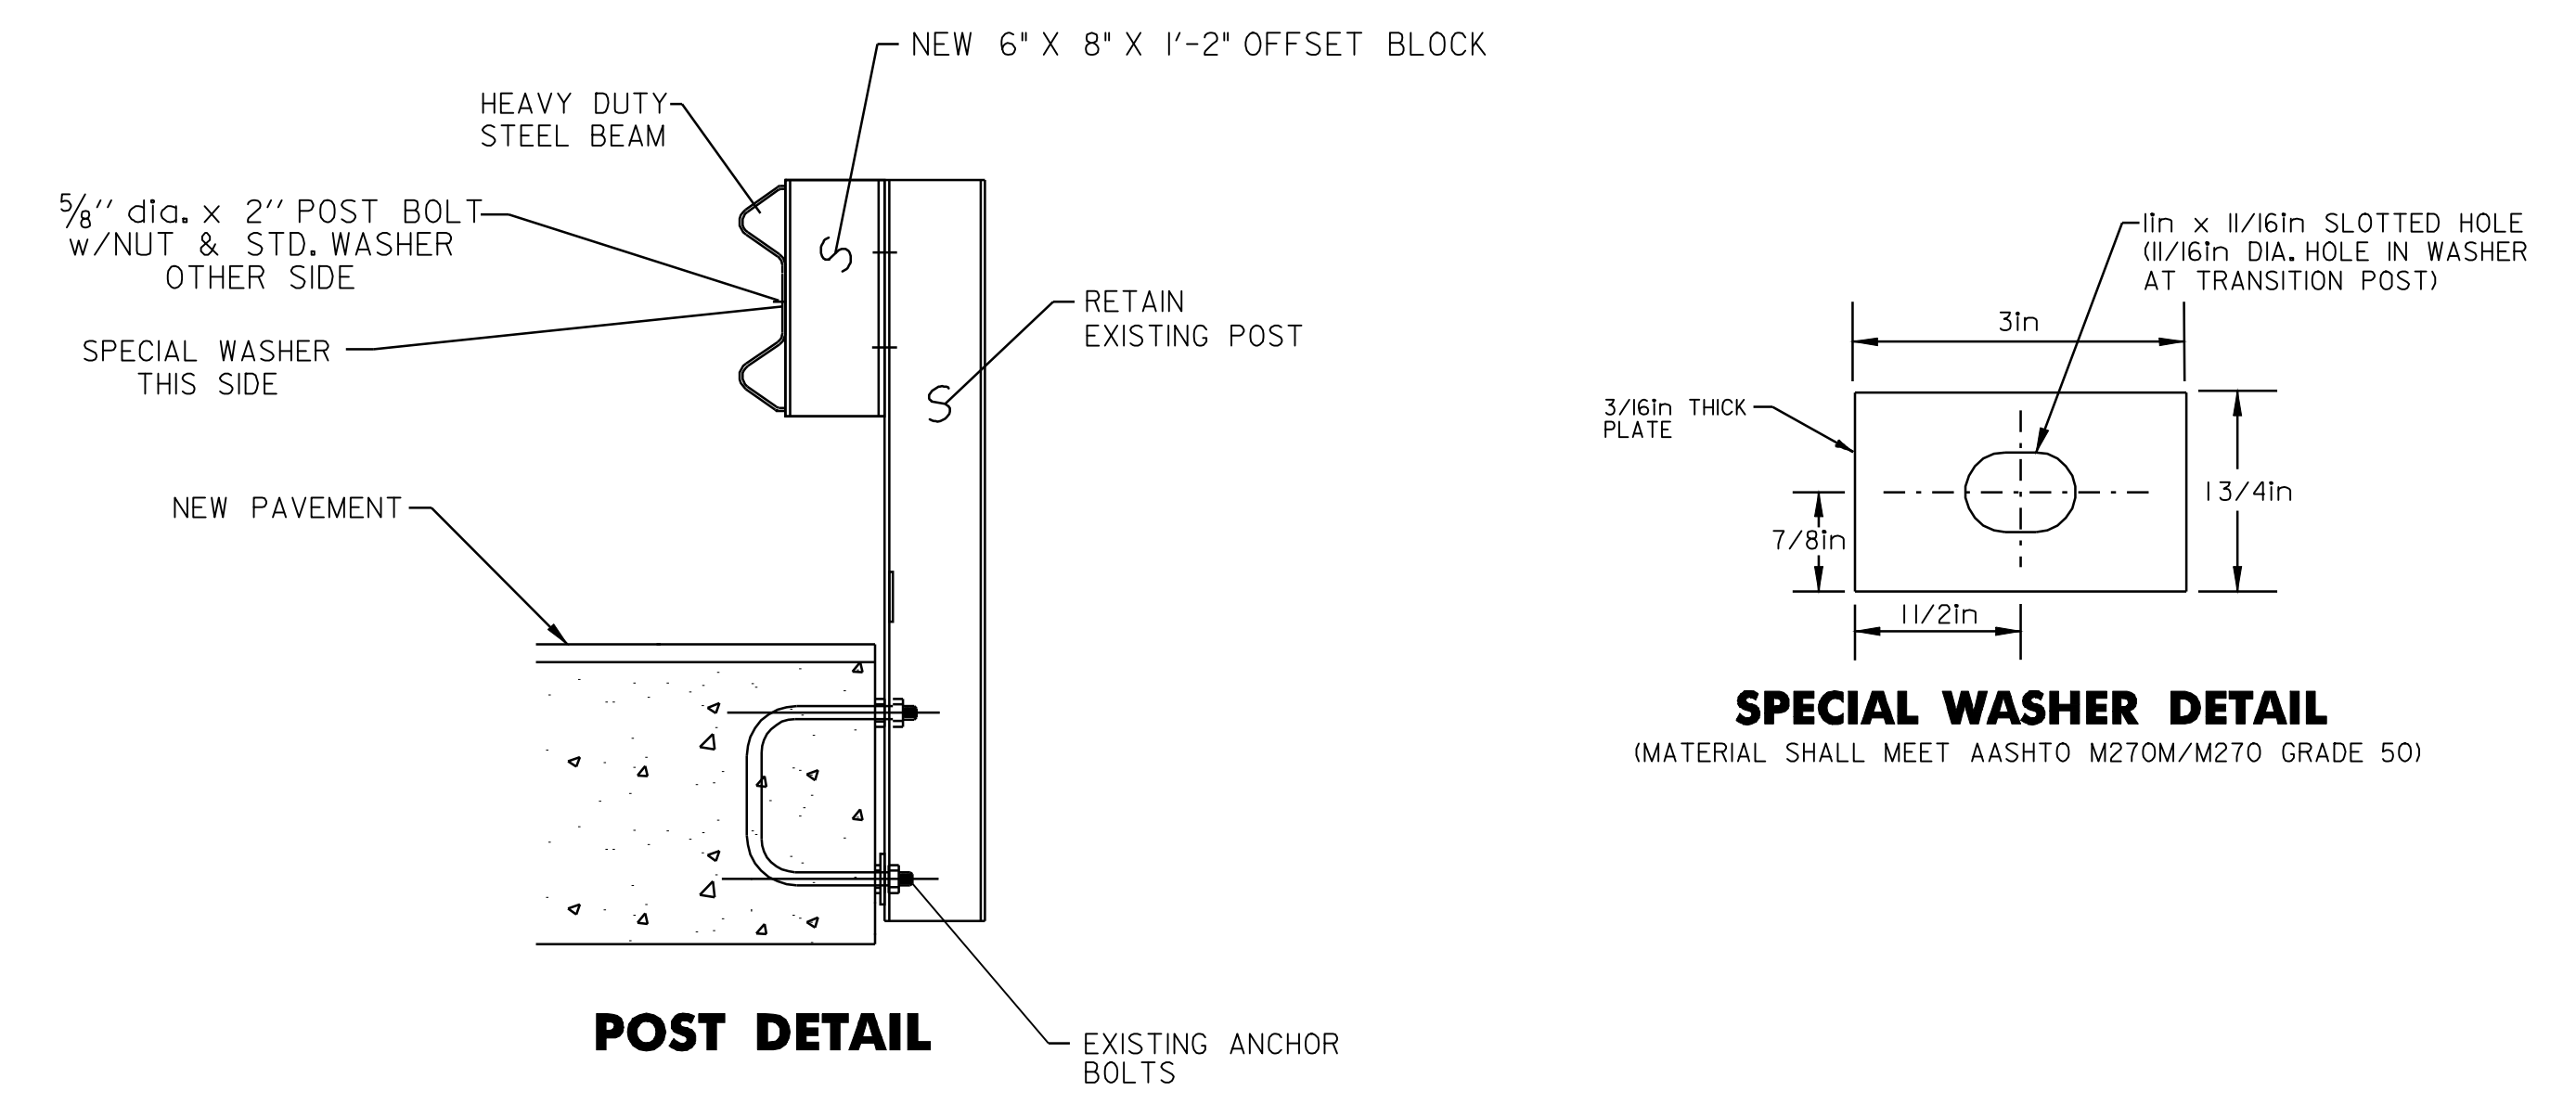

WILLIAMSTOWN BRIDGE #58
FIELD STA. 219+30 - MM 4.153

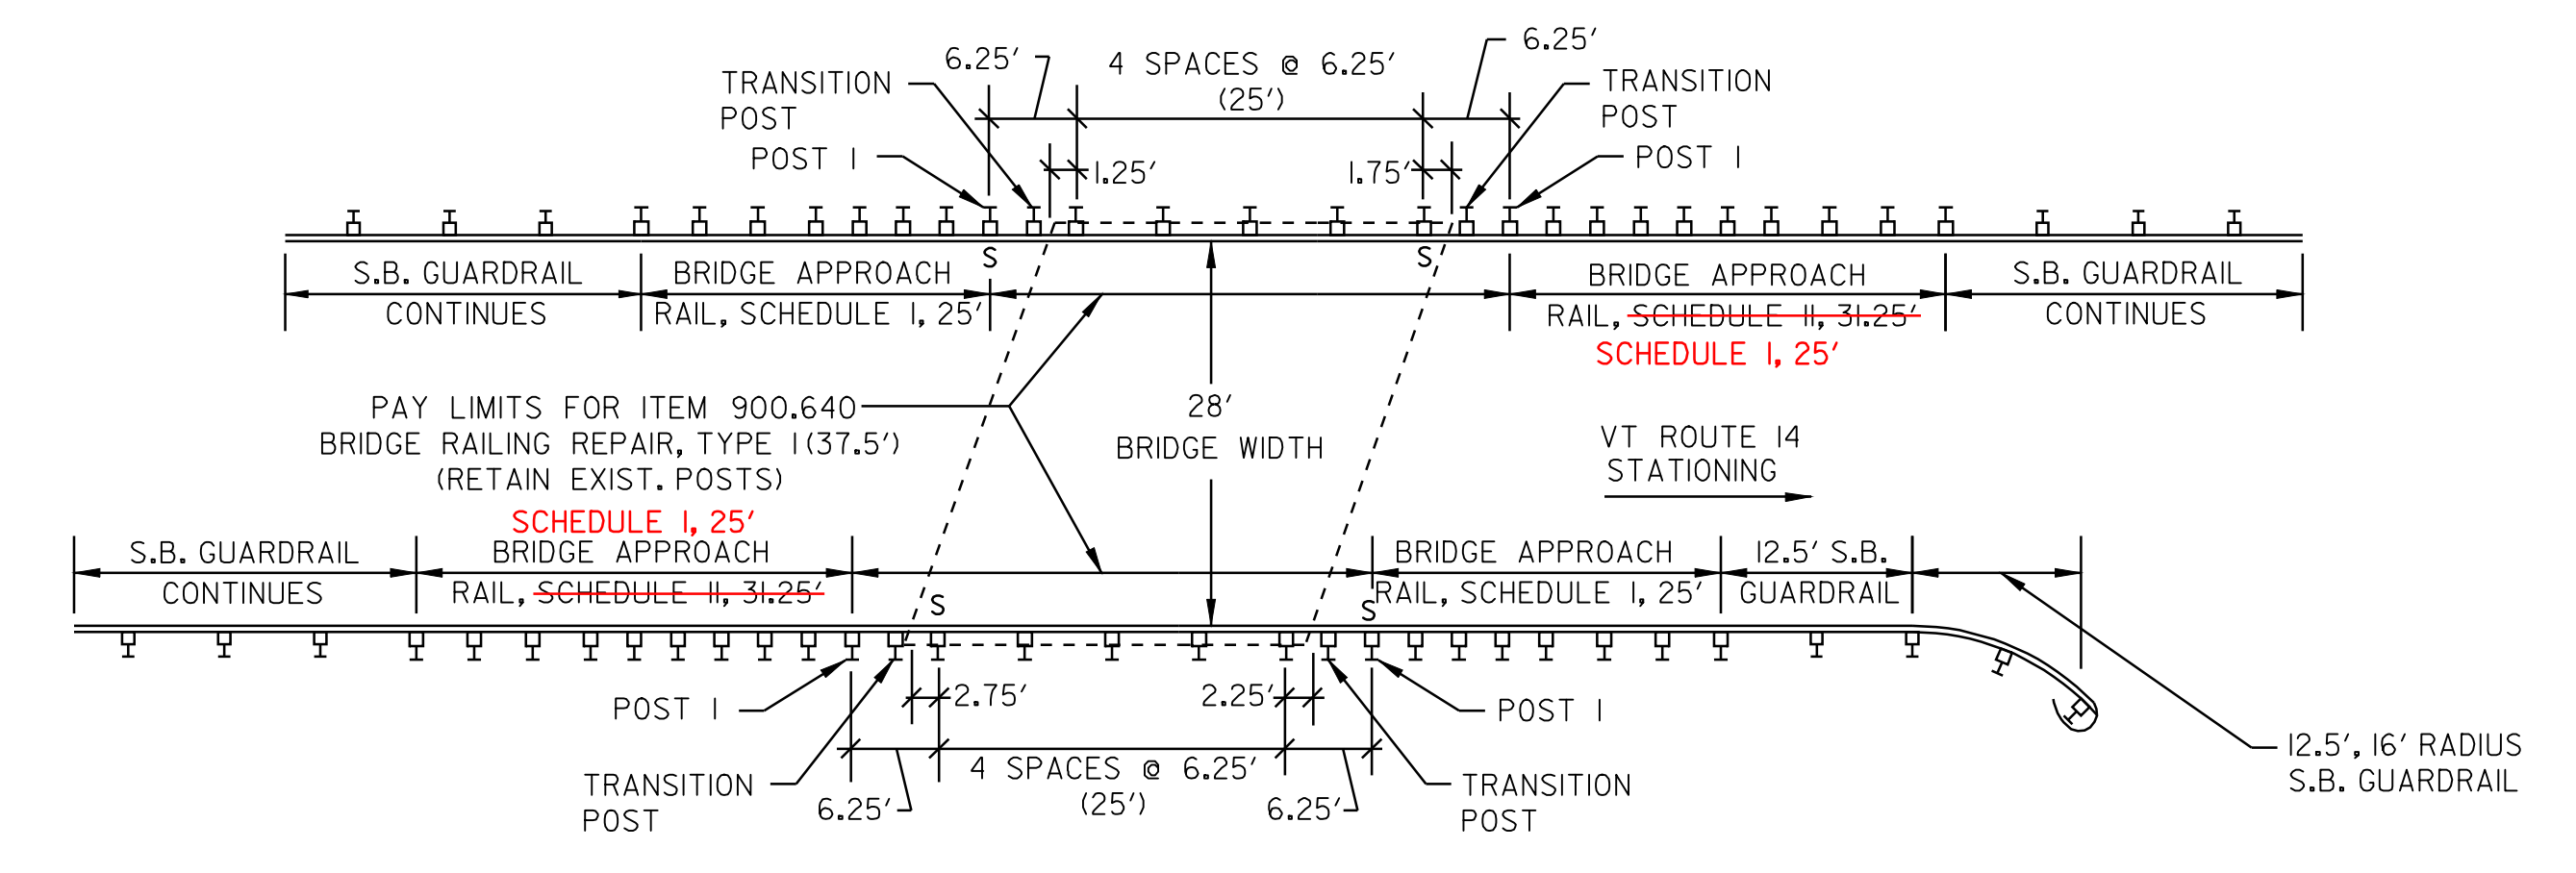

WILLIAMSTOWN BRIDGE #60
FIELD STA. 306+85 - MM 5.812

DETAILS ARE NOT TO SCALE

BRIDGE DETAIL SHEET	PROJECT NAME: WILLIAMSTOWN-BARRE TOWN
	PROJECT NUMBER: STP 2210 (1)S
	FILE NAME: p99cl72.dgn
	PLOT DATE: 29-APR-2009 13:3
PROJECT LEADER: EPD	DRAWN BY: RHB
DESIGNED BY: CDL	CHECKED BY: EPD
PLOT FILE: p99cl72bds.I	SHEET 6 OF 32