

646.403 DURABLE 4 INCH WHITE LINE, EPOXY PAINT
 STA. 223+50 - STA. 238+50 (SOLID LT & RT)
 (WITH EDGELINE BREAKS AT TOWN ROADS)
 STA. 226+80 LT (EDGELINES, TH# 39)
 STA. 233+54 LT (EDGELINES, TH# 73)
 STA. 233+74 RT (EDGELINES, TH# 72)
 STA. 235+55 RT (EDGELINES, TH# 71)
 STA. 237+13 LT (EDGELINES, VT 64)

646.413 DURABLE 4 INCH YELLOW LINE, EPOXY PAINT
 STA. 223+50 - STA. 238+50 (SOLID LT & RT)
 (WITH CENTERLINE BREAKS AT TOWN ROADS)
 STA. 226+80 LT (CENTERLINE, TH# 39)
 STA. 233+54 LT (CENTERLINE, TH# 73)
 STA. 233+74 RT (CENTERLINE, TH# 72)
 STA. 237+13 LT (CENTERLINE, VT 64)


646.482 DURABLE 24 INCH STOP BAR, THERMOPLASTIC
 STA. 226+63 LT - STA. 226+80 LT (TH# 39)
 STA. 233+42 LT - STA. 233+54 LT (TH# 73)
 STA. 233+74 RT - STA. 233+94 RT (TH# 72)
 STA. 236+91LT - STA. 237+13 LT (VT 64)

646.602 TEMPORARY 4 INCH WHITE LINE, PAINT
 STA. 223+50 - STA. 238+50 (SOLID LT & RT)
 (WITH EDGELINE BREAKS AT TOWN ROADS)
 STA. 226+80 LT (EDGELINES, TH# 39)
 STA. 233+54 LT (EDGELINES, TH# 73)
 STA. 233+74 RT (EDGELINES, TH# 72)
 STA. 235+55 RT (EDGELINES, TH# 71)
 STA. 237+13 LT (EDGELINES, VT 64)

646.612 TEMPORARY 4 INCH YELLOW LINE, PAINT
 STA. 223+50 - STA. 238+50 (SOLID LT & RT)
 (WITH CENTERLINE BREAKS AT TOWN ROADS)
 STA. 226+80 LT (CENTERLINE, TH# 39)
 STA. 233+54 LT (CENTERLINE, TH# 73)
 STA. 233+74 RT (CENTERLINE, TH# 72)
 STA. 237+13 LT (CENTERLINE, VT 64)

646.682 TEMPORARY 24 INCH STOP BAR, PAINT
 STA. 226+63 LT - STA. 227+80 LT (TH# 39)
 STA. 233+42 LT - STA. 233+54 LT (TH# 73)
 STA. 233+74 RT - STA. 233+94 RT (TH# 72)
 STA. 236+91LT - STA. 237+13 LT (VT 64)

VT STATE PLANE GRID

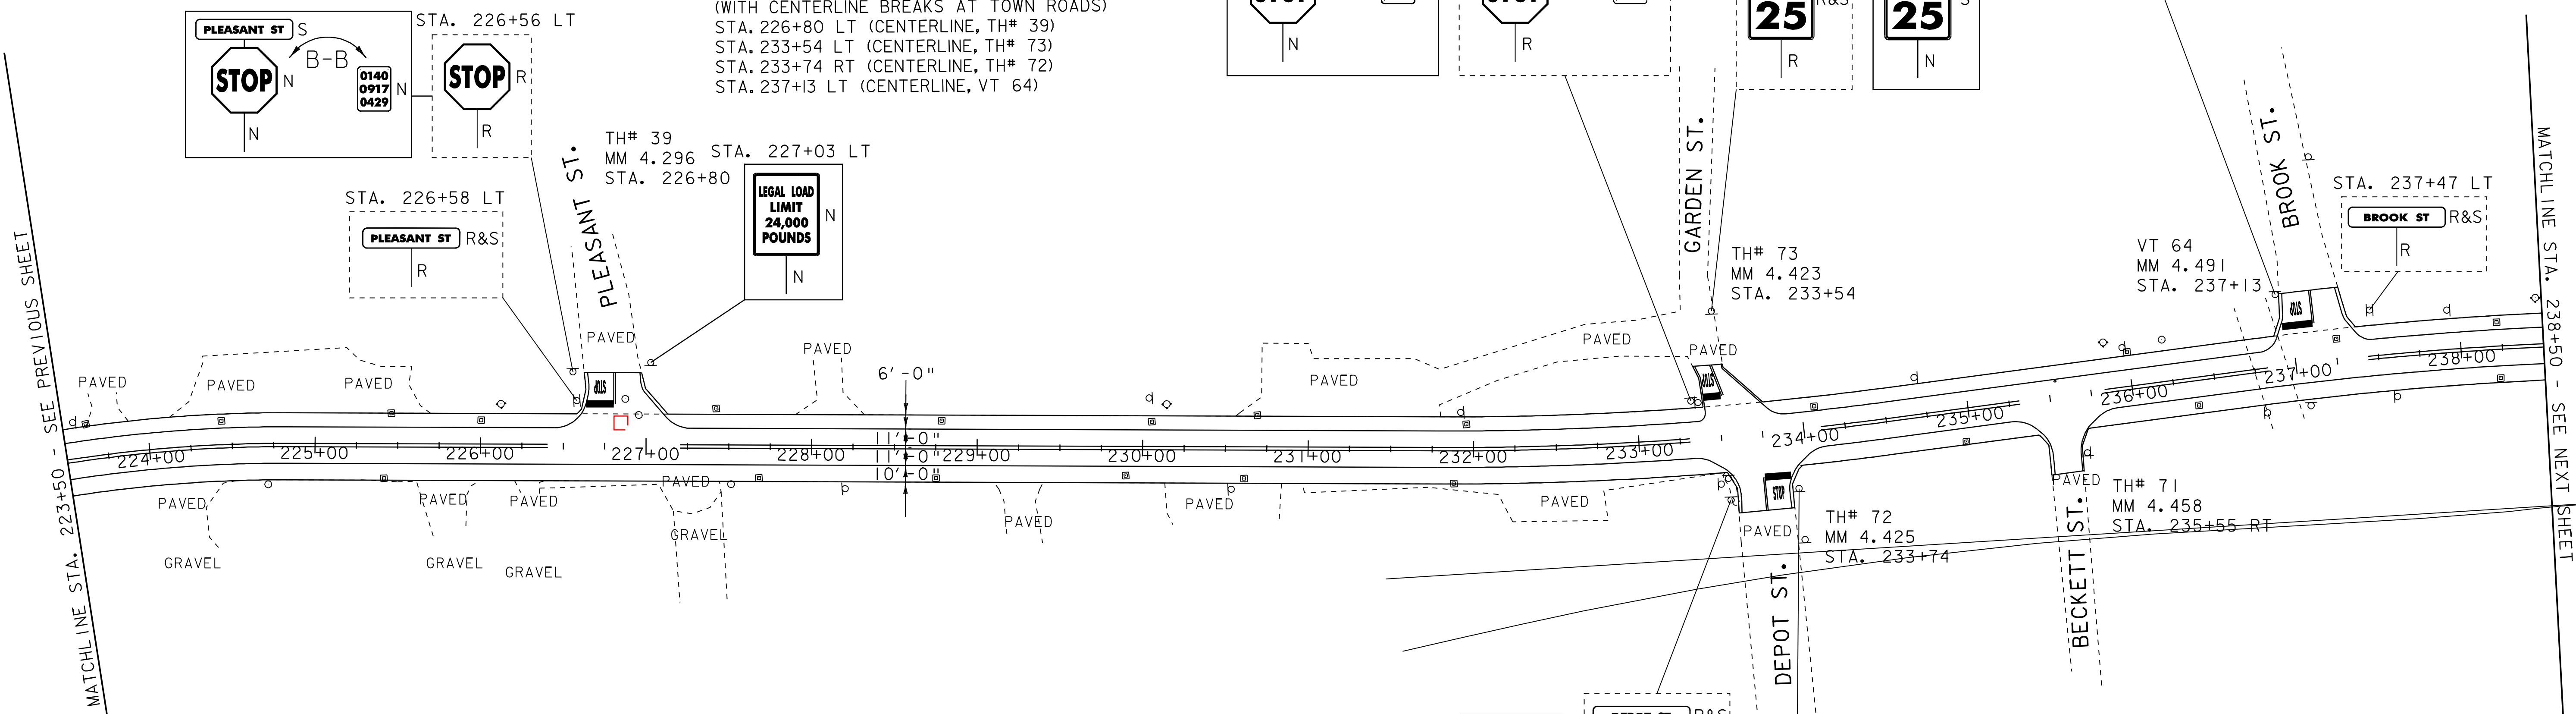

646.492 DURABLE LETTER OR SYMBOL, THERMOPLASTIC
 STA. 226+75 LT "STOP" (TH# 39)
 STA. 233+50 LT "STOP" (TH# 73)
 STA. 233+85 RT "STOP" (TH# 72)
 STA. 237+00 LT "STOP" (VT 64)

646.692 TEMPORARY LETTER OR SYMBOL, PAINT
 STA. 226+75 LT "STOP" (TH# 39)
 STA. 233+50 LT "STOP" (TH# 73)
 STA. 233+85 RT "STOP" (TH# 72)
 STA. 237+00 LT "STOP" (VT 64)

604.40 CHANGING ELEVATION OF DROP INLETS,
 CATCH BASINS, OR MANHOLES
 STA. 226+96 LT
 STA. 238+23 RT

226+



604.42 CHANGING ELEVATION OF SEWER MANHOLES
 STA. 226+88 LT

604.412 REHAB. DROP INLETS, CATCH BASINS,
 OR MANHOLES, CLASS I

STA. 223+63 LT	STA. 228+78 LT	STA. 234+96 RT
STA. 224+45 LT	STA. 229+90 RT	STA. 236+00 LT
STA. 225+41 RT	STA. 230+05 LT	STA. 236+39 RT
STA. 225+46 LT	STA. 230+61 RT	STA. 237+26 LT
STA. 226+00 LT	STA. 230+69 LT	STA. 238+22 LT
STA. 227+42 LT	STA. 231+88 RT	STA. 238+22 LT
STA. 227+68 RT	STA. 231+96 LT	
STA. 228+75 RT	STA. 234+07 LT	


675.50 REMOVING SIGNS
 AS SHOWN - 14

675.60 ERECTING SALVAGED SIGNS
 AS SHOWN - 6

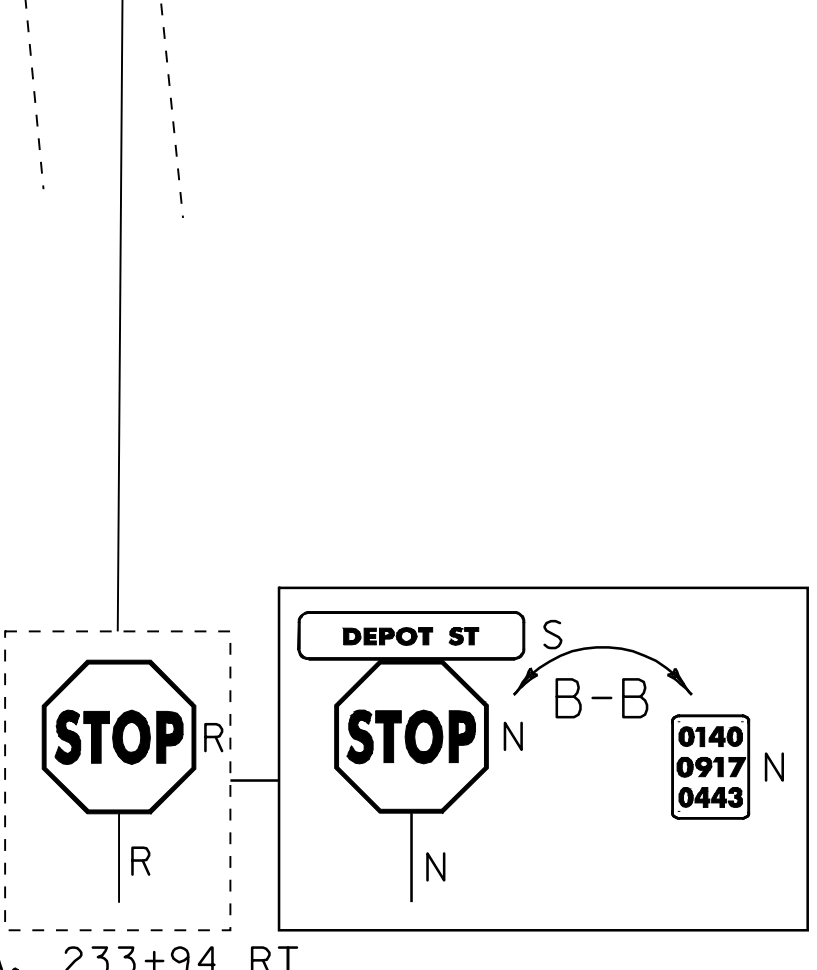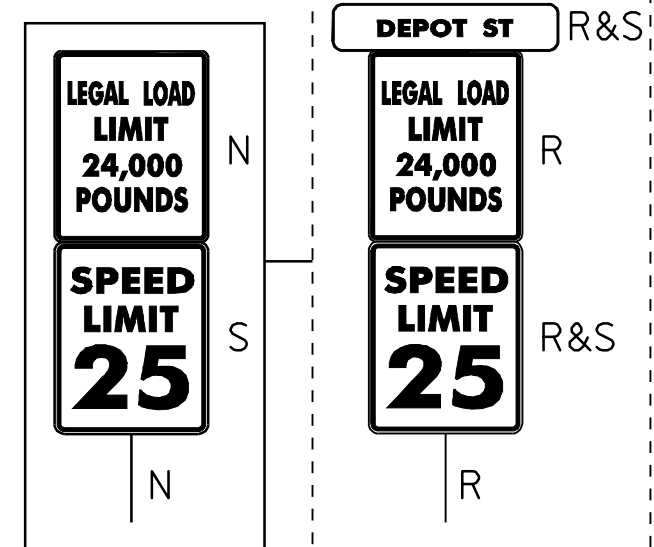

SIGN LEGEND
 R = REMOVE
 S = SALVAGE
 N = NEW
 RET = RETAIN
 B-B = BACK TO BACK

DATUM	
VERTICAL	N/A
HORIZONTAL	N/A

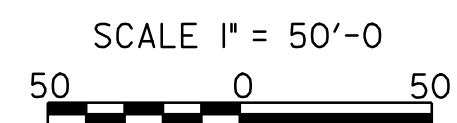

PROJECT LAYOUT SHEET 3

PROJECT NAME:	WILLIAMSTOWN-BARRE TOWN
PROJECT NUMBER:	STP 2210(I)S
FILE NAME:	p99ci72.dgn
PROJECT LEADER:	EPD
DESIGNED BY:	CDL
PLOT FILE:	p99ci72103.1
PLOT DATE:	29-APR-2009 13:3
DRAWN BY:	RHB
CHECKED BY:	EPD
SHEET	15 OF 32