

646.403 DURABLE 4 INCH WHITE LINE, EPOXY PAINT  
 STA. 74+50 - STA. 90+40 (SOLID LT & RT)  
 (WITH EDGELINE BREAKS AT TOWN ROADS)  
 STA. 76+55 LT (EDGELINES, TH#59)  
 STA. 79+55 RT (EDGELINES, TH#214)  
 STA. 82+65 LT (EDGELINES, SMOKEHOUSE LN.)  
 STA. 84+75 - STA. 87+10 (DOTTED LT)  
 STA. 87+10 - STA. 88+60 (SOLID LT)  
 STA. 89+24 LT (EDGELINES, VT 63)  
 STA. 89+24 RT (EDGELINES, TH#4)  
 STA. 89+81 - STA. 90+40 (SOLID LT)

646.482 DURABLE 24 INCH STOP BAR, THERMOPLASTIC  
 STA. 76+41LT - STA. 76+55 LT (TH# 59)  
 STA. 79+55 RT - STA. 79+67 RT (TH# 214)  
 STA. 82+46 LT - STA. 82+65 LT (SMOKEHOUSE LN.)  
 STA. 88+61LT & RT  
 STA. 88+83 LT - STA. 89+15 LT (VT 63)  
 STA. 89+24 RT - STA. 89+50 RT (TH# 4)  
 STA. 89+80 LT  
 STA. 90+06 LT

646.602 TEMPORARY 4 INCH WHITE LINE, PAINT  
 STA. 74+50 - STA. 90+40 (SOLID LT & RT)  
 (WITH EDGELINE BREAKS AT TOWN ROADS)  
 STA. 76+55 LT (EDGELINES, TH#59)  
 STA. 79+55 RT (EDGELINES, TH#214)  
 STA. 82+65 LT (EDGELINES, SMOKEHOUSE LN.)  
 STA. 84+75 - STA. 87+10 (DOTTED LT)  
 STA. 87+10 - STA. 88+60 (SOLID LT)  
 STA. 89+24 LT (EDGELINES, VT 63)  
 STA. 89+24 RT (EDGELINES, TH#4)  
 STA. 89+81 - STA. 90+40 (SOLID LT)

646.692 TEMPORARY LETTER OR SYMBOL, PAINT  
 STA. 76+48 LT "STOP" (TH# 59) STA. 88+46 RT "ARROW"  
 STA. 79+61RT "STOP" (TH# 214) STA. 88+49 RT "ARROW"  
 STA. 81+46 RT "SIGNAL" STA. 88+52 LT "ARROW"  
 STA. 81+86 RT "AHEAD" STA. 88+91LT "ARROW" (VT 63)  
 STA. 82+58 LT "STOP" (SMOKEHOUSE LN.) STA. 88+93 LT "ARROW" (VT 63)  
 STA. 89+08 LT "ARROW" (VT 63)  
 STA. 87+18 LT "ARROW" STA. 89+93 LT "ARROW"  
 STA. 87+18 RT "ARROW" STA. 89+95 LT "ARROW"  
 STA. 87+21RT "ARROW" STA. 90+15 LT "ARROW"  
 STA. 87+85 LT "ONLY"

646.492 DURABLE LETTER OR SYMBOL, THERMOPLASTIC  
 STA. 76+48 LT "STOP" (TH# 59) STA. 88+46 RT "ARROW"  
 STA. 79+61RT "STOP" (TH# 214) STA. 88+49 RT "ARROW"  
 STA. 81+46 RT "SIGNAL" STA. 88+52 LT "ARROW"  
 STA. 81+86 RT "AHEAD" STA. 88+91LT "ARROW" (VT 63)  
 STA. 82+58 LT "STOP" (SMOKEHOUSE LN.) STA. 88+93 LT "ARROW" (VT 63)  
 STA. 89+08 LT "ARROW" (VT 63)  
 STA. 87+18 LT "ARROW" STA. 89+93 LT "ARROW"  
 STA. 87+18 RT "ARROW" STA. 89+95 LT "ARROW"  
 STA. 87+21RT "ARROW" STA. 90+15 LT "ARROW"  
 STA. 87+85 LT "ONLY"

646.612 TEMPORARY 4 INCH YELLOW LINE, PAINT  
 STA. 74+50 - STA. 88+65 (SOLID LT & RT)  
 (WITH CENTERLINE BREAKS AT TOWN ROADS)  
 STA. 76+55 LT (CENTERLINE, TH#59)  
 STA. 79+55 RT (CENTERLINE, TH#214)  
 STA. 82+65 LT (CENTERLINE, SMOKEHOUSE LN.)  
 STA. 89+24 RT (CENTERLINE, TH#4)  
 STA. 89+24 LT (CENTERLINE, VT 63)  
 STA. 90+05 - STA. 90+40 (SOLID LT, CENTERLINE)


646.702 TEMPORARY CROSSWALK MARKING, PAINT  
 STA. 88+80 RT - STA. 89+61RT (TH#4)

675.50 REMOVING SIGNS  
 AS SHOWN - 12

675.60 ERECTING SALVAGED SIGNS  
 AS SHOWN - 4

646.652 TEMPORARY 8 INCH YELLOW LINE, PAINT  
 STA. 85+75 - STA. 87+00 (HATCHED LT)

646.682 TEMPORARY 24 INCH STOP BAR, PAINT  
 STA. 76+41LT - STA. 76+55 LT (TH# 59)  
 STA. 79+55 RT - STA. 79+67 RT (TH# 214)  
 STA. 82+46 LT - STA. 82+65 LT (SMOKEHOUSE LN.)  
 STA. 88+61LT & RT  
 STA. 88+83 LT - STA. 89+15 LT (VT 63)  
 STA. 89+24 RT - STA. 89+50 RT (TH# 4)  
 STA. 89+80 LT STA. 90+06 LT

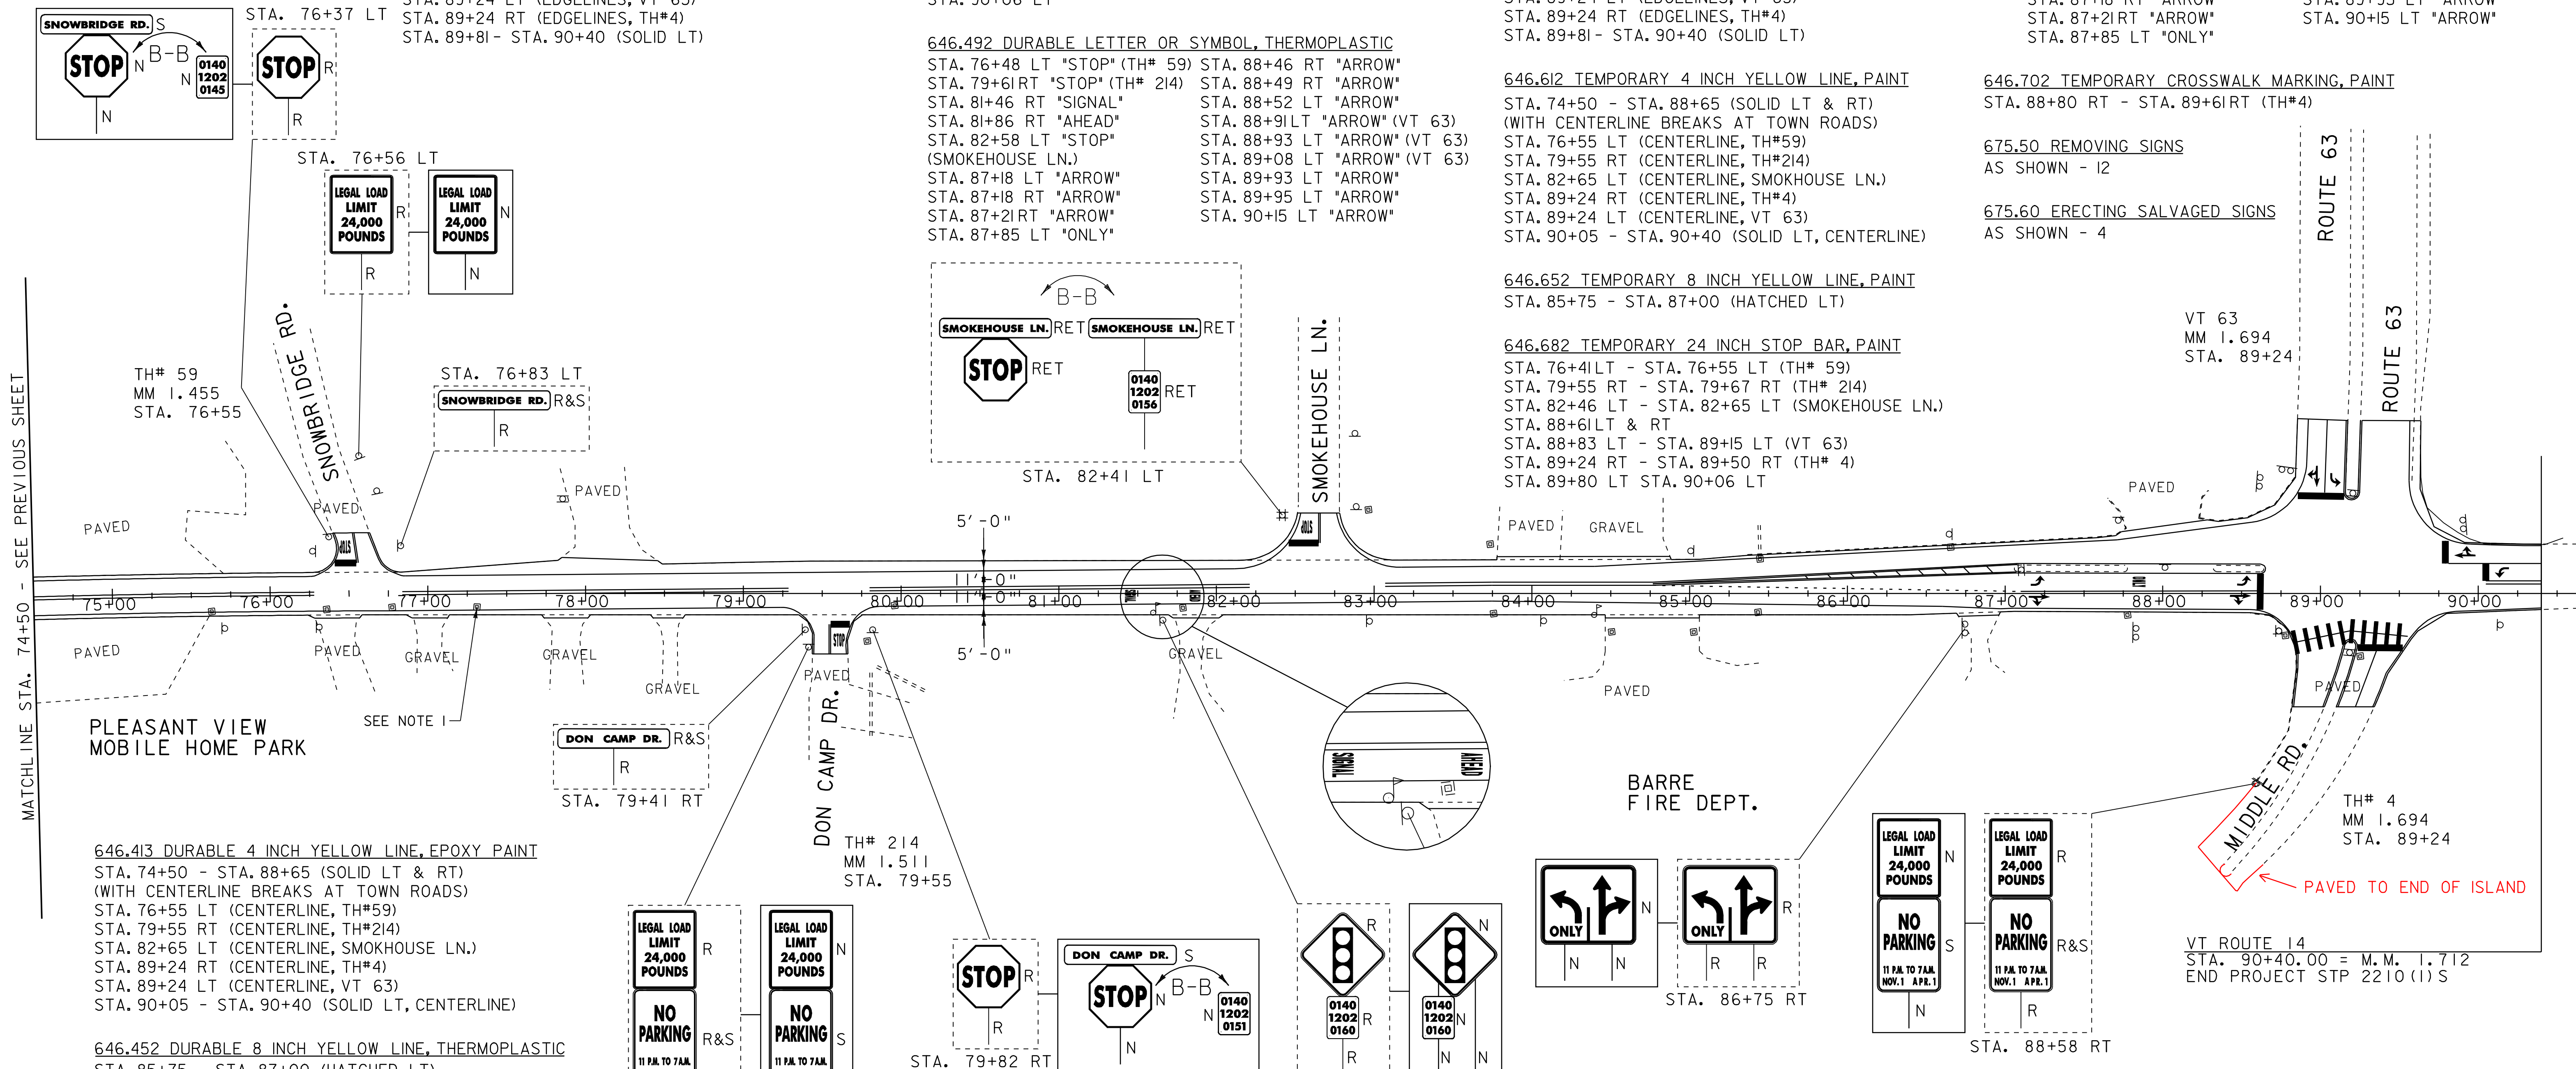

MATCHLINE STA. 74+50 - SEE PREVIOUS SHEET

TH# 59  
MM 1.455  
STA. 76+55

STA. 76+83 LT  
SNOWBRIDGE RD. R&S

SMOKEHOUSE LN. RET  
0140 1202 0156 RET

DON CAMP DR. R&S  
STA. 79+41 RT

TH# 214  
MM 1.511  
STA. 79+55

646.413 DURABLE 4 INCH YELLOW LINE, EPOXY PAINT  
 STA. 74+50 - STA. 88+65 (SOLID LT & RT)  
 (WITH CENTERLINE BREAKS AT TOWN ROADS)  
 STA. 76+55 LT (CENTERLINE, TH#59)  
 STA. 79+55 RT (CENTERLINE, TH#214)  
 STA. 82+65 LT (CENTERLINE, SMOKEHOUSE LN.)  
 STA. 89+24 RT (CENTERLINE, TH#4)  
 STA. 89+24 LT (CENTERLINE, VT 63)  
 STA. 90+05 - STA. 90+40 (SOLID LT, CENTERLINE)

646.452 DURABLE 8 INCH YELLOW LINE, THERMOPLASTIC  
 STA. 85+75 - STA. 87+00 (HATCHED LT)

LEGAL LOAD LIMIT 24,000 POUNDS  
NO PARKING 11 P.M. TO 7 A.M. NOV. 1 APR. 1

STOP DON CAMP DR. B-B 0140 1202 0151

0140 1202 0160

ONLY

LEGAL LOAD LIMIT 24,000 POUNDS  
NO PARKING 11 P.M. TO 7 A.M. NOV. 1 APR. 1

TH# 4  
MM 1.694  
STA. 89+24

VT ROUTE 14  
STA. 90+40.00 = M.M. 1.712  
END PROJECT STP 2210(I)S

NOTE:

1. EXISTING DRAINAGE GRATE IS LOCATED BENEATH THE SIDEWALK. THE CONTRACTOR SHALL REMOVE THE SIDEWALK SLAB ABOVE THE EXISTING DRAINAGE STRUCTURE, REFORM STRUCTURE TO ALLOW FRAME AND GRATE TO BE ADJACENT TO SIDEWALK, AND RECONSTRUCT SIDEWALK. REMOVAL OF THE SIDEWALK SHALL BE PAID UNDER ITEM 203.16, "SOLID ROCK EXCAVATION". REFORMING THE STRUCTURE SHALL BE PAID UNDER ITEM 604.412, "REHAB. DROP INLETS, CATCH BASINS, OR MANHOLES, CLASS 1". NEW SIDEWALK WILL BE PAID UNDER ITEM 618.10, "PORTLAND CEMENT CONCRETE SIDEWALK, 5 INCH".

**SIGN LEGEND**  
 R = REMOVE  
 S = SALVAGE  
 N = NEW  
 RET = RETAIN  
 B-B = BACK TO BACK

604.412 REHAB. DROP INLETS, CATCH BASINS, OR MANHOLES, CLASS 1

STA. 75+60 RT STA. 83+76 RT  
 STA. 76+35 RT STA. 85+43 RT  
 STA. 76+77 RT STA. 85+45 LT  
 STA. 77+31RT STA. 86+65 LT  
 STA. 79+96 RT STA. 87+78 RT  
 STA. 81+79 RT STA. 89+25 RT

616.47 BITUMINOUS CONCRETE GUTTERS AND TRAFFIC ISLANDS

STA. 76+60 RT - STA. 76+77 RT  
 STA. 77+15 RT - STA. 77+71RT  
 STA. 78+03 RT - STA. 78+43 RT  
 STA. 78+65 RT - STA. 79+37 RT  
 STA. 79+75 RT - STA. 81+70 RT  
 STA. 82+66 RT - STA. 84+44 RT


617.10 RELOCATE MAILBOX, SINGLE SUPPORT

STA. 81+60 RT  
 STA. 84+40 RT

646.502 DURABLE CROSSWALK MARKING, THERMOPLASTIC  
 STA. 88+80 RT - STA. 89+61RT (TH#4)

DATUM

VERTICAL	N/A
HORIZONTAL	N/A

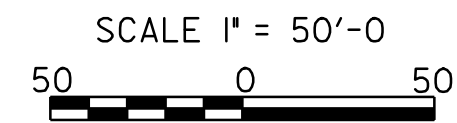

**PROJECT LAYOUT SHEET 11**

PROJECT NAME: WILLIAMSTOWN-BARRE TOWN  
 PROJECT NUMBER: STP 2210(I)S

FILE NAME: p99c172.dgn  
 PROJECT LEADER: EPD  
 DESIGNED BY: CDL  
 PLOT FILE: p99c172III.I

PLOT DATE: 29-APR-2009 13:30  
 DRAWN BY: RHB  
 CHECKED BY: EPD  
 SHEET 23 OF 32