


CROSSWALK PATTERN DETAIL
NOT TO SCALE

**VT ROUTE 14, VT ROUTE 63, AND MIDDLE ROAD
INTERSECTION DETAILS**

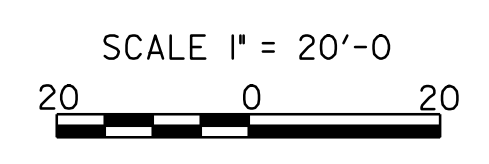

**INTERSECTION
DETAIL
SHEET**

PROJECT NAME: WILLIAMSTOWN-BARRE TOWN	
PROJECT NUMBER: STP 2210 (I)S	
FILE NAME: p99cl72.dgn	PLOT DATE: 29-APR-2009 13:3
PROJECT LEADER: EPD	DRAWN BY: RHB
DESIGNED BY: CDL	CHECKED BY: EPD
PLOT FILE: p99cl72ids.l	SHEET 24 OF 32