




**- APPROACH AREA DETAIL -**  
**JOHNSON**  
**STA 0+35 (BEGIN PROJECT)**

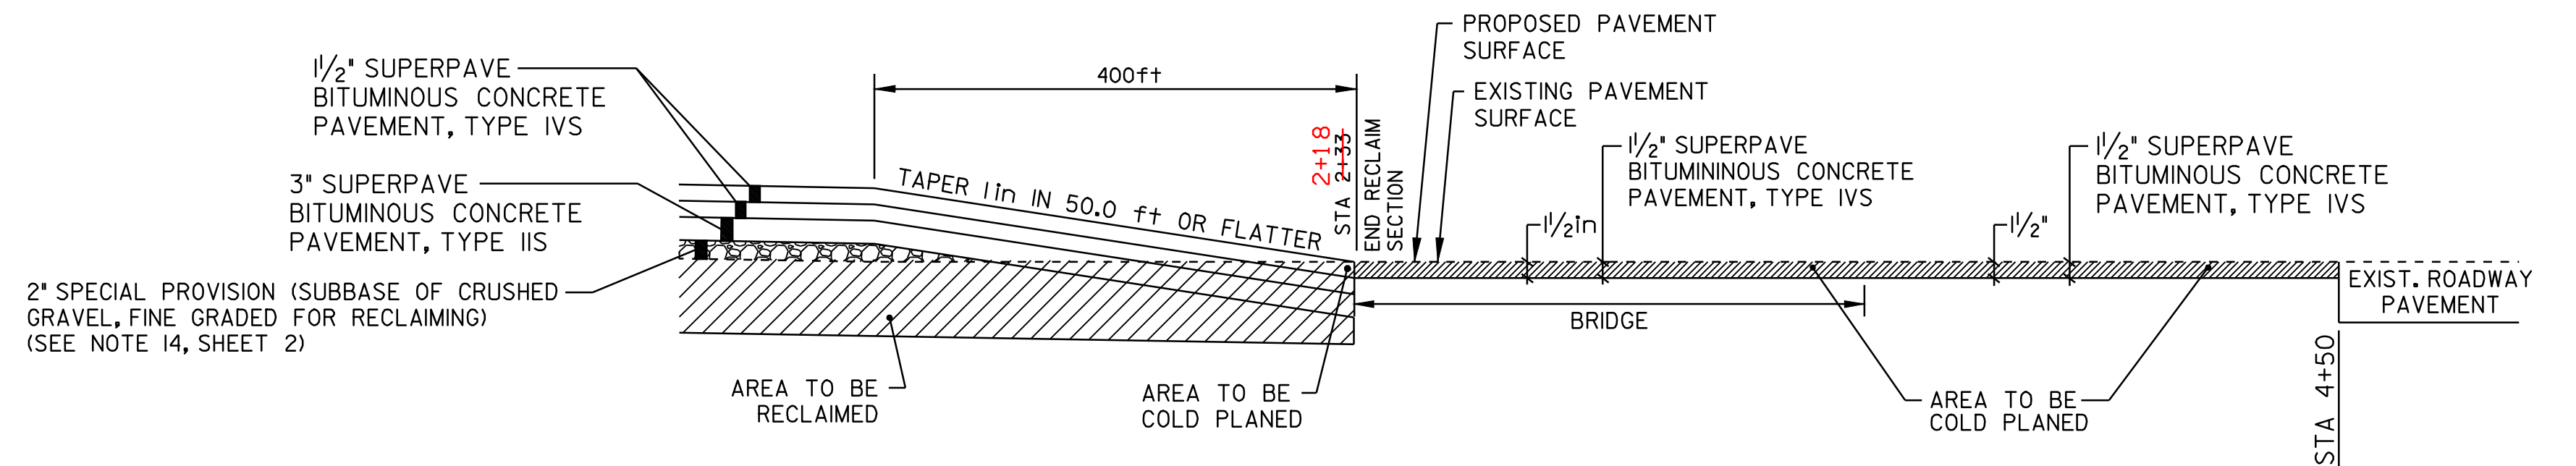

**- TRANSITION AREA DETAIL -**  
**HYDE PARK**  
**BRIDGE #6 TO END OF PROJECT**

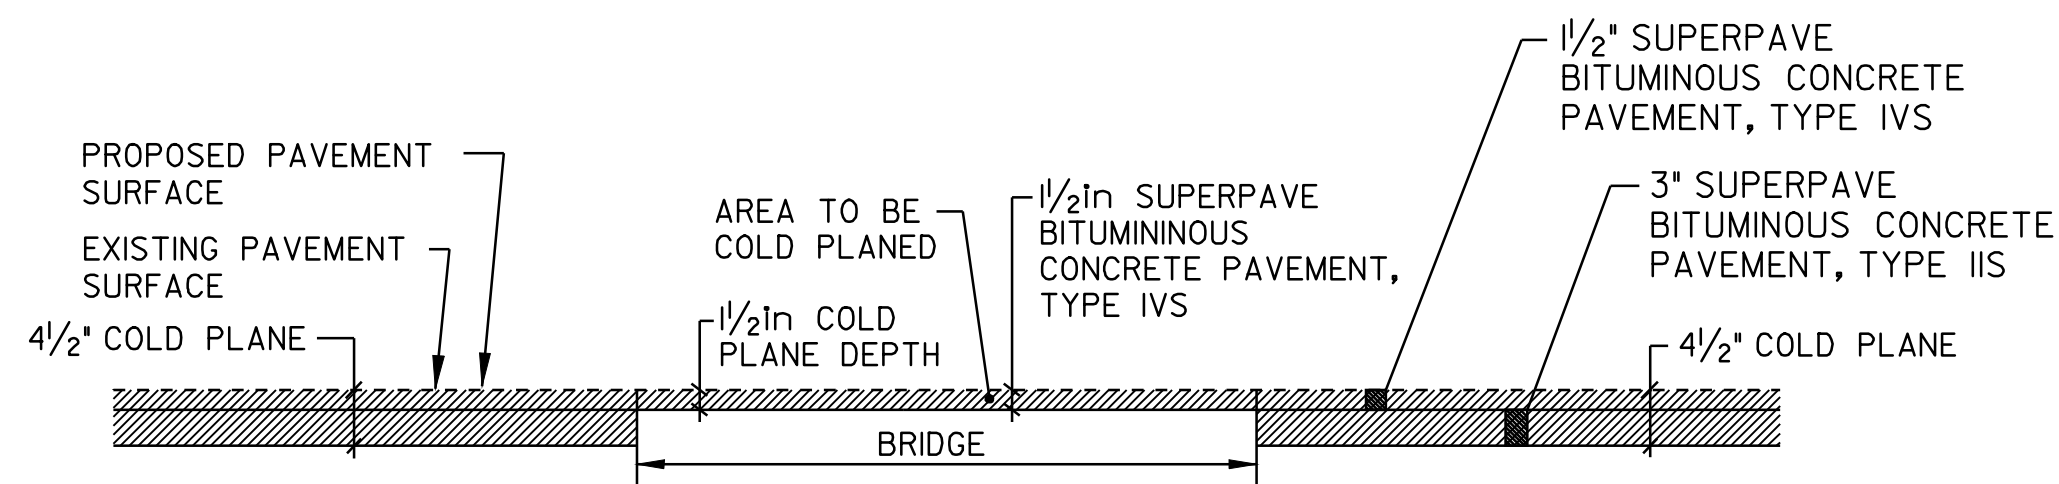

**- COLD PLANING DETAIL @ BRIDGES -**  
**JOHNSON**  
**BRIDGE #1 - STA 51+34**  
**BRIDGE #2 - STA 52+82**

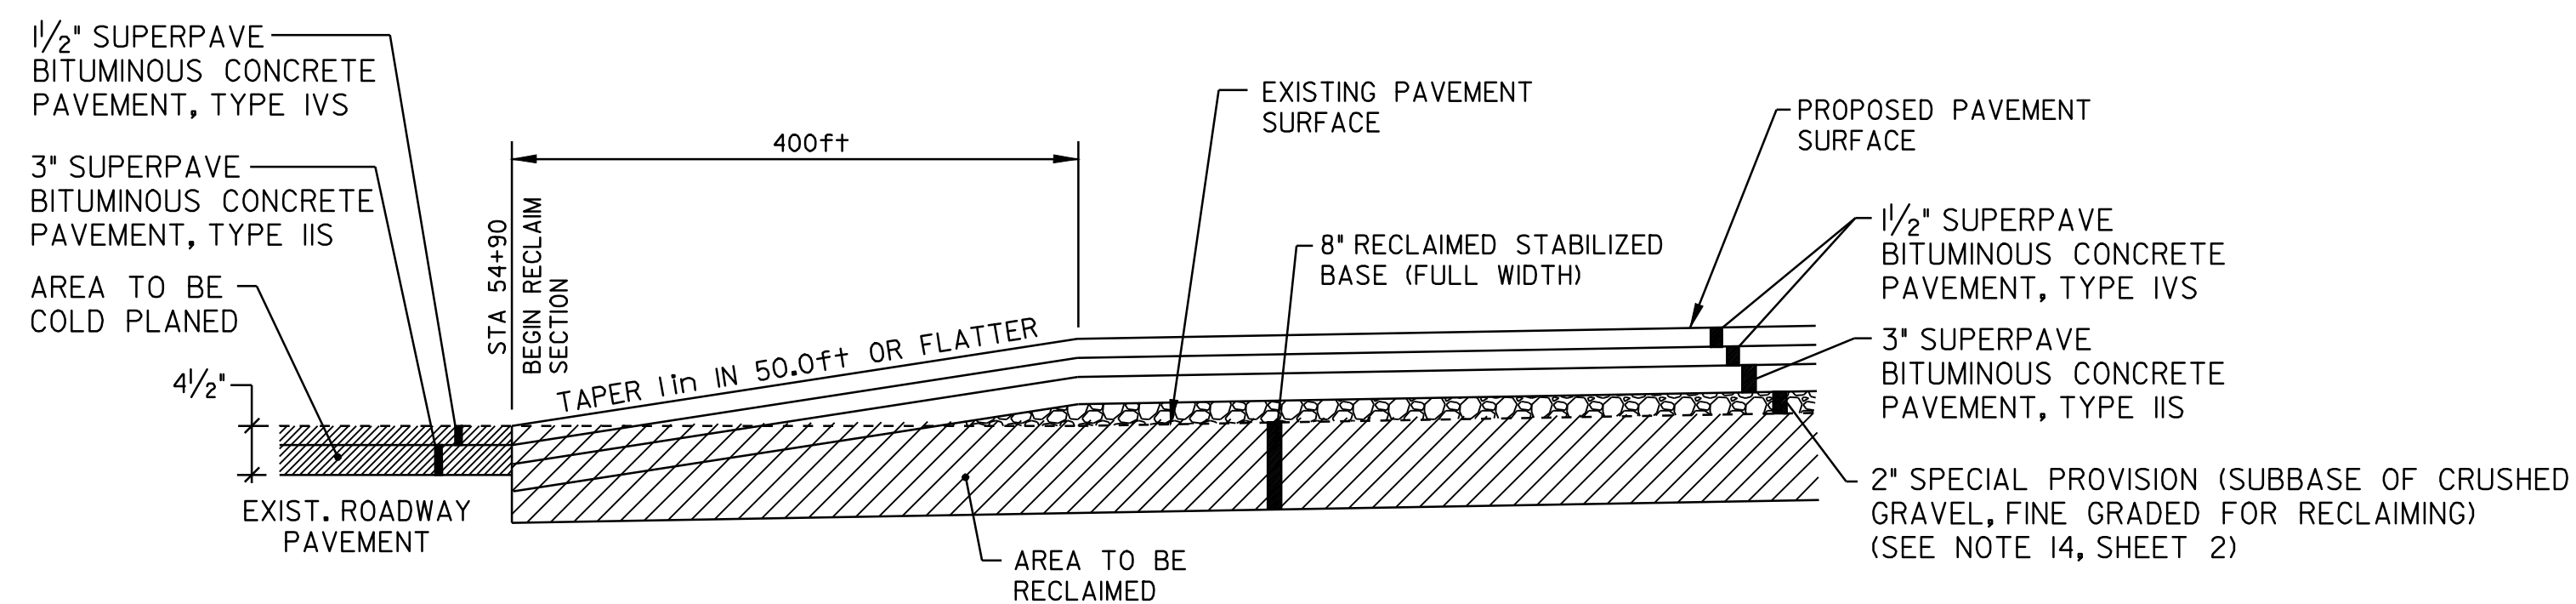

**-TRANSITION AREA DETAIL-**  
**JOHNSON**  
**STA 54+90**  
**(END COLD PLANING/BEGIN RECLAIMING)**

**CONSERVATION SEED MIX**  
RURAL AREA - SEED MIXTURE

% WT.	lbs./ACRE	NAME	PUR%	GERM%
37.5	22.5	CREeping RED FESCUE	98	85
37.5	22.5	TALL FESCUE	95	90
5.0	3	RED TOP	95	90
15.0	9	BIRDSFOOT TREFOIL	98	85
5.0	3	ANNUAL RYEGRASS	95	85
100.0	60			

SEED MIXTURE:  
SHALL NOT HAVE A WEED CONTENT EXCEEDING 0.40% BY WEIGHT AND SHALL BE FREE OF ALL NOXIOUS SEED.

SEED:  
TO BE APPLIED PER SEEDING FORMULAS OR AS DIRECTED BY THE ENGINEER.

FERTILIZER:  
FORMULA 10-20-10, TO BE USED WITH SEED, APPLIED AT THE RATE OF 500 lbs/ACRE. (HYDRO SEEDERS MAY USE 19-19-19 FORMULA)

AGRICULTURAL LIMESTONE:  
TO BE APPLIED AT THE RATE OF 2.0 TONS/ACRE, OR AS DIRECTED BY THE ENGINEER.

HAY MULCH:  
TO BE PLACED ON EARTH SLOPES AT THE RATE OF 2.0 TONS/ACRE, OR AS DIRECTED BY THE ENGINEER.

TOPSOIL:  
TO BE USED AS INDICATED ON THE PLANS, OR AS DIRECTED BY THE RESIDENT ENGINEER.

<b>PROJECT TYPICAL SHEET #2</b>	DESIGNED BY	BCE/PJM	DATE	6-07
	DRAWN BY	C.E.A., INC.	DATE	6-07
	DESIGN FILE NO.	p99cl82.dgn		
	PRF FILE	p99cl82+yp2.i	DATE PLOTTED	08-JAN-2009
	PROJ. NAME	JOHNSON - HYDE PARK		
PROJ. NO.	STP 2215(1)S			
SHEET	3	OF	33	SHEETS