

TEMPORARY 4in YELLOW LINE (PAINT)  
 DURABLE 4in YELLOW LINE (THERMOPLASTIC)  
 STA 83+00 TO 115+00  
 SOLID LT&RT

TEMPORARY 4in WHITE LINE (PAINT)  
 DURABLE 4in WHITE LINE (THERMOPLASTIC)  
 STA 83+00 TO 115+00  
 SOLID LT&RT

REMOVAL AND DISPOSAL OF GUARD RAIL  
 STA 83+00 TO 85+25 LT  
 83+78 85+05

STEEL BEAM GUARD RAIL, GALVANIZED  
 STA 83+00 TO 84+88 LT  
 83+78 85+78

MANUFACTURED TERMINAL SECTION, FLARED  
 STA 84+88 TO 85+25 LT  
 85+78 86+15


STEEL BEAM GUARDRAIL, GALVANIZED W/8' POSTS  
 STA 83+00 TO 83+78 LT

CURVE #4  
 PC = 83+00  
 PT = 86+70  
 R = 500ft  
 SEE SHEET 20 FOR  
 SUPERELEVATION DIAGRAM

CURVE #5  
 PC = 93+10  
 PT = 97+10  
 R = 1,200ft  
 SEE SHEET 21FOR  
 SUPERELEVATION DIAGRAM

CURVE #6  
 PC = 103+70  
 PT = 108+50  
 R = 750ft  
 SEE SHEET 21FOR  
 SUPERELEVATION DIAGRAM

CURVE #7  
 PC = 111+20  
 PT = 114+90  
 R = 1,700ft  
 SEE SHEET 21FOR  
 SUPERELEVATION DIAGRAM

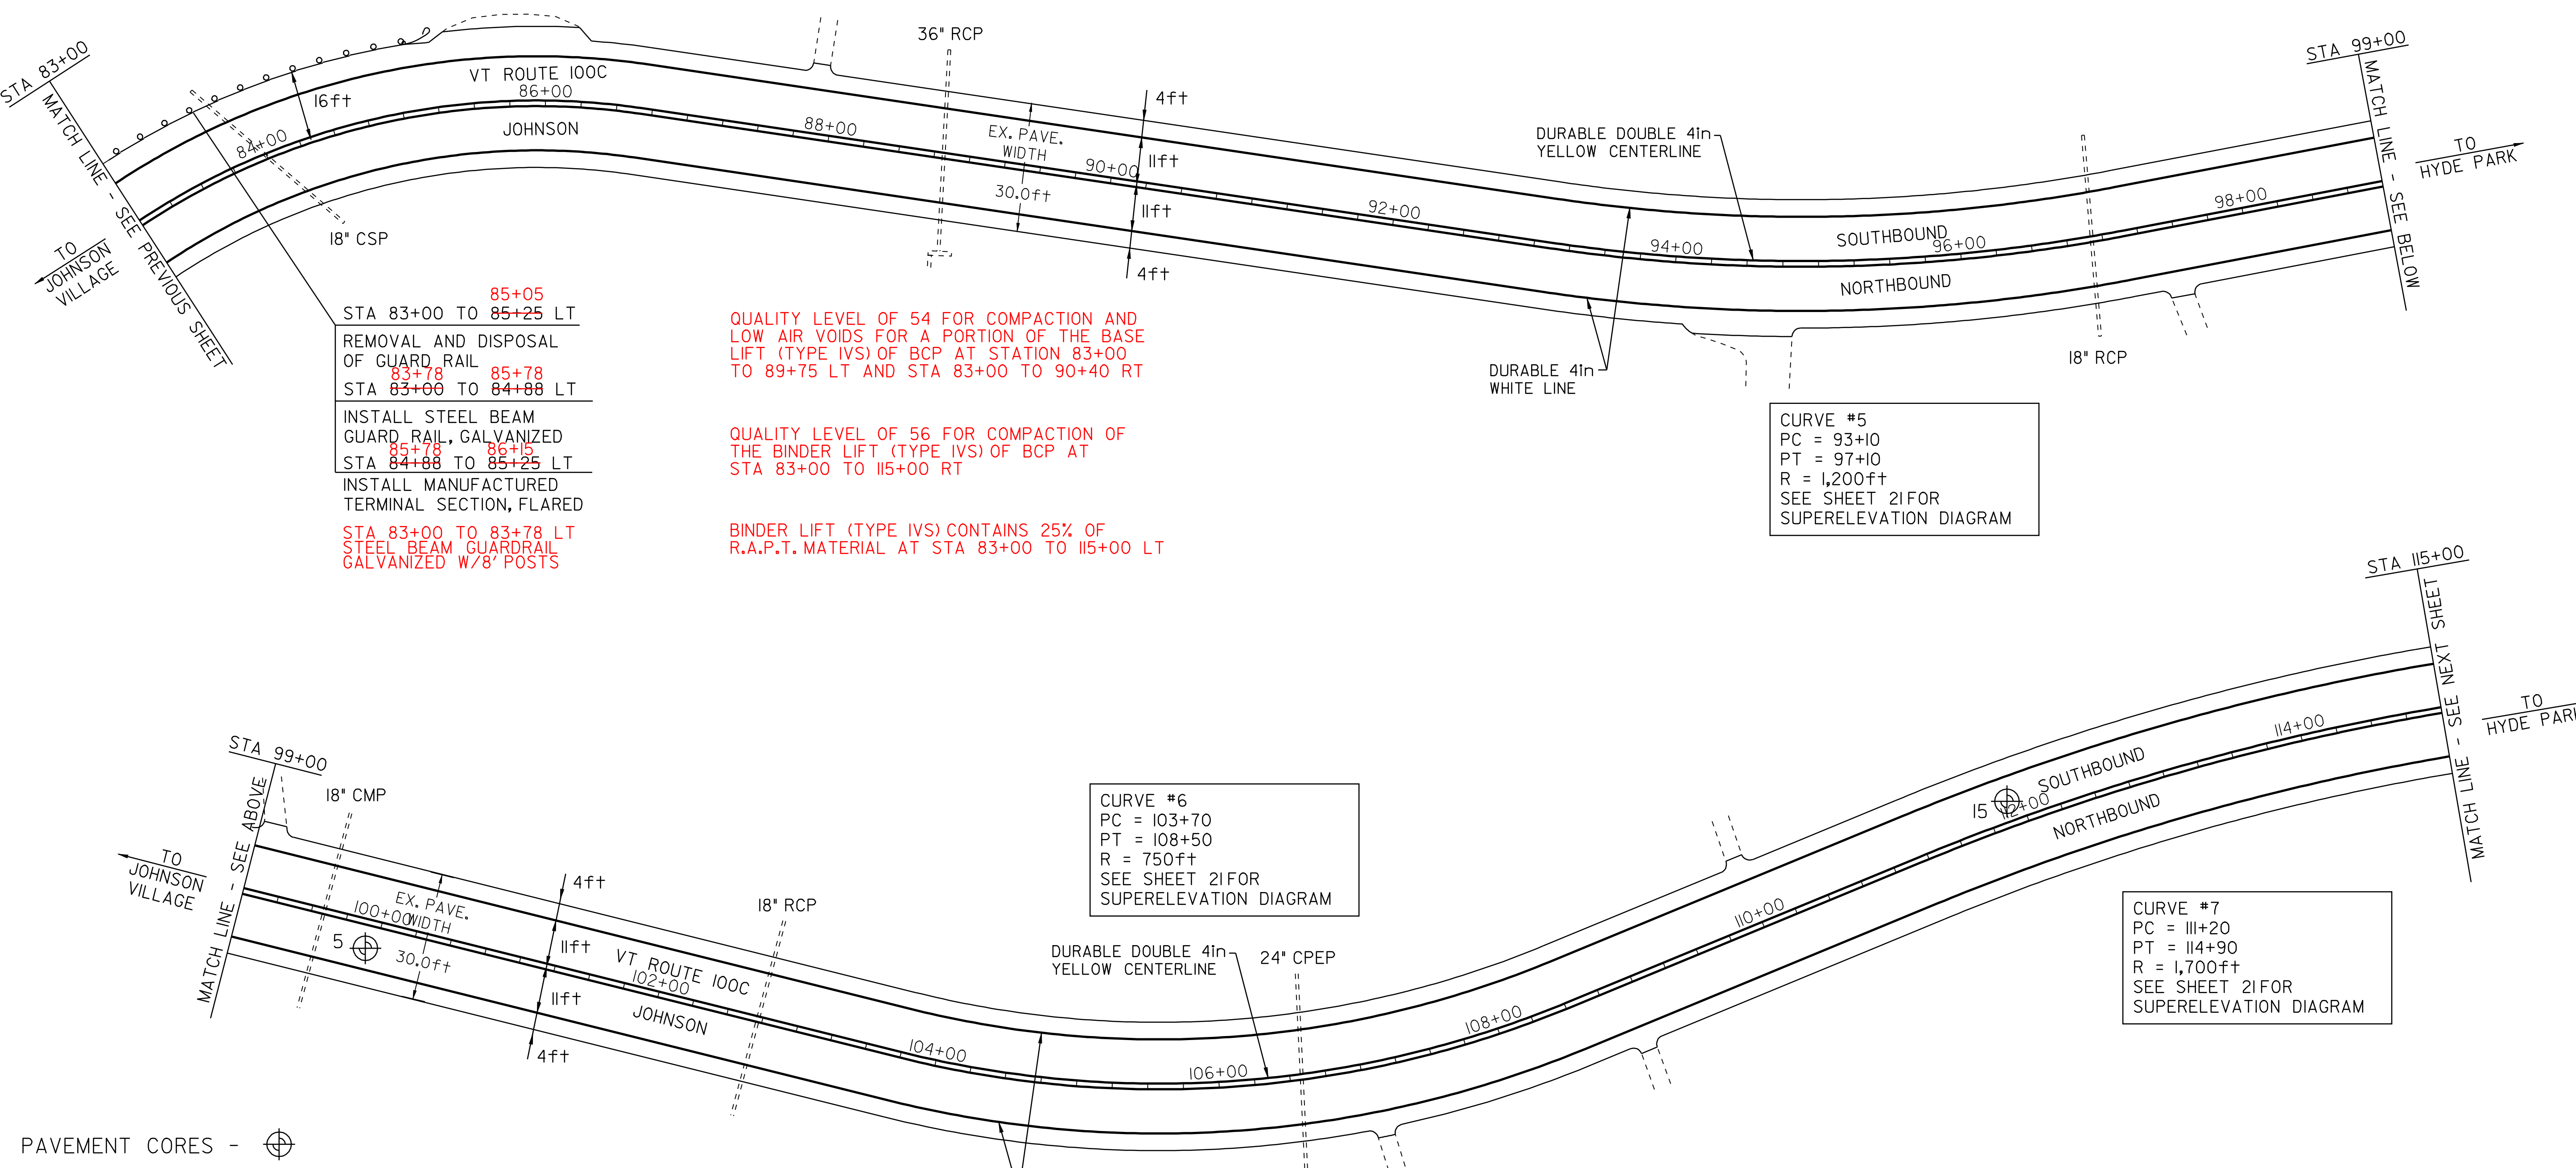

85+05  
 STA 83+00 TO 85+25 LT  
 REMOVAL AND DISPOSAL  
 OF GUARD RAIL  
 83+78 85+78  
 STA 83+00 TO 84+88 LT  
 INSTALL STEEL BEAM  
 GUARD RAIL, GALVANIZED  
 85+78 86+15  
 STA 84+88 TO 85+25 LT  
 INSTALL MANUFACTURED  
 TERMINAL SECTION, FLARED  
 STA 83+00 TO 83+78 LT  
 STEEL BEAM GUARDRAIL  
 GALVANIZED W/8' POSTS

QUALITY LEVEL OF 54 FOR COMPACTION AND  
 LOW AIR VOIDS FOR A PORTION OF THE BASE  
 LIFT (TYPE IVS) OF BCP AT STATION 83+00  
 TO 89+75 LT AND STA 83+00 TO 90+40 RT  
 QUALITY LEVEL OF 56 FOR COMPACTION OF  
 THE BINDER LIFT (TYPE IVS) OF BCP AT  
 STA 83+00 TO 115+00 RT  
 BINDER LIFT (TYPE IVS) CONTAINS 25% OF  
 R.A.P.T. MATERIAL AT STA 83+00 TO 115+00 LT

PAVEMENT CORES - ⊕

#	TOTAL DEPTH (in)	DRAINABLE BASE	SOLID CORE	COMMENTS
5	5.0	NO	YES	STEARNS RD
15	7.75	NO	YES	--

NOTE:  
 - NO PCC UNDER ANY CORES  
 - NO CORES OVER ASPHALTED  
 - NO SHOULDER CORES  
 - NO STRIPPED CORES

## PAVING PROJECT LAYOUT SHEET #5

DESIGNED BY	BCE/PJM	DATE	7-07
DRAWN BY	C.E.A., INC.	DATE	7-07
DESIGN FILE NO.	p99c182.dgn		
PRF FILE	p99c182p105.i	DATE PLOTTED	08-JAN-2009
PROJ. NAME	JOHNSON - HYDE PARK		
PROJ. NO.	STP 2215(1)S		
SHEET	14	OF	33 SHEETS