

TEMPORARY 4in YELLOW LINE (PAINT)
DURABLE 4in YELLOW LINE (THERMOPLASTIC)
STA 115+00 TO 145+00 SOLID LT&RT
STA 141+21 DOUBLE SOLID RT
(WITH CENTERLINE BREAKS FOR TOWN HIGHWAYS)

TEMPORARY 4in WHITE LINE (PAINT)
DURABLE 4in WHITE LINE (THERMOPLASTIC)
STA 115+00 TO 145+00 SOLID LT&RT
(WITH EDGELINE BREAKS FOR TOWN HIGHWAYS)

STEARNS RD
TH #68
STA 123+26=
MM 2.334
(CLASS III)

123+57 126+43
STA 123+42 TO 126+42 LT
REMOVAL AND DISPOSAL
OF GUARD RAIL
123+50 123+87
STA 123+42 TO 123+79 LT
INSTALL MANUFACTURED
TERMINAL SECTION, FLARED

123+87 126+12
STA 123+79 TO 126+05 LT
INSTALL STEEL BEAM
GUARD RAIL, GALVANIZED
126+12 126+49
STA 126+05 TO 126+42 LT
INSTALL MANUFACTURED
TERMINAL SECTION, FLARED

TEMPORARY LETTER OR SYMBOL (PAINT)
DURABLE LETTER OR SYMBOL (THERMOPLASTIC)
STA 141+21RT "STOP"

TEMPORARY 24in STOP BAR (PAINT)
DURABLE 24in STOP BAR (THERMOPLASTIC)
STA 141+21RT WHITCOMB ISLAND RD

CURVES #8 & #9
PC = 119+70
PCC = 122+10
R = 720ft
PCC = 122+10
PT = 127+50
R = 560ft
SEE SHEET 22 FOR
SUPERELEVATION DIAGRAM

REMOVE SIGNS
1

QUALITY LEVEL OF 56 FOR THE COMPACTION
OF THE BINDER LIFT (TYPE IVS) OF BCP
AT STA 115+00 TO 131+50 RT

THE BINDER LIFT (TYPE IVS) OF BCP
CONTAINS 25% R.A.P.T. MATERIAL
AT STA 115+00 TO 145+00 LT AND
AT STA 131+50 TO 145+00 RT

MINOR FAILURE ON
#200 FOR ITEM 900.680


REMOVAL AND DISPOSAL OF GUARD RAIL
STA 122+56 TO 125+44 RT 122+52 TO 125+38
STA 123+42 TO 126+42 LT 123+57 TO 126+43

STEEL BEAM GUARD RAIL, GALVANIZED
STA 123+79 TO 126+05 LT 123+87 TO 126+12

STEEL BEAM GUARD RAIL W/8 FOOT POSTS, GALVANIZED
STA 122+93 TO 125+07 RT 122+75 TO 125+00

MANUFACTURED TERMINAL SECTION, FLARED
STA 122+56 TO 122+93 RT 122+36 TO 122+75
STA 123+42 TO 123+79 LT 123+50 TO 123+87
STA 125+07 TO 125+44 RT 125+00 TO 125+38
STA 126+05 TO 126+42 LT 126+12 TO 126+44

CURVE #10
PC = 129+20
PT = 140+90
R = 790ft
SEE SHEET 22 FOR
SUPERELEVATION DIAGRAM

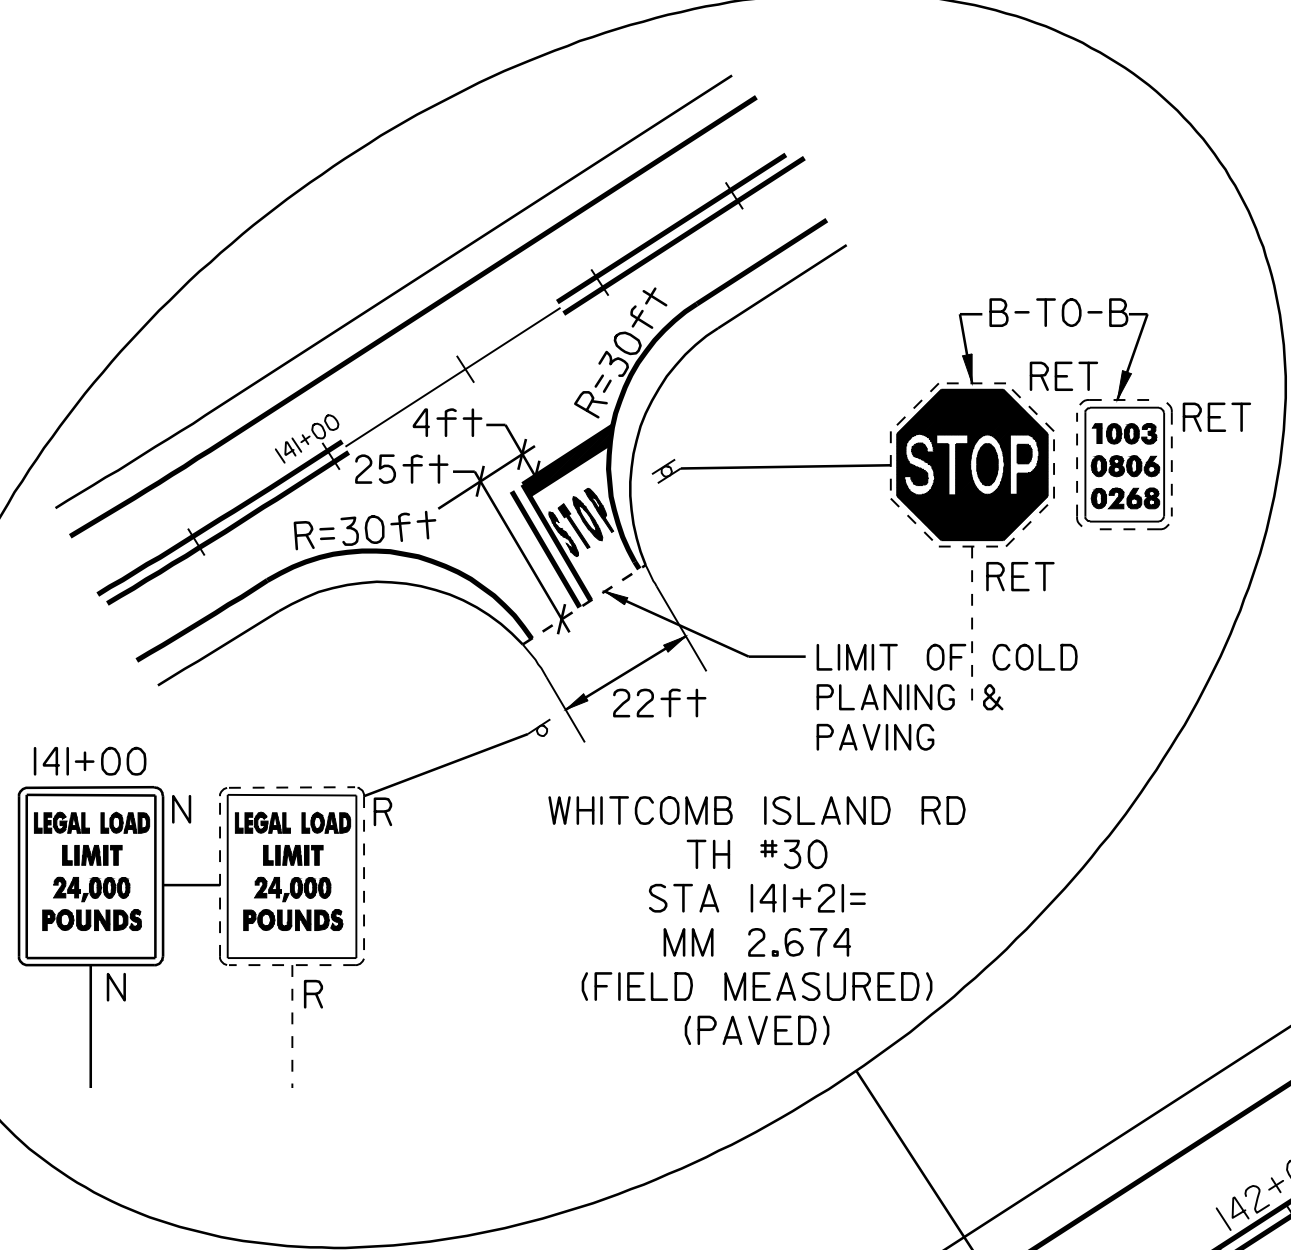

PAVEMENT CORES -

#	TOTAL DEPTH (1n)	DRAINABLE BASE	SOLID CORE	COMMENTS
6	5.0	NO	YES	CHIP SEAL

NOTE:
- NO PCC UNDER ANY CORES
- NO CORES OVER ASPHALTED
- NO SHOULDER CORES
- NO STRIPPED CORES

PAVING PROJECT LAYOUT SHEET #6

DESIGNED BY	BCE/PJM	DATE	7-07
DRAWN BY	C.E.A., INC.	DATE	7-07
DESIGN FILE NO.	p99c182.dgn		
PRF FILE	p99c182p106.i	DATE PLOTTED	08-JAN-2009
PROJ. NAME	JOHNSON - HYDE PARK		
PROJ. NO.	STP 2215(1)S		
SHEET	15	OF	33 SHEETS