

TEMPORARY 4in YELLOW LINE (PAINT)  
 DURABLE 4in YELLOW LINE (THERMOPLASTIC)

STA 145+00 TO 152+59 151+90 SOLID LT&RT  
 STA 151+51 DOUBLE SOLID LT&RT  
 STA 152+59 TO 156+56 SOLID LT & DASHED RT  
 STA 156+56 TO 163+68 DASHED  
 STA 163+68 TO 170+02 DASHED LT & SOLID RT  
 STA 170+02 TO 174+00 SOLID LT&RT  
 (WITH CENTERLINE BREAKS FOR TOWN HIGHWAYS)

151+90 TO 155+67  
 155+67 TO 162+64  
 162+64 TO 169+22  
 169+22 TO 174+00

TEMPORARY LETTER OR SYMBOL (PAINT)  
 DURABLE LETTER OR SYMBOL (THERMOPLASTIC)



STA 151+51LT "STOP"  
 STA 151+51RT "STOP"

TEMPORARY 4in WHITE LINE (PAINT)  
 DURABLE 4in WHITE LINE (THERMOPLASTIC)

STA 145+00 TO 174+00 SOLID LT&RT  
 (WITH EDGELINE BREAKS FOR TOWN HIGHWAYS)


TEMPORARY 24in STOP BAR (PAINT)  
 DURABLE 24in STOP BAR (THERMOPLASTIC)

STA 151+51LT MINE RD  
 STA 151+51RT WILSON RD

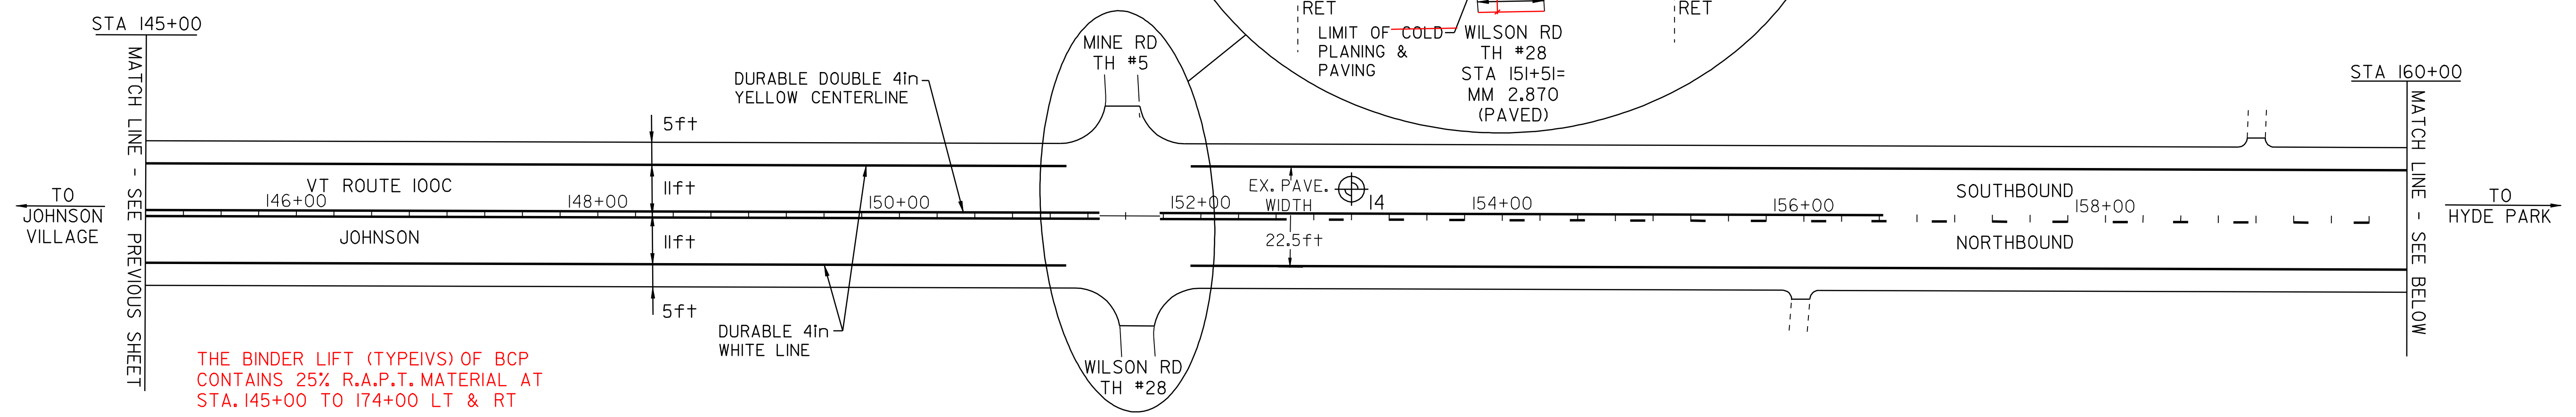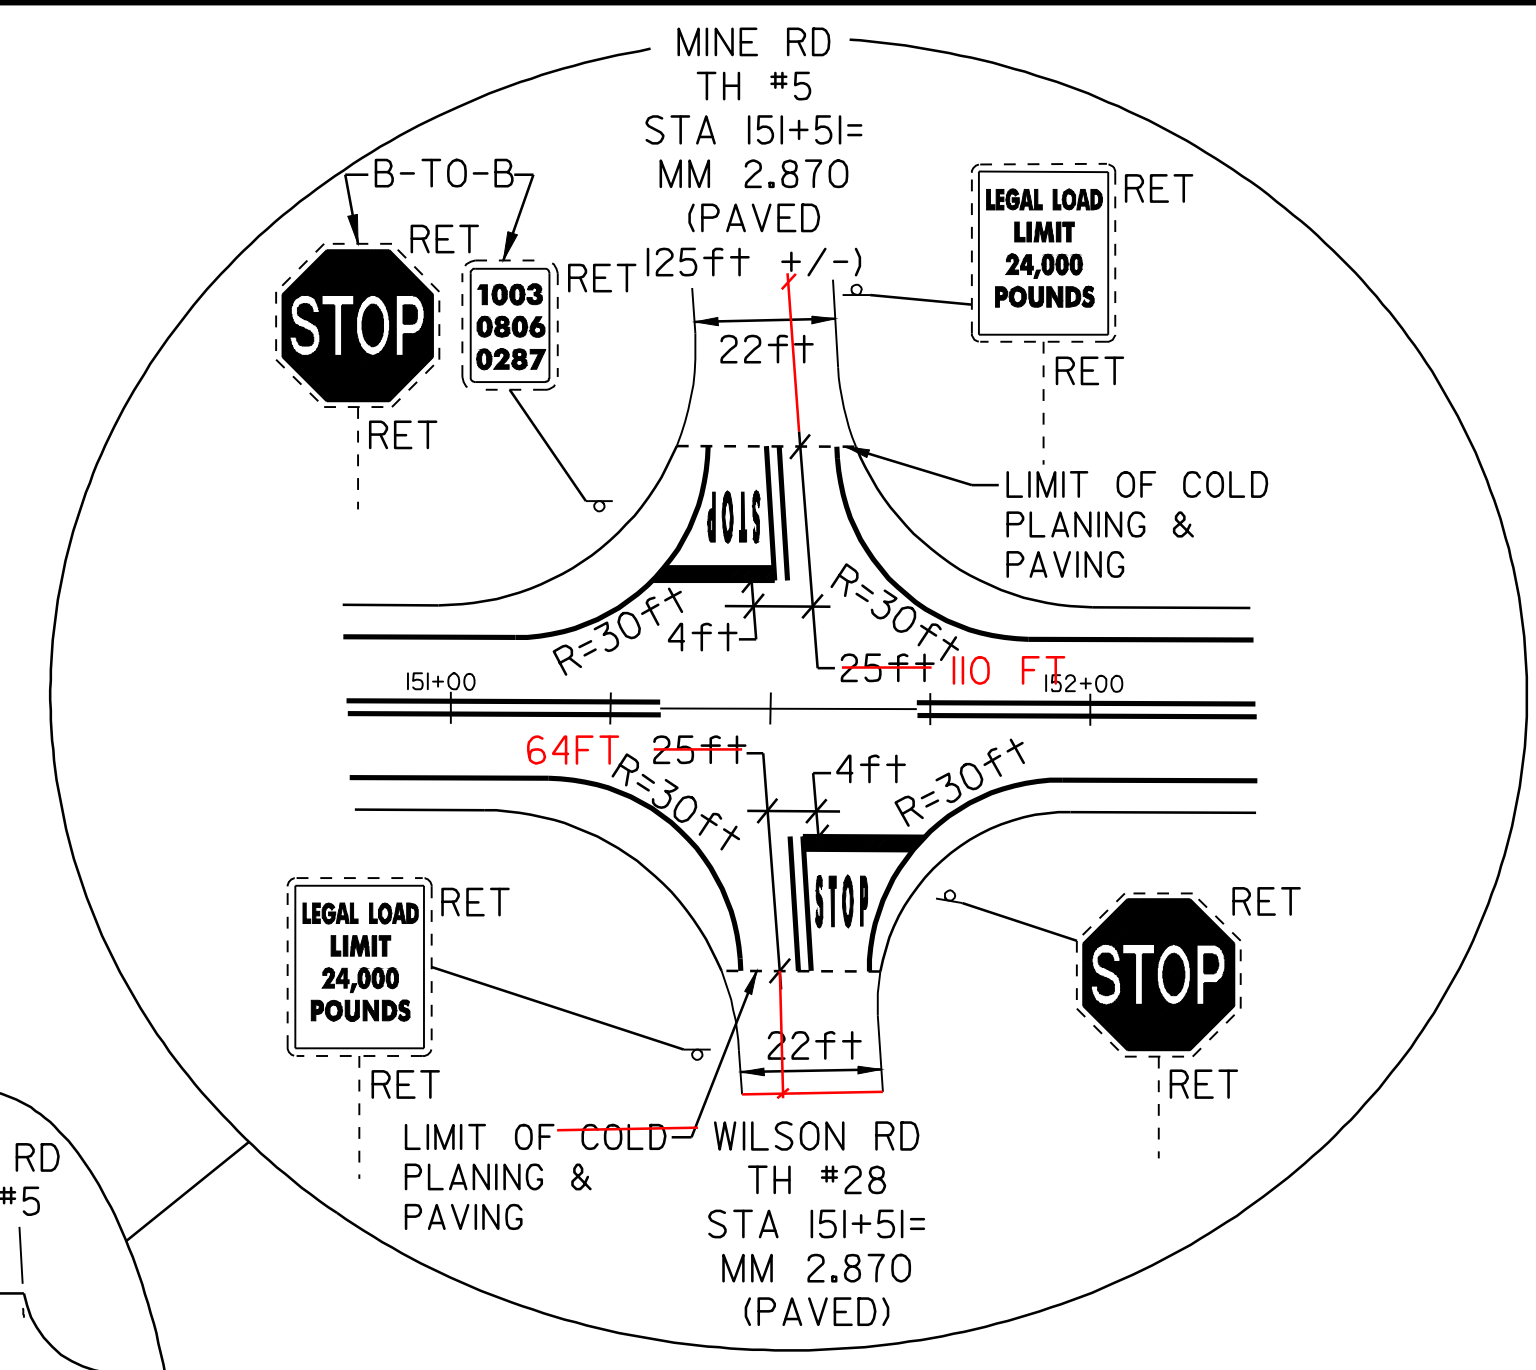

THE BINDER LIFT (TYPE IVS) OF BCP CONTAINS 25% R.A.P.T. MATERIAL AT STA. 145+00 TO 174+00 LT & RT

CURVE #11  
 PC = 163+20  
 PT = 168+40  
 R = 7,700ft  
 SEE SHEET 22 FOR SUPERELEVATION DIAGRAM

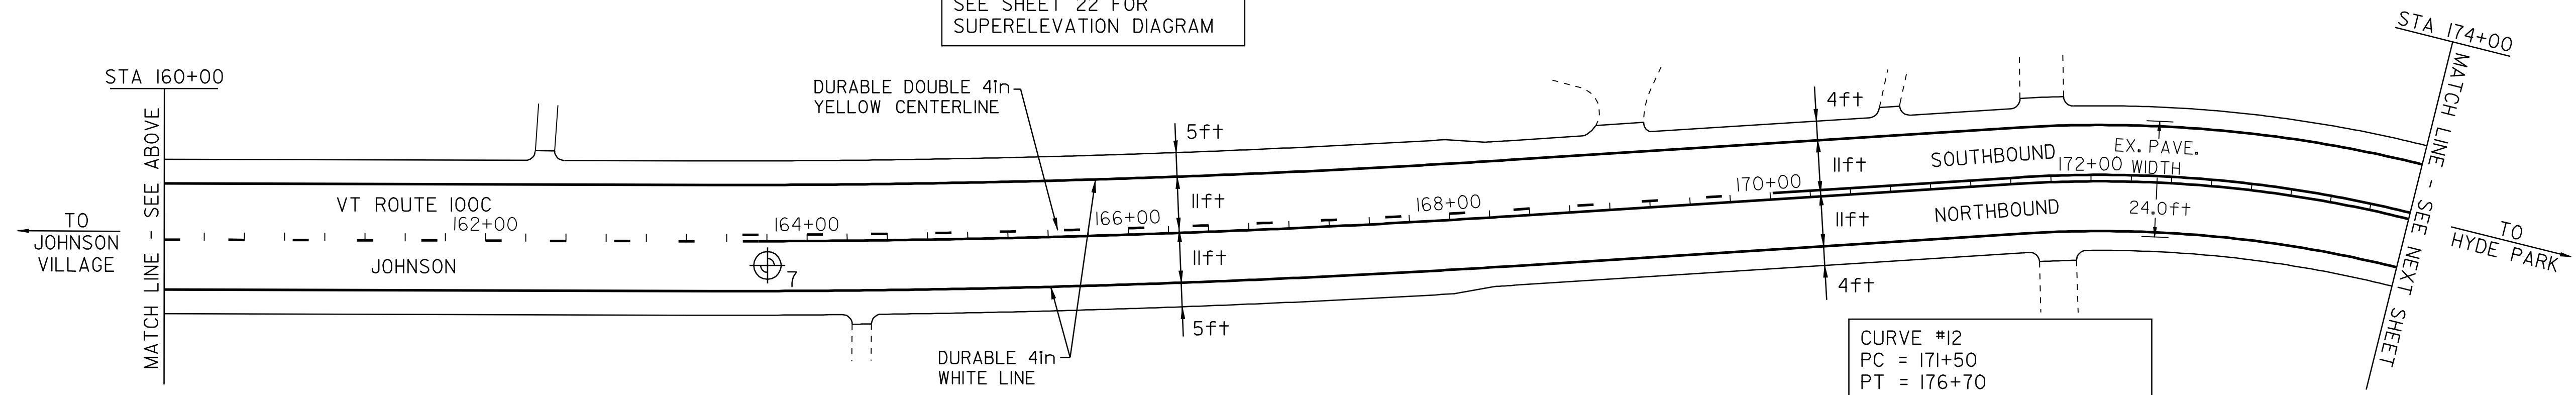

CURVE #12  
 PC = 171+50  
 PT = 176+70  
 R = 800ft  
 SEE SHEET 22 FOR SUPERELEVATION DIAGRAM

PAVEMENT CORES -

#	TOTAL DEPTH (in)	DRAINABLE BASE	SOLID CORE	COMMENTS
14	5.0	NO	NO	--
7	5.25	NO	YES	--

NOTE:  
 - NO PCC UNDER ANY CORES  
 - NO CORES OVER ASPHALTED  
 - NO SHOULDER CORES  
 - NO STRIPPED CORES

## PAVING PROJECT LAYOUT SHEET #7

DESIGNED BY BCE/PJM DATE 7-07  
 DRAWN BY C.E.A., INC. DATE 7-07  
 DESIGN FILE NO. p99c182.dgn  
 PRF FILE p99c182p107.i DATE PLOTTED 08-JAN-2009  
 PROJ. NAME **JOHNSON - HYDE PARK**  
 PROJ. NO. **STP 2215(1)S**  
 SHEET **16** OF **33** SHEETS