


JOHNSON - BRIDGE #1
STA 51+34 = MM 0.972

NOTE:
 FIELD VERIFY ALL RADII.

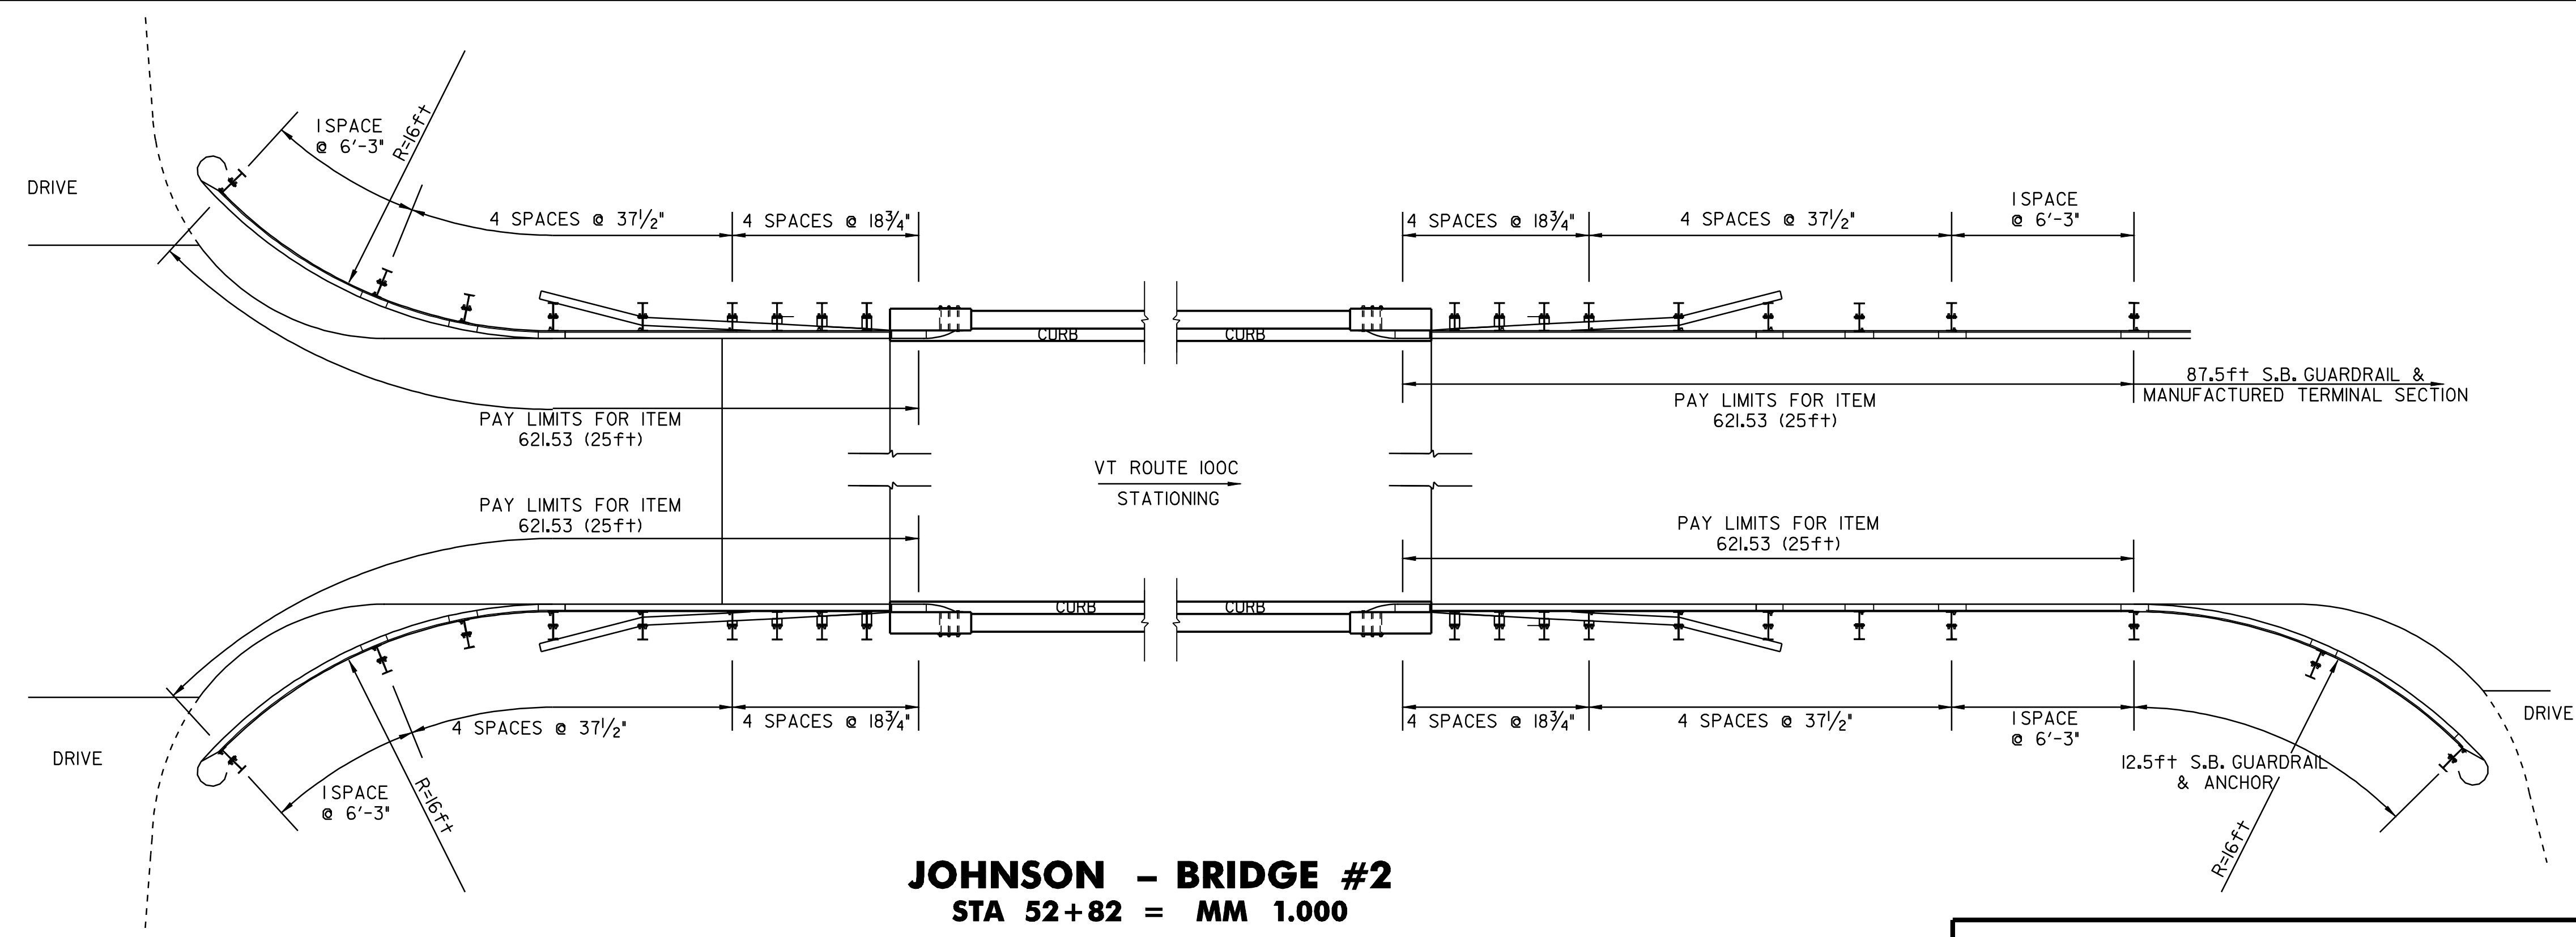

JOHNSON - BRIDGE #2
STA 52+82 = MM 1.000

BRIDGE DETAIL SHEET #1		DESIGNED BY	BCE/PJM	DATE	6-07
		DRAWN BY	C.E.A., INC.	DATE	6-07
		DESIGN FILE NO.	p99c182.dgn		
PRF FILE	p99c182bdl1	DATE PLOTTED	08-JAN-2009	08	
		PROJ. NAME	JOHNSON - HYDE PARK		
		PROJ. NO.	STP 2215(1)S		
		SHEET	29	OF	33 SHEETS