


INDEX OF SHEETS

1	TITLE SHEET
2-4	PROJECT TYPICAL SHEETS
5-6	QUANTITY SHEETS
7-8	ITEM DETAIL SUMMARY SHEETS
9	DITCH CLEANING DETAIL SHEET
10-19	PAVING PROJECT LAYOUT SHEETS
20-25	SUPERELEVATION BANKING DIAGRAM SHEETS
26-27	TRAFFIC SIGN SUMMARY SHEETS
28	TERMINAL CONNECTOR FOR STEEL BEAM GUARD RAIL W/STEEL POSTS
29-30	BRIDGE DETAIL SHEETS
31-32	GUARD RAIL APPROACH SECTION DETAIL SHEETS
33	CONSTRUCTION APPROACH SIGNING AND BURIED END TERMINAL DETAIL SHEET

VAOT STANDARDS

B-1	BANKING TABLES	06-01-94
D-3	TREATED GUTTERS	06-01-94
D-8	REINFORCED CONCRETE DROP INLET WITH PRECAST COVER & GRATE (BOTTOM SECTION) SEE SHEETS D-9,10,11 FOR TOP SECTION	01-03-00
D-15	PRECAST REINFORCED CONC. MH-GRATES (BICYCLE SAFE) CAST IRON GRATE WITH FRAME, TYPE D CAST IRON GRATE WITH FRAME, TYPE E	06-01-94
E-100	CONSTRUCTION APPROACH SIGNS	01-02-04
E-101	CONSTRUCTION SIGN DETAILS	05-30-03
E-102	CONSTRUCTION SIGN DETAILS	06-30-03
E-102A	CONSTRUCTION SIGN DETAILS	05-01-04
E-103	MAINLINE TRAFFIC CONTROL DIVIDED HIGHWAY ONE LANE CLOSED	03-01-04
E-106	TRAFFIC CONTROL - MISCELLANEOUS DETAILS	03-01-04
E-107	DELINEATION, BARRICADES AND DETOURS FOR CONSTRUCTION AREAS	06-30-03
E-107A	BREAKAWAY BARRICADE DETAILS	08-08-95
E-110	MAJOR MAINTAINANCE OPERATION LANE CLOSURE	08-08-95
E-111	MINOR MAINTAINANCE OPERATIONS	03-11-97
E-119	UTILITY WORK ZONE	03-01-04
E-120	STANDARD SIGN PLACEMENT - FREEWAY/EXPRESSWAY	08-08-95
E-121	STANDARD SIGN PLACEMENT - CONVENTIONAL ROAD	08-08-95
E-138	MARKER DETAILS - STATE AND TOWN HIGHWAYS	05-30-03
E-141	REGULATORY SIGN DETAILS	09-20-95
E-143	REGULATORY SIGN DETAILS	06-15-04
E-160	FLANGED CHANNEL STEEL SIGN POST	05-20-99
E-191	PAVEMENT MARKING DETAILS	02-01-99
E-192	PAVEMENT MARKING DETAILS	10-12-00
E-193	PAVEMENT MARKING DETAILS	08-18-95
G-1	STEEL BEAM GUARDRAIL (50MPH & OVER) HEAVY DUTY STEEL BEAM GUARDRAIL TWISTED END TERMINAL ANCHOR FOR STEEL BEAM RAIL	01-03-00
G-1D	STEEL BEAM GUARDRAIL (40MPH & LESS) HEAVY DUTY STEEL BEAM GUARDRAIL STEEL BEAM MEDIAN BARRIER ANCHOR FOR STEEL BEAM RAIL	01-03-00
G-4	MARKERS - GUIDE POSTS - PLANK GUARD RAIL PLANK RAIL GUIDE POSTS WOOD MARKER POSTS STEEL MARKER POSTS	06-01-94
G-19	GENERIC GRADING PLAN FOR GUARDRAIL END TERMINALS	11-15-02
SB-R6-82	BRIDGE RAIL - HEAVY DUTY STEEL BEAM	01-06-95

STATE OF VERMONT AGENCY OF TRANSPORTATION


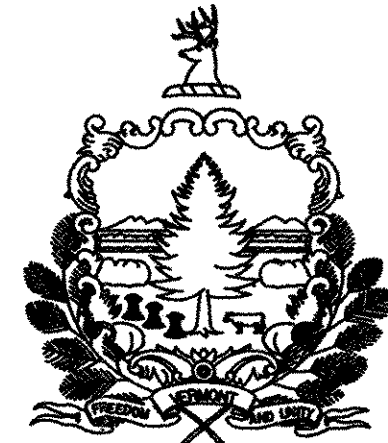


PROPOSED IMPROVEMENTS TOWNS OF JOHNSON AND HYDE PARK COUNTY OF LAMOILLE VT ROUTE 100C

BEGINNING IN THE TOWN OF JOHNSON AT STA 0+00 (MM 0.000) AND EXTENDING NORTHERLY ALONG VT ROUTE 100C THROUGH THE TOWN OF JOHNSON AND INTO THE TOWN OF HYDE PARK FOR A DISTANCE OF APPROXIMATELY 24,261 FEET (4.595 MILES) TO THE END OF VT ROUTE 100C AT THE INTERSECTION WITH VT ROUTE 100, STA 4+59, MM 0.087.

STATION TO STATION DATA	LENGTH (FEET)	(MILES)
TOWN OF JOHNSON STA 0+00 TO STA 238+02 (MM 0.000 TO MM 4.508)	23,802	4.508
TOWN OF HYDE PARK STA 0+00 TO STA 4+59 (MM 0.000 TO MM 0.087)	459	0.087
PROJECT TOTALS	24,261	4.595

WORK TO BE PERFORMED UNDER THIS PROJECT INCLUDES COLD PLANING AND RECLAIMING SECTIONS AND RESURFACING OF THE EXISTING HIGHWAY WITH A COMBINATION OF LEVELING AND WEARING COURSES, NEW PAVEMENT MARKINGS, GUARD RAIL INSTALLATION, DRAINAGE IMPROVEMENTS AND INCIDENTAL ITEMS.

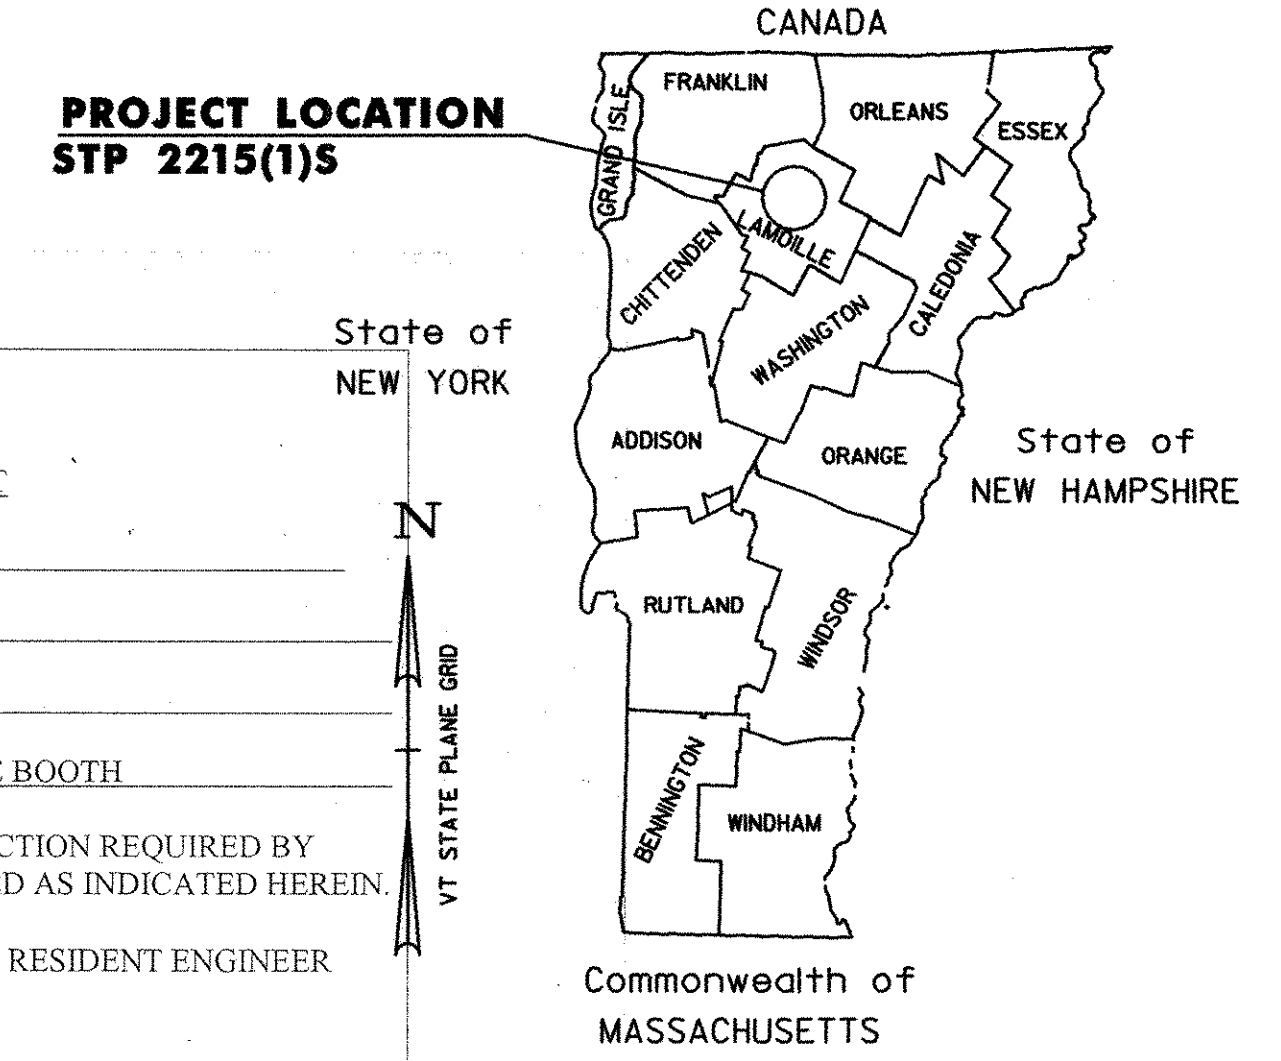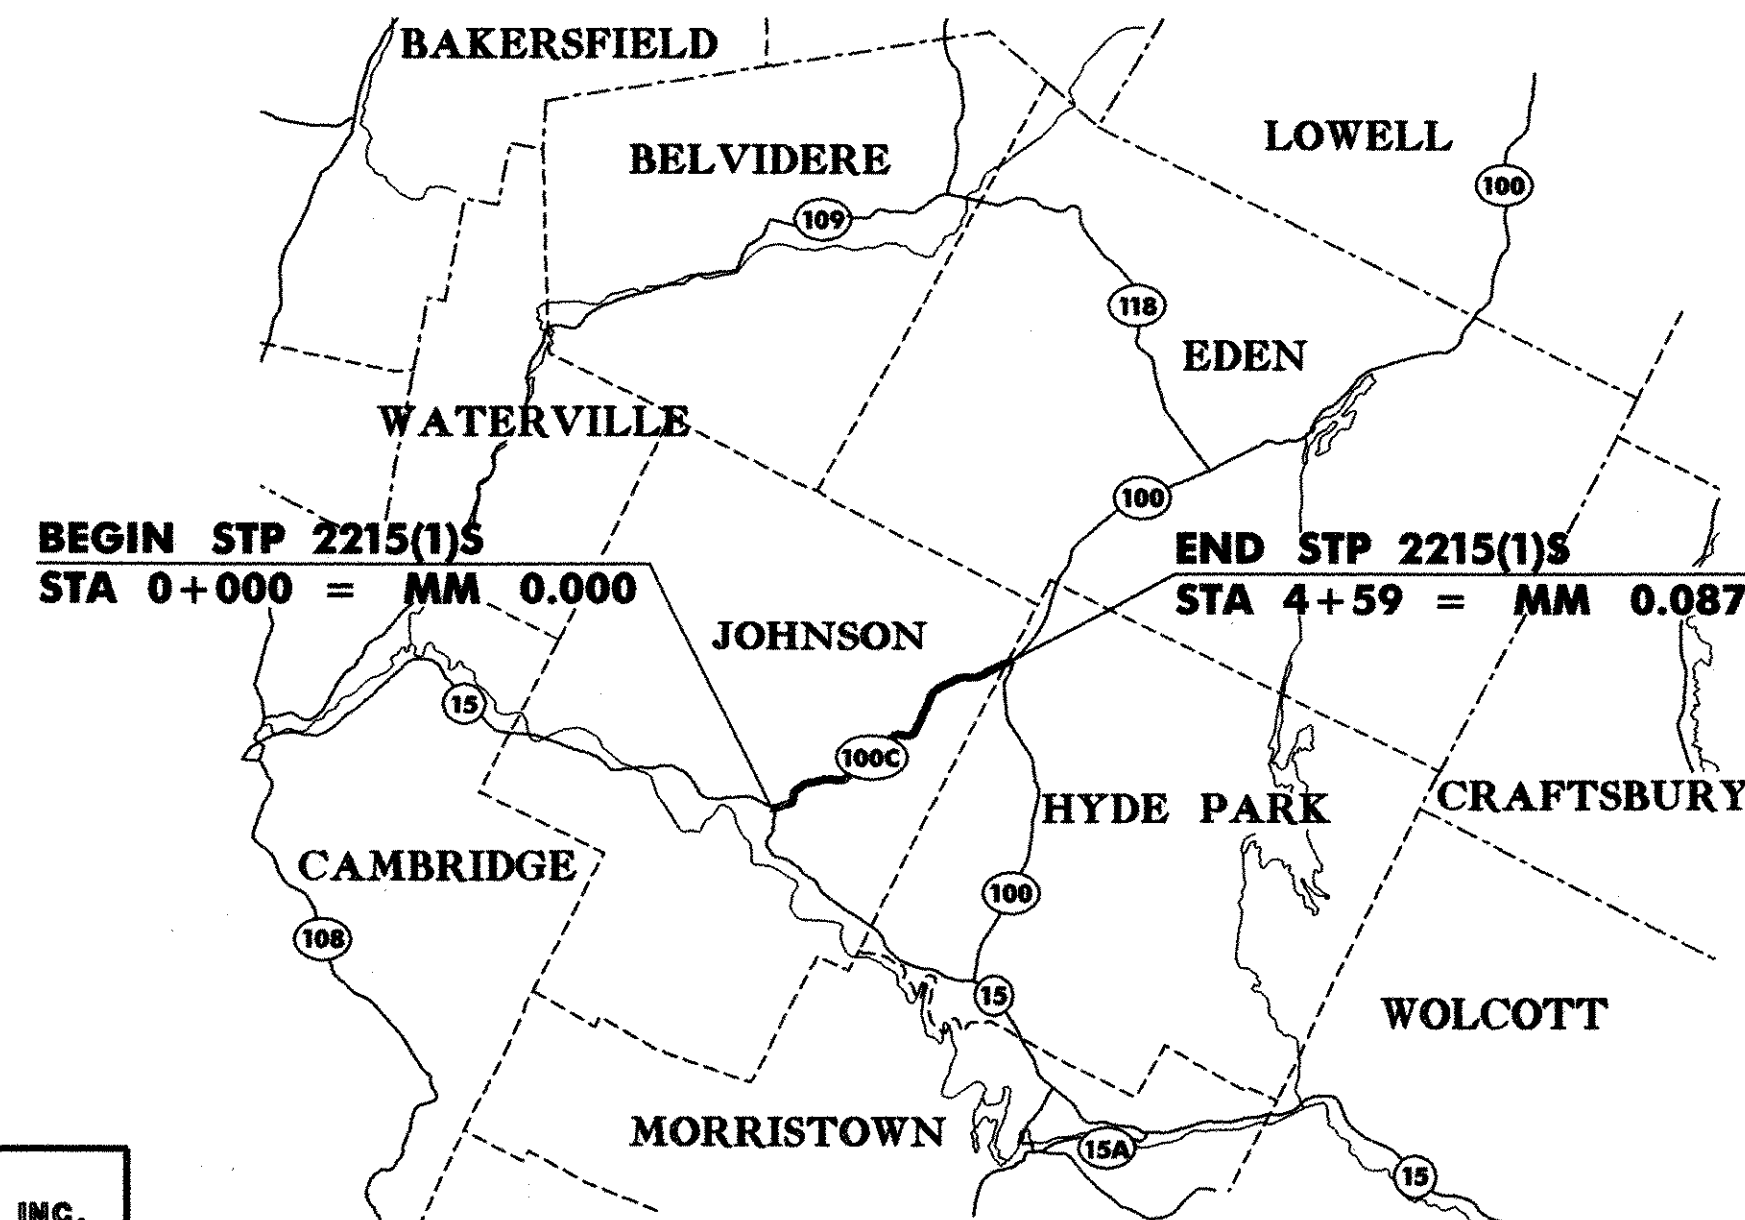

RECORD PLANS

CONTRACTOR: PIKE INDUSTRIES BERLIN, VT
 RESIDENT ENGINEER: JON P. DAY
 CONSTRUCTION BEGAN: _____
 CONSTRUCTION COMPLETE: _____
 RECORD PLANS BY: JON P. DAY & MIKE BOOTH

I HEREBY CERTIFY THAT ALL THE CONSTRUCTION REQUIRED BY THIS SET OF DRAWINGS HAS BEEN ACCOMPLISHED AS INDICATED HEREIN.

BY Jonathan Day RESIDENT ENGINEER
 DATE 12/31/08

NOTE: Any further information concerning final quantities, amounts or other details relative to this project may be found at Central Files in the electronic archives.

TRAFFIC DATA

SECTION	ADT		DHV		FLEXIBLE ESAL'S	
	2008	2018	2008	2018	(2008-2018)	(2008-2028)
BEGIN PROJECT TO SINCLAIR ROAD	4,200	5,100	470	570	1,300,000	3,510,000
SINCLAIR ROAD TO END PROJECT	3,000	3,600	340	410	962,000	2,293,000

JOHNSON - HYDE PARK VT ROUTE 100C, MM 0.000 TO MM 0.087	
BITUMINOUS CONCRETE PAVEMENT SUPERPAVE MIXTURE DESIGN CRITERIA	
DESIGN LANE/DESIGN LIFE ESAL	1,755,000
DESIGN NUMBER OF GYRATIONS	75
PERFORMANCE GRADED ASPHALT BINDER	PG 58-34


CONVENTIONAL SYMBOLS

COUNTY LINE	---
TOWN LINE	---
LIMITS OF ACCESS	○-○-○-○
POINT OF ACCESS	X
FENCE LINE	-x-x-
STONE WALL	○-○-○-○
TRAVELED WAY	○-○-○-○
GUARD RAIL	○-○-○-○
RAILROAD	
SURVEY LINE	---
CULVERT	—x—x—
POWER POLE	⊙
TELEPHONE POLE	⊙
TREES	⊙ *
CONTROL OF ACCESS	///
PROPERTY LINE	---
R.O.W. TAKING LINE	SR
SLOPE RIGHTS	○-○-○-○
TOP OF CUT	△
TOE OF SLOPE	○

DATUM	
VERTICAL	N/A
HORIZONTAL	N/A

BY:

CIVIL ENGINEERING ASSOCIATES, INC.
 P.O. BOX 488 SHELBURNE, VT 05402
 802-985-2323 FAX: 802-985-2271 web: cea-vt.com

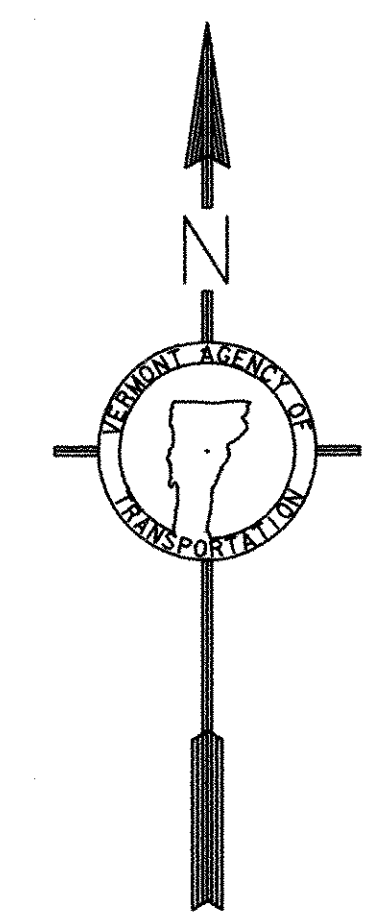

RIGHT-OF-WAY LIMITS, IF APPLICABLE, ARE PROVIDED SOLELY FOR THE CONVENIENCE OF THE STATE AND ITS CONTRACTOR DURING THE COURSE OF THIS PAVING PROJECT. ANY REFERENCES TO OFFSETS ON THESE PLANS ARE APPROXIMATE AND SHOULD NOT BE RELIED UPON FOR ANY OTHER PURPOSES.

UNLESS OTHERWISE NOTED, ALL DRAWINGS AND DETAILS ON THESE PLANS ARE DRAWN 'NOT TO SCALE'.


THESE PLANS ARE SUBJECT TO SUCH ENGINEERING CHANGES AS MAY BE REQUIRED BY THE FEDERAL HIGHWAY ADMINISTRATION OR THE DIRECTOR OF PROGRAM DEVELOPMENT.

CONSTRUCTION IS TO BE CARRIED ON IN ACCORDANCE WITH THESE PLANS AND THE STANDARD SPECIFICATIONS FOR CONSTRUCTION DATED 2006, AS APPROVED BY THE FEDERAL HIGHWAY ADMINISTRATION ON JUNE 15, 2006 FOR USE ON THIS PROJECT, INCLUDING ALL SUBSEQUENT REVISIONS AND SUCH REVISED SPECIFICATIONS AND SPECIAL PROVISIONS AS ARE INCORPORATED IN THESE PLANS.

DIRECTOR OF PROGRAM DEVELOPMENT
APPROVED DATE <u>11/13/07</u>
PROJECT MANAGER : TED DOMEY
PROJECT NAME : JOHNSON - HYDE PARK
PROJECT NUMBER : STP 2215(1)S
SHEET 1 OF 33 SHEETS


NOTES

- THE PAVEMENT WEARING COURSE SHALL BE TYPE IVS. ALL ASPHALT CEMENT USED IN THE BITUMINOUS CONCRETE PAVEMENT SHALL BE PG 58-34.
- EMULSIFIED ASPHALT, TYPE RS-1, SHALL BE APPLIED ON EXISTING PAVEMENT SURFACES, (NOT INCLUDING RECLAIMING SURFACES) BETWEEN ALL COURSES OF PAVEMENT AND ON COLD PLANED SURFACES AT THE RATE OF 0.025 GAL/SY OR AS DIRECTED BY THE RESIDENT ENGINEER. EMULSIFIED ASPHALT, TYPE RS-1, SHALL BE APPLIED TO THE FINE GRADED RECLAIMED SURFACE FOR THE PURPOSE OF DUST CONTROL AT A RATE OF 0.10 TO 0.15 GAL/SY. QUANTITIES OF EMULSIFIED ASPHALT TO BE USED FOR DUST CONTROL HAVE BEEN ESTIMATED AT 0.125 GAL/SY. PAYMENT WILL BE UNDER ITEM EMULSIFIED ASPHALT.
- SUPERPAVE BITUMINOUS CONCRETE PAVEMENT TOLERANCE = +/- 1/4in (TOTAL THICKNESS EXCLUDING LEVELING).
- PRIOR TO RECLAIMING, EXISTING SHOULDER MATERIAL DEEMED UNSUITABLE BY THE RESIDENT ENGINEER WILL BE EXCAVATED TO A DEPTH OF 3 in +/- OR AS DIRECTED BY THE RESIDENT ENGINEER. EXCAVATED MATERIAL WILL BE SPREAD ON THE ADJACENT SLOPES OR REMOVED FROM THE PROJECT, AS DIRECTED BY THE RESIDENT ENGINEER. THIS WORK WILL BE PAID FOR USING THE APPROPRIATE RENTAL ITEMS SUCH AS ALL PURPOSE EXCAVATOR RENTAL, TYPE I, POWER GRADER RENTAL, LOADER RENTAL, TYPE I, TRUCK RENTAL, AND POWER BROOM RENTAL, TYPE I. THE METHOD OF REMOVAL AND THE USE OF RENTAL ITEMS SHALL BE APPROVED BY THE RESIDENT ENGINEER PRIOR TO ANY WORK BEING DONE. MATERIAL REMOVED SHALL BE REPLACED WITH SUBBASE OF CRUSHED GRAVEL, FINE GRADED.
- THREE FEET OF BACKING IS REQUIRED BEHIND THE FACE OF GUARD RAIL WITH 6ft POSTS. IF THIS CANNOT BE OBTAINED THEN 8ft POSTS SHALL BE USED.
- STEEL BEAM GUARD RAIL WITH STEEL POSTS SHALL BE USED ON THIS PROJECT.
- COLD PLANING TO BE COMPLETED ACCORDING TO THE TYPICAL OR AS NOTED OTHERWISE ON THE PLANS. A FULL DEPTH BUTT JOINT SHALL BE CONSTRUCTED AT THE PROJECT BEGIN/END AND AT ALL SIDE ROAD APPROACHES AS DENOTED ON THE PROJECT PLANS OR AS OTHERWISE DIRECTED BY THE RESIDENT ENGINEER. ALL BUTT JOINTS SHALL BE SAW CUT, INCIDENTAL TO ITEM 210.10.
- ITEMS 604.412, 604.42, & 629.20 ARE ESTIMATED QUANTITIES AND SHALL BE PERFORMED AT LOCATIONS INDICATED ON THE LAYOUT SHEETS AND AS DIRECTED BY THE RESIDENT ENGINEER. ALL D.I.'S, MANHOLES, AND WATER VALVES SHALL BE RAISED OR REHABILITATED SUCH THAT THE NEW FINISH GRADE ELEVATION IS LEVEL WITH THE SURROUNDING TERRAIN.
- ALL EDGES OF PAVEMENT SHALL BE BACKED UP FULL HEIGHT WITH AGGREGATE SHOULDERS, RAP AS DIRECTED BY THE RESIDENT ENGINEER AND WILL BE PAID FOR UNDER ITEM 402.13, AGGREGATE SHOULDERS, RAP.
- ALL DRIVES SHALL RECEIVE A PAVED APRON TO THE SIDEWALK, OR AS DIRECTED BY THE RESIDENT ENGINEER. ANY REQUIRED EXCAVATION SHALL BE AS DIRECTED AND WILL BE PAID FOR UNDER CONTRACT ITEM 210.10 OR THE APPLICABLE RENTAL ITEM(S). IF REQUIRED, A NEW SUBBASE SHALL BE CONSTRUCTED AND WILL BE PAID FOR UNDER ITEM 301.28, SUBBASE OF CRUSHED GRAVEL, FINE GRADED. A NEW BITUMINOUS SURFACE SHALL BE CONSTRUCTED AS DIRECTED AND WILL BE PAID FOR UNDER ITEM 490.30. ESTIMATED QUANTITIES OF THE ABOVE ITEMS HAVE BEEN INCLUDED TO PAY FOR THIS WORK.
- ESTIMATED QUANTITIES OF ITEMS 608.25, ALL PURPOSE EXCAVATOR RENTAL, TYPE I, 608.37, TRUCK RENTAL, AND 608.40, LOADER RENTAL, TYPE I HAVE BEEN INCLUDED FOR THE PROVISION OF CONSTRUCTING GUARD RAIL END SECTION FLARES WITH EXCAVATED DITCHING MATERIAL. AN ESTIMATED QUANTITY OF 203.30, EARTH BORROW HAS BEEN INCLUDED IN THE CASE THAT THE DITCHING MATERIAL IS NOT SUITABLE TO USE IN THE GUARD RAIL END SECTION FLARE. 25 CUBIC YARDS OF EARTH BORROW HAS BEEN ESTIMATED FOR EACH NEW GUARD RAIL END SECTION FLARE. GUARD RAIL END SECTION FLARES SHALL BE CAPPED WITH AN ESTIMATED 3' DEPTH OF AGGREGATE SHOULDERS, RAP, UNLESS OTHERWISE DIRECTED BY THE RESIDENT ENGINEER. THE QUANTITIES INCLUDED REFLECT 5 TONS OF ITEM 402.13, AGGREGATE SHOULDERS, RAP, FOR EACH NEW GUARD RAIL END SECTION FLARE. ITEM 653.20, TEMPORARY EROSION MATTING, SHALL BE PLACED ON SLOPES GREATER THAN 1:6 CREATED BY THE GUARD RAIL END SECTION FLARE. THE QUANTITIES INCLUDED REFLECT 25 SY OF ITEM 653.20, TEMPORARY EROSION MATTING FOR EACH NEW GUARD RAIL END SECTION FLARE.
- ITEM 616.47, BITUMINOUS CONCRETE GUTTERS AND TRAFFIC ISLANDS WILL BE PAID ONLY WHERE SPECIFIED IN THE PLANS. ALL OTHER BITUMINOUS CONCRETE PAVEMENT WORK, WHICH COULD INVOLVE SOME HAND-WORK (SUCH AS DRIVE AND SIDEROAD APPROACHES AND AROUND DRAINAGE/UTILITY STRUCTURES), SHALL BE PAID FOR AT THE CONTRACT UNIT PRICE FOR ITEM 490.30, SUPERPAVE BITUMINOUS CONCRETE PAVEMENT.
- COMPACTION, GRADING, AND CLEAN UP OF ITEM 301.28-SUBBASE OF CRUSHED GRAVEL, FINE GRADED, ITEM 402.13-AGGREGATE SHOULDERS, RAP AND ITEM 651.35-TOPSOIL, IS TO BE INCLUDED IN THE CONTRACT PRICE OF EACH ITEM.
- AN ESTIMATED THICKNESS OF 2" OF SPECIAL PROVISION (SUBBASE OF CRUSHED GRAVEL, FINE GRADED FOR RECLAIMING), HAS BEEN INCLUDED FOR THE PROVISION OF IMPROVING GRADATION DEFICIENCIES AND/OR CORRECTING SUPERELEVATION, AS NECESSARY, OR AS DIRECTED BY THE RESIDENT ENGINEER. THIS MATERIAL SHALL BE RECLAIMED INTO THE RECLAIMED STABILIZED BASE. PAYMENT FOR THIS SECOND RECLAIMING OPERATION WILL BE INCIDENTAL TO ITEM 900.680 SPECIAL PROVISION (SUBBASE OF CRUSHED GRAVEL, FINE GRADED FOR RECLAIMING).
- STABILIZING AGENT FOR RECLAIMED STABILIZED BASE WILL BE WATER. PAYMENT SHALL BE INCIDENTAL TO ITEM 310.20.
- AN ESTIMATED QUANTITY OF ITEM 619.17, YIELDING MARKER POSTS HAS BEEN INCLUDED TO DELINEATE CULVERT ENDS AND DROP INLETS LOCATED OUTSIDE OF THE PAVEMENT SURFACE OR AS DIRECTED BY THE RESIDENT ENGINEER.

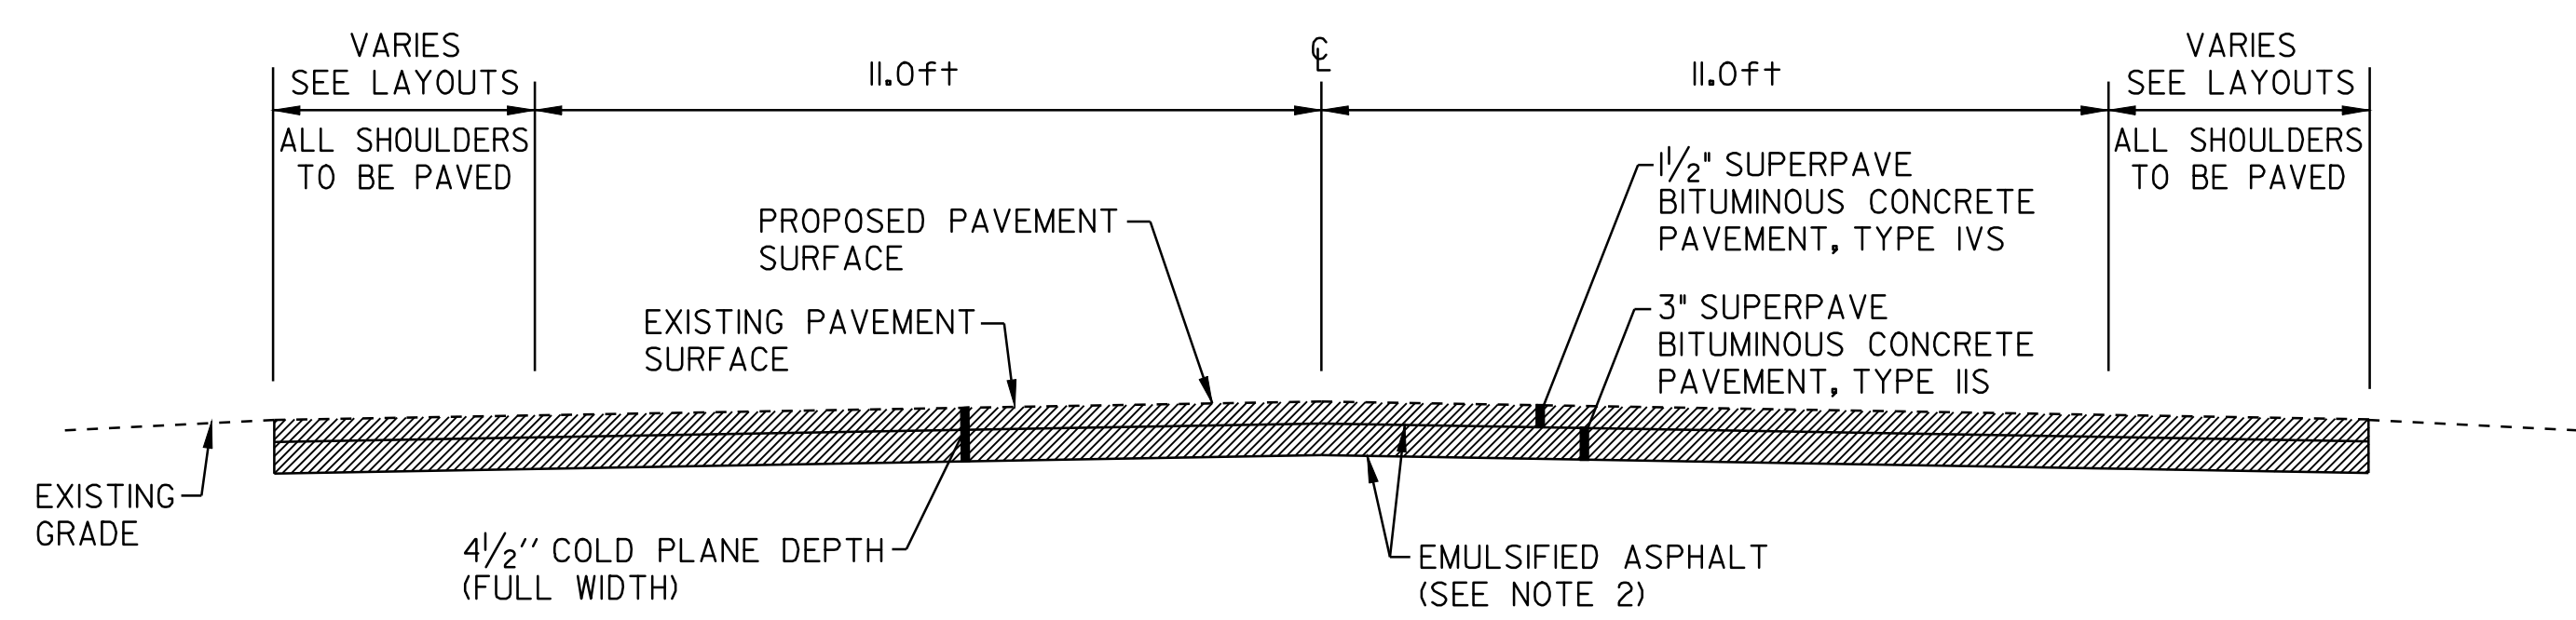

COLD PLANED TYPICAL SECTION

**JOHNSON
0+00 TO 54+90**

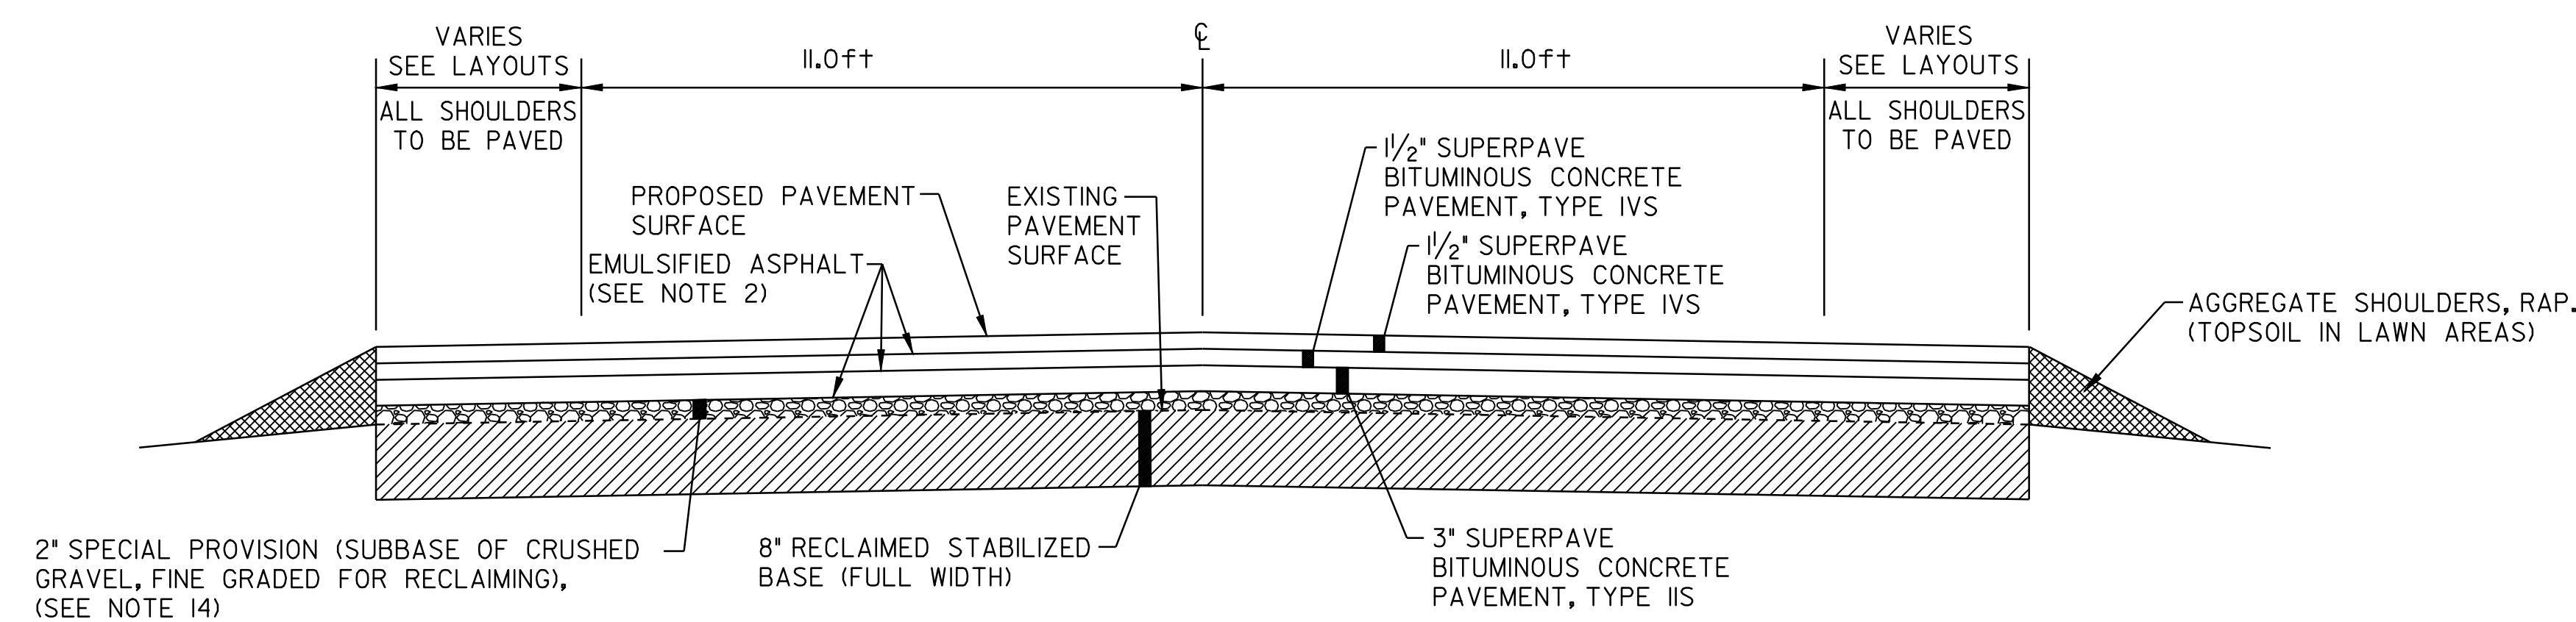

RECLAIM TYPICAL SECTION


**JOHNSON
54+90 TO 238+02
HYDE PARK
STA 0+00 TO 4+59**

PROJECT PAVING LIMITS


TOWN & ROUTE	BEGIN STATION	END STATION	LANE TYPICAL	WEARING DEPTH	LEVELING Tons	NOTES
JOHNSON - VT ROUTE 100C	0+00	54+90	VARIABLE -11.0FT-11.0FT- VARIABLE	1 1/2 in	--	COLD PLANE 4 1/2", PAVE w/ 3" TYPE IIS AND 1 1/2" TYPE IVS.
	54+90	238+02	VARIABLE -11.0FT-11.0FT- VARIABLE	1 1/2 in	--	RECLAIM 8", MIX 2" SPECIAL PROVISION (SUBBASE OF CRUSHED GRAVEL, FINE GRADED FOR RECLAIMING), IN RECLAIM AREA, PAVE w/ 3" TYPE IIS, & 2 - LIFTS 1 1/2" TYPE IVS.
HYDE PARK - VT ROUTE 100C	0+00	4+59	VARIABLE -11.0FT-11.0FT- VARIABLE	1 1/2 in	--	RECLAIM 8", MIX 2" SPECIAL PROVISION (SUBBASE OF CRUSHED GRAVEL, FINE GRADED FOR RECLAIMING), IN RECLAIM AREA, PAVE w/ 3" TYPE IIS, & 2 - LIFTS 1 1/2" TYPE IVS.

**PROJECT
TYPICAL
SHEET #1**


DESIGNED BY	BCE/PJM	DATE	6-07
DRAWN BY	C.E.A., INC.	DATE	6-07
DESIGN FILE NO.	p99c182.dgn		
PRF FILE	p99c182+typ1.i	DATE PLOTTED	08-JAN-2009
PROJ. NAME	JOHNSON - HYDE PARK		
PROJ. NO.	STP 2215(1)S		
SHEET	2	OF	33 SHEETS

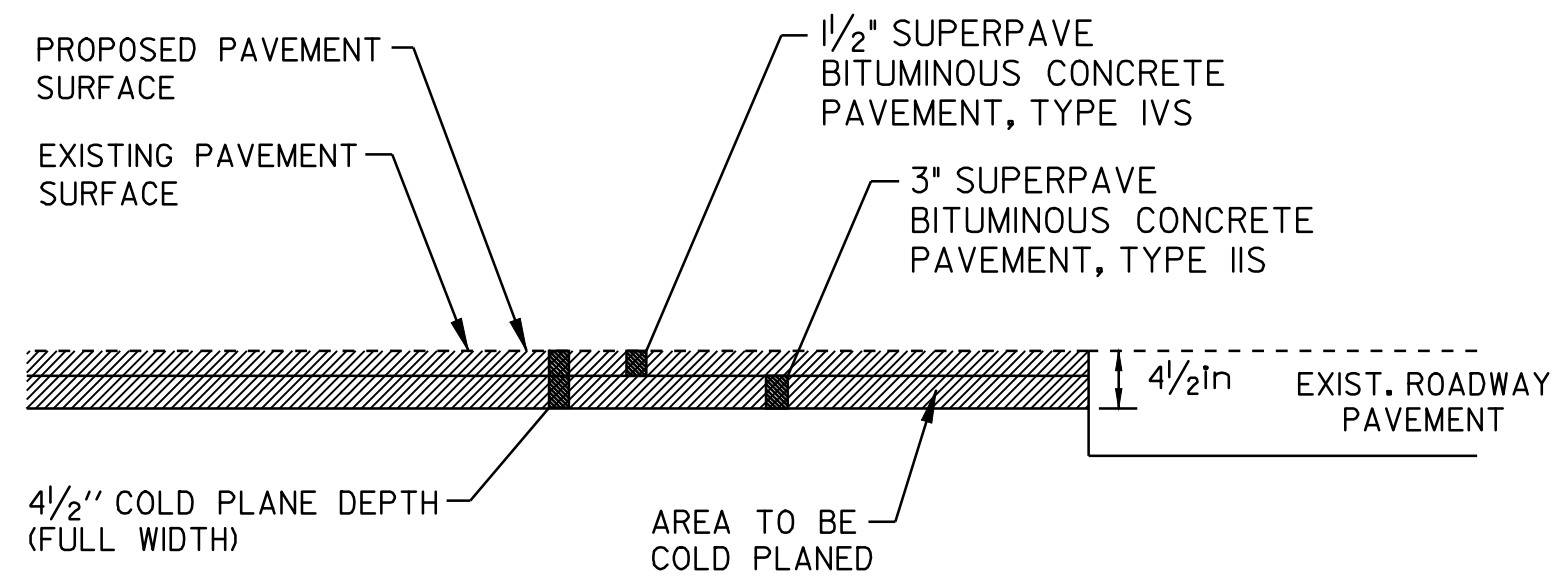


- APPROACH AREA DETAIL -
JOHNSON
STA 0+35 (BEGIN PROJECT)

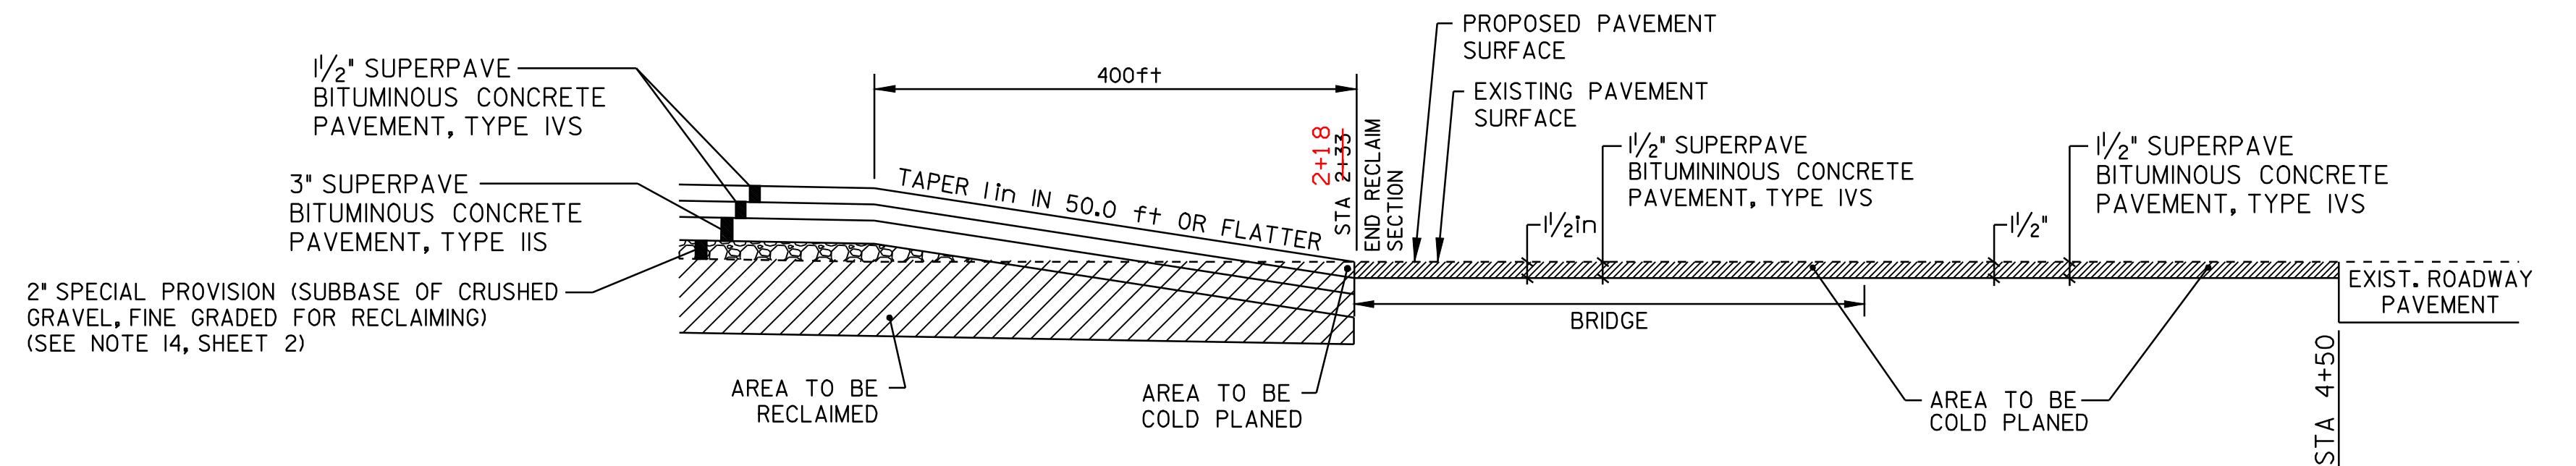

- TRANSITION AREA DETAIL -
HYDE PARK
BRIDGE #6 TO END OF PROJECT

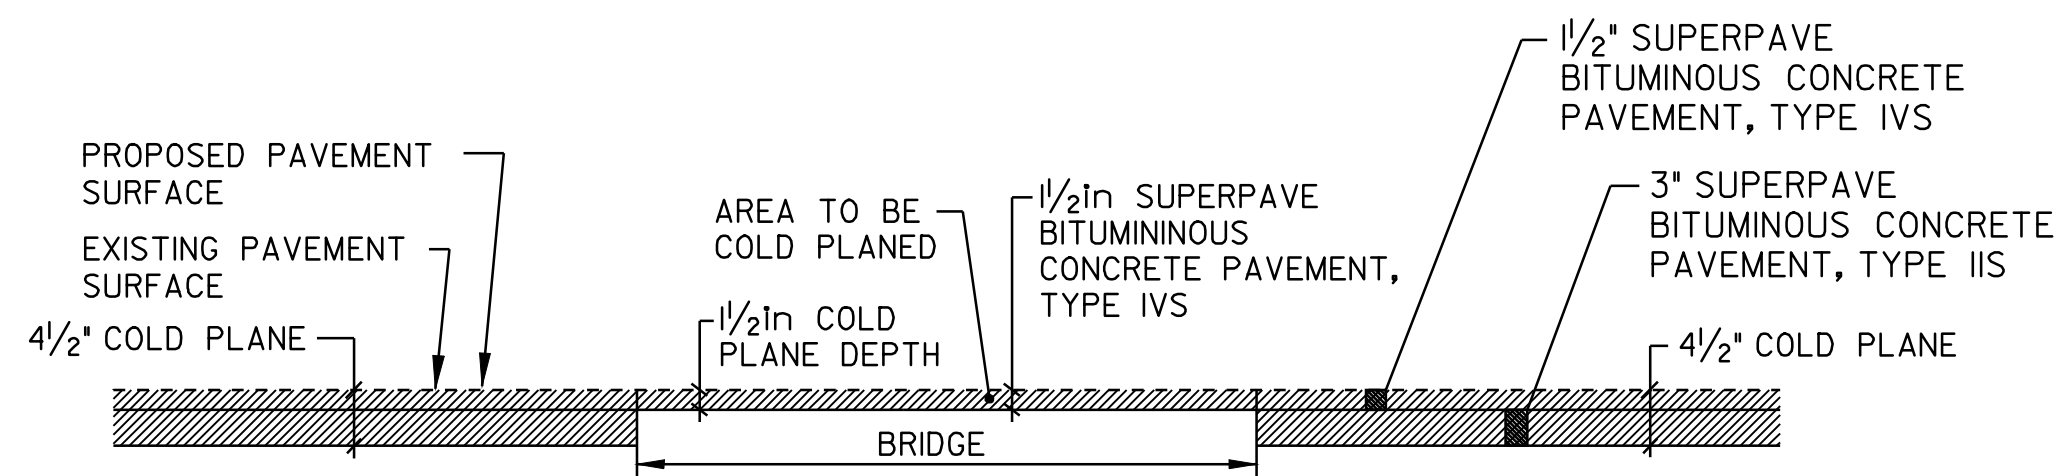

- COLD PLANING DETAIL @ BRIDGES -
JOHNSON
BRIDGE #1 - STA 51+34
BRIDGE #2 - STA 52+82

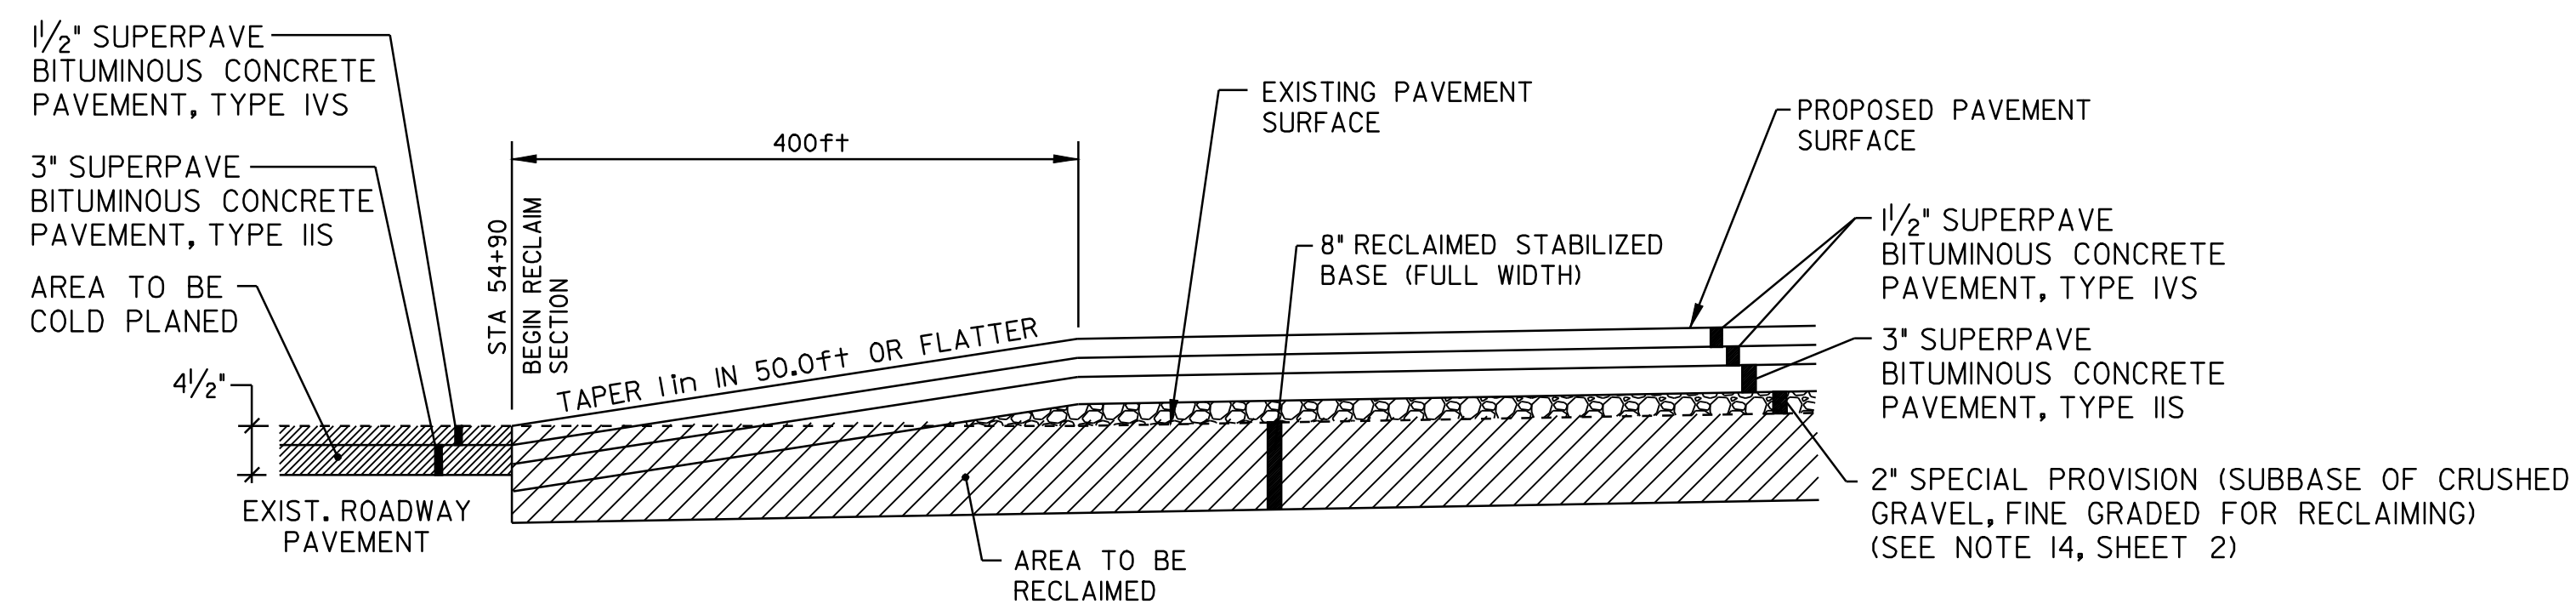

-TRANSITION AREA DETAIL-
JOHNSON
STA 54+90
(END COLD PLANING/BEGIN RECLAIMING)

CONSERVATION SEED MIX
 RURAL AREA - SEED MIXTURE

% WT.	lbs./ACRE	NAME	PUR%	GERM%
37.5	22.5	CREeping RED FESCUE	98	85
37.5	22.5	TALL FESCUE	95	90
5.0	3	RED TOP	95	90
15.0	9	BIRDSFOOT TREFOIL	98	85
5.0	3	ANNUAL RYEGRASS	95	85
100.0	60			

SEED MIXTURE:
 SHALL NOT HAVE A WEED CONTENT EXCEEDING 0.40% BY WEIGHT AND SHALL BE FREE OF ALL NOXIOUS SEED.

SEED:
 TO BE APPLIED PER SEEDING FORMULAS OR AS DIRECTED BY THE ENGINEER.


FERTILIZER:
 FORMULA 10-20-10, TO BE USED WITH SEED, APPLIED AT THE RATE OF 500 lbs/ACRE. (HYDRO SEEDERS MAY USE 19-19-19 FORMULA)

AGRICULTURAL LIMESTONE:
 TO BE APPLIED AT THE RATE OF 2.0 TONS/ACRE, OR AS DIRECTED BY THE ENGINEER.

HAY MULCH:
 TO BE PLACED ON EARTH SLOPES AT THE RATE OF 2.0 TONS/ACRE, OR AS DIRECTED BY THE ENGINEER.

TOPSOIL:
 TO BE USED AS INDICATED ON THE PLANS, OR AS DIRECTED BY THE RESIDENT ENGINEER.

PROJECT TYPICAL SHEET #2	DESIGNED BY	BCE/PJM	DATE	6-07
	DRAWN BY	C.E.A., INC.	DATE	6-07
	DESIGN FILE NO.	p99cl82.dgn		
	PRF FILE	p99cl82+yp2.i	DATE PLOTTED	08-JAN-2009
	PROJ. NAME	JOHNSON - HYDE PARK		
PROJ. NO.	STP 2215(1)S			
SHEET	3	OF	33	SHEETS

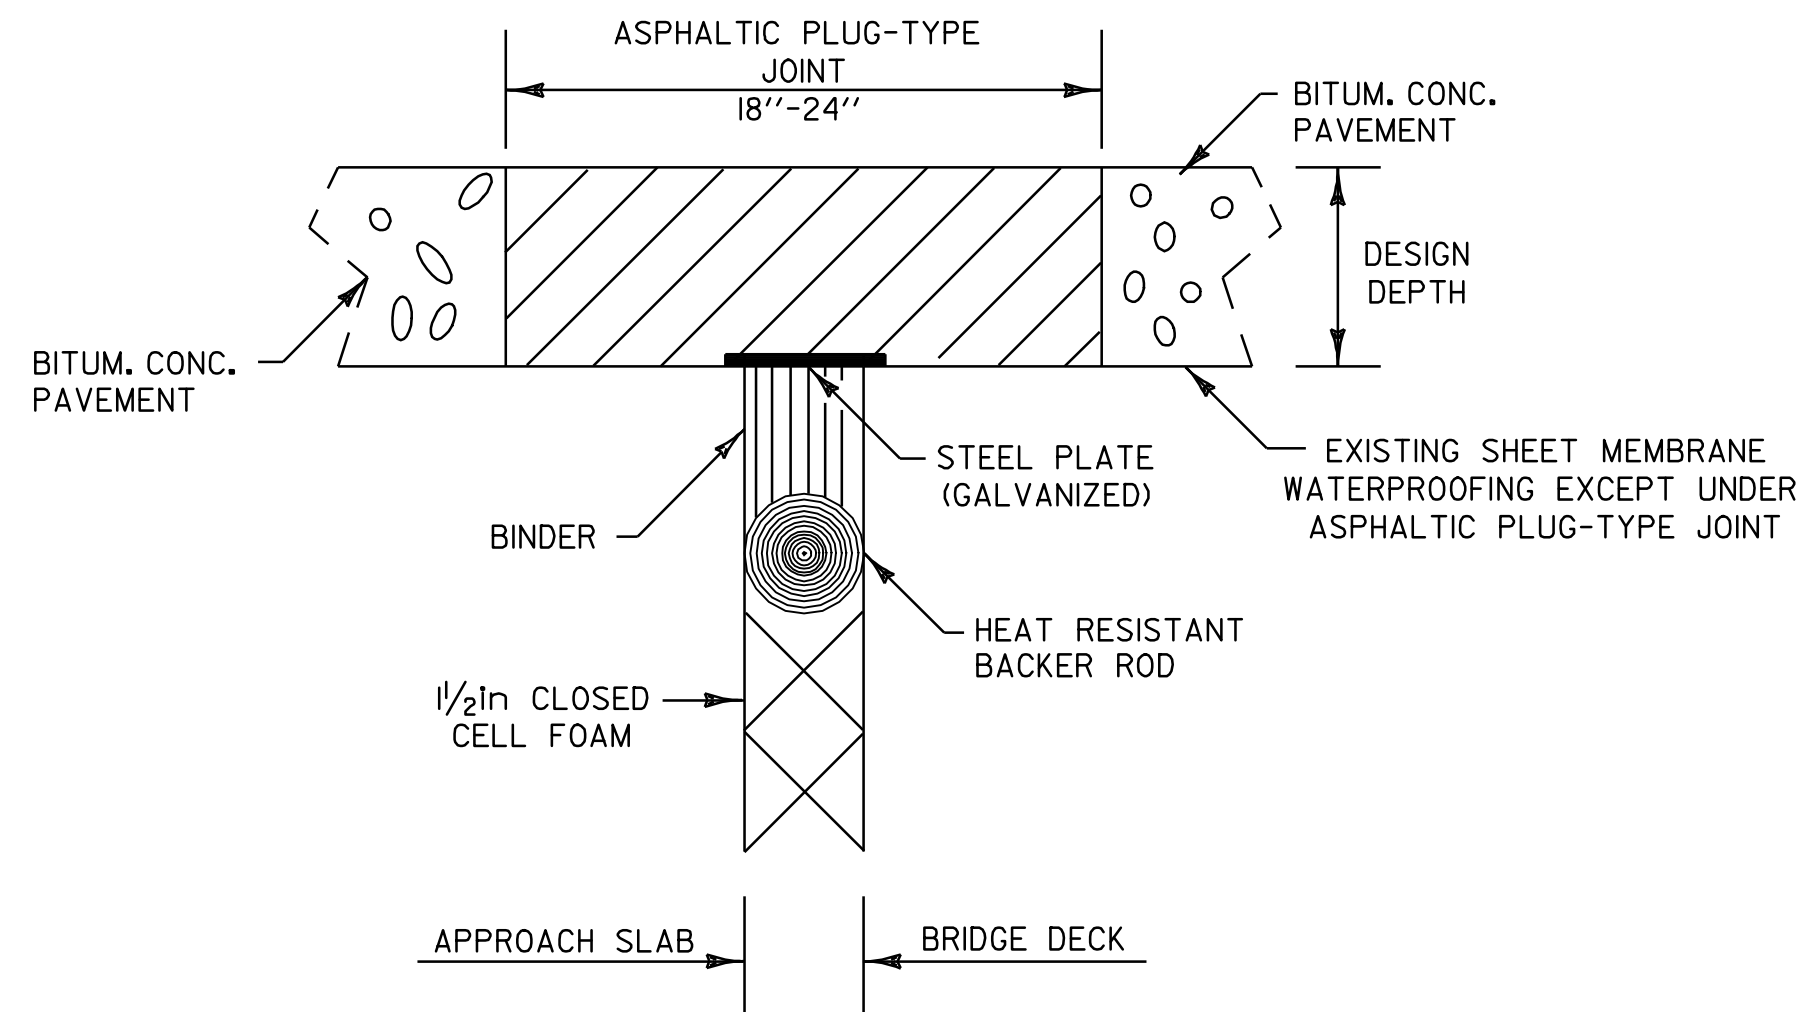

- ASPHALTIC PLUG TYPE JOINT DETAIL -

LOCATION

HYDE PARK

BRIDGE #6 (32ft) - STA 2+35
BRIDGE #6 (32ft) - STA 3+30


**- ASPHALTIC PLUG BRIDGE JOINT -
GENERAL NOTES**

INSTALLATION:

1. THE JOINT SHALL BE LOCATED CENTRALLY OVER THE DECK EXPANSION GAP OR FIXED JOINT MARKED OUT TO THE MANUFACTURERS RECOMMENDED WIDTH.
2. THE JOINT SHALL BE EXCAVATED AS SHOWN ON THE PLANS BY USE OF SAWS AND PNEUMATIC HAMMER OR A HAMMER AND CHISEL.
3. THE JOINT SHALL BE BLAST CLEANED OF DEBRIS AND ASPHALT. THE JOINT AREA SHALL BE THOROUGHLY DRIED USING HOT COMPRESSED AIR PRIOR TO APPLYING BINDER MATERIAL.
4. SPALLED AND DEFECTIVE CONCRETE SHALL BE REPAIRED WITH AN APPROVED MATERIAL AS AGREED UPON BY THE RESIDENT ENGINEER.
5. PROPERLY SIZED HEAT RESISTANT BACKER ROD SHALL BE PLACED IN THE MOVEMENT GAP ALLOWING FOR 1 INCH +/- OF BINDER ABOVE THE ROD.
6. THE BINDER MATERIAL SHALL BE HEATED AND PLACED AS RECOMMENDED BY THE MANUFACTURER.
7. PLACE 1/4 INCH THICK BY 8 INCH WIDE SECTIONS OF STEEL PLATE OVER THE CENTER OF THE MOVEMENT GAP. SECURE PLATES FROM MOVING BY INSERTING LOCATING PINS THROUGH THE PRESTAMPED HOLES INTO THE BACKER ROD AND COVER WITH HOT BINDER.
 - a. THE STEEL PLATES MAY BE OMITTED WHERE THE APPROACH SLAB IS COVERED WITH A STONE BASE OR BITUMINOUS PAVEMENT, AND VERTICAL MOVEMENT OF THE PLATES MIGHT OCCUR.
8. THE BINDER MATERIAL AND AGGREGATE SHALL BE HEATED AND MIXED AS RECOMMENDED BY THE MANUFACTURER.
9. THE INSTALLATION OF MATERIAL, COMPACTION AND TOPCOATING SHALL BE AS RECOMMENDED BY THE MANUFACTURER.
10. IMMEDIATELY AFTER TOPCOATING, AN ANTI-SKID MATERIAL SHALL BE CAST OVER THE JOINT TO REDUCE THE RISK OF TRACKING.
11. JOINT SHALL BE PROTECTED FROM TRAFFIC UNTIL THE MATERIAL HAS COOLED TO 125 DEGREES F +/-.

WEATHER LIMITATIONS:


- I. BINDER MATERIAL SHALL BE APPLIED ONLY WHEN THE FOLLOWING CONDITIONS PREVAIL:
 - a. THE AMBIENT AIR TEMPERATURE IS AT LEAST 50 DEGREES F AND RISING.
 - b. THE ROAD SURFACE IS SUFFICIENTLY DRY.
 - c. WEATHER CONDITIONS OR OTHER CONDITIONS ARE FAVORABLE AND ARE EXPECTED TO REMAIN SO FOR THE PERFORMANCE OF THE SATISFACTORY WORK.

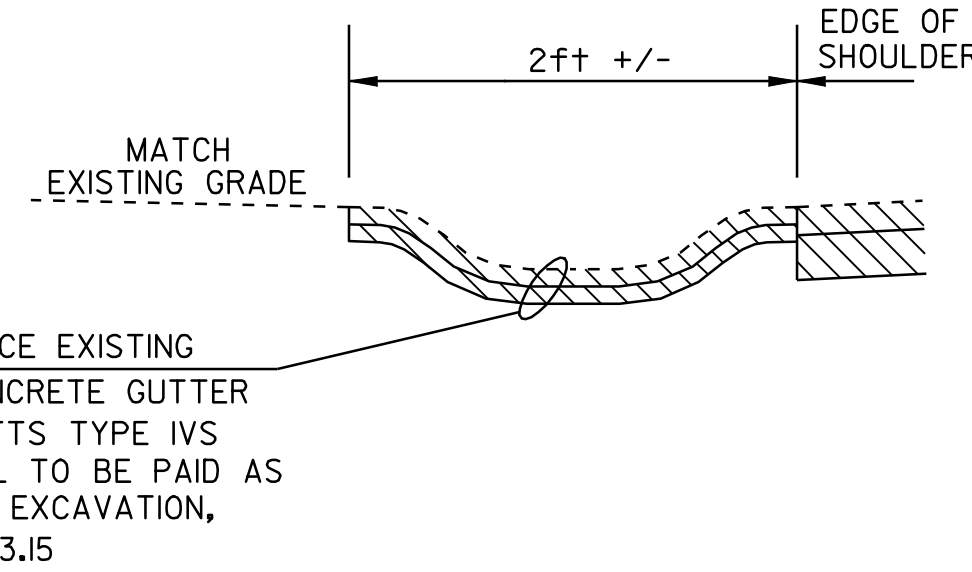


**BITUMINOUS CONCRETE
GUTTER DETAIL**

JOHNSON

10+25
STA 4+80 TO 9+40 LT
~~STA 38+40 TO 40+00 LT~~
STA 0+00 TO 2+00 LT
STA 6+65 TO 10+00 RT

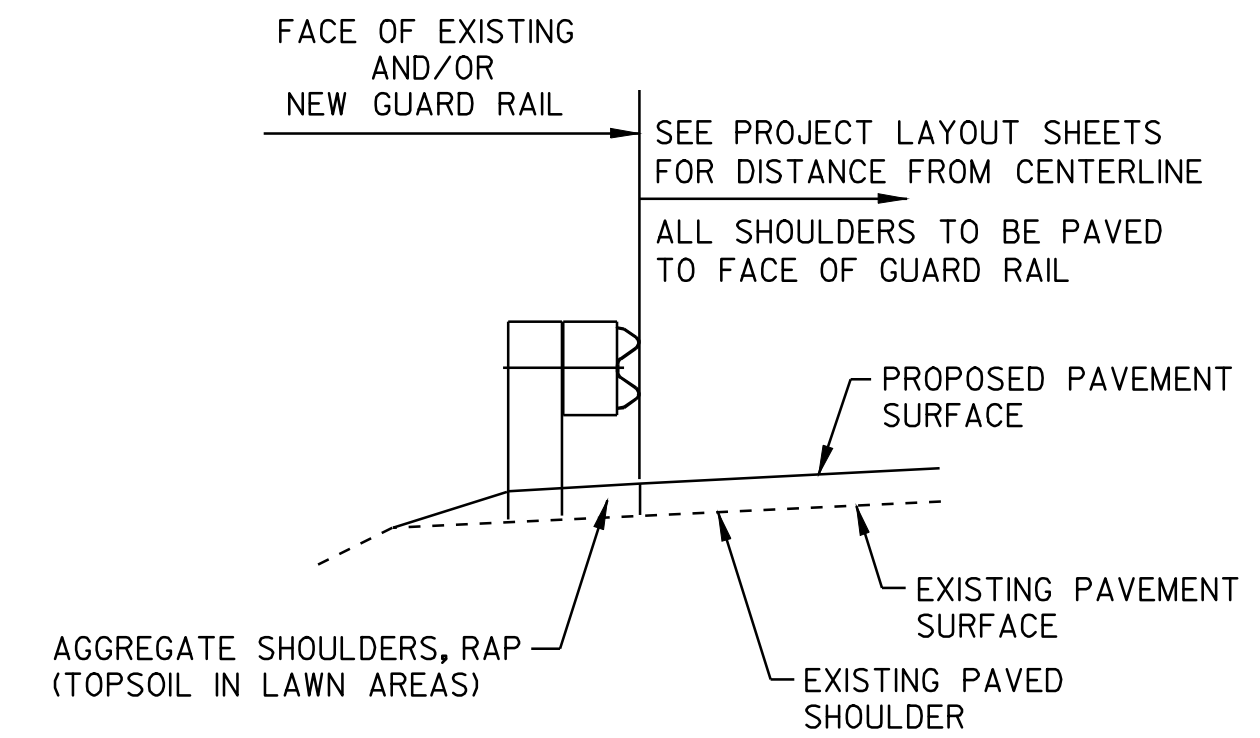


- TYPICAL SECTION AT GUARD RAIL -

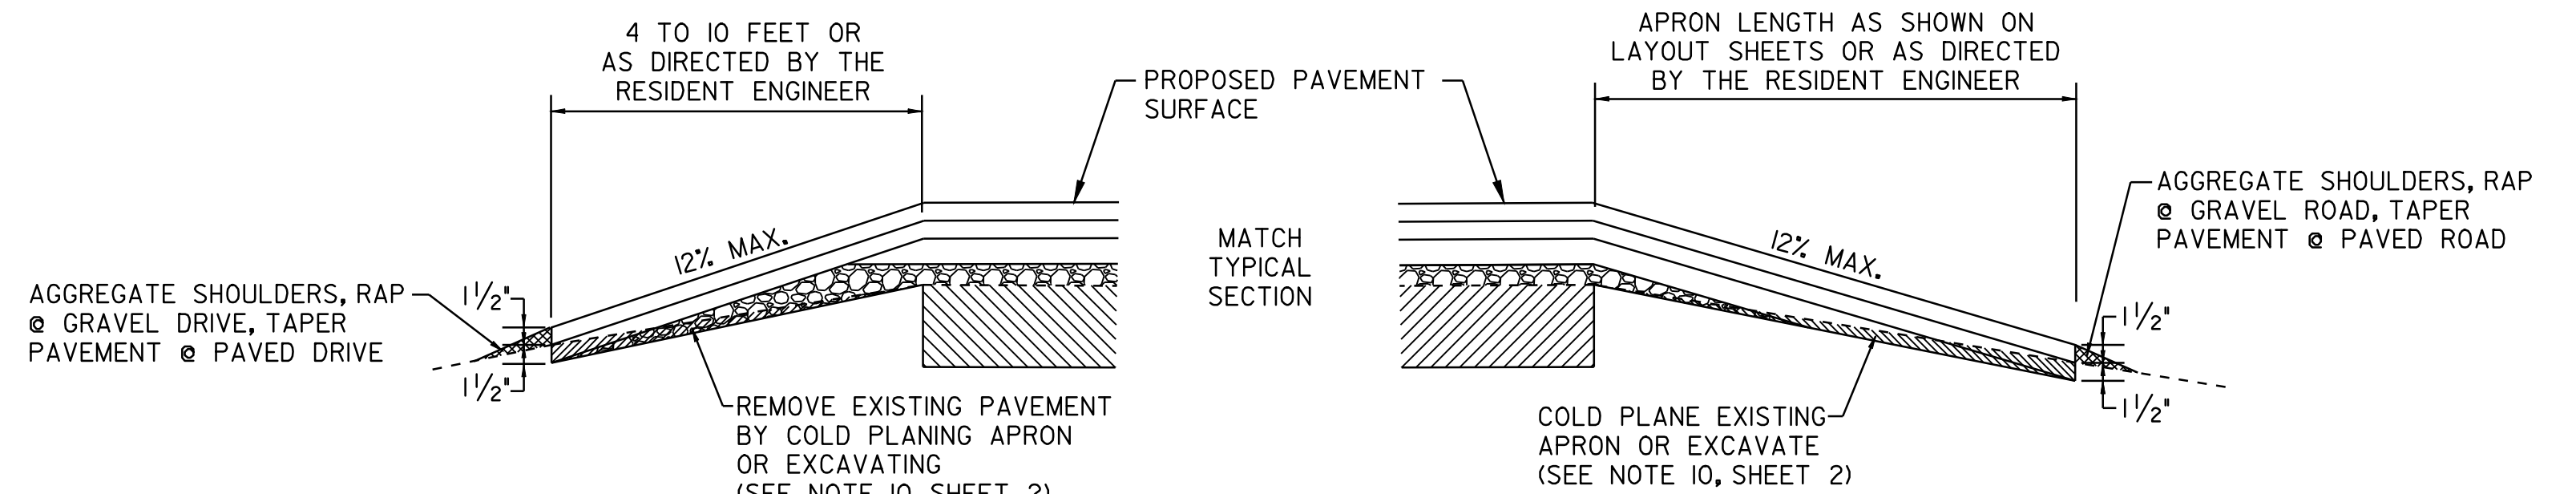

**DRIVEWAY TRANSITION DETAIL
@ RECLAIM AREAS**

**TOWN HIGHWAY TRANSITION DETAIL
@ RECLAIM AREAS**

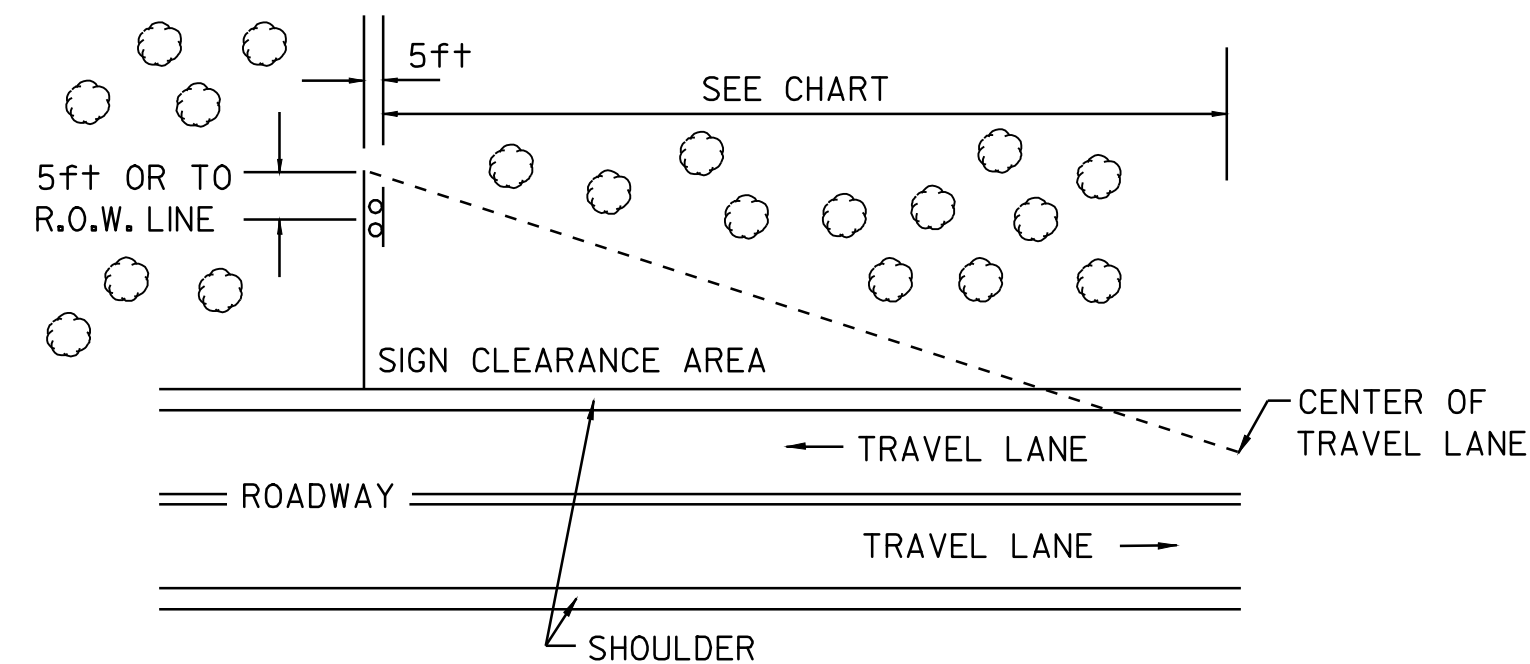

MINIMUM SIGN SIGHT DISTANCE CHART

APPROACH SPEED (mph)	SIGHT DISTANCE (feet)
30 OR LESS	300
35	350
40	400
45	450
50	500
55	550

THE CONTRACTOR SHALL REMOVE ALL WOODY STEMMED GROWTH INCLUDING BRUSH, SAPPLINGS, TREE LIMBS, GROWING WITHIN OR PROJECTING INTO THE CLEARANCE AREA AND DOWN TO GROUND LEVEL OR AT LEAST 10 FEET BELOW THE BOTTOM OF THE SIGN, WHICHEVER IS LESS. PAYMENT WILL BE FOR THINNING AND TRIMMING FOR SIGNS, ITEM 201.31, AND PAID FOR PER EACH. NO CHEMICALS (POISONS, OR DEFOLIANTS) ALLOWED.

CLEARING LIMITS FOR SIGNS ON CONVENTIONAL ROADS

**PROJECT
TYPICAL
SHEET #3**

DESIGNED BY BCE/PJM DATE 6-07
DRAWN BY C.E.A., INC. DATE 6-07
DESIGN FILE NO. p99cl82.dgn
PRF FILE p99cl82+yp3.i DATE PLOTTED 08-JAN-2009
PROJ. NAME JOHNSON - HYDE PARK
PROJ. NO. STP 2215(1)5
SHEET 4 OF 33 SHEETS

ITEM DETAIL SUMMARY SHEET 1

LOCATION			MISCELLANEOUS ITEMS								DRAINAGE ITEMS 613.11					GUARD RAIL ITEMS										REMARKS	
STA	STA	POS.	201.31	203.15	203.30	402.13	616.47	617.10	900.680	604.412	NEW PIPE				613.10	616.35	619.17	621.20	621.205	621.50	621.51	621.53	621.60	621.70	621.80		676.10
			THINNING AND TRIMMING FOR SIGNS	COM. EXCAV.	EARTH BORROW	AGG. SHOULD. RAP.	B. CONC. GUTTER & TRAF. ISLAND	RELOCATE MAILBOX SINGLE SUPPORT	SPECIAL PROVISION (SUBBASE OF CRUSHED GRAVEL FINE GRADED, FOR RECLAIMING)	REHAB. D.I. CLASS I	DIA.	CSP (0.064)	RCP	CPEP	STONE FILL, TYPE X II	TREATED TIMBER CURB	YIELDING MARKER POSTS	STEEL BEAM G.R., GALV.	STEEL BEAM G.R. 8ft POSTS	MANUF. TERMINAL SECTION, FLARED	MANUF. TERMINAL SECTION, TANGENT	TERMINAL CONNECT.	ANCHOR FOR S.B. RAIL	GUARD RAIL APPROACH SECTION TYPE I	REMOVE & DISP. OF GUARD RAIL		DELIN. w/STEEL POSTS
			EA	CY	CY	TON	TON	EA	TON	EA	in	LF	LF	LF	CY	LF	EA	LF	LF	EA	EA	EA	EA	EA	LF	EA	
JOHNSON																											
0+00	238+02	LT&RT				2,720			7,060							10											
0+69		LT							6,116																		
0+70		RT																									
0+00	2+00	LT																									
4+80	9+40	LT	10+25	10			20																				
6+65	10+00	RT																									
6+66		LT																									
6+69		RT																									
10+49														198.6				162.5									
10+50	17+37	LT			50	10								100			529	687-5				2		687.5	2		
	26+75																441.5							425			
22+40	26+90	LT			50	10											450					2		450	2		
38+40	40+00	LT																									
40+31	47+05			2																					675		
40+80	47+17	LT			50	10												637-5					2		637-5	2	
49+10		RT																									
50+80	51+18																	14.5					1				
50+65	51+15	RT			25	5					15			20			12-5					1	2	25	1		
50+92	51+18																										
50+90	51+15	LT			25	5												2				1	1	25	1		
51+50	51+76																										
51+55	51+80	RT			25	5												2				1	1	25	1		
51+50	51+76																										
51+55	51+80	LT			25	5												2				1	1	25	1		
52+33	52+56																										
52+30	52+55	LT			25	5												2				1	1	25	1		
52+33	52+56																										
52+30	52+55	RT			25	5												2				1	1	25	1		
53+07																		114.5									
53+10	54+47	LT			25	5												112-5				1	1	75	1		
53+07	53+45																	14.5									
53+10	53+47	RT			25	5												12-5				1	1	25	1		
60+15	63+67																										
59+97	63+60	LT			50	10												354						25	1		
59+83.5	72+25.5																	362-5				2		362-5	2		
69+90	72+27	LT			50	10												162.5	2					237.5	2		
69+85	72+22																										
69+90	72+27	RT			50	10																					
80+00	86+15																	275	250					512.5			
80+25	85+25	LT			50	10												287-5	125	1	1			500	2		
122+26	125+38																										
122+56	125+44	RT			50	10												212-5	2					287.5	2		
123+50	126+49																										
123+42	126+42	LT			50	10										225								300	2		
174+00	175+37																	100						79			
174+18	175+30	LT			50	10												37-5	2	1			1	100	2		
	175+75																	50						67			
174+50	175+37	RT			50	10												12-5	2					75	2		
182+64	188+53																							490			
182+62	186+00	RT			50	10		1										125	262-5	2				300	2		
184+41																											
184+40	189+65	LT			50	10												75	450	2					375	2	
186+80	188+55	RT			50	10												100							175	2	
198+31	202+20																								315		
198+35	202+22	RT			50	10												125	312-5	2				312	2		
198+78	202+00																								282		
198+70	201+82	LT			50	10																			275	2	
	219+91																	375							623		
212+67	219+92	RT			50	10												650	297.5	2					625	2	

SHEET SUB-TOTALS			12	1,050		2,930	24	1	7,060 6,116		5	15		20 50	100 198.6		10	2,487.5 3003	3,025 2963.5	25 22	1	8 17	11		6,187 6,193.5	42 40
-------------------------	--	--	----	-------	--	-------	----	---	----------------	--	---	----	--	----------	--------------	--	----	-----------------	-----------------	----------	---	---------	----	--	------------------	----------

ITEM DETAIL SUMMARY SHEET #1

DESIGNED BY BCE/PJM DATE 6-07

DRAWN BY C.E.A., INC. DATE 6-07

DESIGN FILE NO. p99cl82.dgn

PRF FILE p99cl821dsl.i DATE PLOTTED 08-JAN-2009 08

PROJ. NAME: **JOHNSON - HYDE PARK**

PROJ. NO.: **STP 2215(1)S**

SHEET **7** OF **33** SHEETS

ITEM DETAIL SUMMARY SHEET 2


LOCATION			MISCELLANEOUS ITEMS								DRAINAGE ITEMS						GUARD RAIL ITEMS										REMARKS
STA	STA	POS.	201.31 THINNING AND TRIMMING FOR SIGNS	203.15 COM. EXCAV.	203.30 EARTH BORROW	402.13 AGG. SHOULD. RAP.	616.47 B. CONC. GUTTER & TRAF. ISLAND	617.10 RELOCATE MAILBOX SINGLE SUPPORT	900.680 SPECIAL PROVISION (SUBBASE OF CRUSHED GRAVEL FINE GRADED, FOR RECLAIMING)	604.412 REHAB. D.I. CLASS I	NEW PIPE				613.10 STONE FILL, TYPE I	616.35 TREATED TIMBER CURB	619.17 YIELDING MARKER POSTS	621.20 STEEL BEAM G.R., GALV.	621.205 STEEL BEAM G.R. 8ft POSTS	621.50 MANUF. TERMINAL SECTION, FLARED	621.51 MANUF. TERMINAL SECTION, TANGENT	621.53 TERMINAL CONNECT.	621.60 ANCHOR FOR S.B. RAIL	621.70 GUARD RAIL APPROACH SECTION TYPE I	621.80 REMOVE & DISP. OF GUARD RAIL	676.10 DELIN. w/STEEL POSTS	
			EA	CY	CY	TON	TON	EA	TON	EA	In	LF	LF	LF	LF	EA	EA	EA	EA	EA	EA	EA	EA	EA	EA	EA	
217+48	220+34																125							237			
217+47	220+35	LT			50	10											212.5	110	2					238	2	REPLACE EXISTING CABLE RAIL.	
223+15	227+27																175							330			
223+10	227+22	RT			50	10											337.5	162.5	2					338	2	REPLACE EXISTING CABLE RAIL.	
237+00		LT									1															REHAB D. I.	
238+00		LT									1															REHAB D. I.	
0+00	PARK 4+59	LT&RT	1			30			100																	ESTIMATED QUANTITIES TO BE USED AS DIRECTED BY THE RESIDENT ENGINEER.	
0+50	2+25	RT			25	5										13	87.5	1				1	175	1		REPLACE EXISTING STEEL BEAM GUARD RAIL, COORDINATE WITH SHEETS 30 & 31.	
1+28	2+42	LT			25	5											25		1			1	112.5	1		REPLACE EXISTING STEEL BEAM GUARD RAIL, COORDINATE WITH SHEETS 30 & 31.	
3+20	4+25	RT			25	5					1					2524	87.5	1				1	175	1		REPLACE EXISTING STEEL BEAM GUARD RAIL, COORDINATE WITH SHEETS 30 & 31.	
3+37	4+50	LT			25	5										95 96	162.5 662.5	1				1	250 1279.5	1		REPLACE EXISTING STEEL BEAM GUARD RAIL, COORDINATE WITH SHEETS 30 & 31.	
SHEET SUB-TOTALS			1	--	200	70	--	--	100		3	--	--	--	120	--	912.5	272.5	8	--	--	--	4	1,288.5	8		
ID#1 SUB-TOTALS			--	12	1,050	2,930	24	1	7,060		5	15			133	10	2,487.5	3,025	2522	1	8	117	6193.5	6,187	42 40		
PROJECT SUB-TOTALS			1	12	1,250	3,000	24	1	7,160		8	15			2050	100	120	10	3,400	3,025	33	1	8	11	4	7,475.5	50
ROUNDING			--	3	--	--	1	--	40		--	--			133	3883	50	25	2763.5	--	--	--	--	24.5	--		
PROJECT TOTALS			1	15	1,250	3,000	25	1	7,200 6,116		8	15			2050	100	120	10	3,450	3,050	33	1	8	117	4	7,500 7473	50 48

ITEM DETAIL SUMMARY SHEET #2


DESIGNED BY BCE/PJM DATE 6-07
 DRAWN BY C.E.A., INC. DATE 6-07
 DESIGN FILE NO. p99cl82.dgn
 PRF FILE p99cl82ids2.l DATE PLOTTED 08-JAN-2009 08
 PROJ. NAME: **JOHNSON - HYDE PARK**
 PROJ. NO.: **STP 2215(1)S**
 SHEET **8** OF **33** SHEETS

LOCATION				FEET OF DITCHING				MISC. ITEMS			REMARKS	LOCATION				FEET OF DITCHING				MISC. ITEMS			REMARKS		
SITE	STATION	STATION	POS.	PERCENT GRADE				653.20	613.10	649.31		SITE	STATION	STATION	POS.	PERCENT GRADE				653.20	613.10	649.31			
				0-1	1-2.5	2.5-10	>10	TEMP. EROS. MATT.	STONE FILL TYP. I	GEOT. UNDER STONE FILL						TEMP. EROS. MATT.	STONE FILL TYP. I	GEOT. UNDER STONE FILL	0-1	1-2.5	2.5-10	>10			
																								0-1	1-2.5
VT ROUTE 100C, JOHNSON DISTRICT #8								SY	CY	SY									SY	CY	SY				
1	12+00	22+50	RT	450	200	400		89	59.5	171															
2	31+75	47+25	RT	1,150		400		235	110.6	287															
3	76+75	87+00	RT	86+84		1,025		957	206.5	530															
4	88+75	106+50	LT		1,675	100		744	15	67															
5	110+50	121+50	LT			1,100			20	617															
6	113+00	116+25	RT			325		106	48	217															
7	119+50	121+25	RT			175			26	117															
8	125+50	127+50	RT			200			30	133															
9	134+50	138+00	RT			350			52	233															
10	139+00	140+00	LT	100				156																	
11	164+50	169+00	RT	450					52.4	164															
12	176+50	179+25	LT			275			41	183															
13	220+40	222+00	LT	160																					
PROJECT SUBTOTALS				2,310	1,875	4,350		833	645	2,900															
ROUNDING				40	25	50		17	30	100															
PROJECT TOTALS				2,350	1,900	4,400		850	675	3,000															
	69+67	72+58				291			70	202															
	61+72	62+51						61.4																	
	63+03	64+00						75.4																	
	72+58	73+24						179.0																	
	86+84	88+60																							
	129+84	137+56						233.9	534																
	172+00	174+63						68.2	153																
	227+59	230+05						310																	
	230+26	231+98																							
	23+10	26+05						32.8	25																
	14+34.5	15+00						16.3	201																
	48+23	48+96						14.9	190																
	49+67	51+17						30.6																	
	51+43	52+67						25.3	26																
	HP 0+50	0+72						8.9																	
	44+09	48+19						500.9	3100.0																
								304																	
								2383.8																	
								say																	
								2384																	

LOCATION				FEET OF DITCHING				MISC. ITEMS			REMARKS	LOCATION				FEET OF DITCHING				MISC. ITEMS			REMARKS		
SITE	STATION	STATION	POS.	PERCENT GRADE				653.20	613.10	649.31		SITE	STATION	STATION	POS.	PERCENT GRADE				653.20	613.10	649.31			
				0-1	1-2.5	2.5-10	>10	TEMP. EROS. MATT.	STONE FILL TYP. I	GEOT. UNDER STONE FILL						TEMP. EROS. MATT.	STONE FILL TYP. I	GEOT. UNDER STONE FILL	0-1	1-2.5	2.5-10	>10			
																								0-1	1-2.5

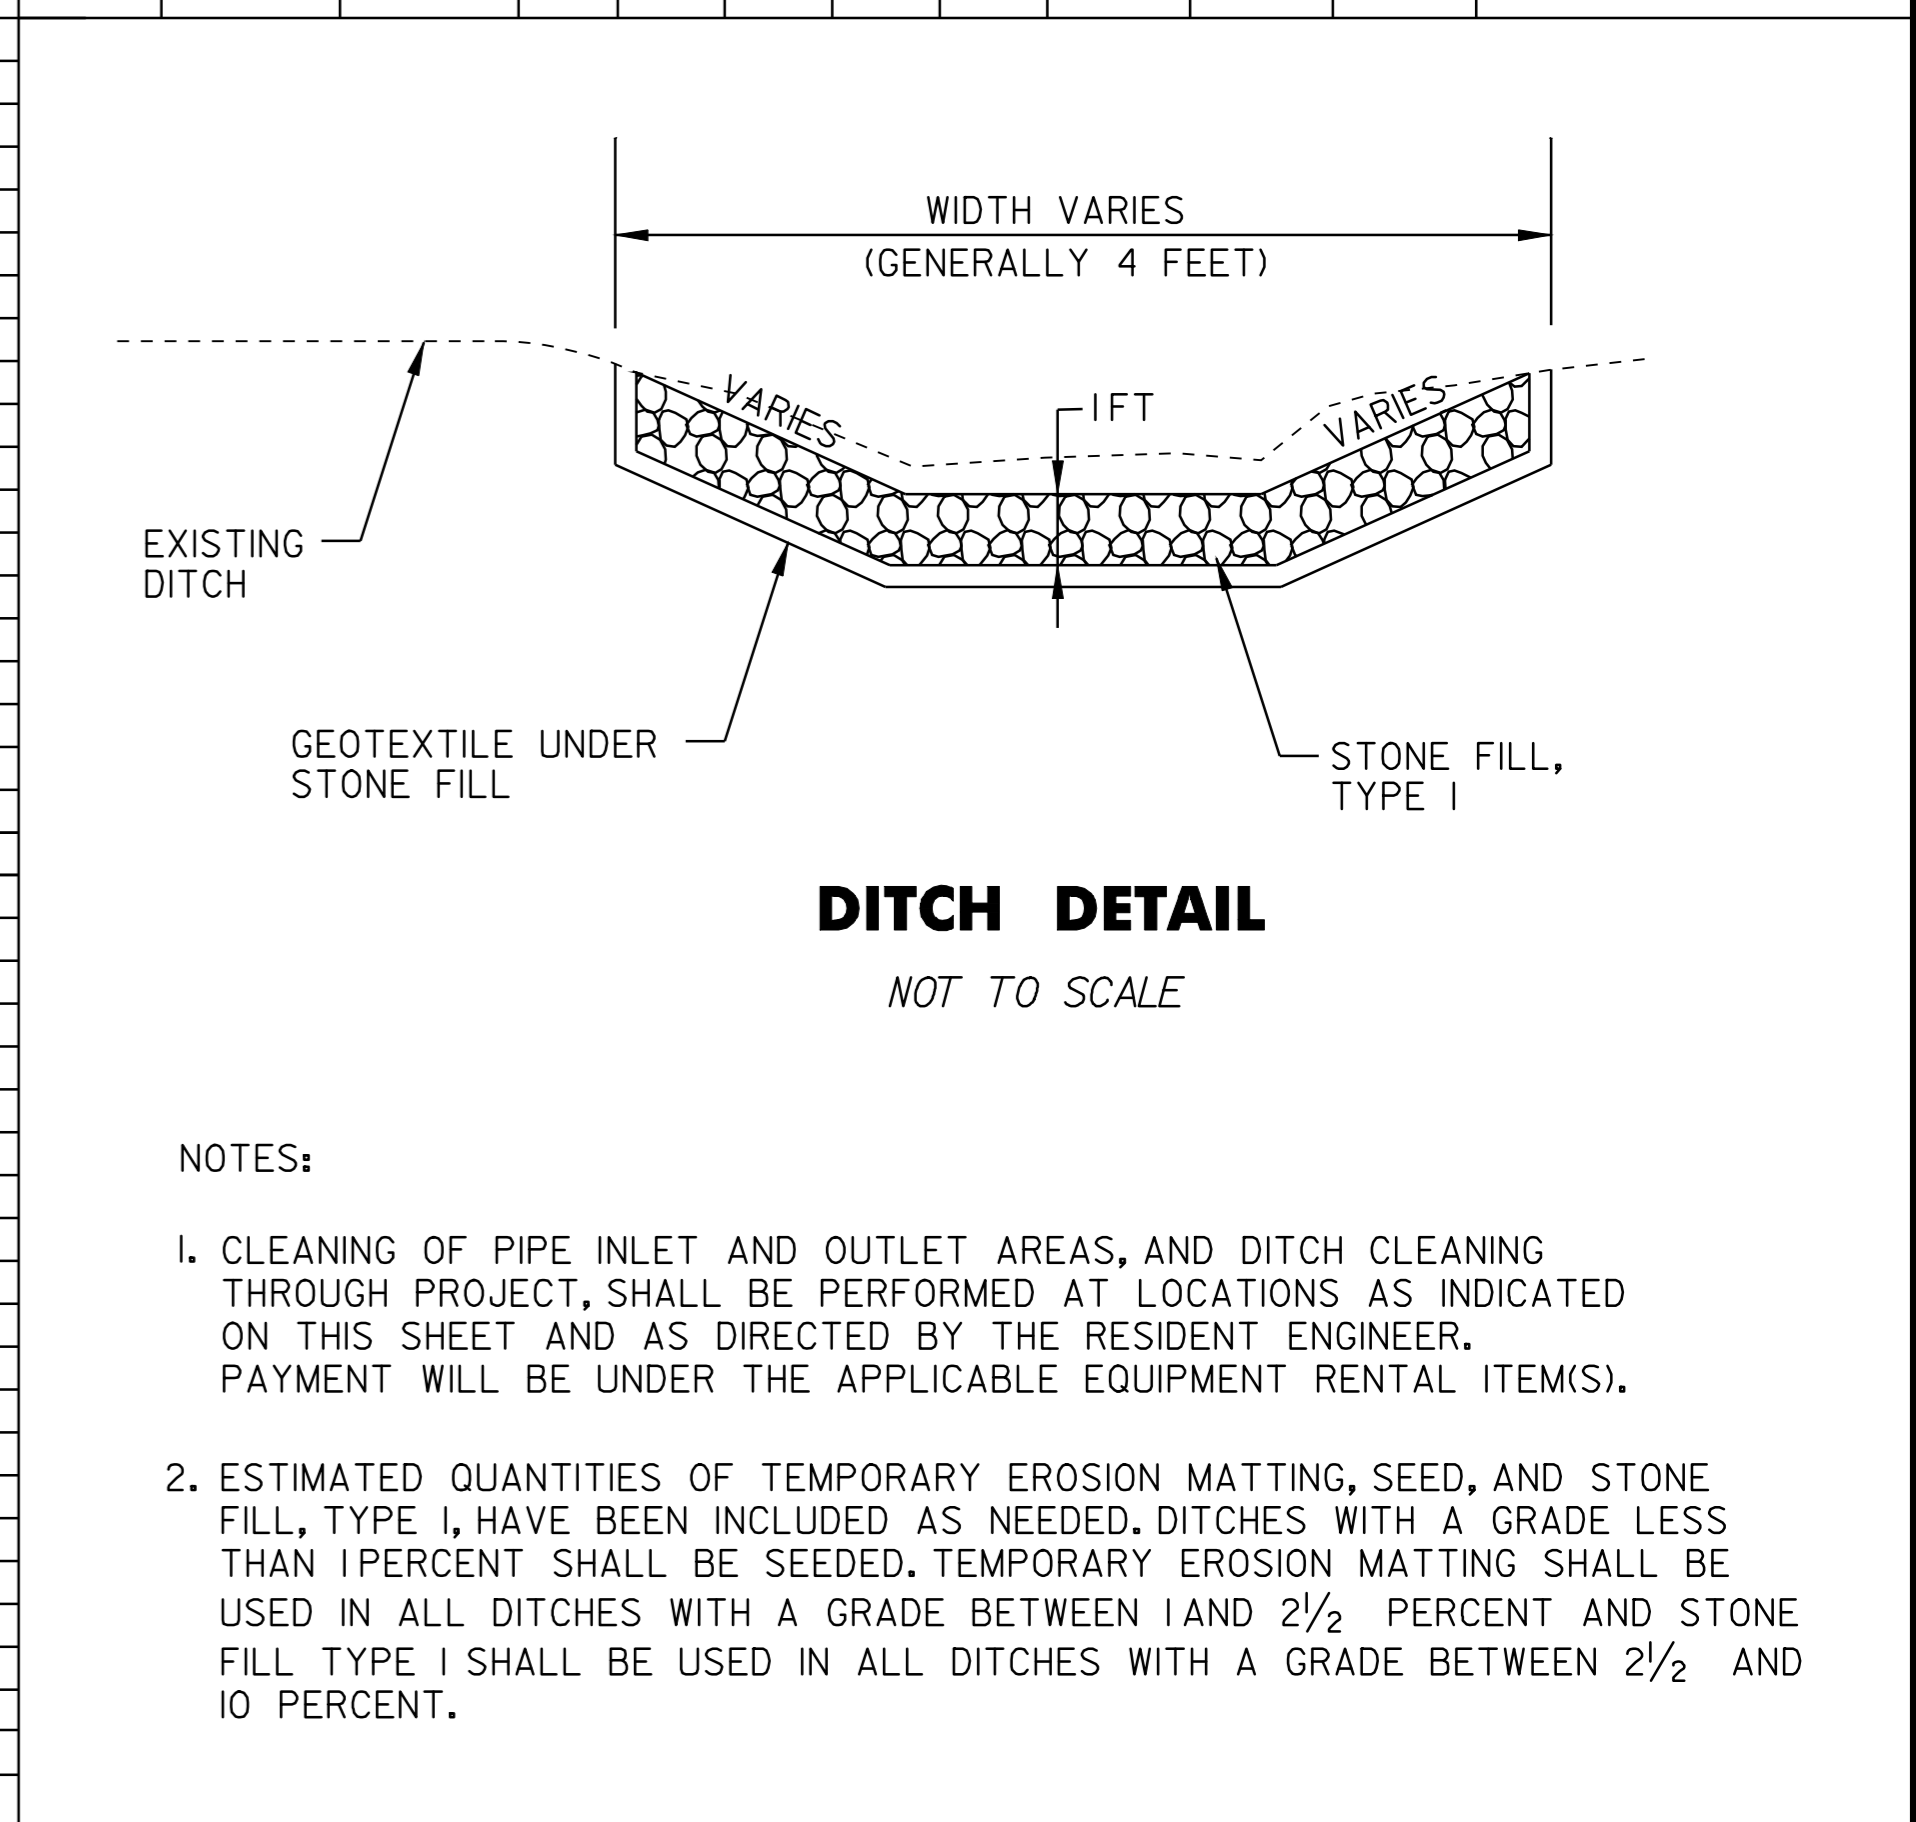

DITCH CLEANING DETAIL SHEET	PROJECT : JOHNSON - HYDE PARK	PROJECT NO. : STP 2215(1)S
	DESIGN FILE NAME: p99cl82.dgn	
	IPARM FILE NAME: p99cl82dcs.1	PLOT DATE: 08-JAN-2009
	SURVEYED BY: CEA	SURVEY DATE:
	SQUAD LEADER: BCE	DRAWN BY: PJM
	SHEET: 9 OF 33	

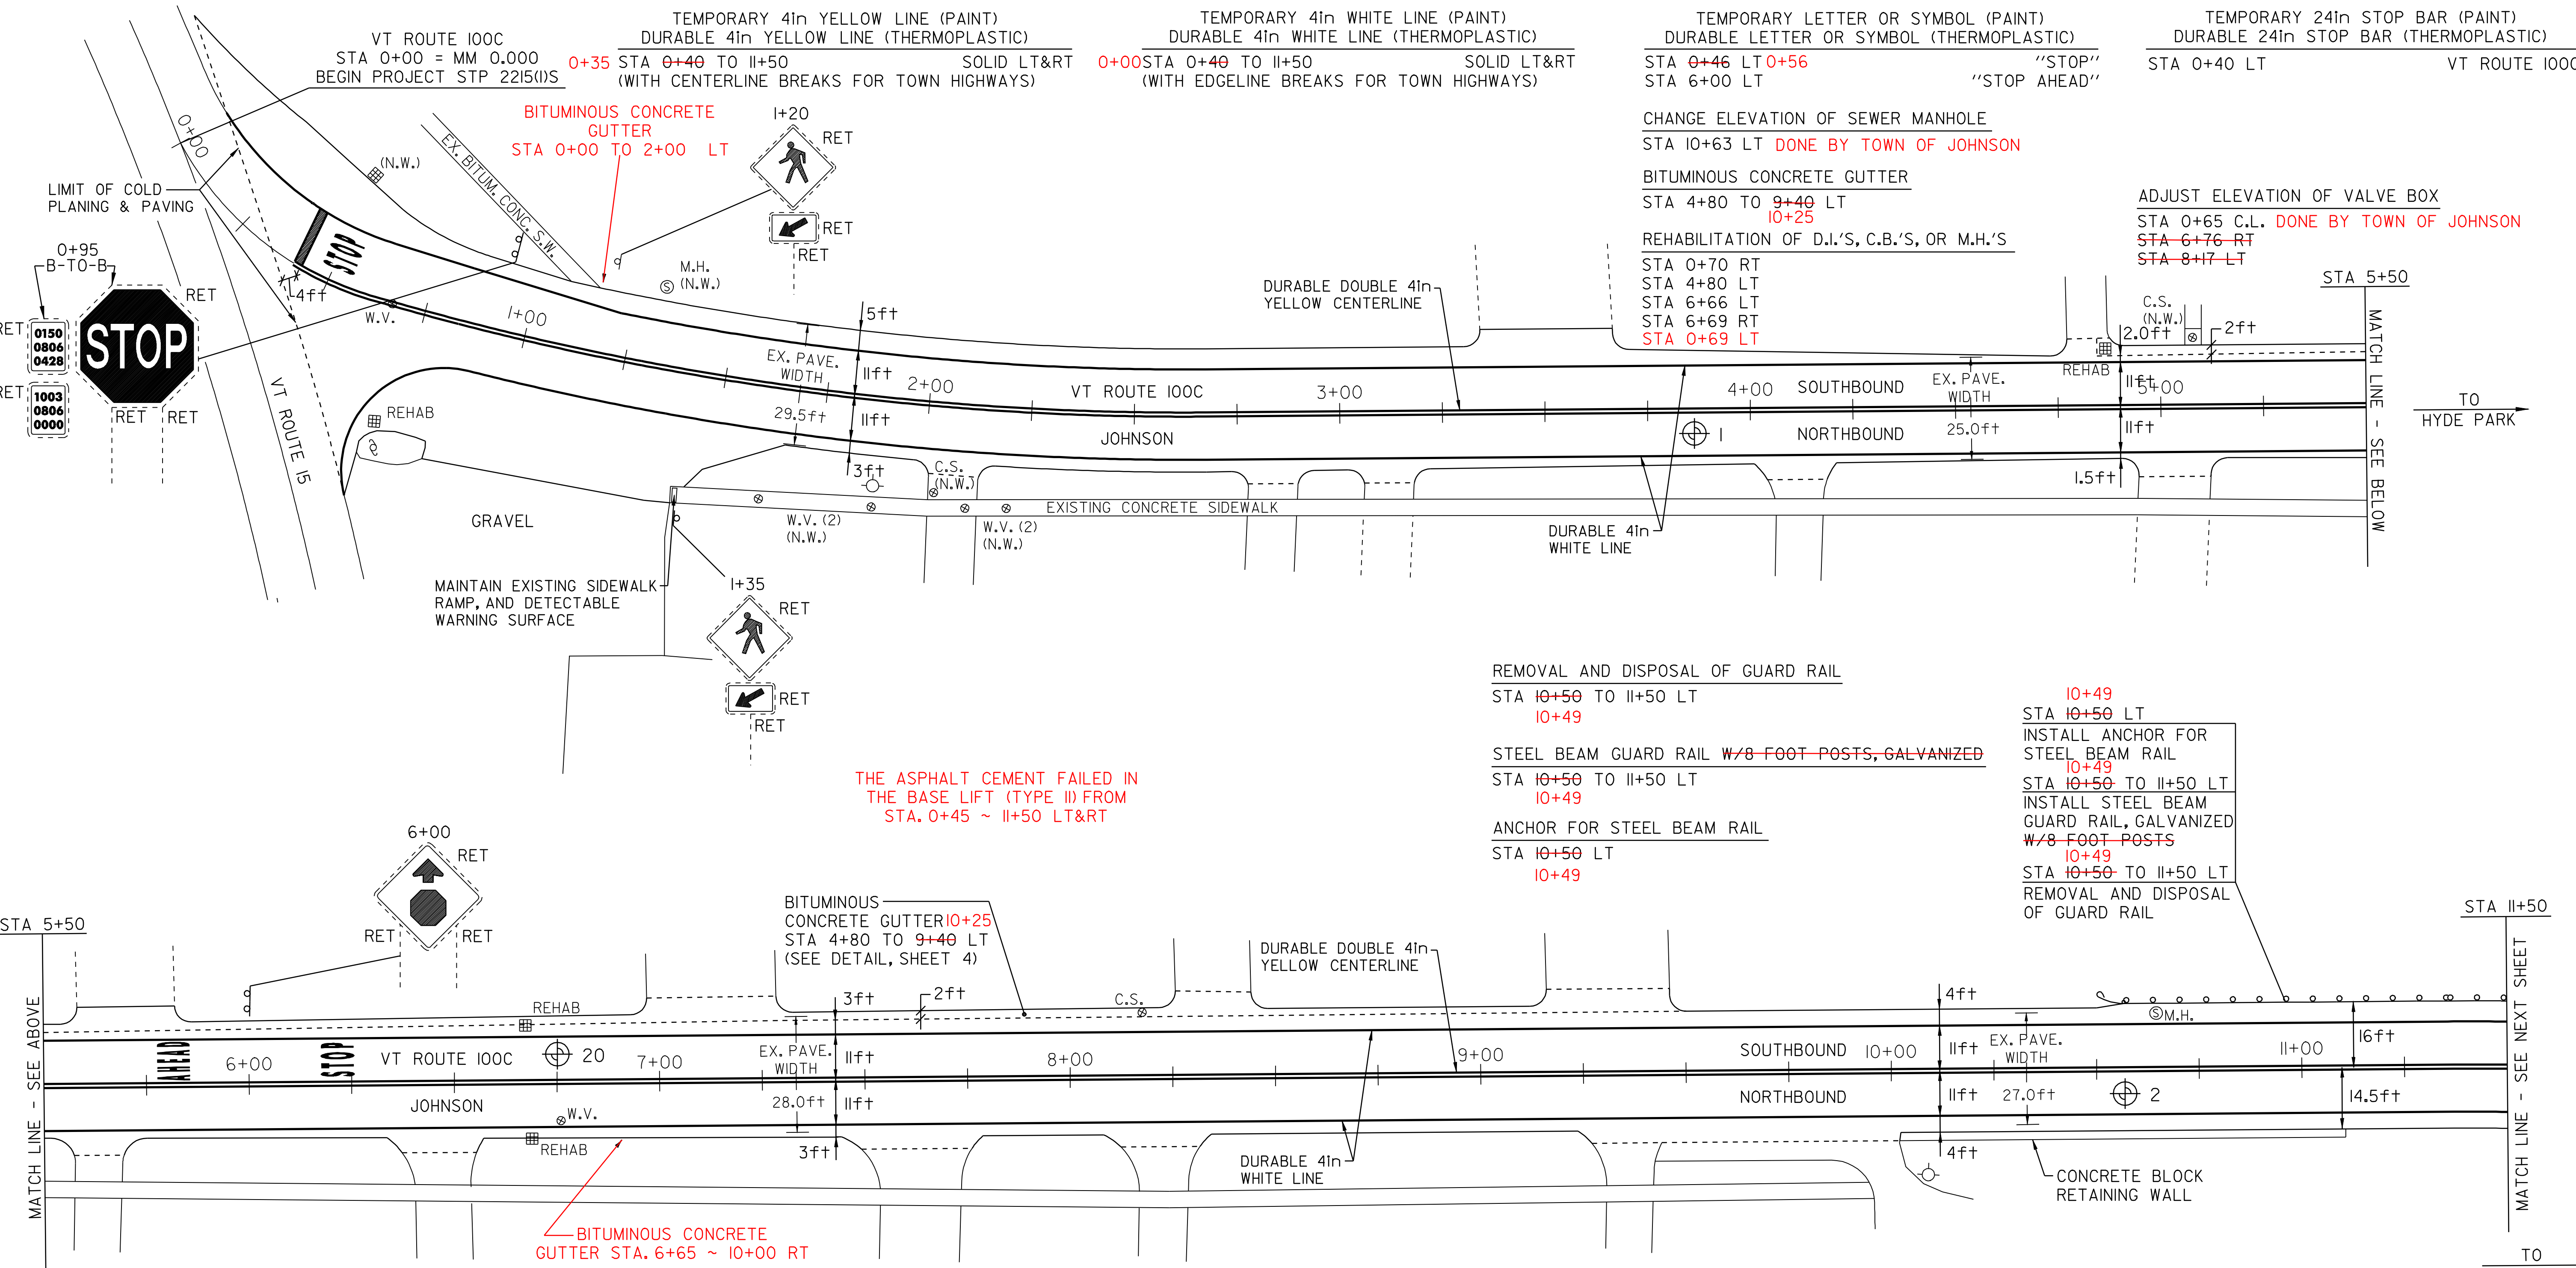

PAVEMENT CORES - ⊕

#	TOTAL DEPTH (in)	DRAINABLE BASE	SOLID CORE	COMMENTS
1	8.0	NO	NO	APPEARS TO BE TREATED GRAVEL
20	13.0	NO	YES	--
2	11.0	NO	YES	CONCRETE RETAINING WALL

NOTE:
 - NO PCC UNDER ANY CORES
 - NO CORES OVER ASPHALTED
 - NO SHOULDER CORES
 - NO STRIPPED CORES

- LEGEND
- N = NEW
 - R = REMOVE
 - R&S = REMOVE & SALVAGE
 - S = SALVAGE
 - RET = RETAIN
 - B-TO-B = BACK TO BACK
 - ⊕ ⊞ ⊠ = CATCH BASIN/DI
 - ⊙ M.H. = SEWER MANHOLE
 - ⊙ W.V. = WATER VALVE
 - ⊙ C.S. = CURB STOP
 - (N.W.) = NO WORK REQUIRED (TYP. FOR W.V.'S, C.S.'S, D.I.'S, C.B.'S WHERE NOTED)
 - ⊥ = YIELDING MARKER POST
 - ⊕ = UTILITY POLE
 - ⊖ = DRIVE

PAVING PROJECT LAYOUT SHEET #1

DESIGNED BY BCE/PJM DATE 7-07

DRAWN BY C.E.A., INC. DATE 7-07

DESIGN FILE NO. p99c182.dgn

PRF FILE p99c182p10.l DATE PLOTTED 08-JAN-2009

PROJ. NAME **JOHNSON-HYDE PARK**

PROJ. NO. **STP 2215(1)S**


SHEET **10** OF **33** SHEETS

TEMPORARY 4in YELLOW LINE (PAINT)
 DURABLE 4in YELLOW LINE (THERMOPLASTIC)
 STA 11+50 TO 22+00 SOLID LT&RT
 STA 19+80 DOUBLE SOLID LT
 (WITH CENTERLINE BREAKS FOR TOWN HIGHWAYS)

TEMPORARY 4in WHITE LINE (PAINT)
 DURABLE 4in WHITE LINE (THERMOPLASTIC)
 STA 11+50 TO 22+00 SOLID LT&RT
 (WITH EDGELINE BREAKS FOR TOWN HIGHWAYS)

TEMPORARY LETTER OR SYMBOL (PAINT)
 DURABLE LETTER OR SYMBOL (THERMOPLASTIC)
 STA 19+80 LT "STOP"

TEMPORARY 24in STOP BAR (PAINT)
 DURABLE 24in STOP BAR (THERMOPLASTIC)
 STA 19+80 LT SCHOOL RD

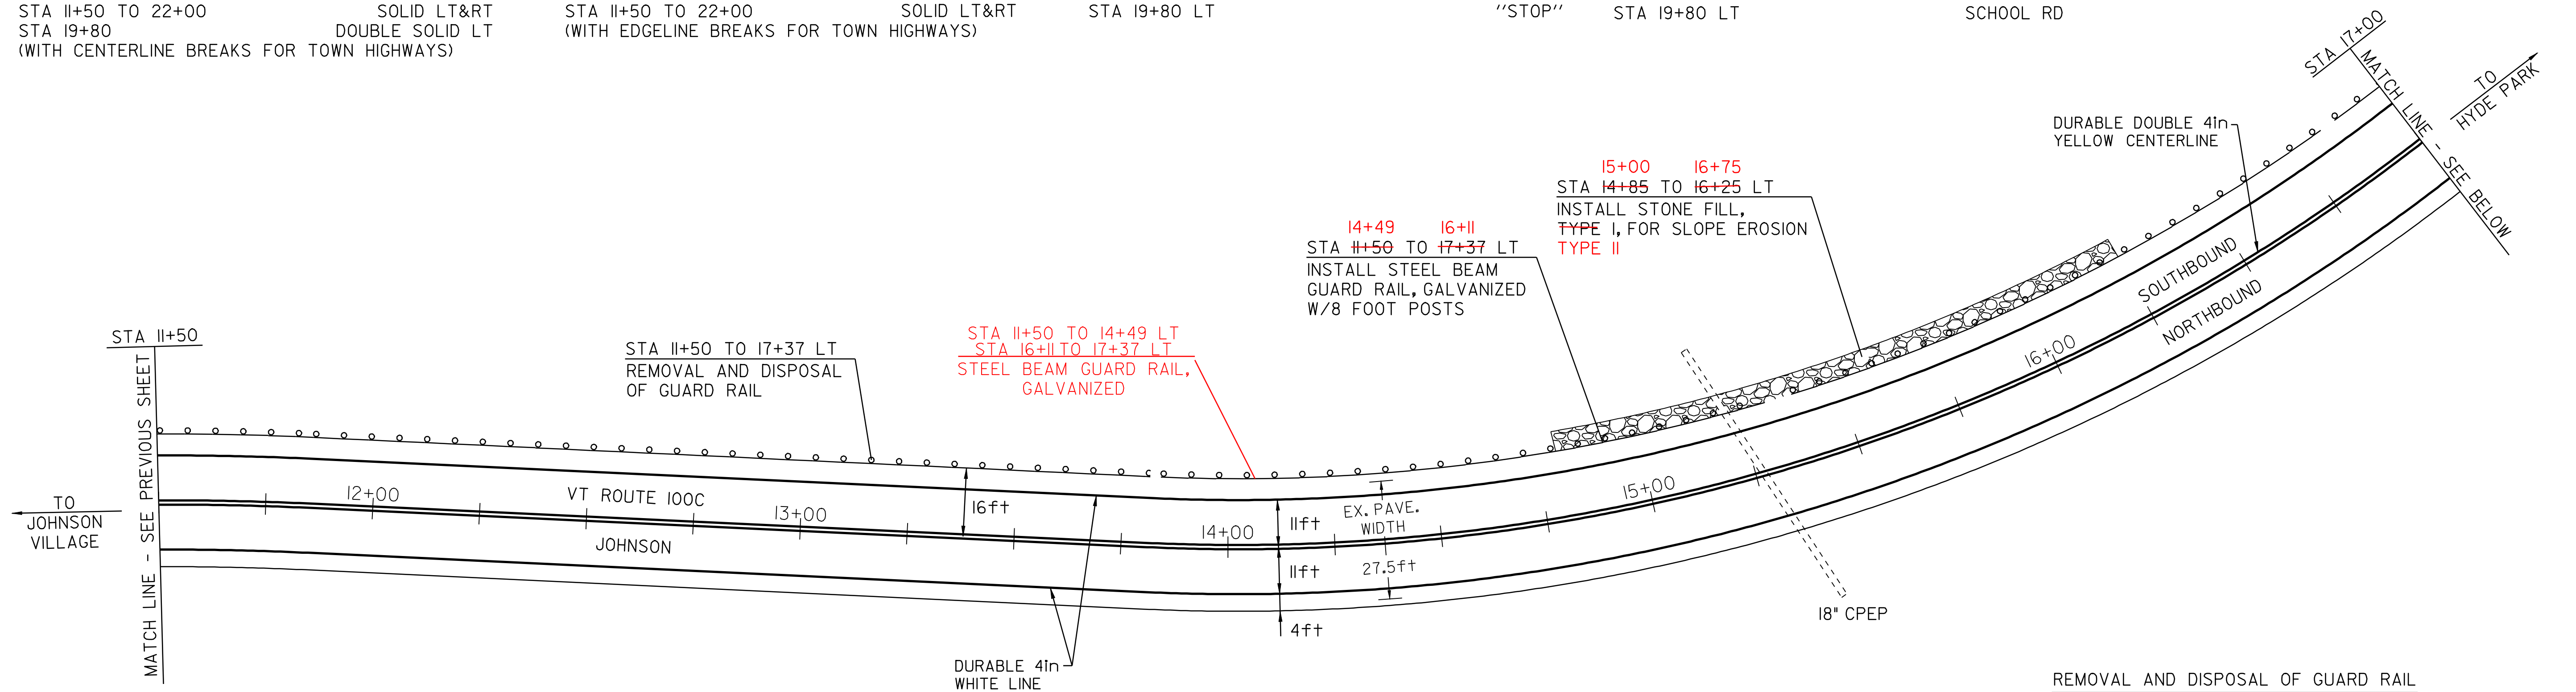


THE ASPHALT CEMENT FAILED IN THE
 BAS LIFT (TYPE IIS) AT
 STA. 11+50 ~ 14+85 LT AND
 STA. 11+50 ~ 15+45 RT

LOW AIR VOIDS IN A PORTION
 OF THE BASE LIFT (TYPE IIS)
 AT STA. 15+45 TO 26+40 RT

REMOVE SIGNS
 2

- REMOVAL AND DISPOSAL OF GUARD RAIL
 STA 11+50 TO 17+37 LT
- STEEL BEAM GUARD RAIL W/8 FOOT POSTS, GALVANIZED
 STA 11+50 TO 17+37 LT
 14+49 16+11
- ANCHOR FOR STEEL BEAM RAIL
 STA 17+37 LT
- CHANGE ELEVATION OF SEWER MANHOLE
 STA 19+74 LT DONE BY TOWN OF JOHNSON
- STEEL BEAM GUARD RAIL, GALVANIZED
 STA 11+50 TO 14+49 LT
 STA 16+11 TO 17+37 LT

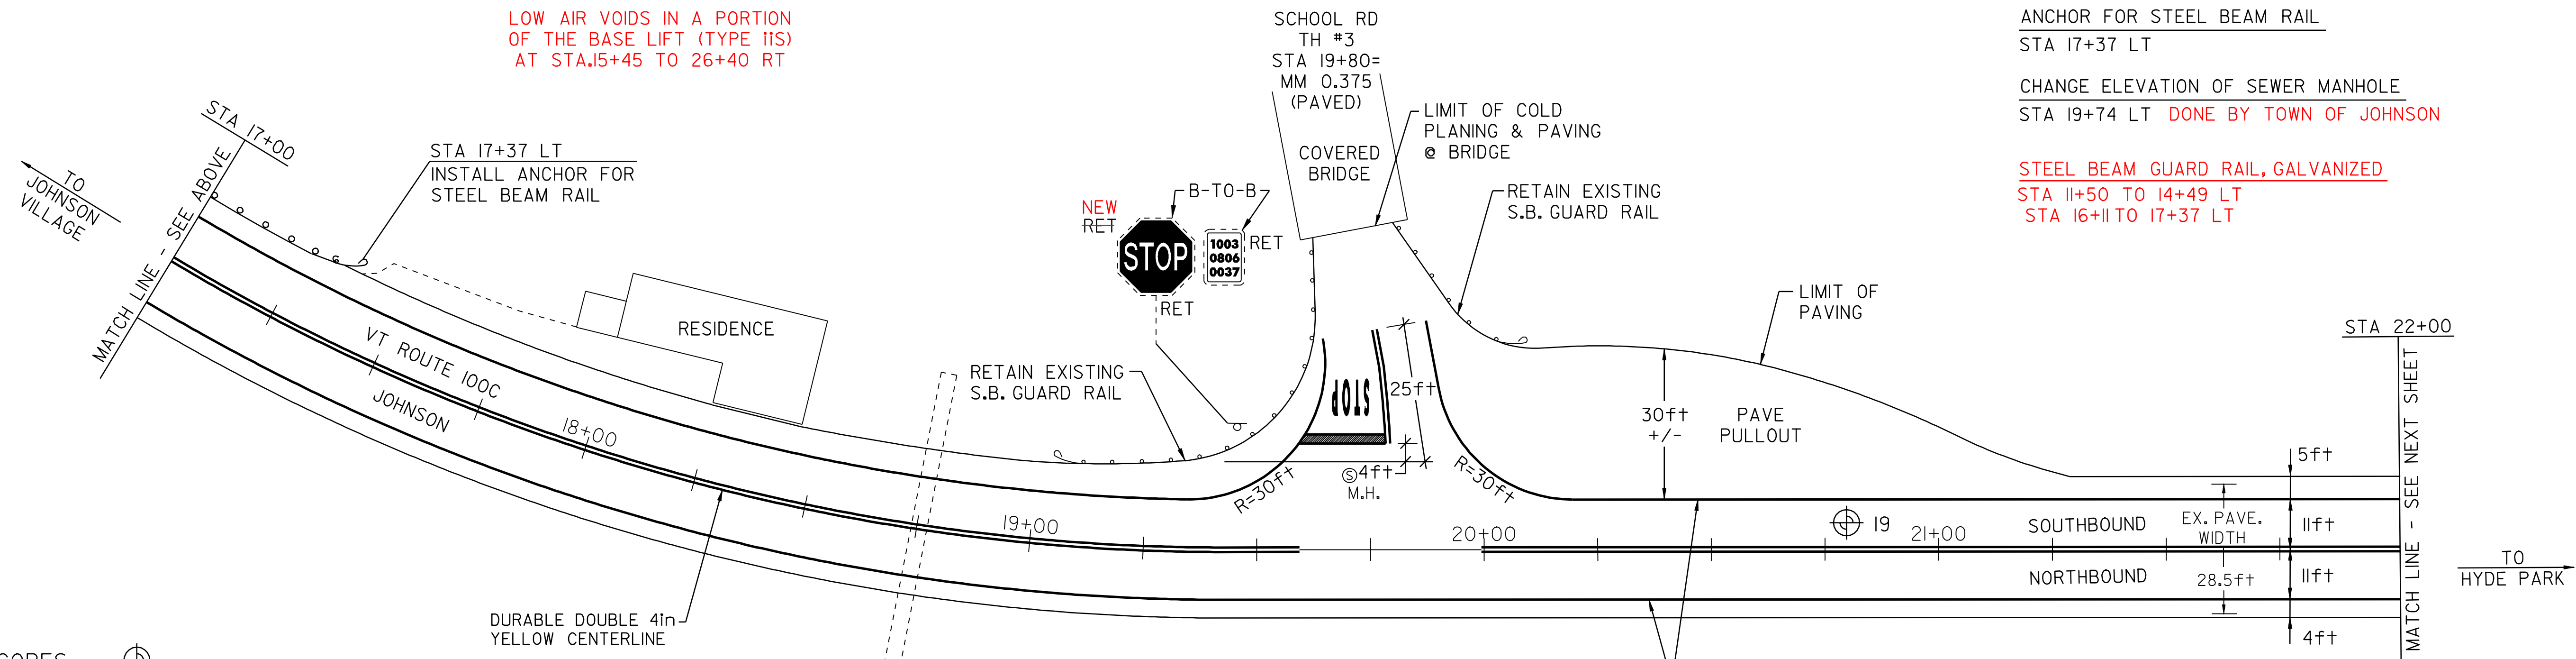

PAVEMENT CORES -

#	TOTAL DEPTH (in)	DRAINABLE BASE	SOLID CORE	COMMENTS
19	7.0	NO	YES	POWER HOUSE BRIDGE

NOTE:
 - NO PCC UNDER ANY CORES
 - NO CORES OVER ASPHALTED
 - NO SHOULDER CORES
 - NO STRIPPED CORES

PAVING PROJECT LAYOUT SHEET #2

DESIGNED BY BCE/PJM DATE 7-07
 DRAWN BY C.E.A., INC. DATE 7-07
 DESIGN FILE NO. p99c182.dgn
 PRF FILE p99c182pl02.i DATE PLOTTED 08-JAN-2009
 PROJ. NAME **JOHNSON-HYDE PARK**
 PROJ. NO. **STP 2215(1)S**
 SHEET **11** OF **33** SHEETS

TEMPORARY 4in YELLOW LINE (PAINT)
DURABLE 4in YELLOW LINE (THERMOPLASTIC)

STA 22+00 TO 52+25 SOLID LT&RT
STA 49+59 DOUBLE SOLID RT
(WITH CENTERLINE BREAKS FOR TOWN HIGHWAYS)

TEMPORARY 4in WHITE LINE (PAINT)
DURABLE 4in WHITE LINE (THERMOPLASTIC)

STA 22+00 TO 52+25 SOLID LT&RT
(WITH EDGELINE BREAKS FOR TOWN HIGHWAYS)

TEMPORARY LETTER OR SYMBOL (PAINT)
DURABLE LETTER OR SYMBOL (THERMOPLASTIC)

STA 49+59 RT "STOP"

TEMPORARY 24in STOP BAR (PAINT)
DURABLE 24in STOP BAR (THERMOPLASTIC)

STA 49+59 RT SINCLAIR RD

PAVEMENT CORES -

#	TOTAL DEPTH (in)	DRAINABLE BASE	SOLID CORE	COMMENTS
3	6.5	NO	YES	--
18	7.75	NO	YES	CABIN COVE RD
17	9.0	NO	YES	CABIN COVE RD

NOTE:
- NO PCC UNDER ANY CORES
- NO CORES OVER ASPHALTED
- NO SHOULDER CORES
- NO STRIPPED CORES

STA 22+40 LT
INSTALL ANCHOR FOR STEEL BEAM RAIL

STA 22+40 TO 26+75 LT

REMOVAL AND DISPOSAL OF GUARD RAIL

STA 22+40 TO 26+75 LT

INSTALL STEEL BEAM GUARD RAIL, GALVANIZED


STA 26+75 LT

INSTALL ANCHOR FOR STEEL BEAM RAIL

REMOVE SIGNS
6

BITUMINOUS CONCRETE GUTTER
STA 38+40 TO 40+00 LT

CHANGE ELEVATION OF SEWER MANHOLE
STA 49+70 RT
STA 22+50 LT
DONE BY TOWN OF JOHNSON

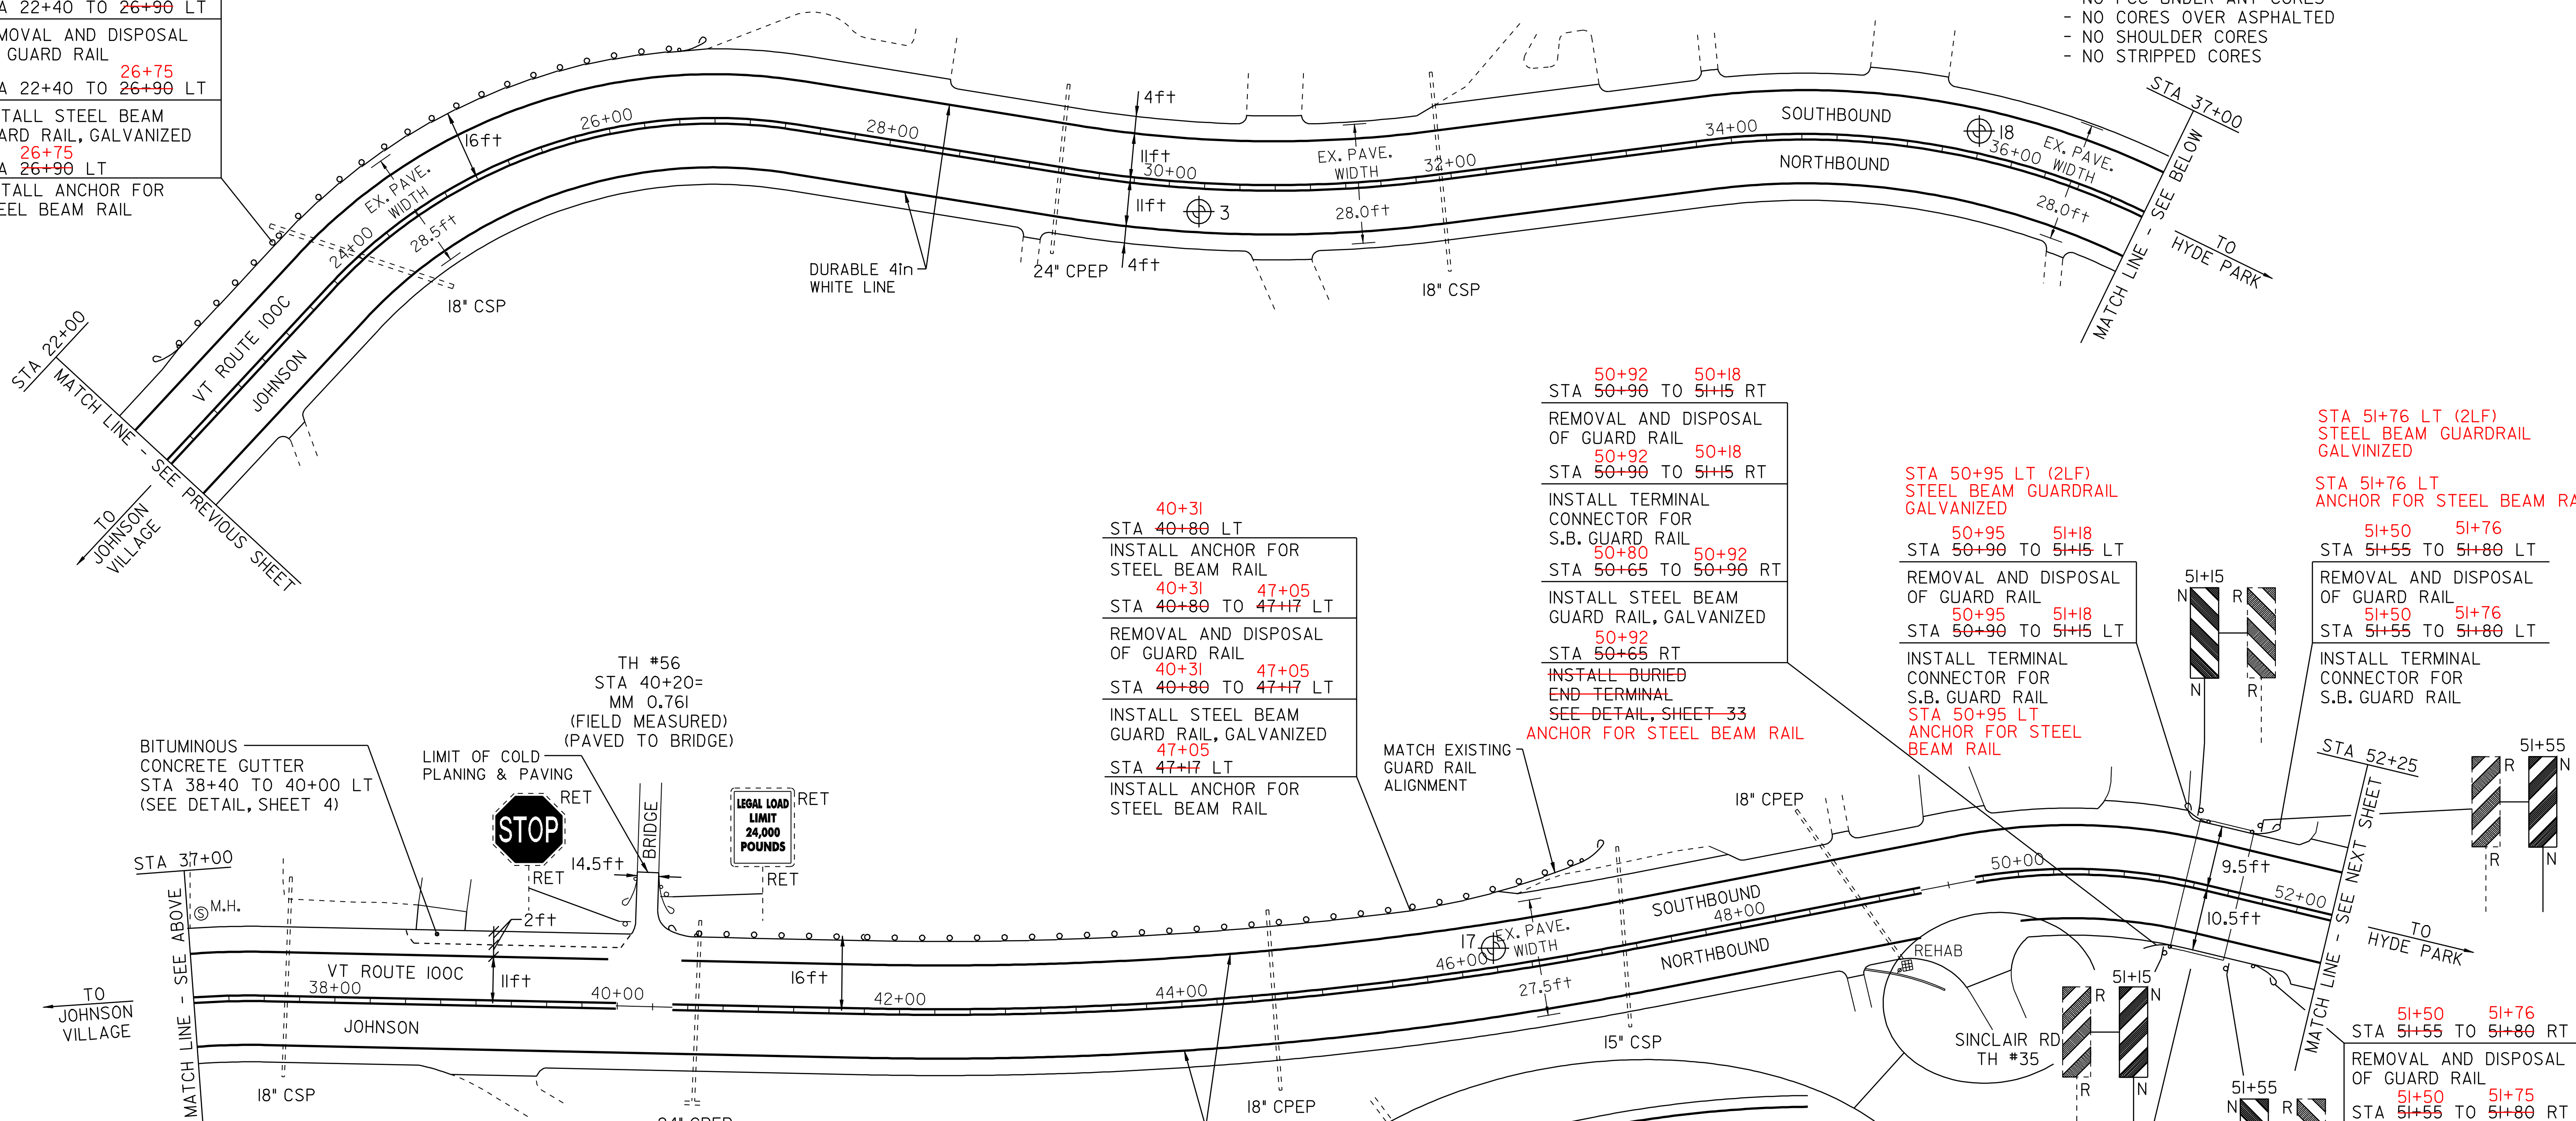

40+31
STA 40+80 LT
INSTALL ANCHOR FOR STEEL BEAM RAIL

40+31 47+05
STA 40+80 TO 47+17 LT
REMOVAL AND DISPOSAL OF GUARD RAIL

40+31 47+05
STA 40+80 TO 47+17 LT
INSTALL STEEL BEAM GUARD RAIL, GALVANIZED

47+05
STA 47+17 LT
INSTALL ANCHOR FOR STEEL BEAM RAIL

50+92 50+18
STA 50+90 TO 51+15 RT
REMOVAL AND DISPOSAL OF GUARD RAIL

50+92 50+18
STA 50+90 TO 51+15 RT
INSTALL TERMINAL CONNECTOR FOR S.B. GUARD RAIL

50+80 50+92
STA 50+65 TO 50+90 RT
INSTALL STEEL BEAM GUARD RAIL, GALVANIZED

50+92
STA 50+65 RT
INSTALL BURIED END TERMINAL
SEE DETAIL, SHEET 33
ANCHOR FOR STEEL BEAM RAIL

50+95 51+18
STA 50+90 TO 51+15 LT
REMOVAL AND DISPOSAL OF GUARD RAIL

50+95 51+18
STA 50+90 TO 51+15 LT
INSTALL TERMINAL CONNECTOR FOR S.B. GUARD RAIL

50+95 LT
ANCHOR FOR STEEL BEAM RAIL

51+76 LT (2LF)
STEEL BEAM GUARDRAIL GALVANIZED

51+76 LT
ANCHOR FOR STEEL BEAM RAIL

51+50 51+76
STA 51+55 TO 51+80 LT
REMOVAL AND DISPOSAL OF GUARD RAIL

51+50 51+76
STA 51+55 TO 51+80 LT
INSTALL TERMINAL CONNECTOR FOR S.B. GUARD RAIL

51+50 51+76
STA 51+55 TO 51+80 RT
REMOVAL AND DISPOSAL OF GUARD RAIL

51+50 51+75
STA 51+55 TO 51+80 RT
INSTALL TERMINAL CONNECTOR FOR S.B. GUARD RAIL

51+76 RT
ANCHOR FOR STEEL BEAM GUARD RAIL

51+76 RT (2LF)
STEEL BEAM GUARD RAIL, GALVANIZED

REMOVAL AND DISPOSAL OF GUARD RAIL

STA 22+40 TO 26+90 LT 22+40 TO 26+75
STA 40+80 TO 47+17 LT 40+31 TO 47+04
STA 50+90 TO 51+15 LT 50+92 TO 51+18
STA 50+90 TO 51+15 RT 50+92 TO 51+18
STA 51+55 TO 51+80 LT 51+50 TO 51+76
STA 51+55 TO 51+80 RT 51+50 TO 51+75

ANCHOR FOR STEEL BEAM RAIL

STA 22+40 LT
STA 26+90 LT 26+75
STA 40+80 LT 40+31
STA 47+17 LT 47+05
STA 50+65 RT - 250+92
STA 50+95 LT
STA 51+76 LT
STA 51+76 RT


TERMINAL CONNECTOR FOR S. B. GUARD RAIL

STA 50+90 TO 51+15 LT 50+92 TO 51+18
STA 50+90 TO 51+15 RT 50+92 TO 51+18
STA 51+55 TO 51+80 LT 51+50 TO 51+76
STA 51+55 TO 51+80 RT 51+50 TO 51+75

REHABILITATION OF D.I.'S, C.B.'S, OR M.H.'S
STA 49+10 RT

STEEL BEAM GUARD RAIL, GALVANIZED

STA 22+40 TO 26+90 LT 22+40 TO 26+75
STA 40+80 TO 47+17 LT 40+31 TO 47+05
STA 50+65 TO 50+90 RT 50+80 TO 50+92
STA 50+95 LT (WING)
STA 51+76 LT (WING)
STA 51+76 RT (WING)

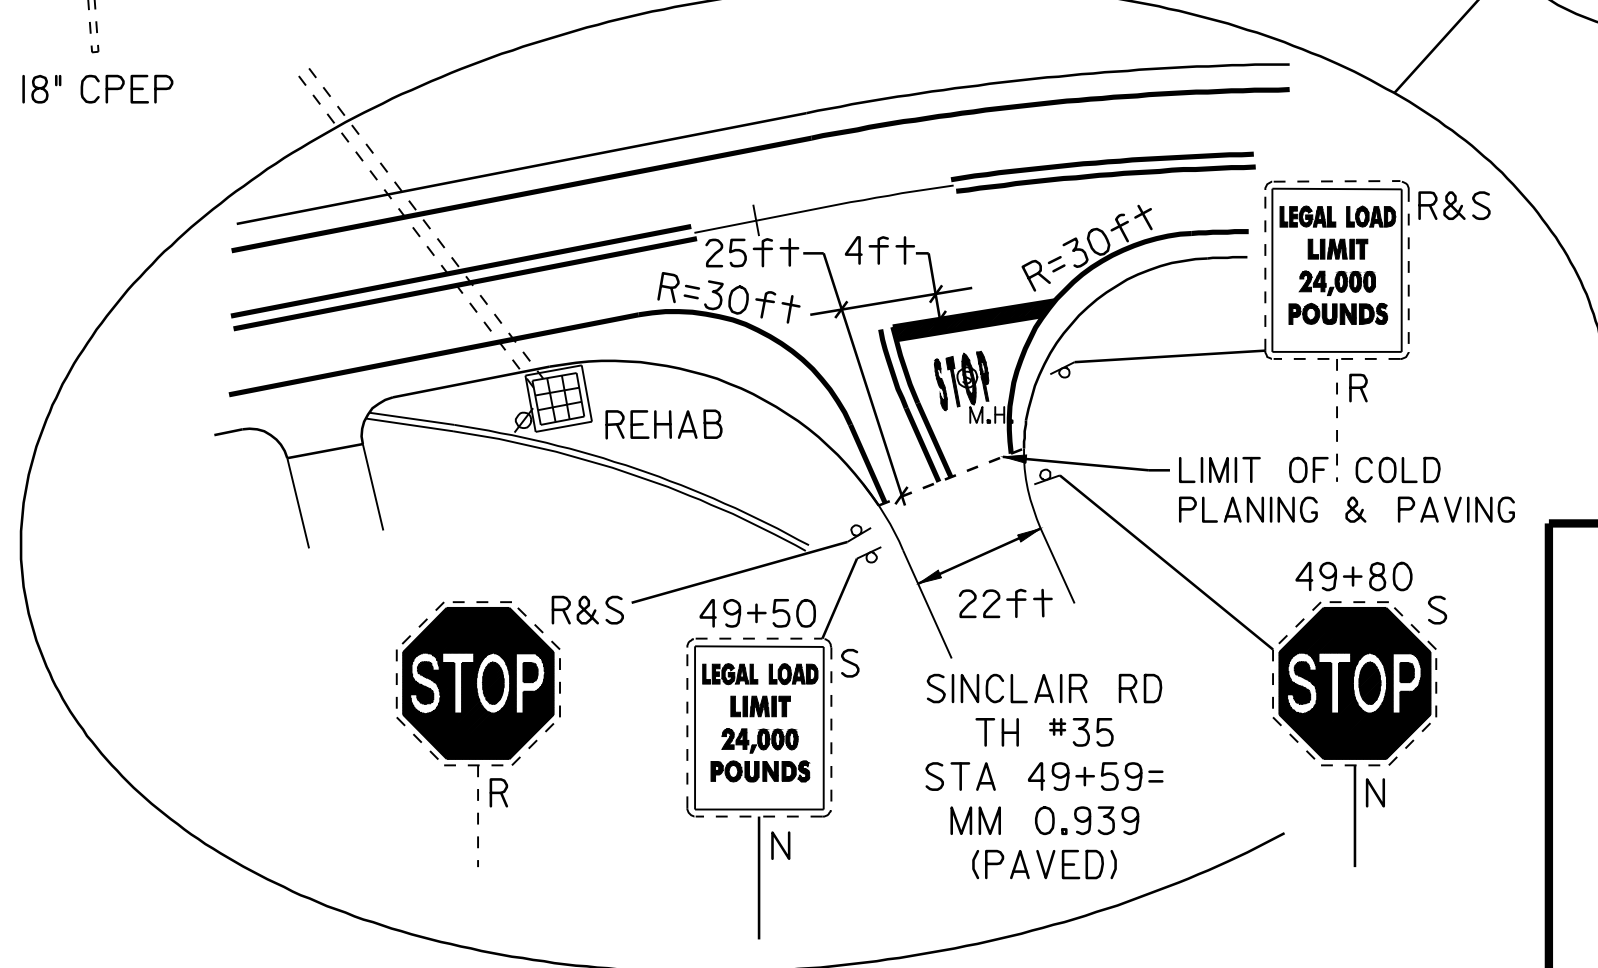

PAVING PROJECT LAYOUT SHEET #3

DESIGNED BY BCE/PJM DATE 7-07

DRAWN BY C.E.A., INC. DATE 7-07

DESIGN FILE NO. p99c182.dgn

PRF FILE p99c182p103.i DATE 08-JAN-2009

PROJ. NAME **JOHNSON - HYDE PARK**

PROJ. NO. **STP 2215(1)S**

SHEET **12** OF **33** SHEETS

TEMPORARY 4in YELLOW LINE (PAINT)
DURABLE 4in YELLOW LINE (THERMOPLASTIC)

STA 52+25 TO 83+00
STA 76+56
(WITH CENTERLINE BREAKS FOR TOWN HIGHWAYS)

TEMPORARY 4in WHITE LINE (PAINT)
DURABLE 4in WHITE LINE (THERMOPLASTIC)

STA 52+25 TO 83+00
(WITH EDGELINE BREAKS FOR TOWN HIGHWAYS)

TEMPORARY LETTER OR SYMBOL (PAINT)
DURABLE LETTER OR SYMBOL (THERMOPLASTIC)

STA 76+56 RT "STOP"

TEMPORARY 24in STOP BAR (PAINT)
DURABLE 24in STOP BAR (THERMOPLASTIC)


STA 76+56 RT ROCKY RD

YIELDING MARKER POST

STA 64+00 LT

REMOVE SIGNS

5

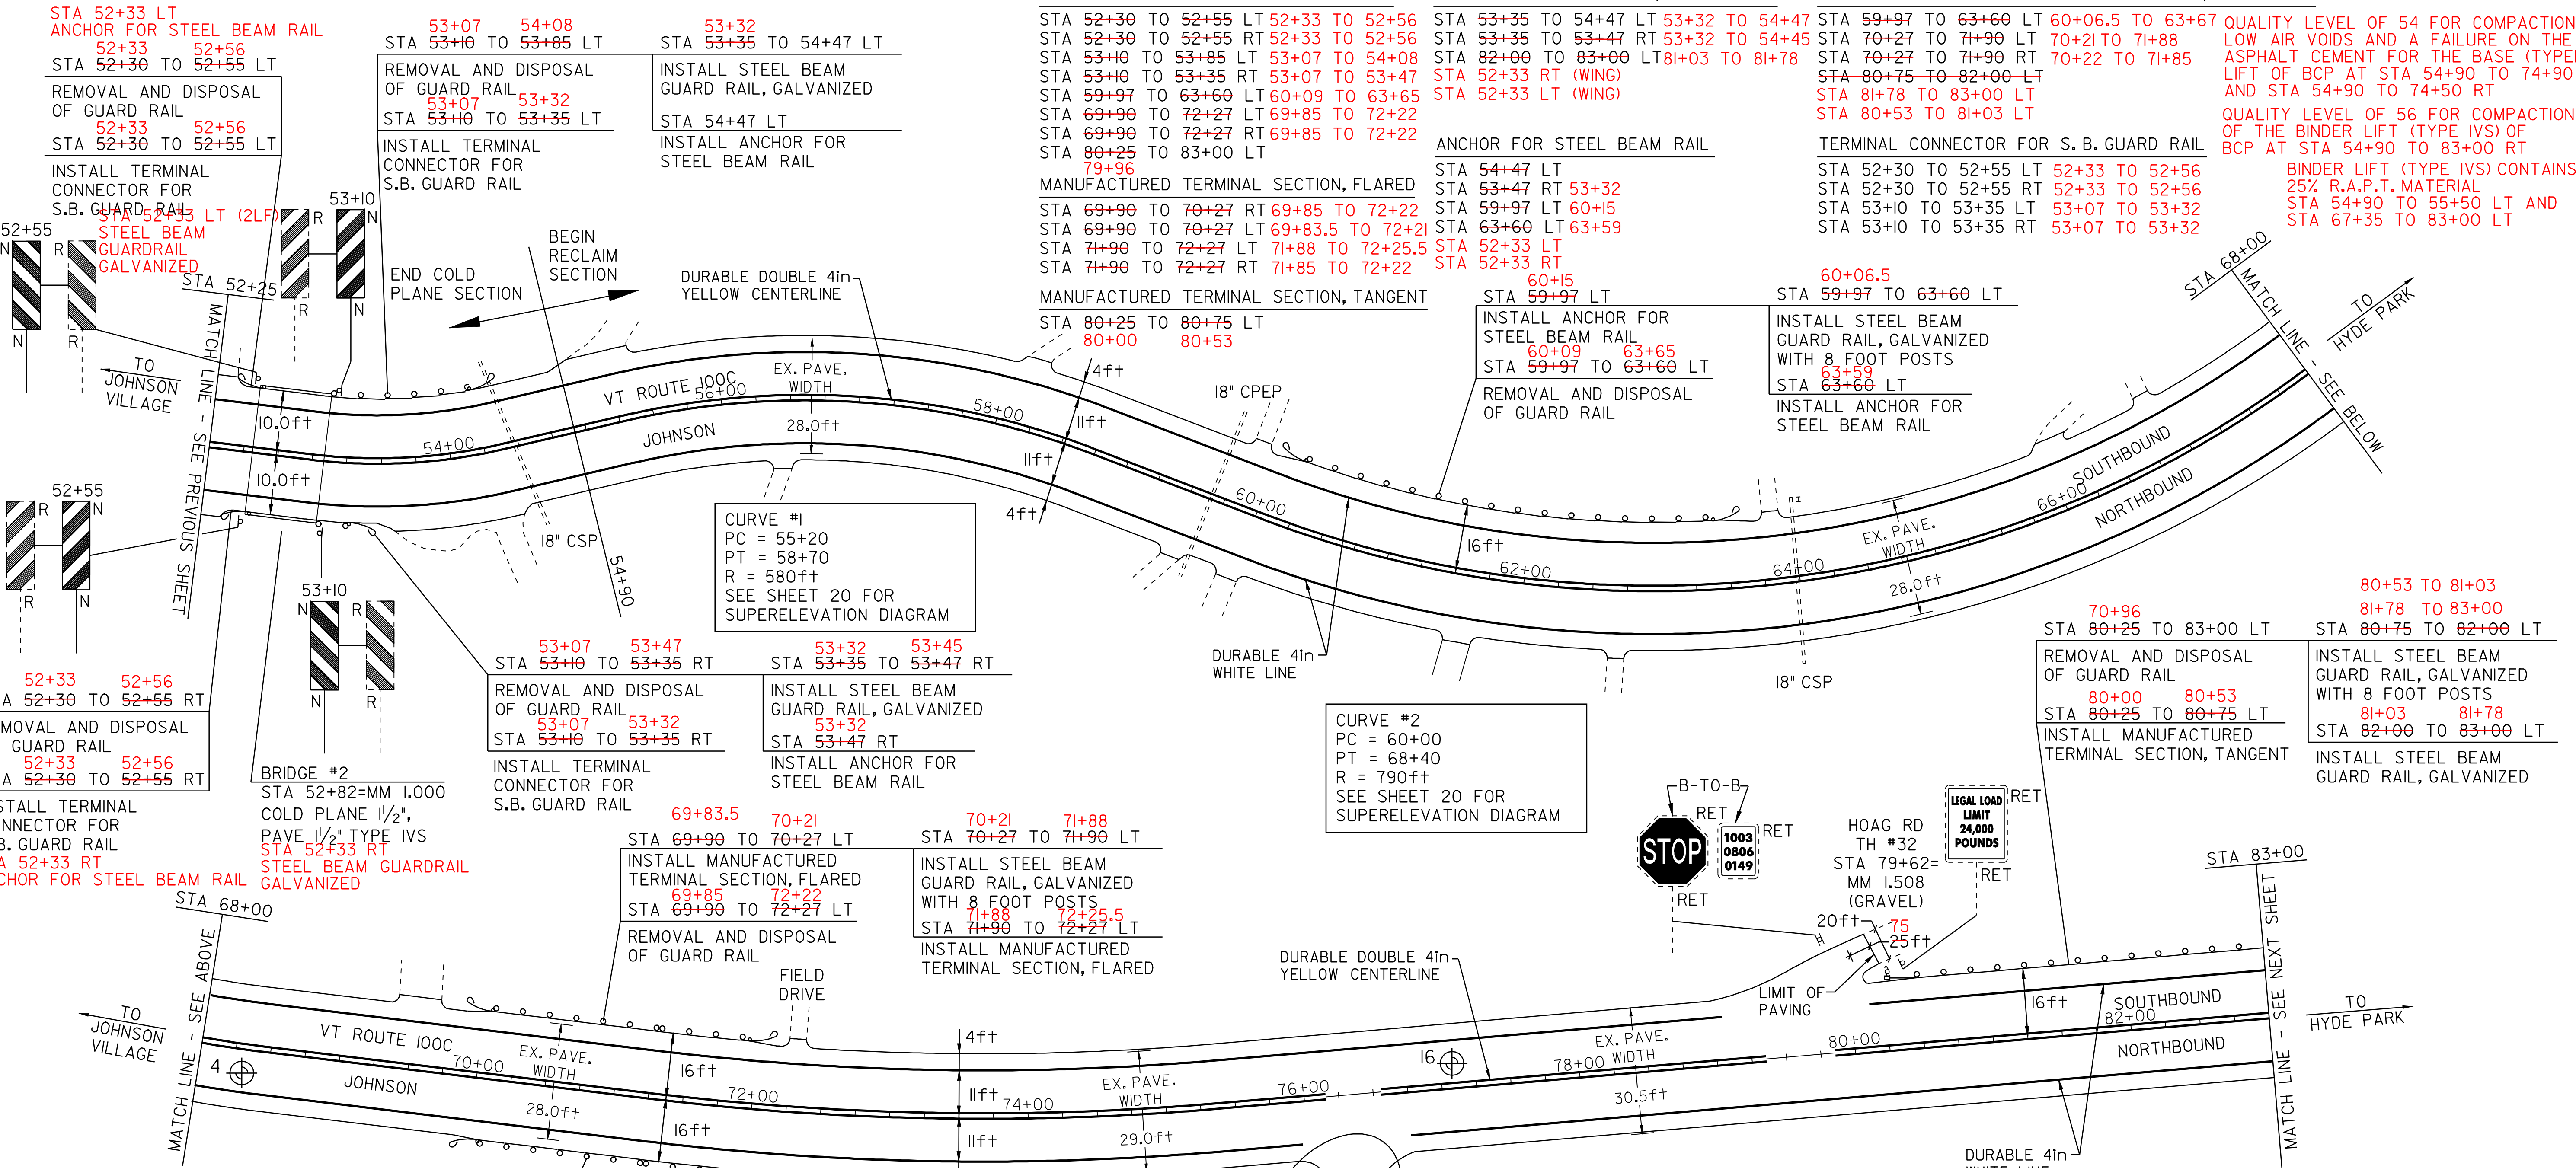


69+85 70+22
STA 69+90 TO 70+27 RT
INSTALL MANUFACTURED
TERMINAL SECTION, FLARED

70+22 71+85
STA 70+27 TO 71+90 RT
INSTALL STEEL BEAM
GUARD RAIL, GALVANIZED
WITH 8 FOOT POSTS

REMOVAL AND DISPOSAL
OF GUARD RAIL

LEGAL LOAD
LIMIT
16,000
POUNDS

SPEED
LIMIT
35

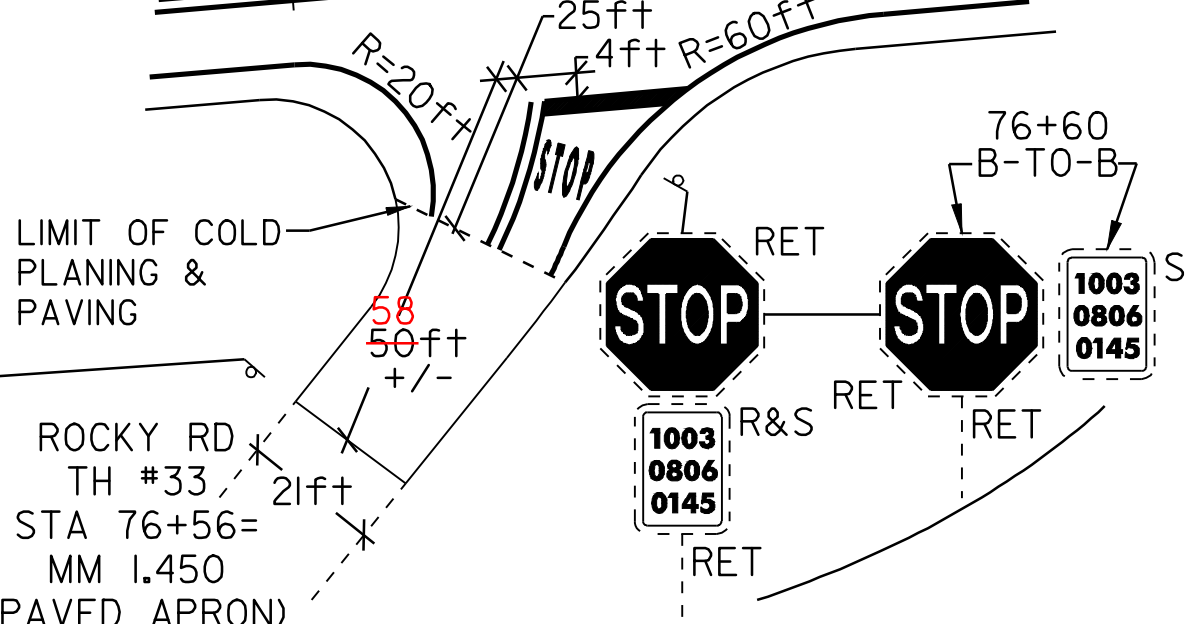

CURVE #3
PC = 71+30
PT = 75+40
R = 2,000ft
SEE SHEET 20 FOR
SUPERELEVATION DIAGRAM

PAVEMENT CORES -

#	TOTAL DEPTH (in)	DRAINABLE BASE	SOLID CORE	COMMENTS
4	5.0	YES	YES	--
16	7.5	NO	YES	ROCKY RD

NOTE:
- NO PCC UNDER ANY CORES
- NO CORES OVER ASPHALTED
- NO SHOULDER CORES
- NO STRIPPED CORES

PAVING PROJECT LAYOUT SHEET #4

DESIGNED BY BCE/PJM DATE 7-07

DRAWN BY C.E.A., INC. DATE 7-07

DESIGN FILE NO. p99c182.dgn

PRF FILE p99c182p104.i DATE PLOTTED 08-JAN-2009

PROJ. NAME **JOHNSON - HYDE PARK**

PROJ. NO. **STP 2215(1)S**

SHEET **13** OF **33** SHEETS

TEMPORARY 4in YELLOW LINE (PAINT)
 DURABLE 4in YELLOW LINE (THERMOPLASTIC)
 STA 83+00 TO 115+00
 SOLID LT&RT

TEMPORARY 4in WHITE LINE (PAINT)
 DURABLE 4in WHITE LINE (THERMOPLASTIC)
 STA 83+00 TO 115+00
 SOLID LT&RT

REMOVAL AND DISPOSAL OF GUARD RAIL
 STA 83+00 TO 85+25 LT
 83+78 85+05

STEEL BEAM GUARD RAIL, GALVANIZED
 STA 83+00 TO 84+88 LT
 83+78 85+78

MANUFACTURED TERMINAL SECTION, FLARED
 STA 84+88 TO 85+25 LT
 85+78 86+15


STEEL BEAM GUARDRAIL, GALVANIZED W/8' POSTS
 STA 83+00 TO 83+78 LT

CURVE #4
 PC = 83+00
 PT = 86+70
 R = 500ft
 SEE SHEET 20 FOR
 SUPERELEVATION DIAGRAM

CURVE #5
 PC = 93+10
 PT = 97+10
 R = 1,200ft
 SEE SHEET 21FOR
 SUPERELEVATION DIAGRAM

CURVE #6
 PC = 103+70
 PT = 108+50
 R = 750ft
 SEE SHEET 21FOR
 SUPERELEVATION DIAGRAM

CURVE #7
 PC = 111+20
 PT = 114+90
 R = 1,700ft
 SEE SHEET 21FOR
 SUPERELEVATION DIAGRAM

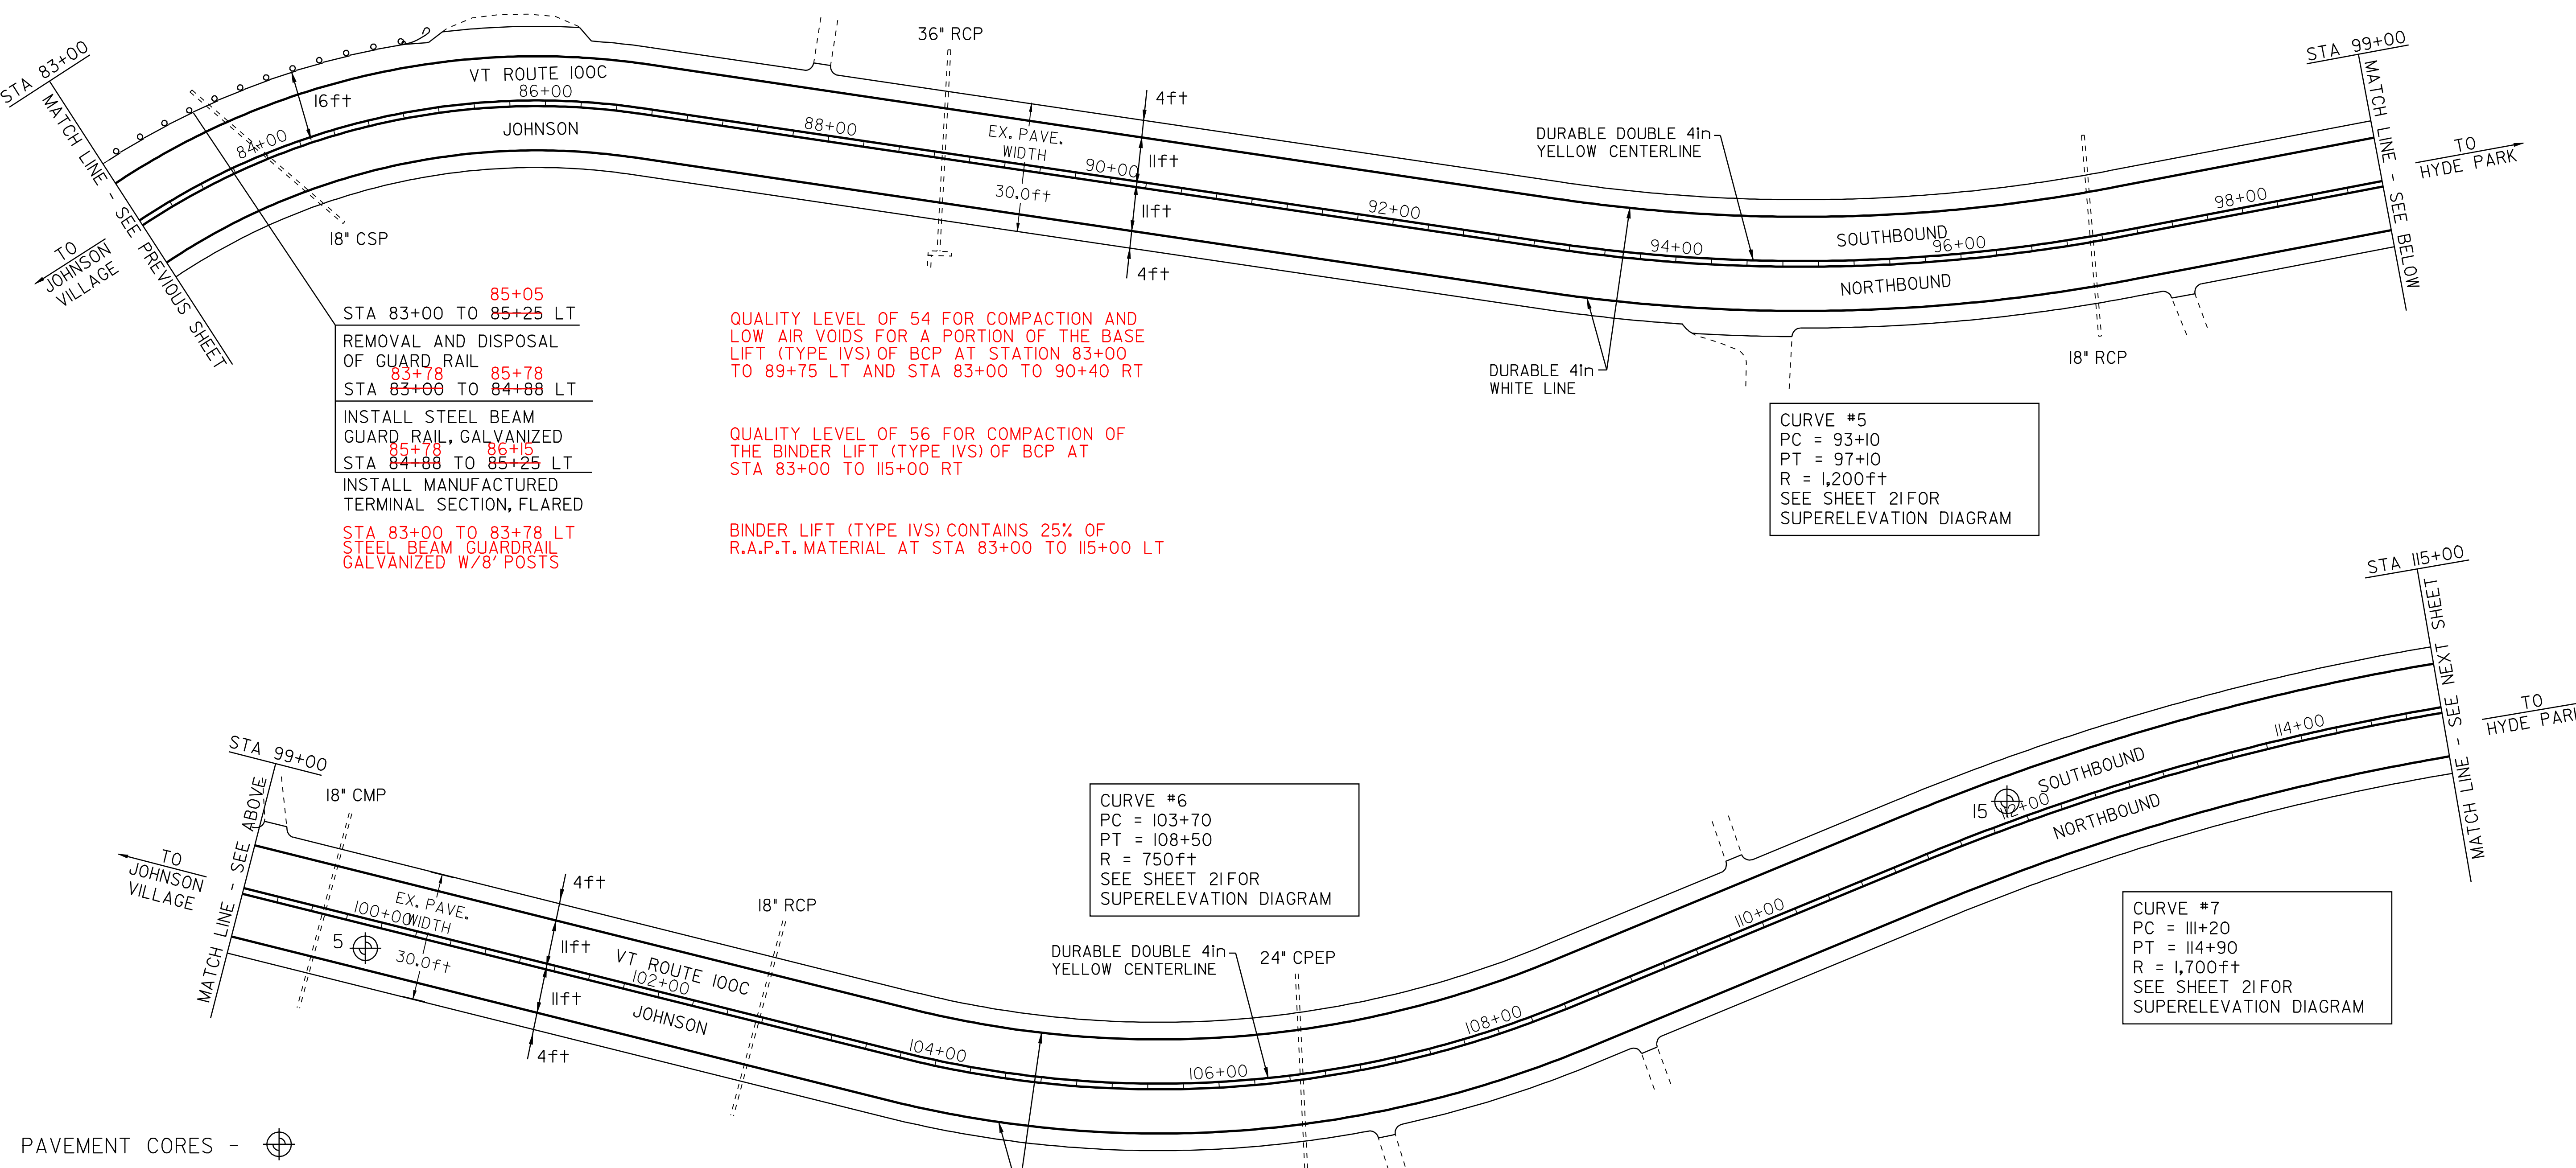

85+05
 STA 83+00 TO 85+25 LT
 REMOVAL AND DISPOSAL
 OF GUARD RAIL
 83+78 85+78
 STA 83+00 TO 84+88 LT
 INSTALL STEEL BEAM
 GUARD RAIL, GALVANIZED
 85+78 86+15
 STA 84+88 TO 85+25 LT
 INSTALL MANUFACTURED
 TERMINAL SECTION, FLARED
 STA 83+00 TO 83+78 LT
 STEEL BEAM GUARDRAIL
 GALVANIZED W/8' POSTS

QUALITY LEVEL OF 54 FOR COMPACTION AND
 LOW AIR VOIDS FOR A PORTION OF THE BASE
 LIFT (TYPE IVS) OF BCP AT STATION 83+00
 TO 89+75 LT AND STA 83+00 TO 90+40 RT

QUALITY LEVEL OF 56 FOR COMPACTION OF
 THE BINDER LIFT (TYPE IVS) OF BCP AT
 STA 83+00 TO 115+00 RT

BINDER LIFT (TYPE IVS) CONTAINS 25% OF
 R.A.P.T. MATERIAL AT STA 83+00 TO 115+00 LT

PAVEMENT CORES - ⊕

#	TOTAL DEPTH (in)	DRAINABLE BASE	SOLID CORE	COMMENTS
5	5.0	NO	YES	STEARNS RD
15	7.75	NO	YES	--

NOTE:
 - NO PCC UNDER ANY CORES
 - NO CORES OVER ASPHALTED
 - NO SHOULDER CORES
 - NO STRIPPED CORES

PAVING PROJECT LAYOUT SHEET #5

DESIGNED BY	BCE/PJM	DATE	7-07
DRAWN BY	C.E.A., INC.	DATE	7-07
DESIGN FILE NO.	p99c182.dgn		
PRF FILE	p99c182p105.i	DATE PLOTTED	08-JAN-2009
PROJ. NAME	JOHNSON - HYDE PARK		
PROJ. NO.	STP 2215(1)S		
SHEET	14	OF	33 SHEETS

TEMPORARY 4in YELLOW LINE (PAINT)
DURABLE 4in YELLOW LINE (THERMOPLASTIC)
STA 115+00 TO 145+00 SOLID LT&RT
STA 141+21 DOUBLE SOLID RT
(WITH CENTERLINE BREAKS FOR TOWN HIGHWAYS)

TEMPORARY 4in WHITE LINE (PAINT)
DURABLE 4in WHITE LINE (THERMOPLASTIC)
STA 115+00 TO 145+00 SOLID LT&RT
(WITH EDGELINE BREAKS FOR TOWN HIGHWAYS)

STEARNS RD
TH #68
STA 123+26=
MM 2.334
(CLASS III)

123+57 126+43
STA 123+42 TO 126+42 LT
REMOVAL AND DISPOSAL
OF GUARD RAIL
123+50 123+87
STA 123+42 TO 123+79 LT
INSTALL MANUFACTURED
TERMINAL SECTION, FLARED

123+87 126+12
STA 123+79 TO 126+05 LT
INSTALL STEEL BEAM
GUARD RAIL, GALVANIZED
126+12 126+49
STA 126+05 TO 126+42 LT
INSTALL MANUFACTURED
TERMINAL SECTION, FLARED

TEMPORARY LETTER OR SYMBOL (PAINT)
DURABLE LETTER OR SYMBOL (THERMOPLASTIC)
STA 141+21RT "STOP"

TEMPORARY 24in STOP BAR (PAINT)
DURABLE 24in STOP BAR (THERMOPLASTIC)
STA 141+21RT WHITCOMB ISLAND RD

CURVES #8 & #9
PC = 119+70
PCC = 122+10
R = 720ft
PCC = 122+10
PT = 127+50
R = 560ft
SEE SHEET 22 FOR
SUPERELEVATION DIAGRAM

REMOVE SIGNS
1

QUALITY LEVEL OF 56 FOR THE COMPACTION
OF THE BINDER LIFT (TYPE IVS) OF BCP
AT STA 115+00 TO 131+50 RT

THE BINDER LIFT (TYPE IVS) OF BCP
CONTAINS 25% R.A.P.T. MATERIAL
AT STA 115+00 TO 145+00 LT AND
AT STA 131+50 TO 145+00 RT

MINOR FAILURE ON
#200 FOR ITEM 900.680


REMOVAL AND DISPOSAL OF GUARD RAIL
STA 122+56 TO 125+44 RT 122+52 TO 125+38
STA 123+42 TO 126+42 LT 123+57 TO 126+43

STEEL BEAM GUARD RAIL, GALVANIZED
STA 123+79 TO 126+05 LT 123+87 TO 126+12

STEEL BEAM GUARD RAIL W/8 FOOT POSTS, GALVANIZED
STA 122+93 TO 125+07 RT 122+75 TO 125+00

MANUFACTURED TERMINAL SECTION, FLARED
STA 122+56 TO 122+93 RT 122+36 TO 122+75
STA 123+42 TO 123+79 LT 123+50 TO 123+87
STA 125+07 TO 125+44 RT 125+00 TO 125+38
STA 126+05 TO 126+42 LT 126+12 TO 126+44

CURVE #10
PC = 129+20
PT = 140+90
R = 790ft
SEE SHEET 22 FOR
SUPERELEVATION DIAGRAM

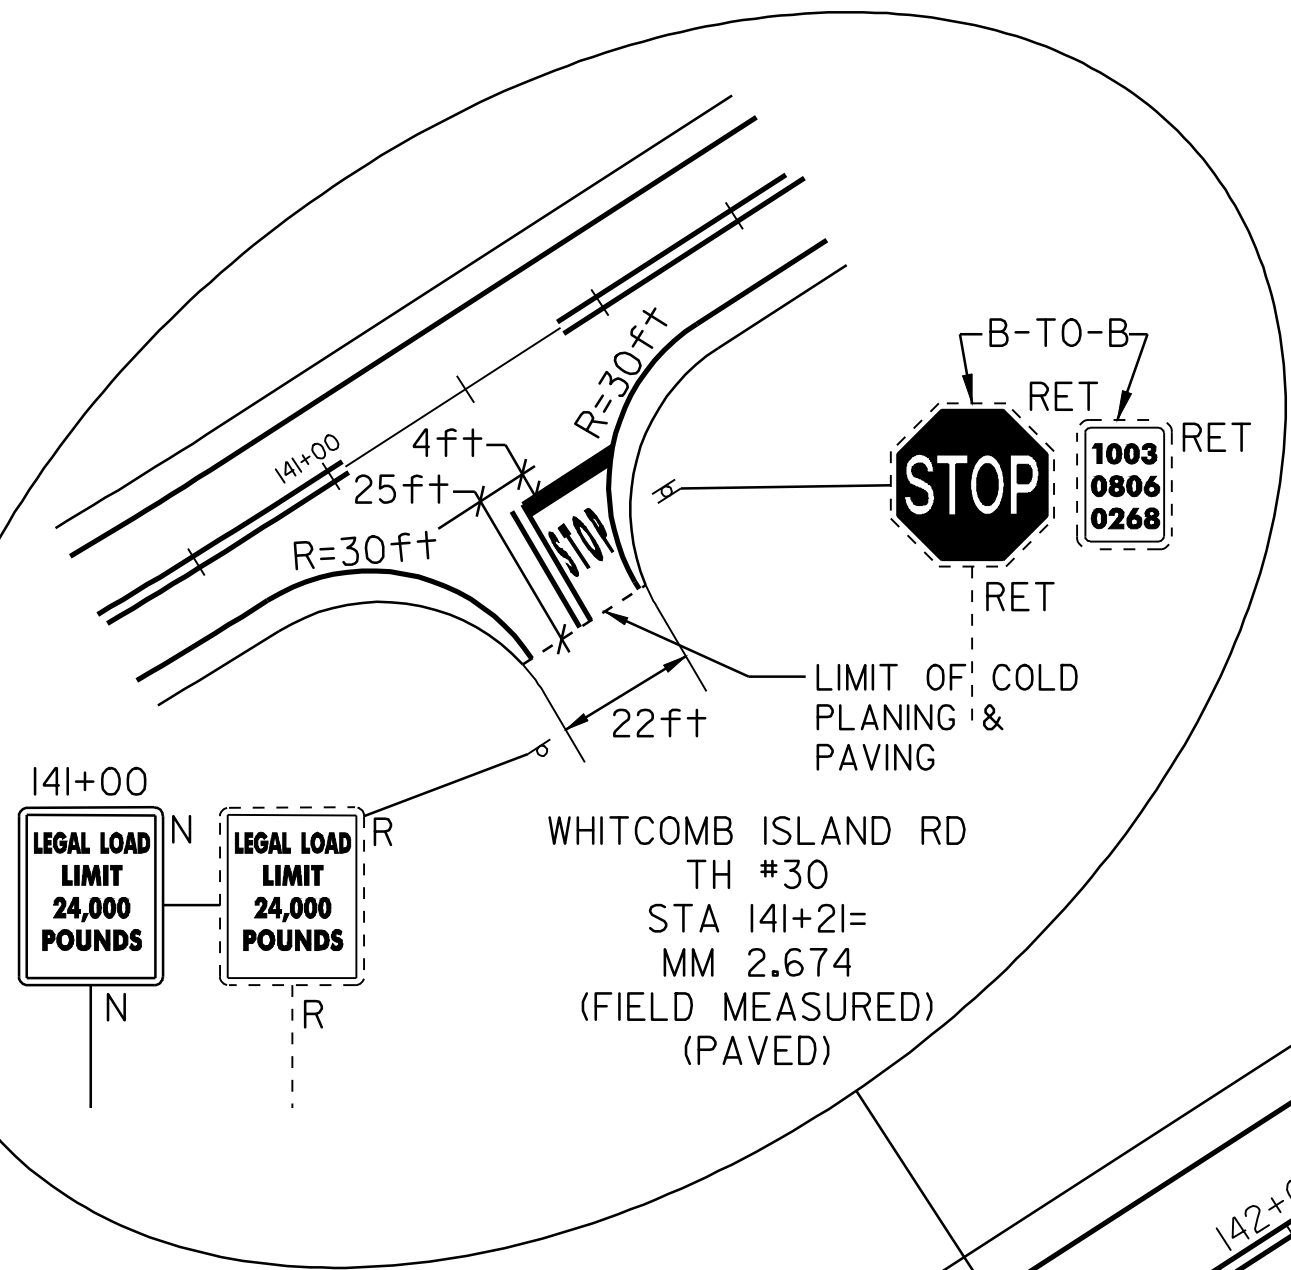

PAVEMENT CORES -

#	TOTAL DEPTH (1n)	DRAINABLE BASE	SOLID CORE	COMMENTS
6	5.0	NO	YES	CHIP SEAL

NOTE:
- NO PCC UNDER ANY CORES
- NO CORES OVER ASPHALTED
- NO SHOULDER CORES
- NO STRIPPED CORES

PAVING PROJECT LAYOUT SHEET #6

DESIGNED BY	BCE/PJM	DATE	7-07
DRAWN BY	C.E.A., INC.	DATE	7-07
DESIGN FILE NO.	p99c182.dgn		
PRF FILE	p99c182p106.i	DATE PLOTTED	08-JAN-2009
PROJ. NAME	JOHNSON - HYDE PARK		
PROJ. NO.	STP 2215(1)S		
SHEET	15	OF	33 SHEETS

TEMPORARY 4in YELLOW LINE (PAINT)
 DURABLE 4in YELLOW LINE (THERMOPLASTIC)

STA 145+00 TO 152+59 151+90 SOLID LT&RT
 STA 151+51 DOUBLE SOLID LT&RT
 STA 152+59 TO 156+56 SOLID LT & DASHED RT
 STA 156+56 TO 163+68 DASHED
 STA 163+68 TO 170+02 DASHED LT & SOLID RT
 STA 170+02 TO 174+00 SOLID LT&RT
 (WITH CENTERLINE BREAKS FOR TOWN HIGHWAYS)

151+90 TO 155+67
 155+67 TO 162+64
 162+64 TO 169+22
 169+22 TO 174+00

TEMPORARY LETTER OR SYMBOL (PAINT)
 DURABLE LETTER OR SYMBOL (THERMOPLASTIC)



STA 151+51LT "STOP"
 STA 151+51RT "STOP"

TEMPORARY 4in WHITE LINE (PAINT)
 DURABLE 4in WHITE LINE (THERMOPLASTIC)

STA 145+00 TO 174+00 SOLID LT&RT
 (WITH EDGELINE BREAKS FOR TOWN HIGHWAYS)


TEMPORARY 24in STOP BAR (PAINT)
 DURABLE 24in STOP BAR (THERMOPLASTIC)

STA 151+51LT MINE RD
 STA 151+51RT WILSON RD

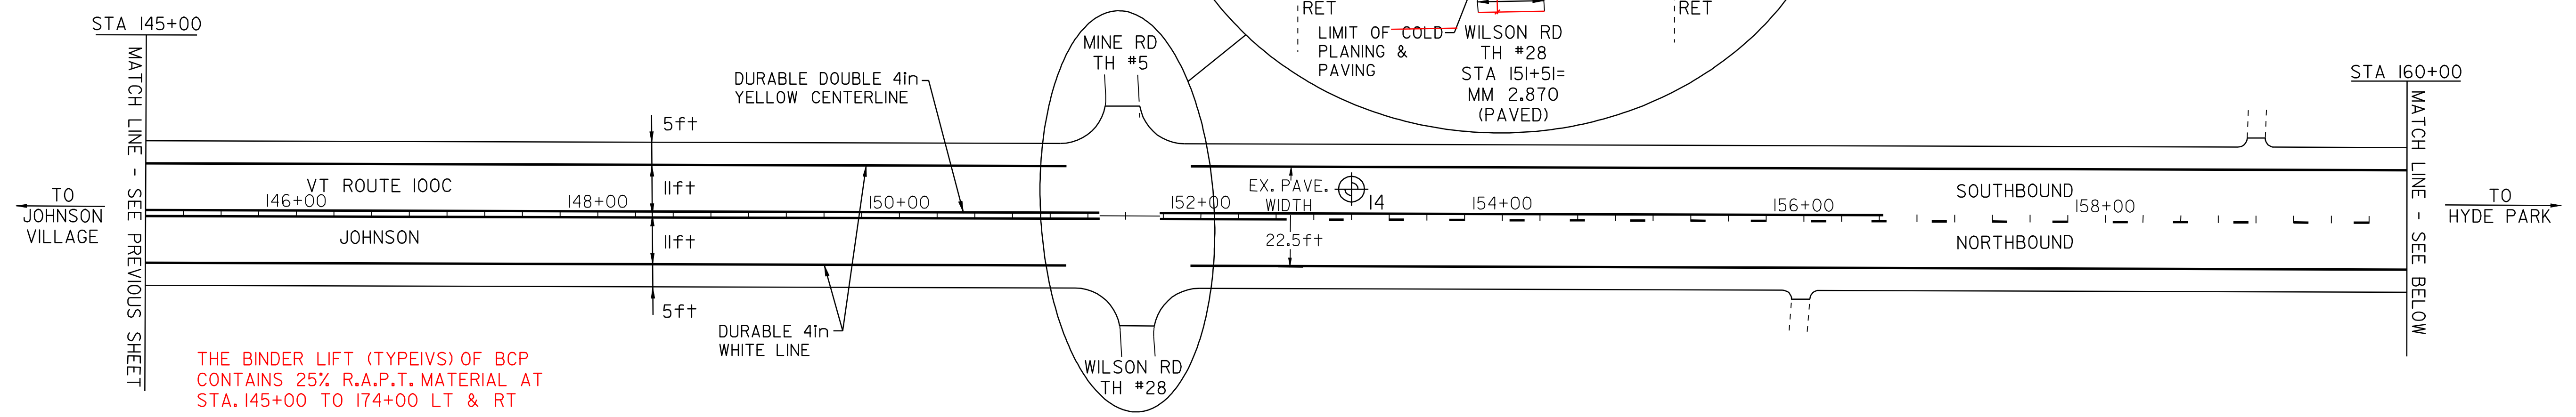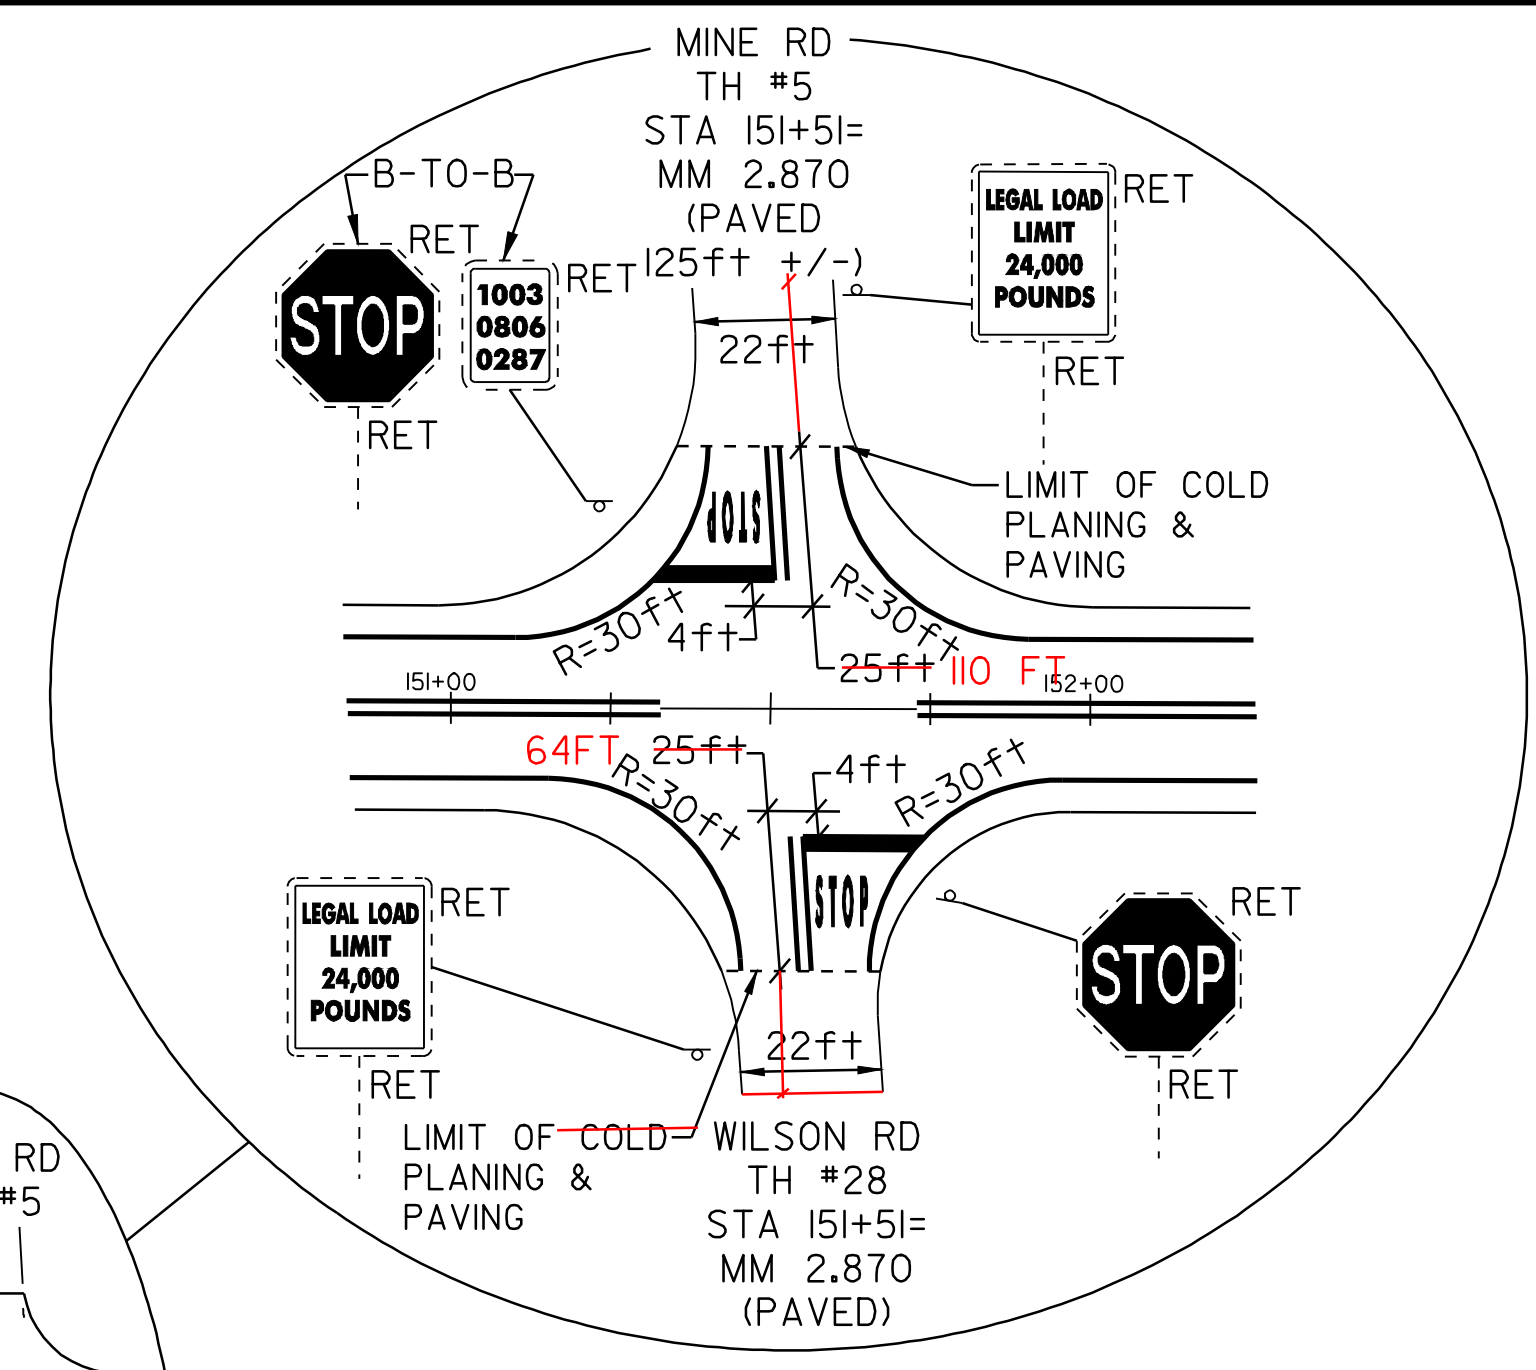

THE BINDER LIFT (TYPE IVS) OF BCP CONTAINS 25% R.A.P.T. MATERIAL AT STA. 145+00 TO 174+00 LT & RT

CURVE #11
 PC = 163+20
 PT = 168+40
 R = 7,700ft
 SEE SHEET 22 FOR SUPERELEVATION DIAGRAM

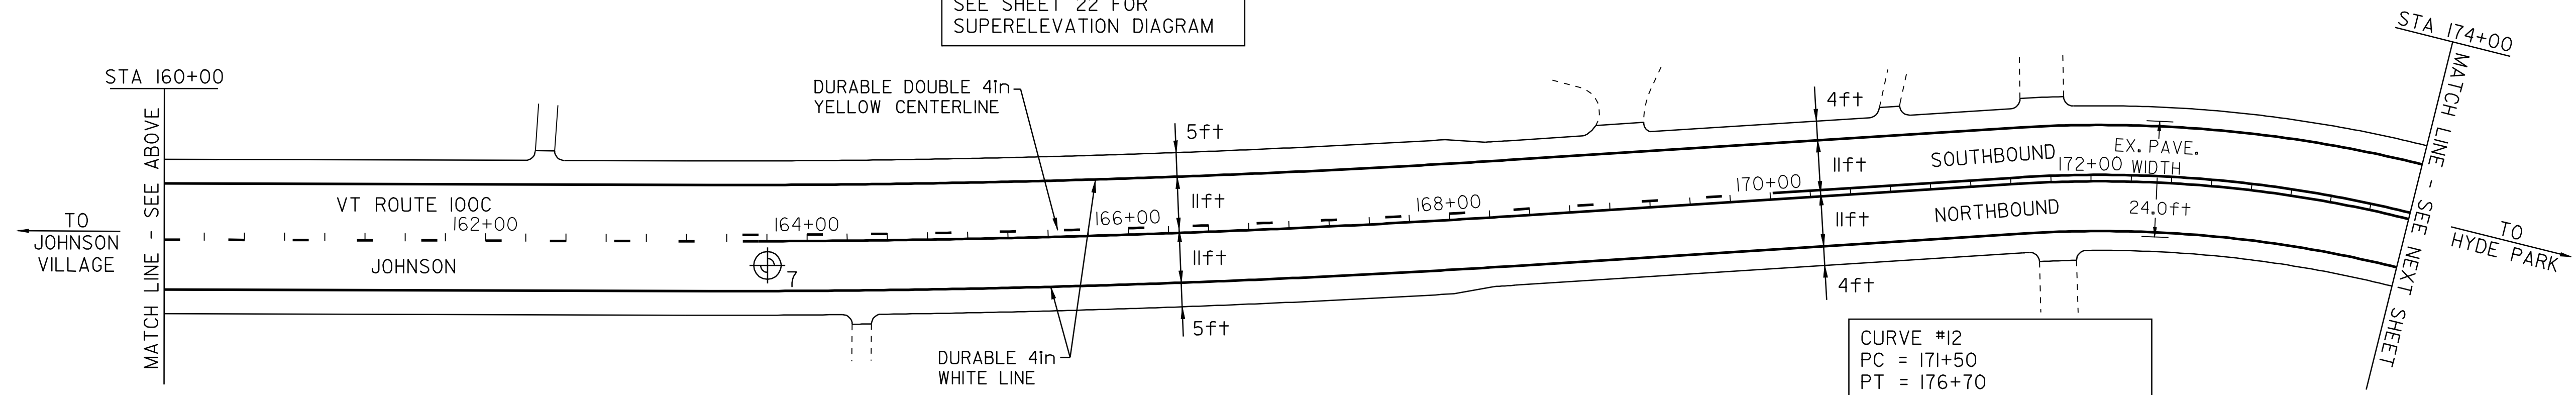

CURVE #12
 PC = 171+50
 PT = 176+70
 R = 800ft
 SEE SHEET 22 FOR SUPERELEVATION DIAGRAM

PAVEMENT CORES - ⊕

#	TOTAL DEPTH (in)	DRAINABLE BASE	SOLID CORE	COMMENTS
14	5.0	NO	NO	--
7	5.25	NO	YES	--

NOTE:
 - NO PCC UNDER ANY CORES
 - NO CORES OVER ASPHALTED
 - NO SHOULDER CORES
 - NO STRIPPED CORES

PAVING PROJECT LAYOUT SHEET #7

DESIGNED BY BCE/PJM DATE 7-07
 DRAWN BY C.E.A., INC. DATE 7-07
 DESIGN FILE NO. p99c182.dgn
 PRF FILE p99c182p107.i DATE PLOTTED 08-JAN-2009
 PROJ. NAME **JOHNSON - HYDE PARK**
 PROJ. NO. **STP 2215(1)S**
 SHEET **16** OF **33** SHEETS


TEMPORARY 4in YELLOW LINE (PAINT)
DURABLE 4in YELLOW LINE (THERMOPLASTIC)
STA I74+00 TO 206+00
SOLID LT&RT
STA I75+03
DOUBLE SOLID LT
(WITH CENTERLINE BREAKS FOR TOWN HIGHWAYS)

TEMPORARY 4in WHITE LINE (PAINT)
DURABLE 4in WHITE LINE (THERMOPLASTIC)
STA I74+00 TO 206+00
SOLID LT&RT
(WITH EDGELINE BREAKS FOR TOWN HIGHWAYS)

TEMPORARY LETTER OR SYMBOL (PAINT)
DURABLE LETTER OR SYMBOL (THERMOPLASTIC)
STA I75+03 LT
"STOP"

TEMPORARY 24in STOP BAR (PAINT)
DURABLE 24in STOP BAR (THERMOPLASTIC)
STA I75+03 LT
OBER HILL RD

RELOCATE MAILBOX, SINGLE SUPPORT
STA I84+20 RT
REMOVE SIGNS
4

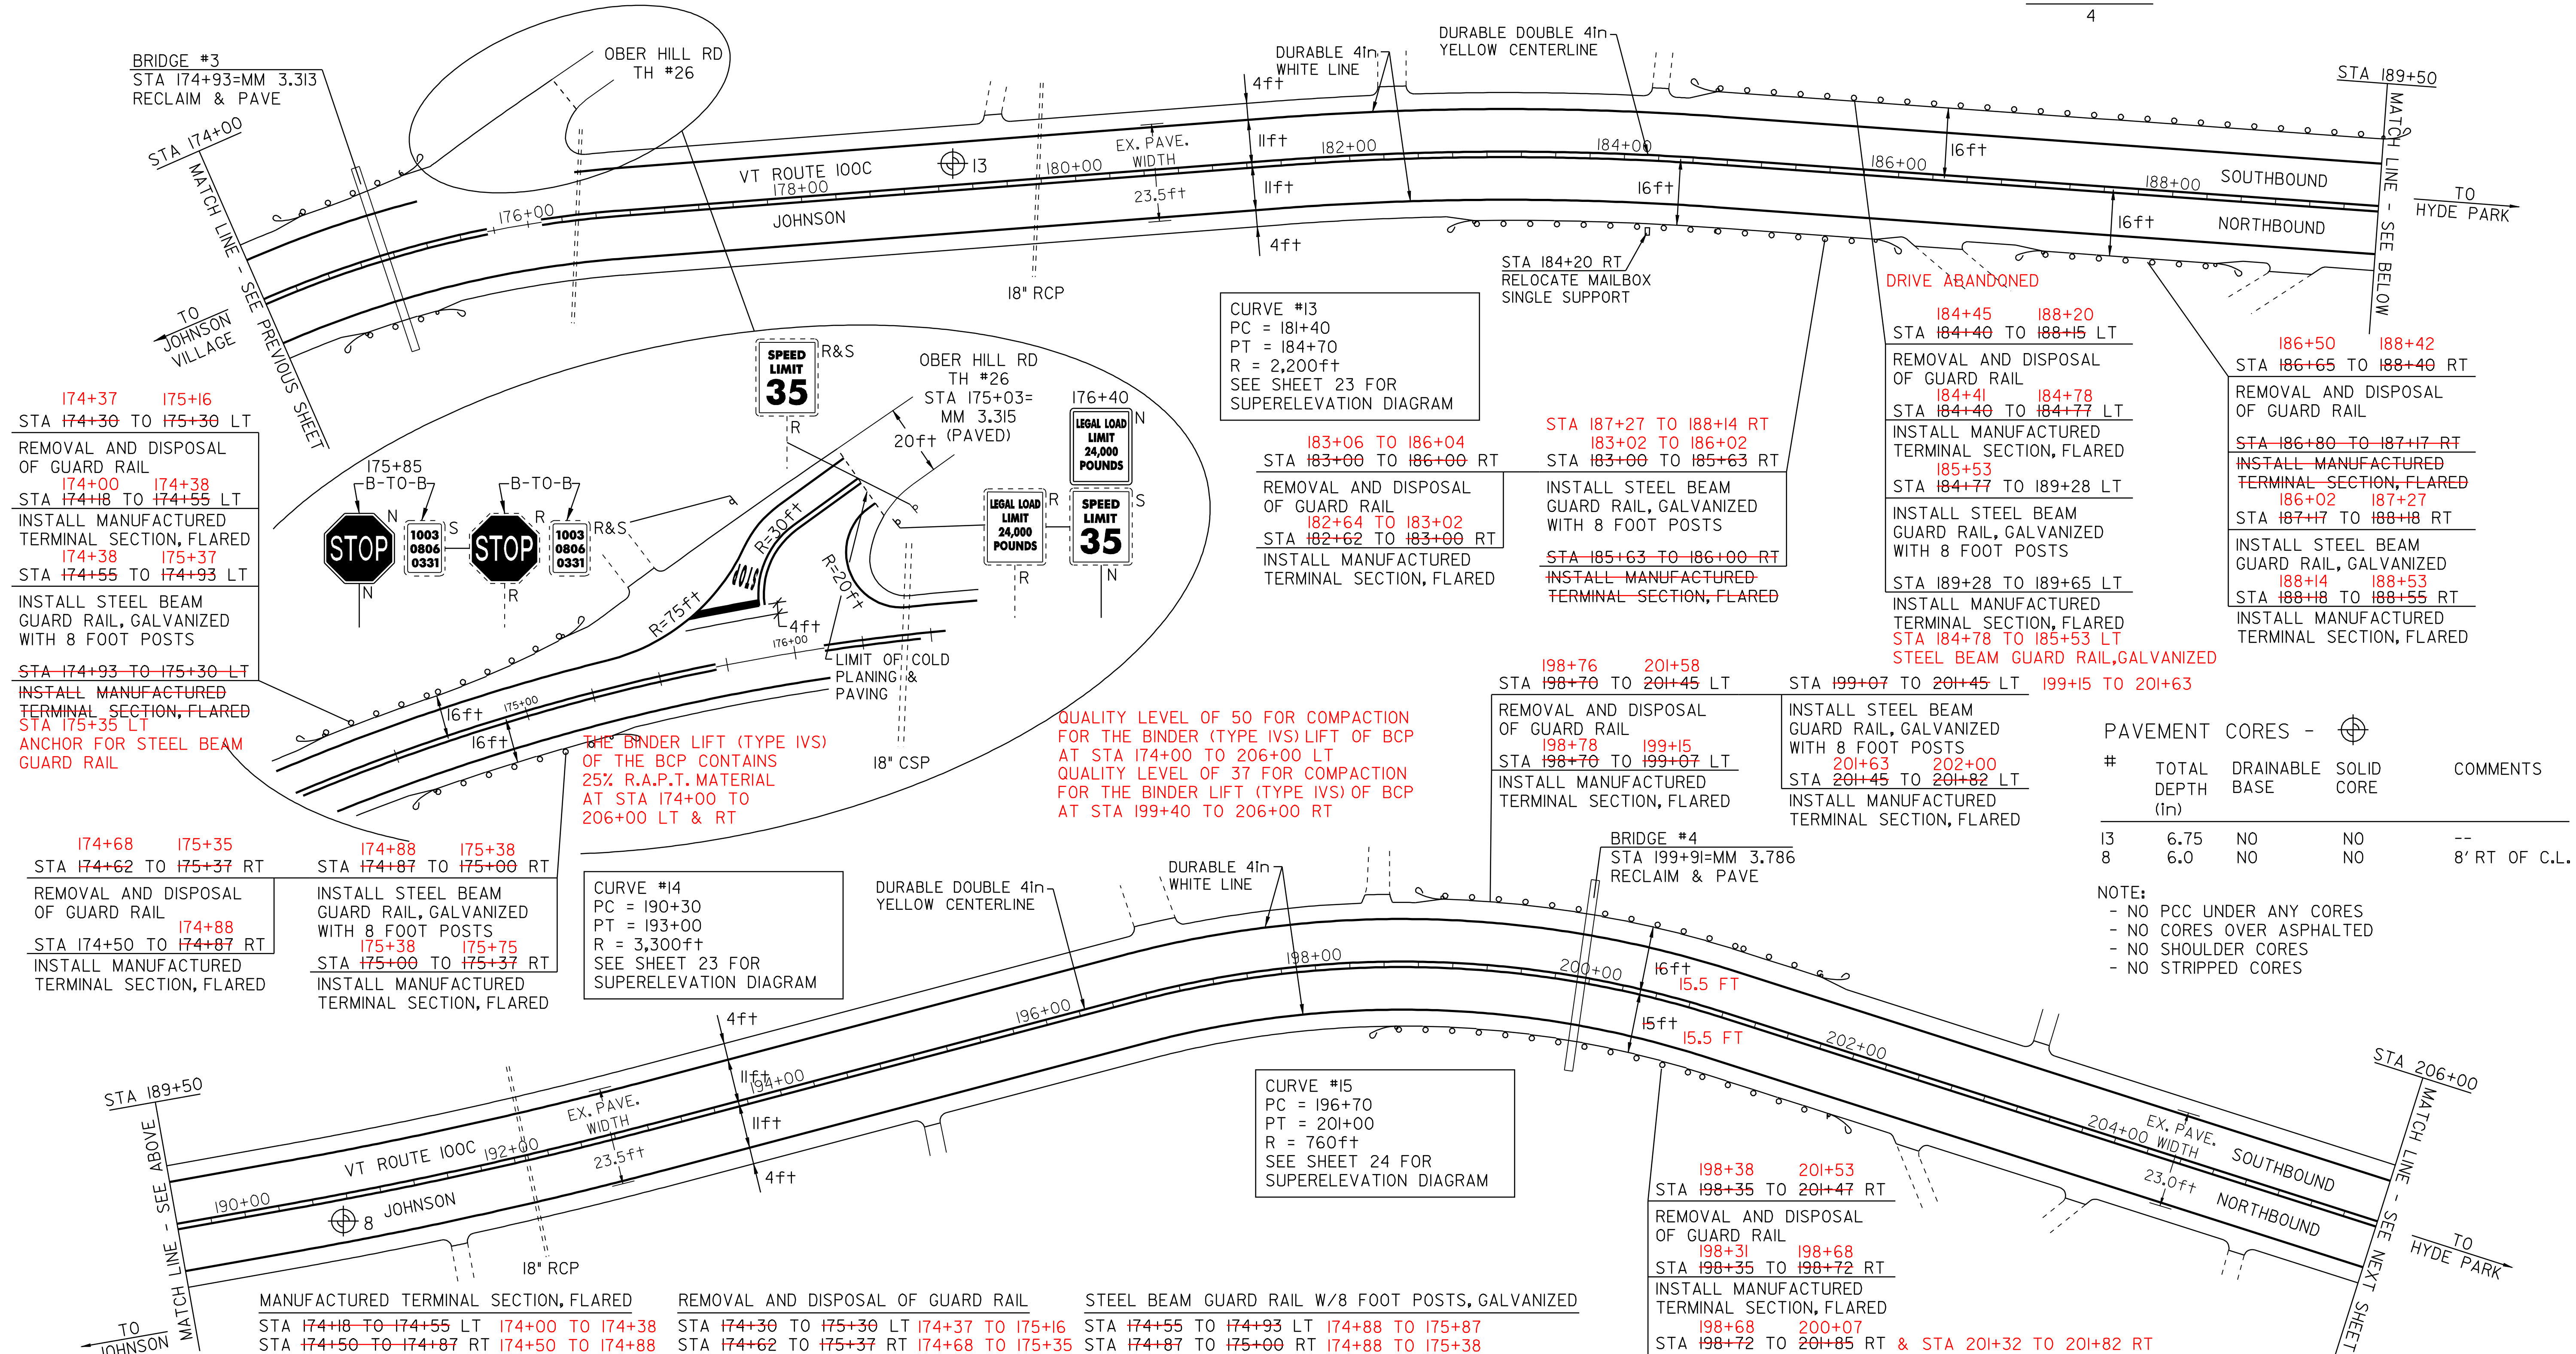

174+37 175+16
STA I74+30 TO I75+30 LT
REMOVAL AND DISPOSAL OF GUARD RAIL
174+00 174+38
STA I74+18 TO I74+55 LT
INSTALL MANUFACTURED TERMINAL SECTION, FLARED
174+38 175+37
STA I74+55 TO I74+93 LT
INSTALL STEEL BEAM GUARD RAIL, GALVANIZED WITH 8 FOOT POSTS
~~STA I74+93 TO I75+30 LT~~
INSTALL MANUFACTURED TERMINAL SECTION, FLARED
STA I75+35 LT
ANCHOR FOR STEEL BEAM GUARD RAIL

174+68 175+35
STA I74+62 TO I75+37 RT
REMOVAL AND DISPOSAL OF GUARD RAIL
174+88
STA I74+50 TO I74+87 RT
INSTALL MANUFACTURED TERMINAL SECTION, FLARED

174+88 175+38
STA I74+87 TO I75+00 RT
INSTALL STEEL BEAM GUARD RAIL, GALVANIZED WITH 8 FOOT POSTS
175+38 175+75
STA I75+00 TO I75+37 RT
INSTALL MANUFACTURED TERMINAL SECTION, FLARED

CURVE #14
PC = 190+30
PT = 193+00
R = 3,300ft
SEE SHEET 23 FOR SUPERELEVATION DIAGRAM

CURVE #13
PC = 181+40
PT = 184+70
R = 2,200ft
SEE SHEET 23 FOR SUPERELEVATION DIAGRAM

183+06 TO 186+04
STA I83+00 TO I86+00 RT
REMOVAL AND DISPOSAL OF GUARD RAIL
182+64 TO 183+02
STA I82+62 TO I83+00 RT
INSTALL MANUFACTURED TERMINAL SECTION, FLARED

187+27 TO 188+14 RT
183+02 TO 186+02
STA I83+00 TO I85+63 RT
INSTALL STEEL BEAM GUARD RAIL, GALVANIZED WITH 8 FOOT POSTS
~~STA I85+63 TO I86+00 RT~~
INSTALL MANUFACTURED TERMINAL SECTION, FLARED

DRIVE ABANDQNE
184+45 188+20
STA I84+40 TO I88+15 LT
REMOVAL AND DISPOSAL OF GUARD RAIL
184+41 184+78
STA I84+40 TO I84+77 LT
INSTALL MANUFACTURED TERMINAL SECTION, FLARED
185+53
STA I84+77 TO I89+28 LT
INSTALL STEEL BEAM GUARD RAIL, GALVANIZED WITH 8 FOOT POSTS
STA I89+28 TO I89+65 LT
INSTALL MANUFACTURED TERMINAL SECTION, FLARED
STA I84+78 TO I85+53 LT
STEEL BEAM GUARD RAIL, GALVANIZED

186+50 188+42
STA I86+65 TO I88+40 RT
REMOVAL AND DISPOSAL OF GUARD RAIL
186+80 TO 187+17 RT
INSTALL MANUFACTURED TERMINAL SECTION, FLARED
186+02 187+27
STA I87+17 TO I88+18 RT
INSTALL STEEL BEAM GUARD RAIL, GALVANIZED
188+14 188+53
STA I88+18 TO I88+55 RT
INSTALL MANUFACTURED TERMINAL SECTION, FLARED

198+76 201+58
STA I98+70 TO 201+45 LT
REMOVAL AND DISPOSAL OF GUARD RAIL
198+78 199+15
STA I98+70 TO I99+07 LT
INSTALL MANUFACTURED TERMINAL SECTION, FLARED

199+07 TO 201+45 LT
199+15 TO 201+63
INSTALL STEEL BEAM GUARD RAIL, GALVANIZED WITH 8 FOOT POSTS
201+63 202+00
STA 201+45 TO 201+82 LT
INSTALL MANUFACTURED TERMINAL SECTION, FLARED

PAVEMENT CORES - ⊕

#	TOTAL DEPTH (in)	DRAINABLE BASE	SOLID CORE	COMMENTS
13	6.75	NO	NO	--
8	6.0	NO	NO	8' RT OF C.L.

NOTE:
- NO PCC UNDER ANY CORES
- NO CORES OVER ASPHALTED
- NO SHOULDER CORES
- NO STRIPPED CORES

CURVE #15
PC = 196+70
PT = 201+00
R = 760ft
SEE SHEET 24 FOR SUPERELEVATION DIAGRAM

198+38 201+53
STA I98+35 TO 201+47 RT
REMOVAL AND DISPOSAL OF GUARD RAIL
198+31 198+68
STA I98+35 TO I98+72 RT
INSTALL MANUFACTURED TERMINAL SECTION, FLARED
198+68 200+07
STA I98+72 TO 201+85 RT & STA 201+32 TO 201+82 RT

INSTALL STEEL BEAM GUARD RAIL, GALVANIZED WITH 8 FOOT POSTS
201+82 202+20
STA 201+85 TO 202+22 RT
INSTALL MANUFACTURED TERMINAL SECTION, FLARED
STA 200+07 TO 201+32 RT
STEEL BEAM GUARD RAIL, GALVANIZED

MANUFACTURED TERMINAL SECTION, FLARED
STA I74+18 TO I74+55 LT I74+00 TO I74+38
STA I74+50 TO I74+87 RT I74+50 TO I74+88
STA I74+93 TO I75+30 LT
STA I75+00 TO I75+37 RT I75+38 TO I75+75
STA I82+62 TO I83+00 RT I82+64 TO I83+02
STA I84+40 TO I84+77 LT I88+41 TO I84+78
STA I85+63 TO I86+00 RT
STA I86+80 TO I87+17 RT
STA I88+18 TO I88+55 RT I88+14 TO I88+53
STA I89+28 TO I89+65 LT
STA I98+35 TO I98+72 RT I98+31 TO I98+68
STA I98+70 TO I99+07 LT I98+78 TO I99+15
STA 201+45 TO 201+82 LT 201+63 TO 202+00
STA 201+85 TO 202+22 RT 201+82 TO 202+20

REMOVAL AND DISPOSAL OF GUARD RAIL
STA I74+30 TO I75+30 LT I74+37 TO I75+16
STA I74+62 TO I75+37 RT I74+68 TO I75+35
STA I83+00 TO I86+00 RT I83+06 TO I86+04
STA I84+40 TO I88+15 LT I84+45 TO I88+20
STA I86+65 TO I88+40 RT I86+50 TO I88+42
STA I98+35 TO 201+47 RT I98+38 TO 201+53
STA I98+70 TO 201+45 LT I98+76 TO 201+58
ANCHOR FOR STEEL BEAM GUARD RAIL
STA I75+85 LT


STEEL BEAM GUARD RAIL W/8 FOOT POSTS, GALVANIZED
STA I74+55 TO I74+93 LT I74+88 TO I75+87
STA I74+87 TO I75+00 RT I74+88 TO I75+38
STA I83+00 TO I85+63 RT I83+02 TO I86+02
STA I84+77 TO I89+28 LT I85+53 TO I89+28
STA I98+72 TO 201+85 RT I98+68 TO 200+07
STA I99+07 TO 201+45 LT I99+15 TO 201+63
STA I87+27 TO I88+14 RT STA 201+32 TO 201+82 RT
STEEL BEAM GUARD RAIL, GALVANIZED
STA I87+17 TO I88+18 RT I86+02 TO I87+27
STA I84+78 TO I85+53 LT
STA 200+07 TO 201+32 RT

PAVING PROJECT LAYOUT SHEET #8

DESIGNED BY BCE/PJM DATE 7-07
 DRAWN BY C.E.A., INC. DATE 7-07
 DESIGN FILE NO. p99c182.dgn
 PRF FILE p99c182pl08.i DATE PLOTTED 08-JAN-2009
 PROJ. NAME **JOHNSON - HYDE PARK**
 PROJ. NO. **STP 2215(1)S**
 SHEET **17** OF **33** SHEETS

TEMPORARY 4in YELLOW LINE (PAINT)
 DURABLE 4in YELLOW LINE (THERMOPLASTIC)
 STA 206+00 TO 232+00 SOLID LT&RT

TEMPORARY 4in WHITE LINE (PAINT)
 DURABLE 4in WHITE LINE (THERMOPLASTIC)
 STA 206+00 TO 232+00 SOLID LT&RT

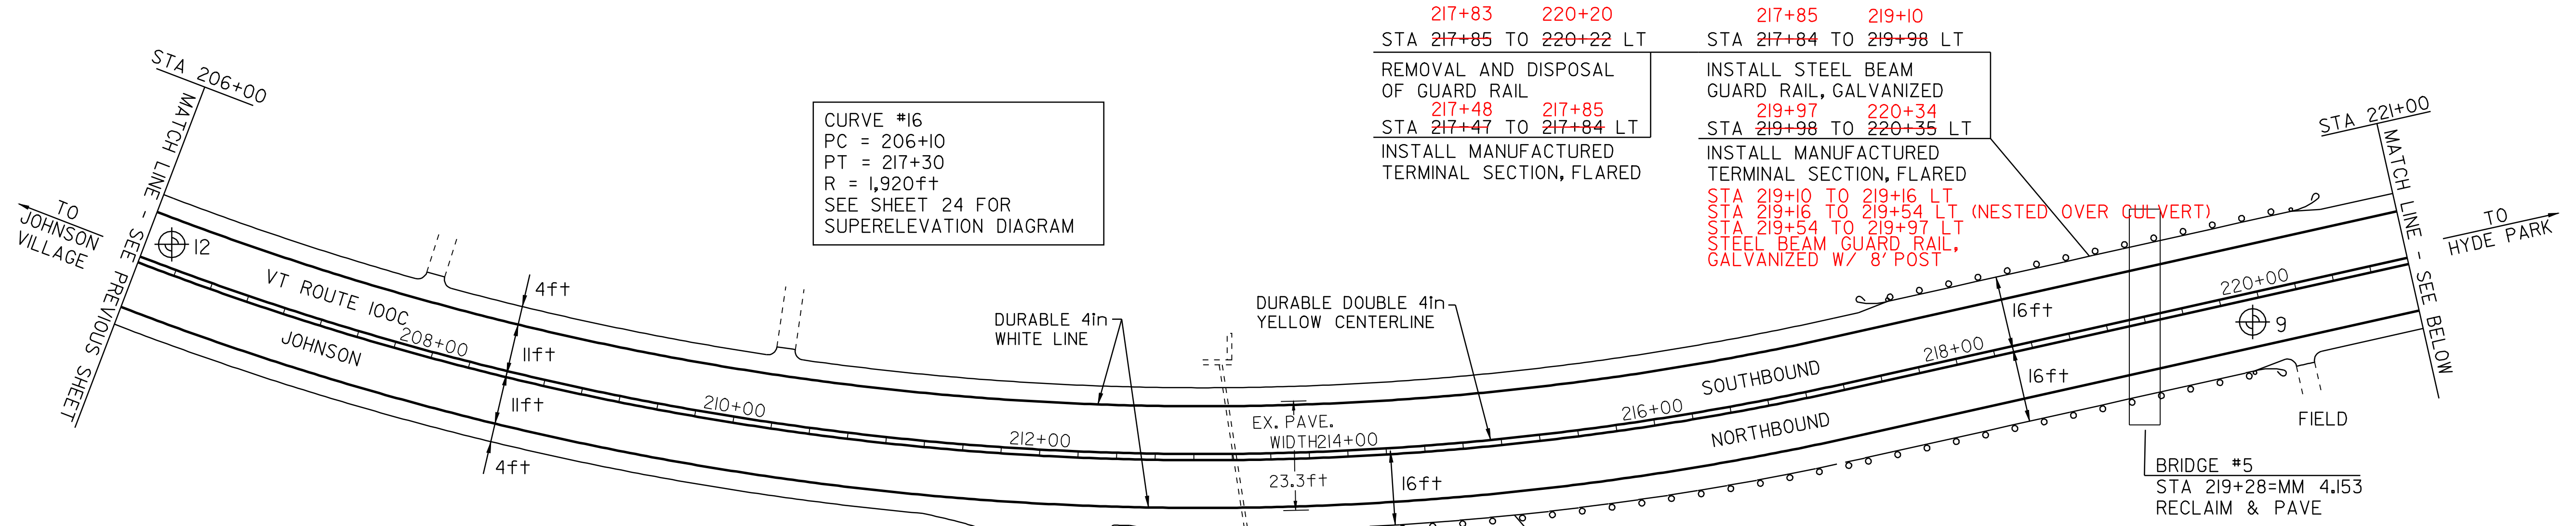

CURVE #16
 PC = 206+10
 PT = 217+30
 R = 1,920ft
 SEE SHEET 24 FOR
 SUPERELEVATION DIAGRAM

217+83 220+20
 STA 217+85 TO 220+22 LT
 REMOVAL AND DISPOSAL
 OF GUARD RAIL
 STA 217+47 TO 217+84 LT
 INSTALL MANUFACTURED
 TERMINAL SECTION, FLARED

217+85 219+10
 STA 217+84 TO 219+98 LT
 INSTALL STEEL BEAM
 GUARD RAIL, GALVANIZED
 STA 219+97 TO 220+34
 STA 219+98 TO 220+35 LT
 INSTALL MANUFACTURED
 TERMINAL SECTION, FLARED

STA 219+10 TO 219+16 LT
 STA 219+16 TO 219+54 LT (NESTED OVER CULVERT)
 STA 219+54 TO 219+97 LT
 STEEL BEAM GUARD RAIL,
 GALVANIZED W/ 8' POST

PAVEMENT CORES -

#	TOTAL DEPTH (in)	DRAINABLE BASE	SOLID CORE	COMMENTS
12	6.0	NO	NO	LOT OF PATCHING
9	5.0	NO	YES	CULVERT
11	5.0	NO	NO	ROSE WOOD LN.

NOTE:
 - NO PCC UNDER ANY CORES
 - NO CORES OVER ASPHALTED
 - NO SHOULDER CORES
 - NO STRIPPED CORES

QUALITY LEVEL OF 50 FOR COMPACTION OF THE BINDER LIFT (TYPE IVS) OF BCP AT STA 206+00 TO 232+00 LT

QUALITY LEVEL OF 37 FOR COMPACTION OF THE BINDER LIFT (TYPE IVS) OF BCP AT STA 206+00 TO 232+00 RT

THE BINDER LIFT (TYPE IVS) OF THE BCP CONTAINS 25% R.A.P.T. MATERIAL AT STA 206+00 TO 232+00 RT & LT

THE WEARING LIFT (TYPE IVS) OF BCP CONTAINS 25% R.A.P.T. MATERIAL AT STA 220+18 TO 232+00 LT

213+59 219+82
 STA 213+55 TO 219+80 RT

REMOVAL AND DISPOSAL OF GUARD RAIL

STA 212+67 TO 213+04 RT
 INSTALL MANUFACTURED TERMINAL SECTION, FLARED

STA 213+04 TO 213+54 RT
 STA 217+89 TO 219+04 RT
 STA 219+04 TO 219+41 RT (NESTED OVER CULVERT)
 STA 219+41 TO 219+54 RT
 STEEL BEAM GUARD RAIL GALVANIZED W/ 8' POSTS

213+54 217+89
 STA 213+04 TO 219+55 RT

INSTALL STEEL BEAM GUARD RAIL, GALVANIZED

STA 219+55 TO 219+92 RT
 INSTALL MANUFACTURED TERMINAL SECTION, FLARED

REMOVAL AND DISPOSAL OF GUARD RAIL

STA 213+55 TO 219+80 RT 213+59 TO 219+82
 STA 217+85 TO 220+22 LT 217+83 TO 220+20
 STA 223+10 TO 226+47 RT 223+15 TO 226+45

STEEL BEAM GUARD RAIL, GALVANIZED


STA 213+04 TO 219+55 RT 213+54 TO 217+89
 STA 217+84 TO 219+98 LT 217+85 TO 219+10
 STA 223+47 TO 226+85 RT 223+52 TO 225+27

MANUFACTURED TERMINAL SECTION, FLARED

STA 212+67 TO 213+04 RT
 STA 217+47 TO 217+84 LT 217+48 TO 217+85
 STA 219+55 TO 219+92 RT 219+54 TO 219+91
 STA 219+98 TO 220+35 LT 219+97 TO 220+34
 STA 223+10 TO 223+47 RT 223+15 TO 223+52
 STA 226+85 TO 227+22 RT 226+90 TO 227+27

STEEL BEAM GUARD RAIL, GALVANIZED W/ 8' POSTS

STA 219+10 TO 219+16 LT
 STA 219+16 TO 219+54 LT (NESTED OVER CULVERT)
 STA 219+54 TO 219+97 LT
 STA 213+04 TO 213+54 RT
 STA 217+89 TO 219+04 RT
 STA 219+04 TO 219+41 RT (NESTED OVER CULVERT)
 STA 219+41 TO 219+54 RT
 STA 225+27 TO 226+90 RT

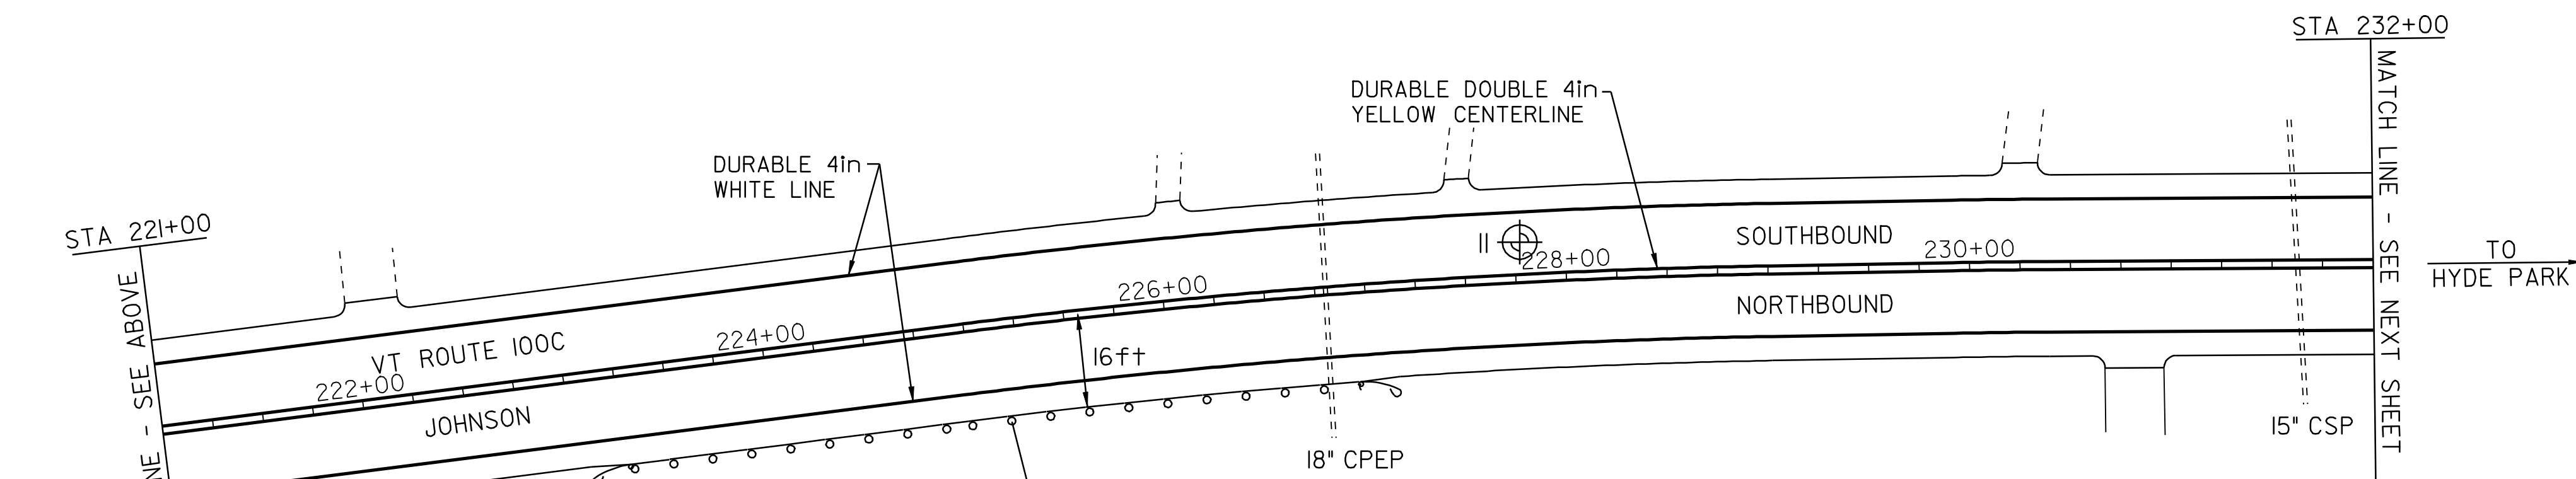

CURVE #17
 PC = 225+00
 PT = 229+00
 R = 3,700ft
 SEE SHEET 25 FOR
 SUPERELEVATION DIAGRAM

CURVE #18
 PC = 229+90
 PT = 230+40
 R = 4,300ft
 SEE SHEET 25 FOR
 SUPERELEVATION DIAGRAM

223+15 226+45
 STA 223+10 TO 226+47 RT

REMOVAL AND DISPOSAL OF GUARD RAIL

STA 223+10 TO 223+47 RT
 INSTALL MANUFACTURED TERMINAL SECTION, FLARED

223+52 225+27
 STA 223+47 TO 226+85 RT

INSTALL STEEL BEAM GUARD RAIL, GALVANIZED

STA 226+85 TO 227+22 RT
 INSTALL MANUFACTURED TERMINAL SECTION, FLARED

STA 225+27 TO 226+90 RT
 STEEL BEAM GUARD RAIL GALVANIZED W/ 8 FOOT POSTS

PAVING PROJECT LAYOUT SHEET #9

DESIGNED BY	BCE/PJM	DATE	7-07
DRAWN BY	C.E.A., INC.	DATE	7-07
DESIGN FILE NO.	p99cl82.dgn		
PRF FILE	p99cl82pl09.i	DATE PLOTTED	08-JAN-2009
PROJ. NAME	JOHNSON - HYDE PARK		
PROJ. NO.	STP 2215(1)S		
SHEET	18	OF	33 SHEETS

TEMPORARY 4in YELLOW LINE (PAINT)
DURABLE 4in YELLOW LINE (THERMOPLASTIC)

TOWN OF JOHNSON
STA 232+00 TO 238+02
TOWN OF HYDE PARK
0+00 TO 4+05
(WITH CENTERLINE BREAKS FOR TOWN HIGHWAYS)

SOLID LT&RT
SOLID LT&RT

TEMPORARY 4in WHITE LINE (PAINT)
DURABLE 4in WHITE LINE (THERMOPLASTIC)

TOWN OF JOHNSON
STA 232+00 TO 238+02
TOWN OF HYDE PARK
0+00 TO 4+05
(WITH EDGELINE BREAKS FOR TOWN HIGHWAYS)

SOLID LT&RT
SOLID LT&RT

TEMPORARY LETTER OR SYMBOL (PAINT)
DURABLE LETTER OR SYMBOL (THERMOPLASTIC)

TOWN OF JOHNSON
STA 233+70 RT
TOWN OF HYDE PARK
STA 3+90 RT
4+00

"STOP AHEAD"
2 - "STOP"

REHABILITATION OF D.I.'S, C.B.'S, OR M.H.'S

TOWN OF JOHNSON
STA 237+00 LT
STA 238+00 LT
TOWN OF HYDE PARK
STA 3+43 RT
3+90

TEMPORARY 24in STOP BAR (PAINT)
DURABLE 24in STOP BAR (THERMOPLASTIC)

TOWN OF HYDE PARK
STA 4+05 RT
4+25


VT ROUTE 100C/100
INTERSECTION

REMOVE SIGNS
3

QUALITY LEVEL OF 50 FOR COMPACTION
OF THE BINDER LIFT (TYPE IVS) OF BCP
AT STA 232+00 TO 2+8 RT

QUALITY LEVEL OF 37 FOR COMPACTION
OF THE BINDER LIFT (TYPE IVS) OF BCP
AT STA 232+00 TO 2+8 RT

THE BINDER LIFT (TYPE IVS) OF THE BCP
CONTAINS 25% R.A.P.T. MATERIAL AT
STA 232+00 TO 2+8 RT & LT

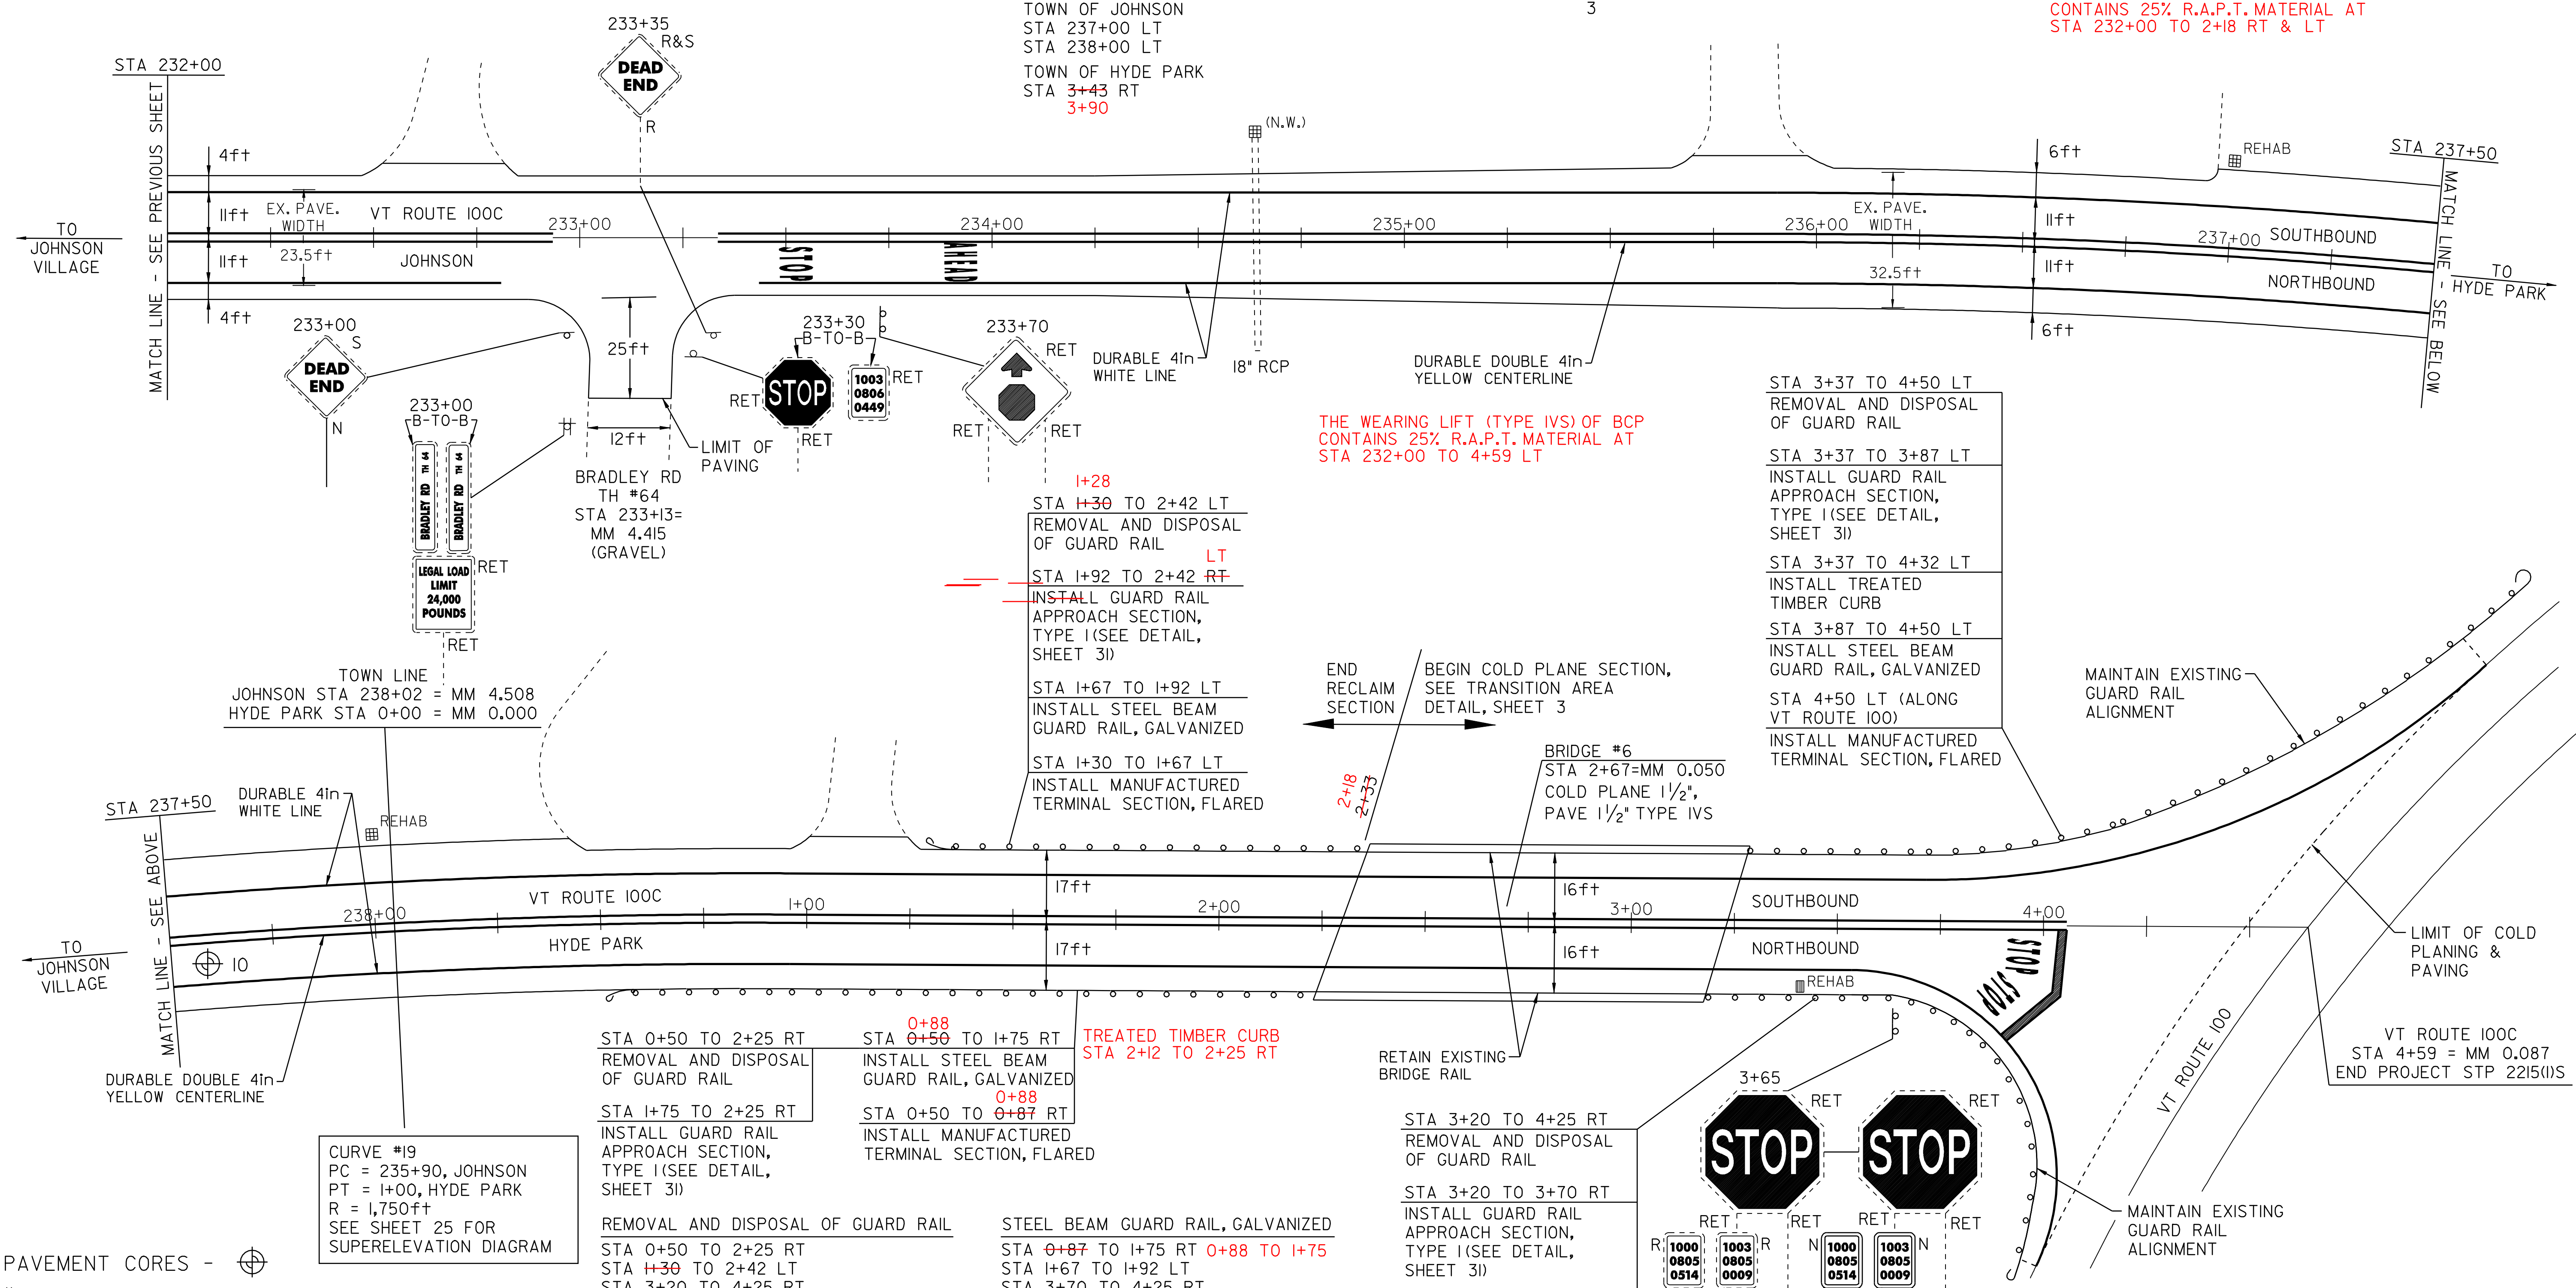

PAVEMENT CORES -

#	TOTAL DEPTH (in)	DRAINABLE BASE	SOLID CORE	COMMENTS
10	5.5	YES	YES	BRIDGE RECONSTRUCT TYPICAL

NOTE:
- NO PCC UNDER ANY CORES
- NO CORES OVER ASPHALTED
- NO SHOULDER CORES
- NO STRIPPED CORES

STA 0+50 TO 2+25 RT
REMOVAL AND DISPOSAL OF GUARD RAIL

STA 1+75 TO 2+25 RT
INSTALL GUARD RAIL APPROACH SECTION, TYPE I (SEE DETAIL, SHEET 3I)

REMOVAL AND DISPOSAL OF GUARD RAIL

STA 0+50 TO 2+25 RT
STA 1+30 TO 2+42 LT
STA 3+20 TO 4+25 RT
STA 3+37 TO 4+50 LT

GUARD RAIL APPROACH SECTION, TYPE I

STA 1+75 TO 2+25 RT
STA 1+92 TO 2+42 LT
STA 3+20 TO 3+70 RT
STA 3+37 TO 3+87 LT

TREATED TIMBER CURB

STA 3+20 TO 3+45 RT
STA 3+37 TO 4+32 LT
STA 2+12 TO 2+25 RT

STA 0+50 TO 1+75 RT
INSTALL STEEL BEAM GUARD RAIL, GALVANIZED

STA 0+50 TO 0+87 RT
INSTALL MANUFACTURED TERMINAL SECTION, FLARED

STEEL BEAM GUARD RAIL, GALVANIZED

STA 0+87 TO 1+75 RT
STA 1+67 TO 1+92 LT
STA 3+70 TO 4+25 RT
STA 3+87 TO 4+50 LT

MANUFACTURED TERMINAL SECTION, FLARED

STA 0+50 TO 0+87 RT
STA 1+30 TO 1+67 LT
STA 4+25 RT (ALONG VT ROUTE 100)
STA 4+50 LT (ALONG VT ROUTE 100)

STA 3+20 TO 4+25 RT
REMOVAL AND DISPOSAL OF GUARD RAIL

STA 3+20 TO 3+70 RT
INSTALL GUARD RAIL APPROACH SECTION, TYPE I (SEE DETAIL, SHEET 3I)

STA 3+20 TO 3+45 RT
INSTALL TREATED TIMBER CURB

STA 3+70 TO 4+25 RT
INSTALL STEEL BEAM GUARD RAIL, GALVANIZED

STA 4+25 RT (ALONG VT ROUTE 100)
INSTALL MANUFACTURED TERMINAL SECTION, FLARED

PAVING PROJECT LAYOUT SHEET #10

DESIGNED BY BCE/PJM DATE 7-07

DRAWN BY C.E.A., INC. DATE 7-07




DESIGN FILE NO. p99c182.dgn

PRF FILE p99c182pl10.i DATE PLOTTED 08-JAN-2009

PROJ. NAME **JOHNSON-HYDE PARK**

PROJ. NO. **STP 2215(1)S**


SHEET **19** OF **33** SHEETS

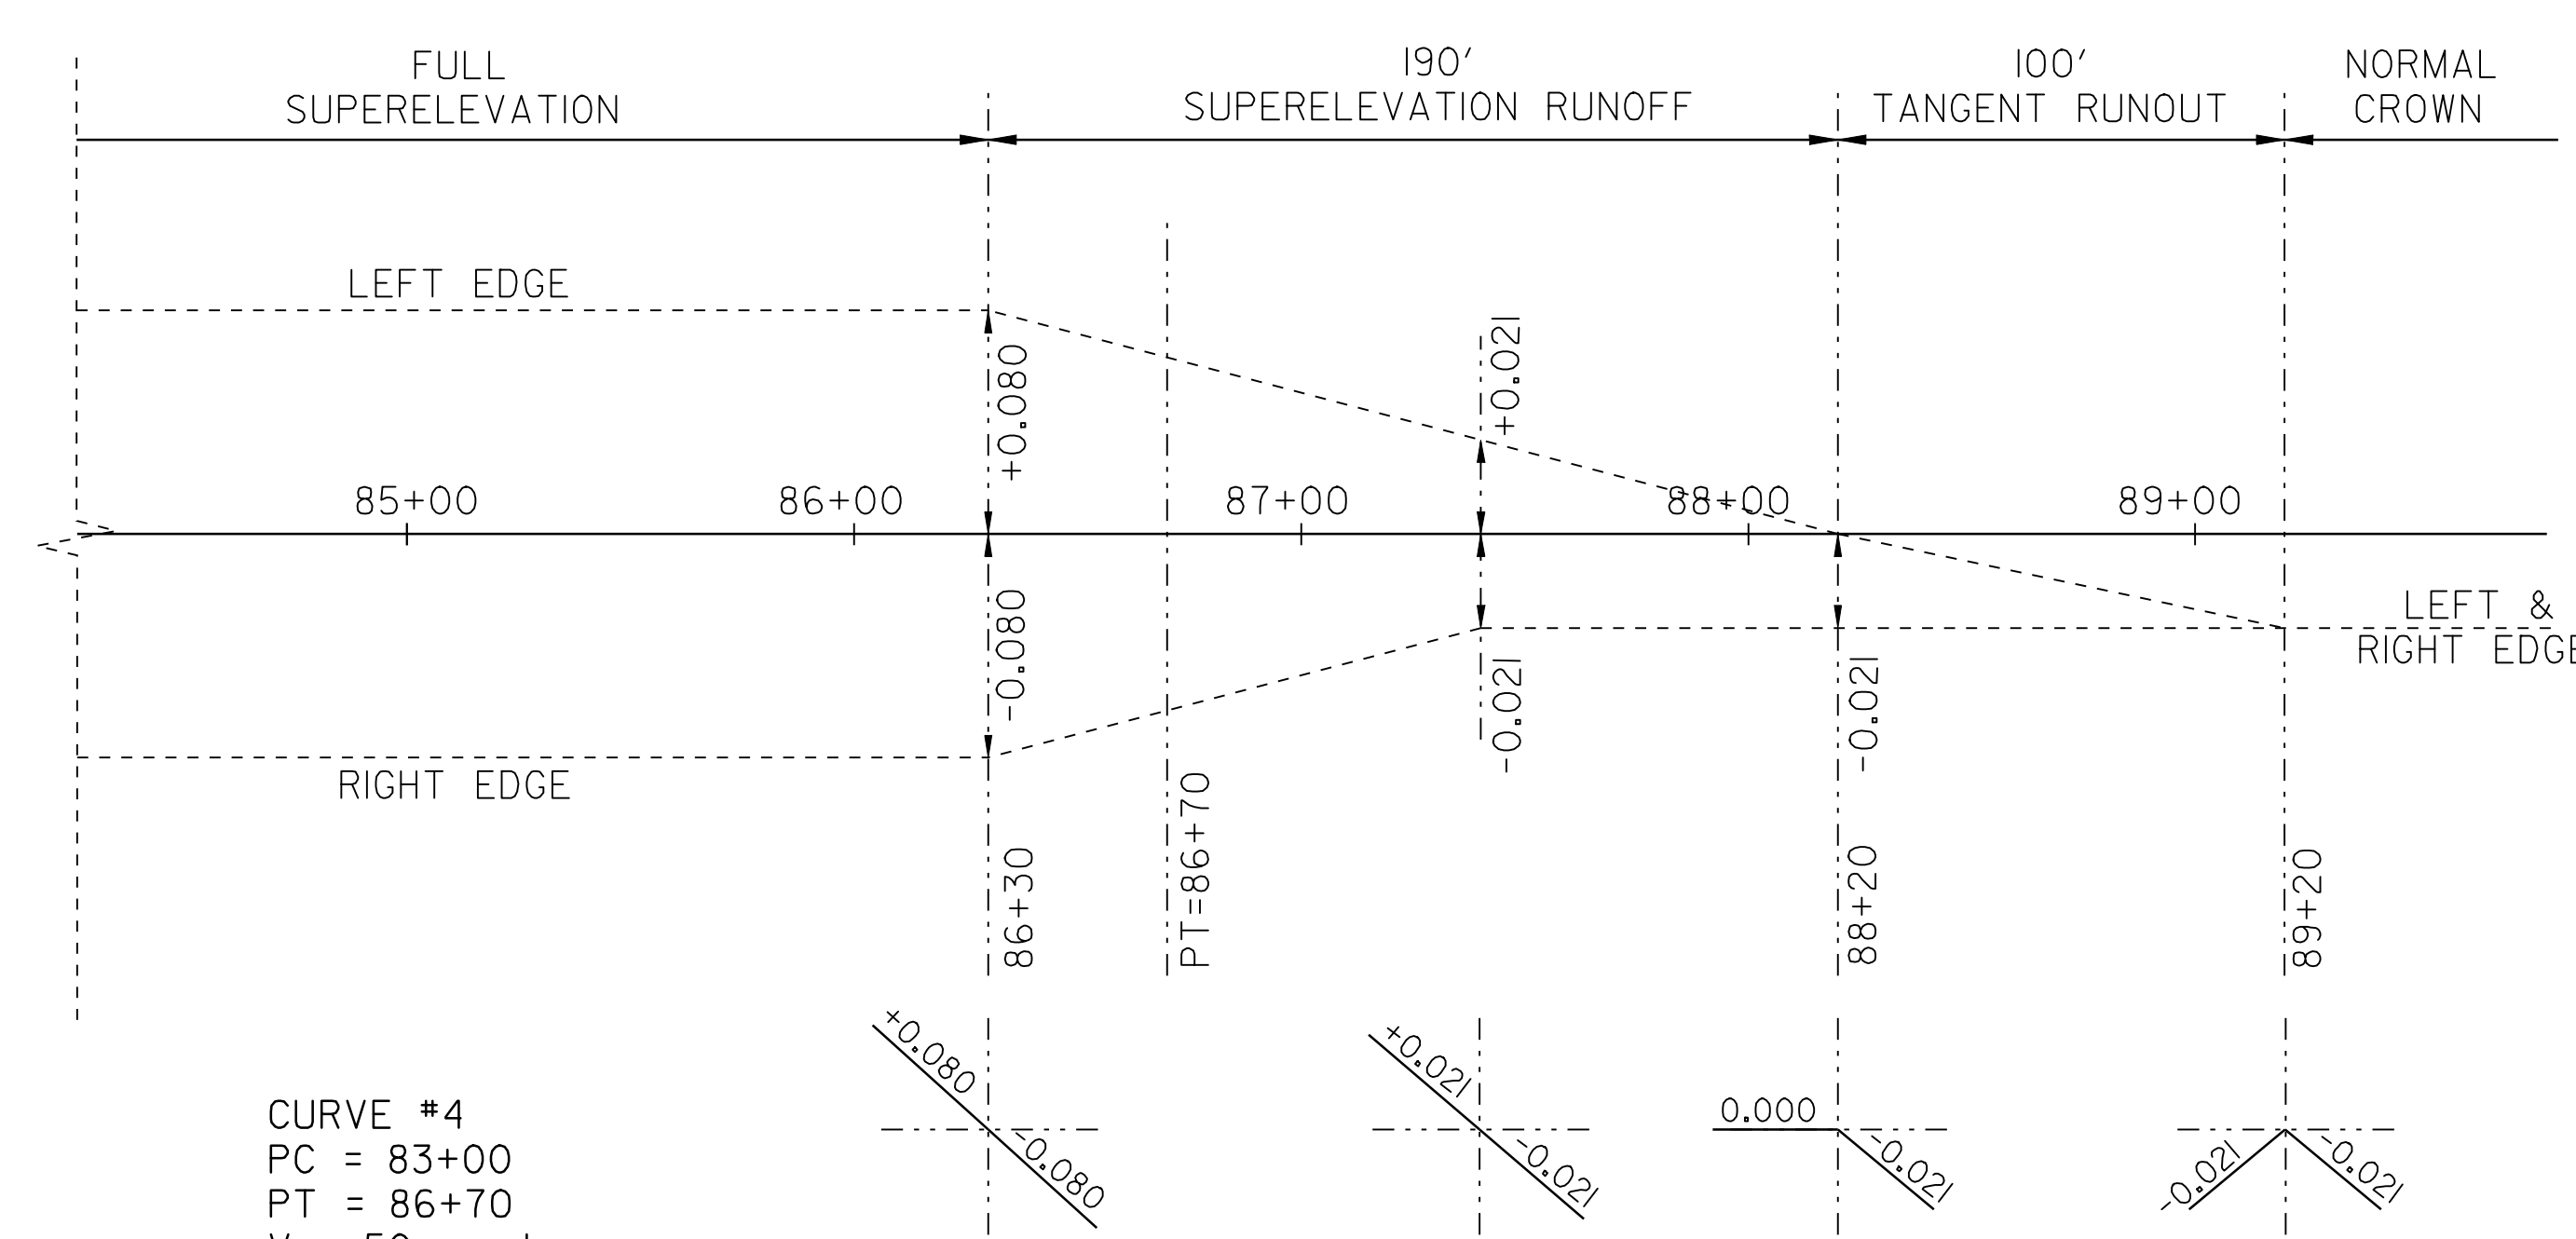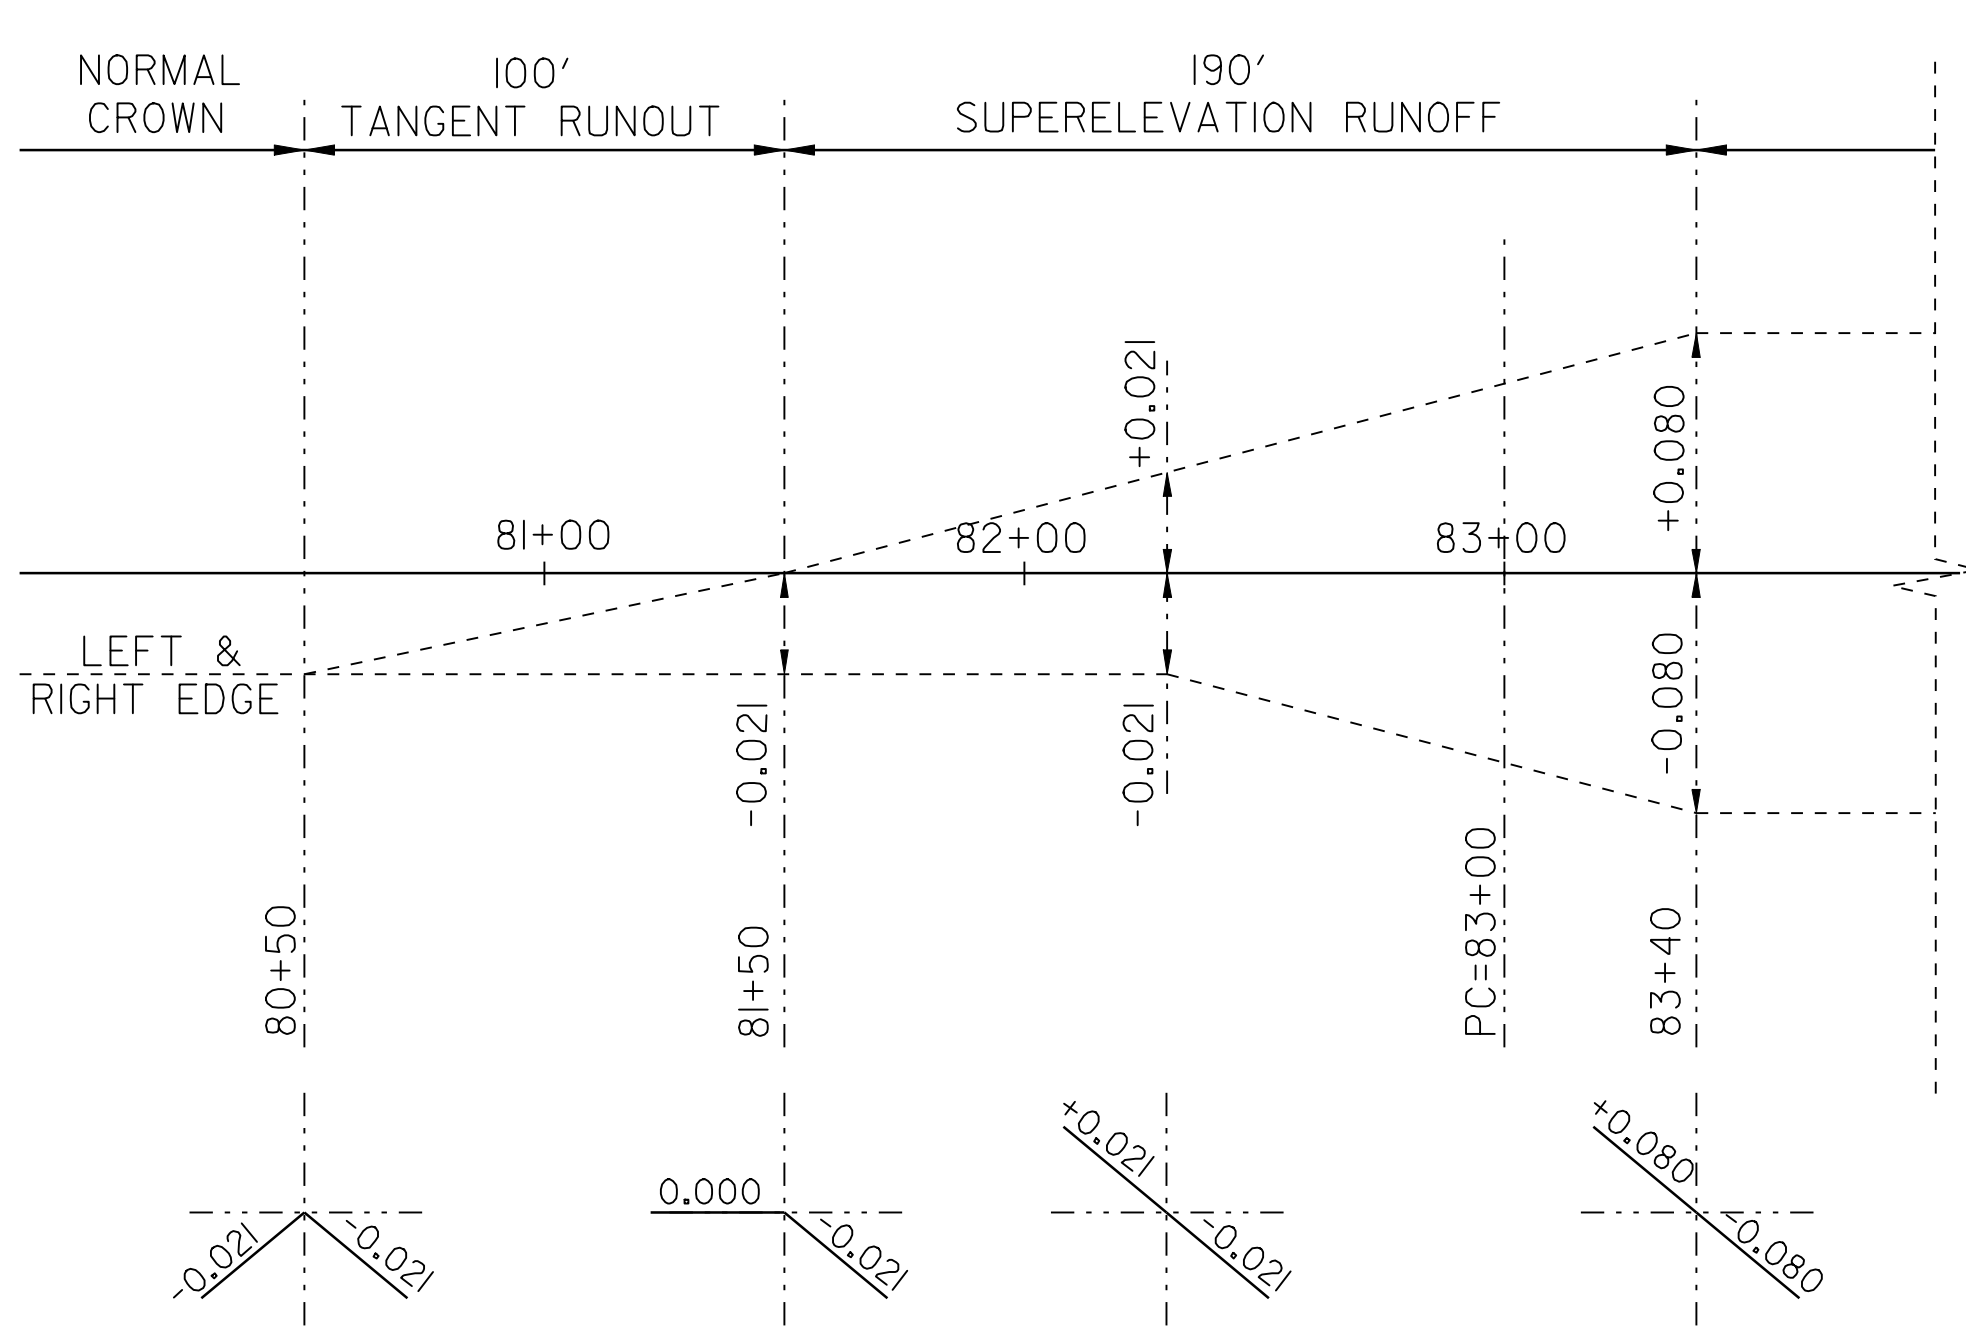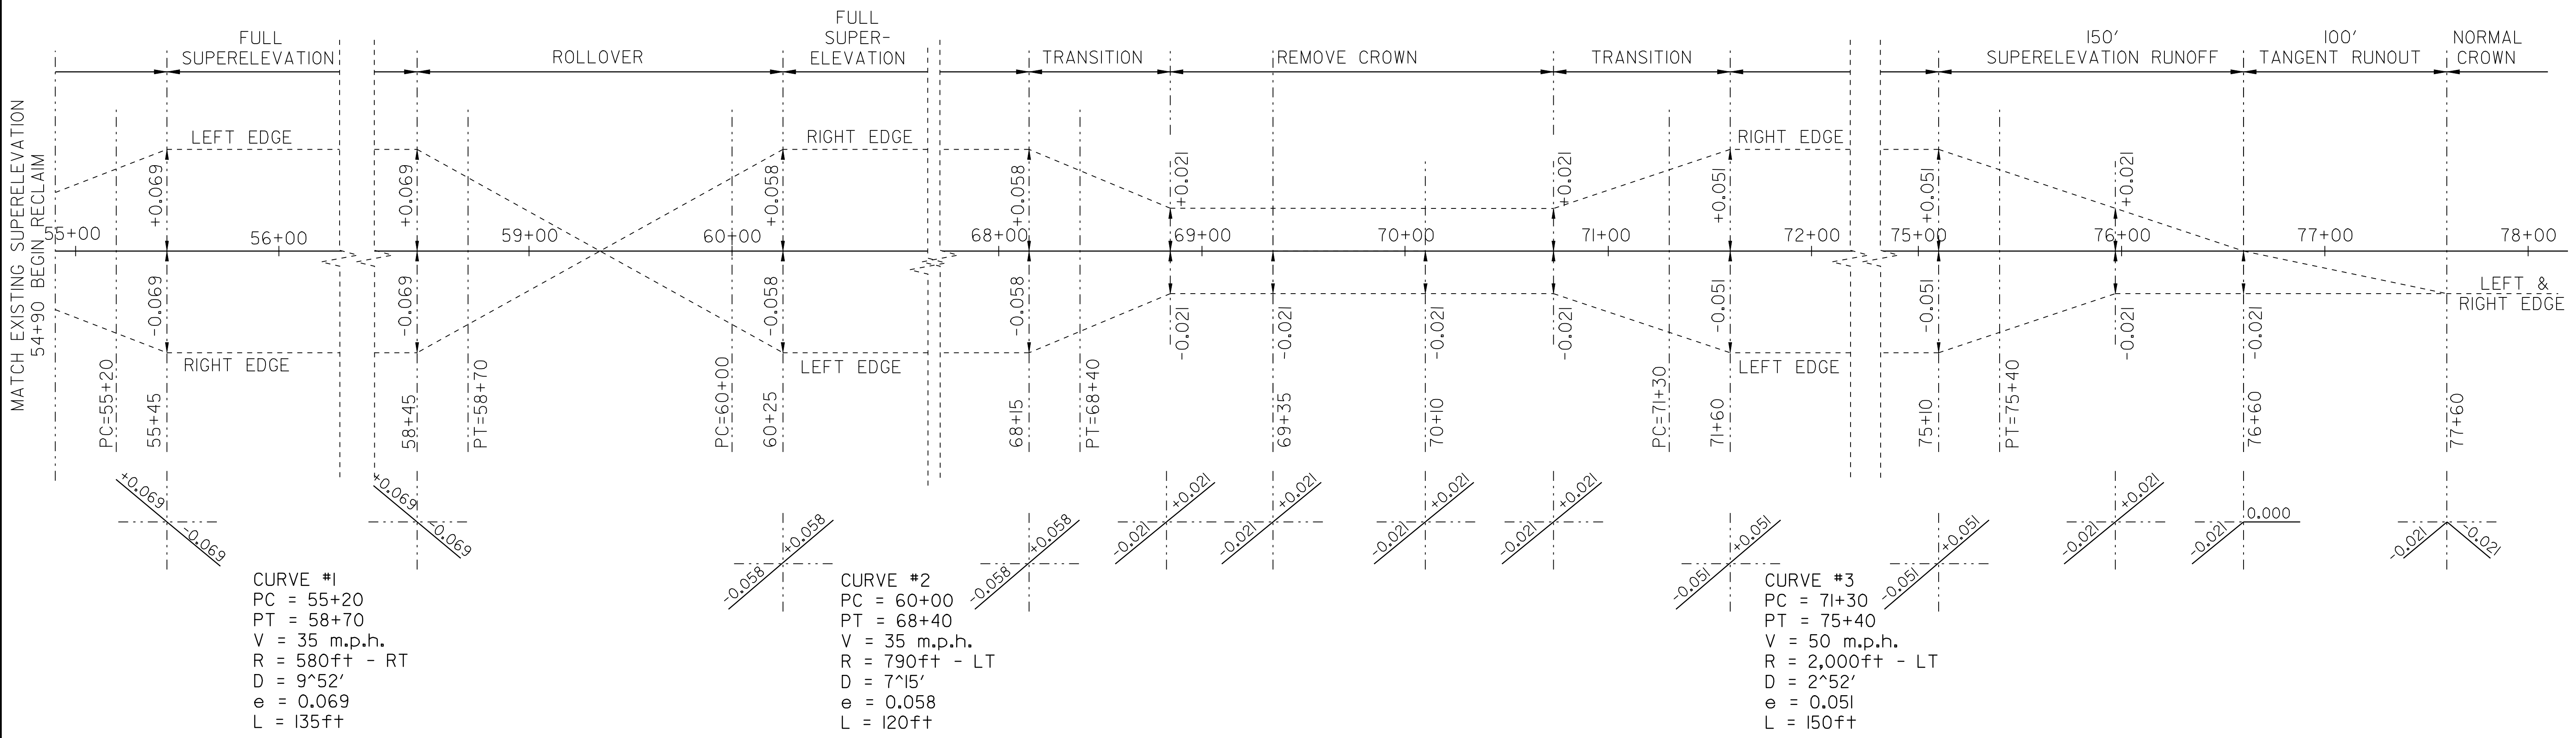


CURVE #4
PC = 83+00
PT = 86+70
V = 50 m.p.h.
R = 500ft - RT
D = 11°27'
e = 0.080
L = 190

SUPERELEVATION BANKING DIAGRAM SHEET #1

DESIGNED BY BCE/PJM DATE 6-07
 DRAWN BY C.E.A., INC. DATE 6-07
 DESIGN FILE NO. p99cl82.dgn
 PRF FILE p99cl82sbd.l DATE PLOTTED 08-JAN-2009 08
 PROJ. NAME **JOHNSON - HYDE PARK**
 PROJ. NO. **STP 2215(1)S**
 SHEET **20** OF **33** SHEETS

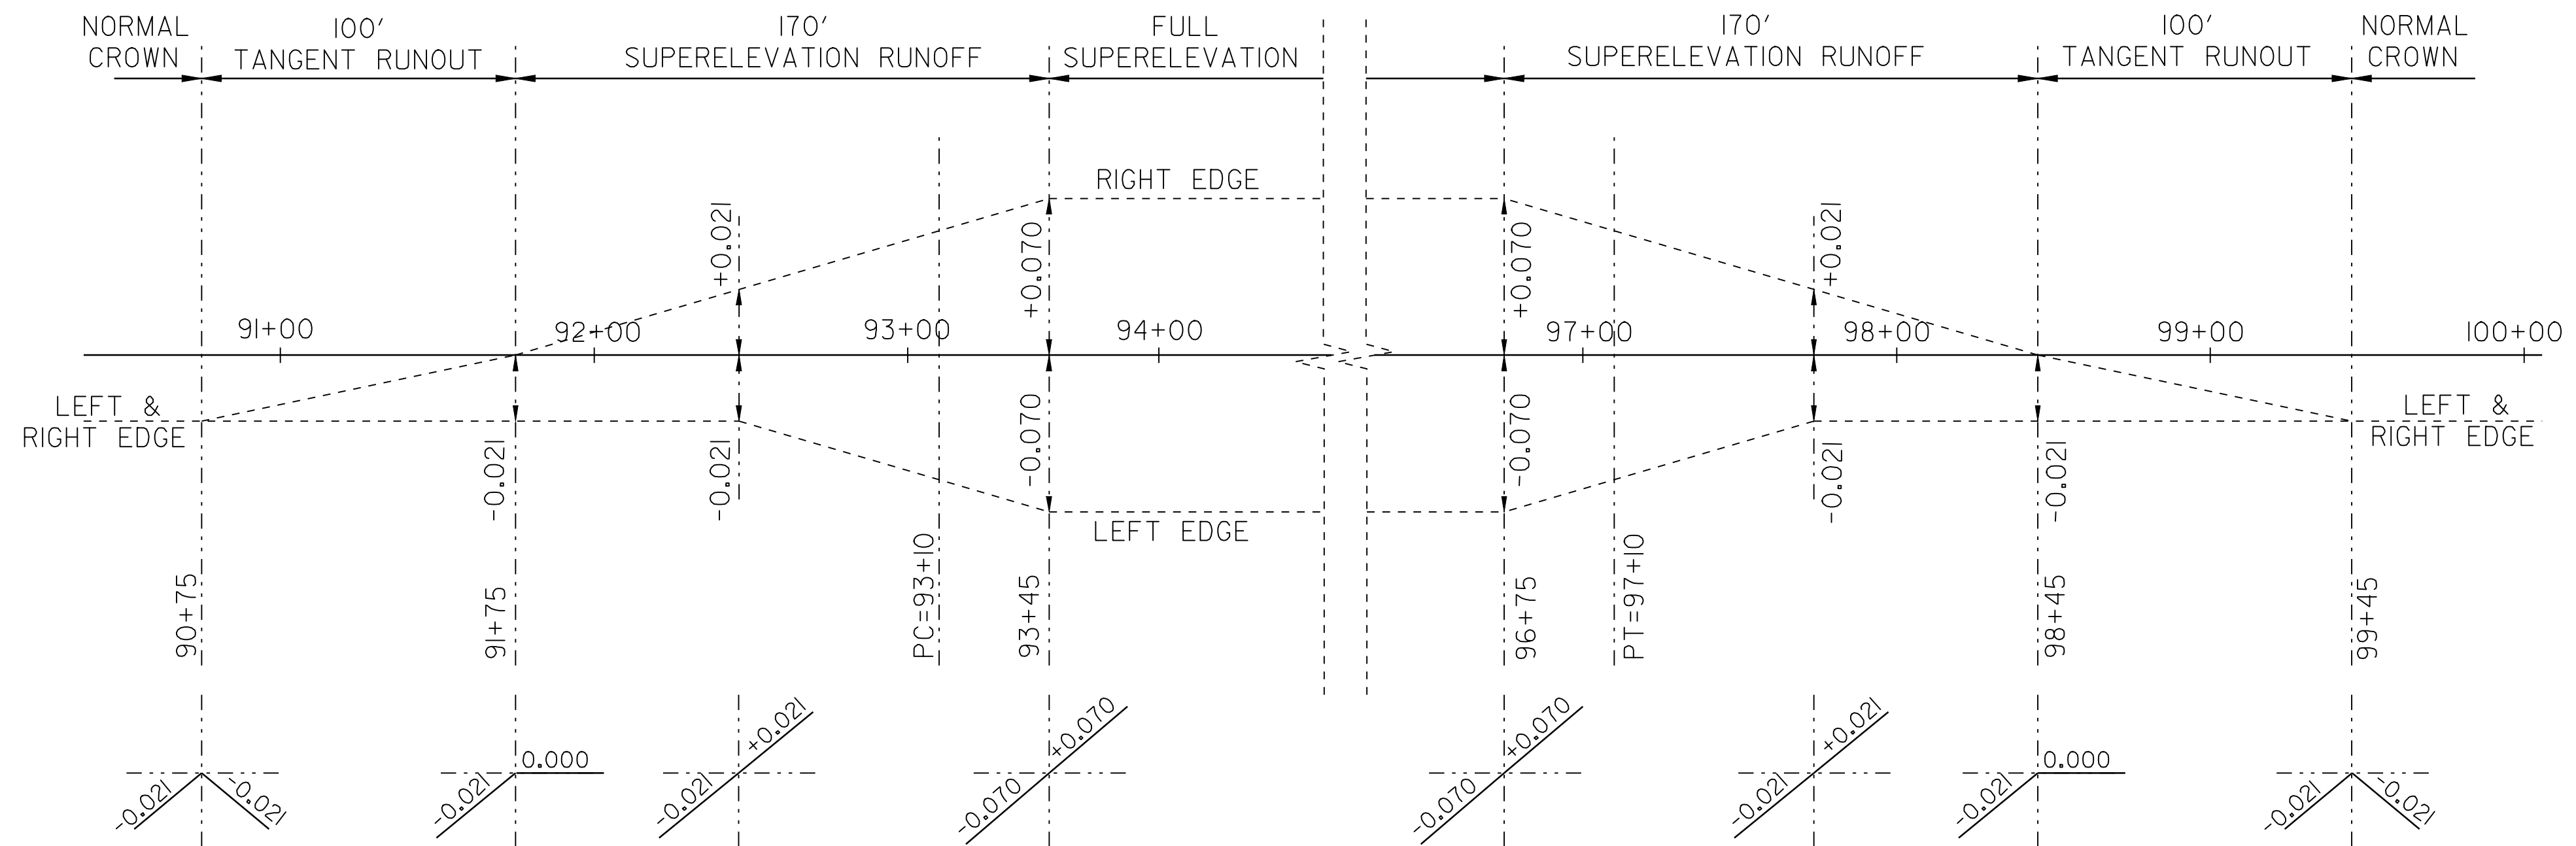



CURVE #5
 PC = 93+10
 PT = 97+10
 V = 50 m.p.h.
 R = 1,200ft - LT
 D = 4°46'
 e = 0.070
 L = 170

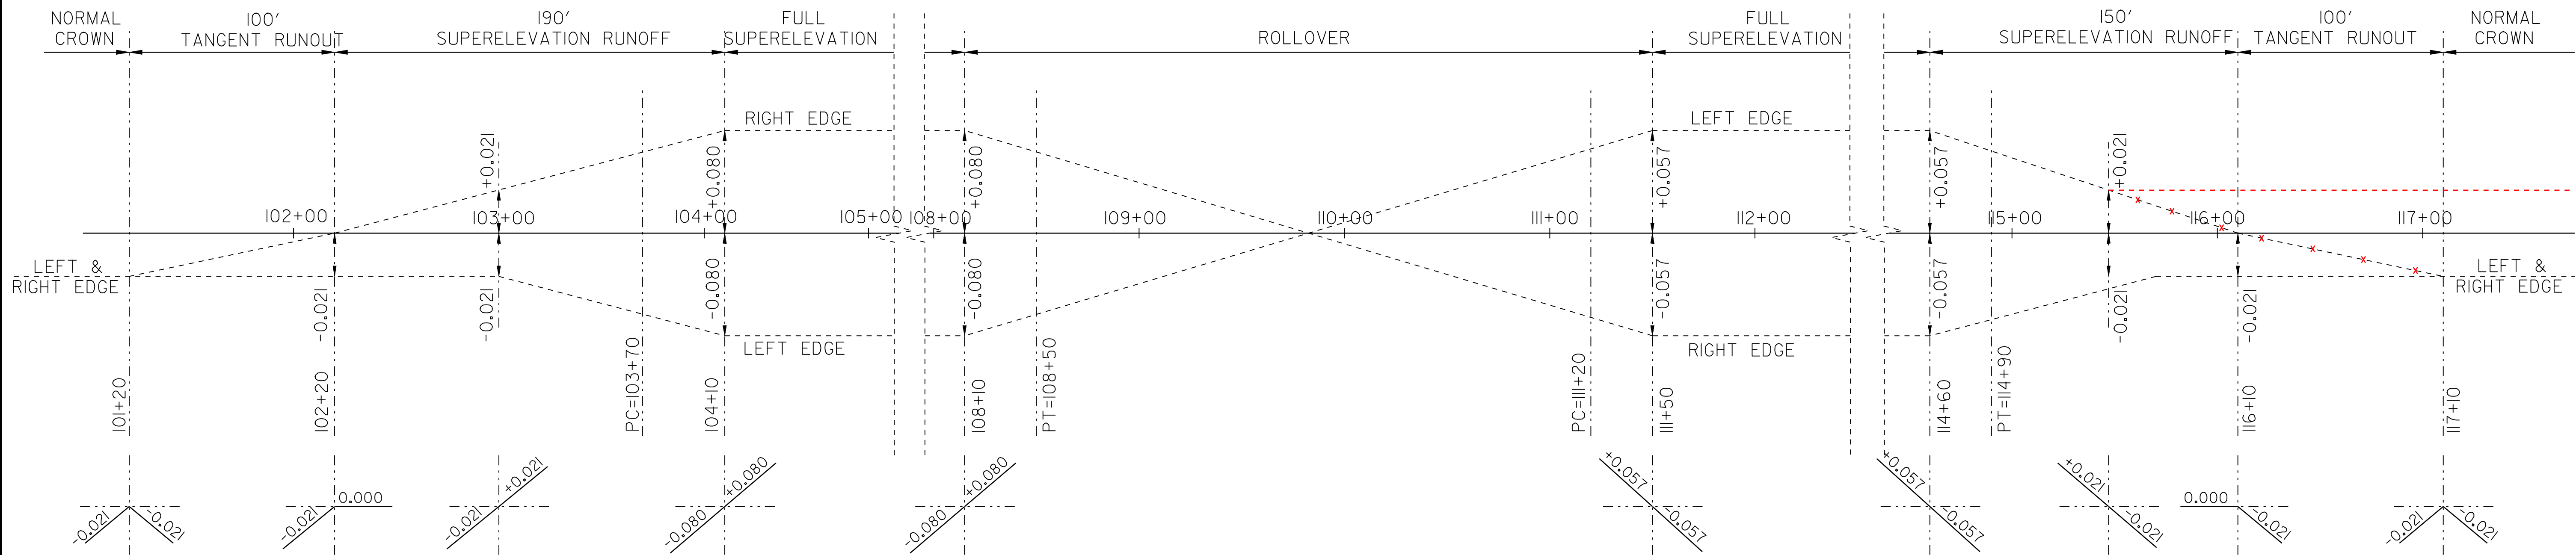

CURVE #6
 PC = 103+70
 PT = 108+50
 V = 50 m.p.h.
 R = 750ft - LT
 D = 7°38'
 e = 0.080
 L = 190



CURVE #7
 PC = 111+20
 PT = 114+90
 V = 50 m.p.h.
 R = 1,700ft - RT
 D = 3°22'
 e = 0.057
 L = 150

SUPERELEVATION BANKING DIAGRAM SHEET #2		DESIGNED BY	BCE/PJM	DATE	6-07
		DRAWN BY	C.E.A., INC.	DATE	6-07
PRF FILE		p99cl82sbd2.i	DATE PLOTTED	08-JAN-2009 08	
PROJ. NAME		JOHNSON - HYDE PARK			
PROJ. NO.		STP 2215(1)S			
SHEET		21	OF	33	SHEETS

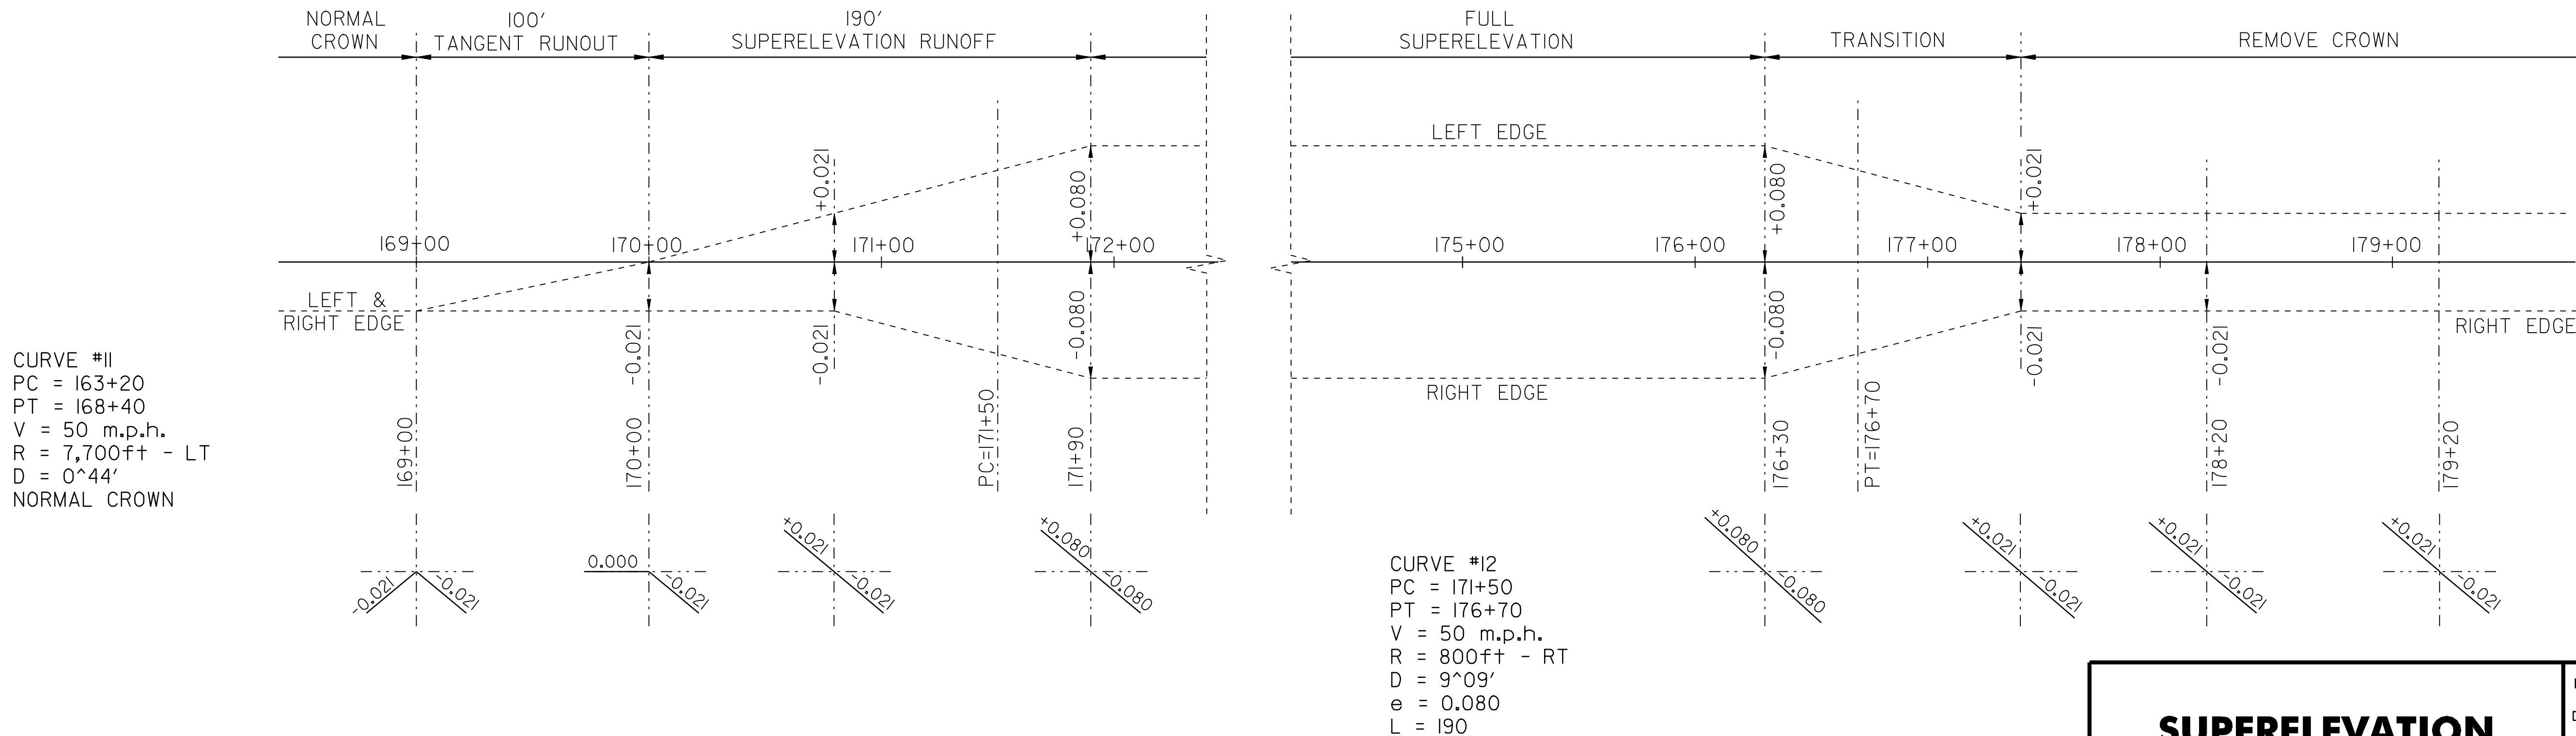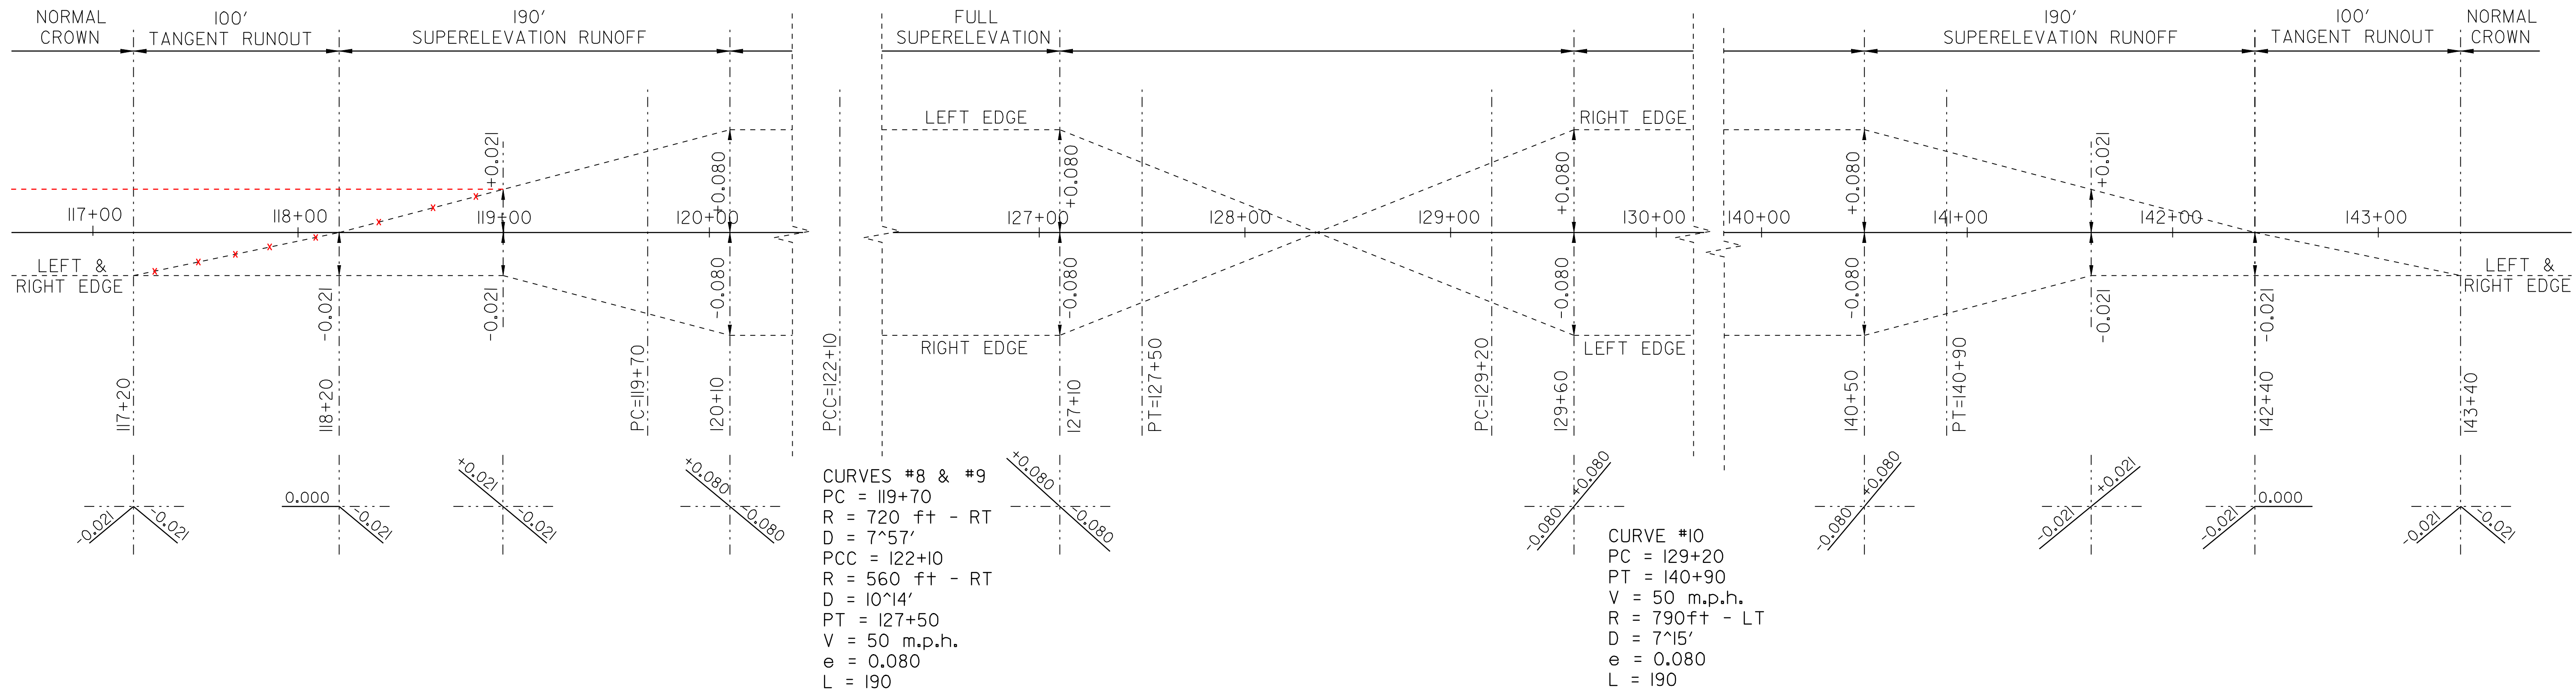



SUPERELEVATION BANKING DIAGRAM SHEET #3

DESIGNED BY	BCE/PJM	DATE	6-07
DRAWN BY	C.E.A., INC.	DATE	6-07
DESIGN FILE NO.	p99cl82.dgn		
PRF FILE	p99cl82sbd3.i	DATE PLOTTED	08-JAN-2009 08
PROJ. NAME	JOHNSON - HYDE PARK		
PROJ. NO.	STP 2215(1)S		
SHEET	22	OF	33 SHEETS

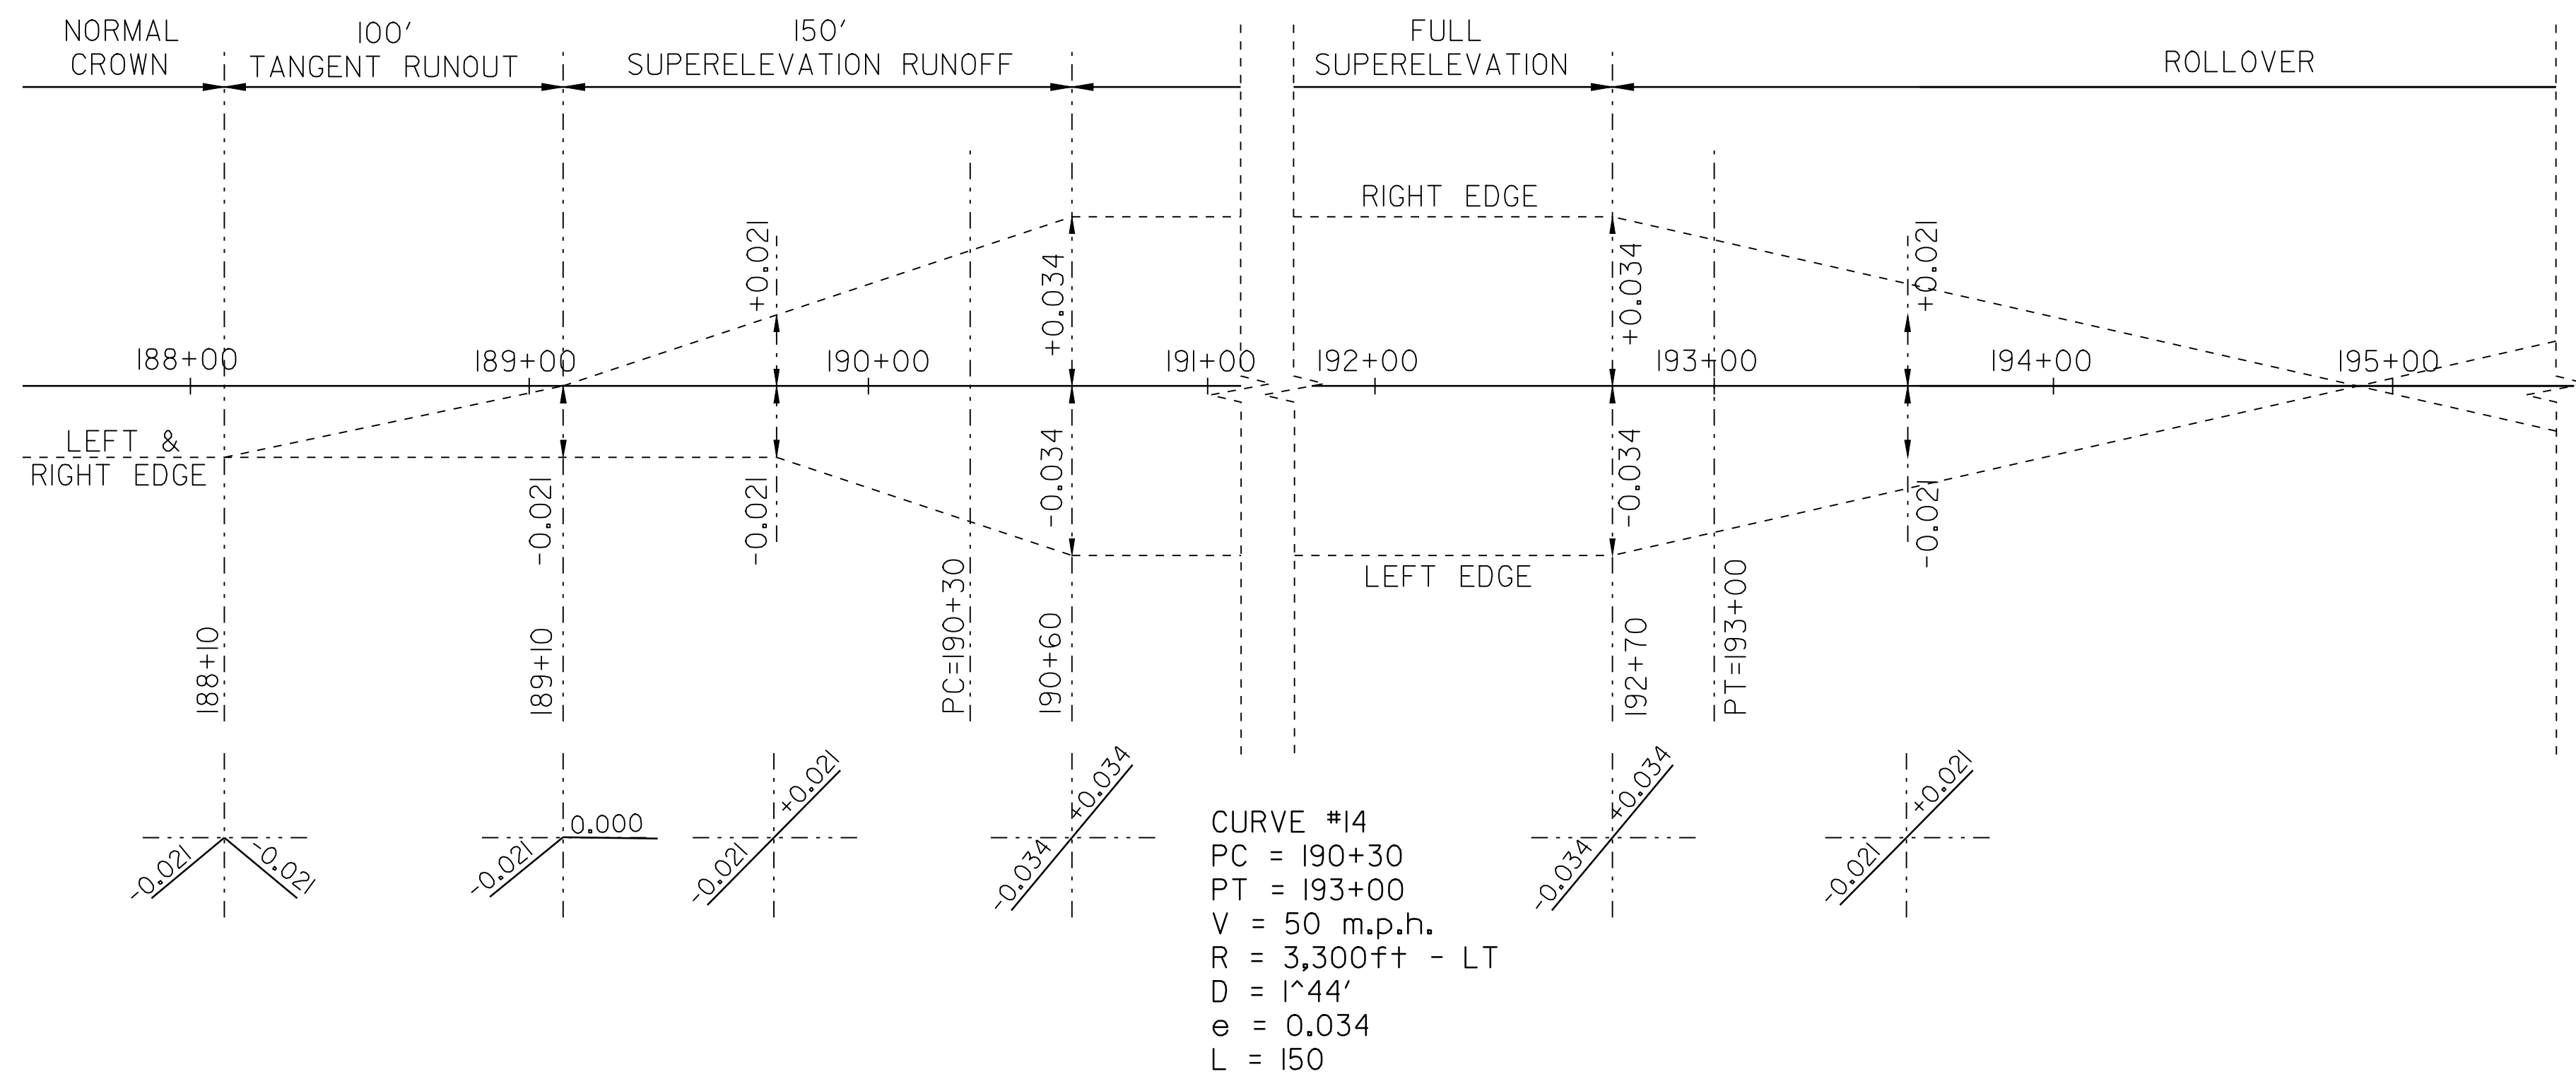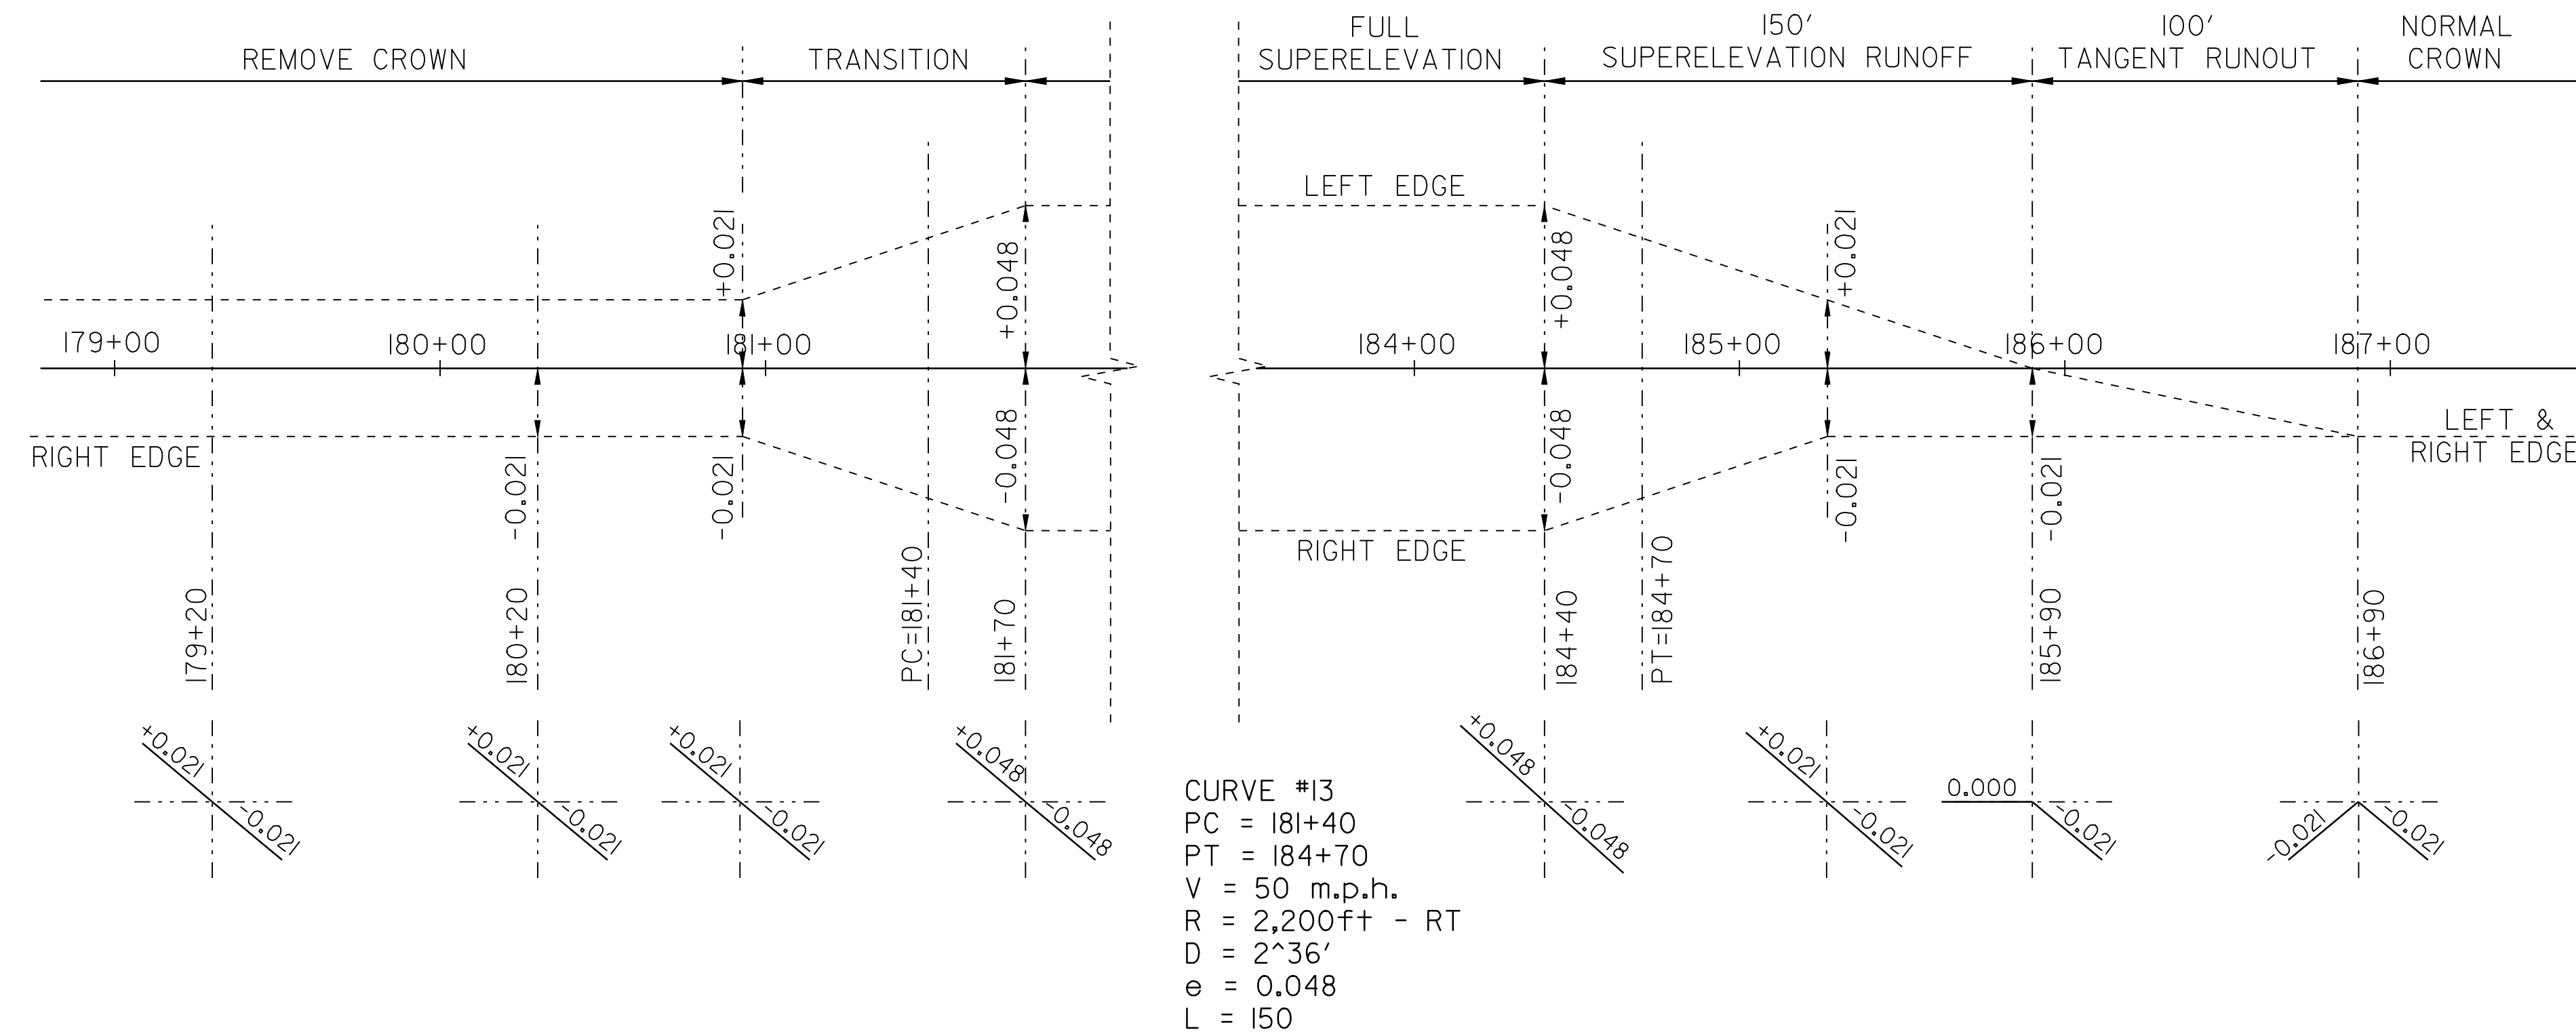



SUPERELEVATION BANKING DIAGRAM SHEET #4

DESIGNED BY BCE/PJM DATE 6-07
 DRAWN BY C.E.A., INC. DATE 6-07
 DESIGN FILE NO. p99cl82.dgn
 PRF FILE p99cl82sbd4.i DATE PLOTTED 08-JAN-2009 08
 PROJ. NAME **JOHNSON - HYDE PARK**
 PROJ. NO. **STP 2215(1)S**
 SHEET **23** OF **33** SHEETS

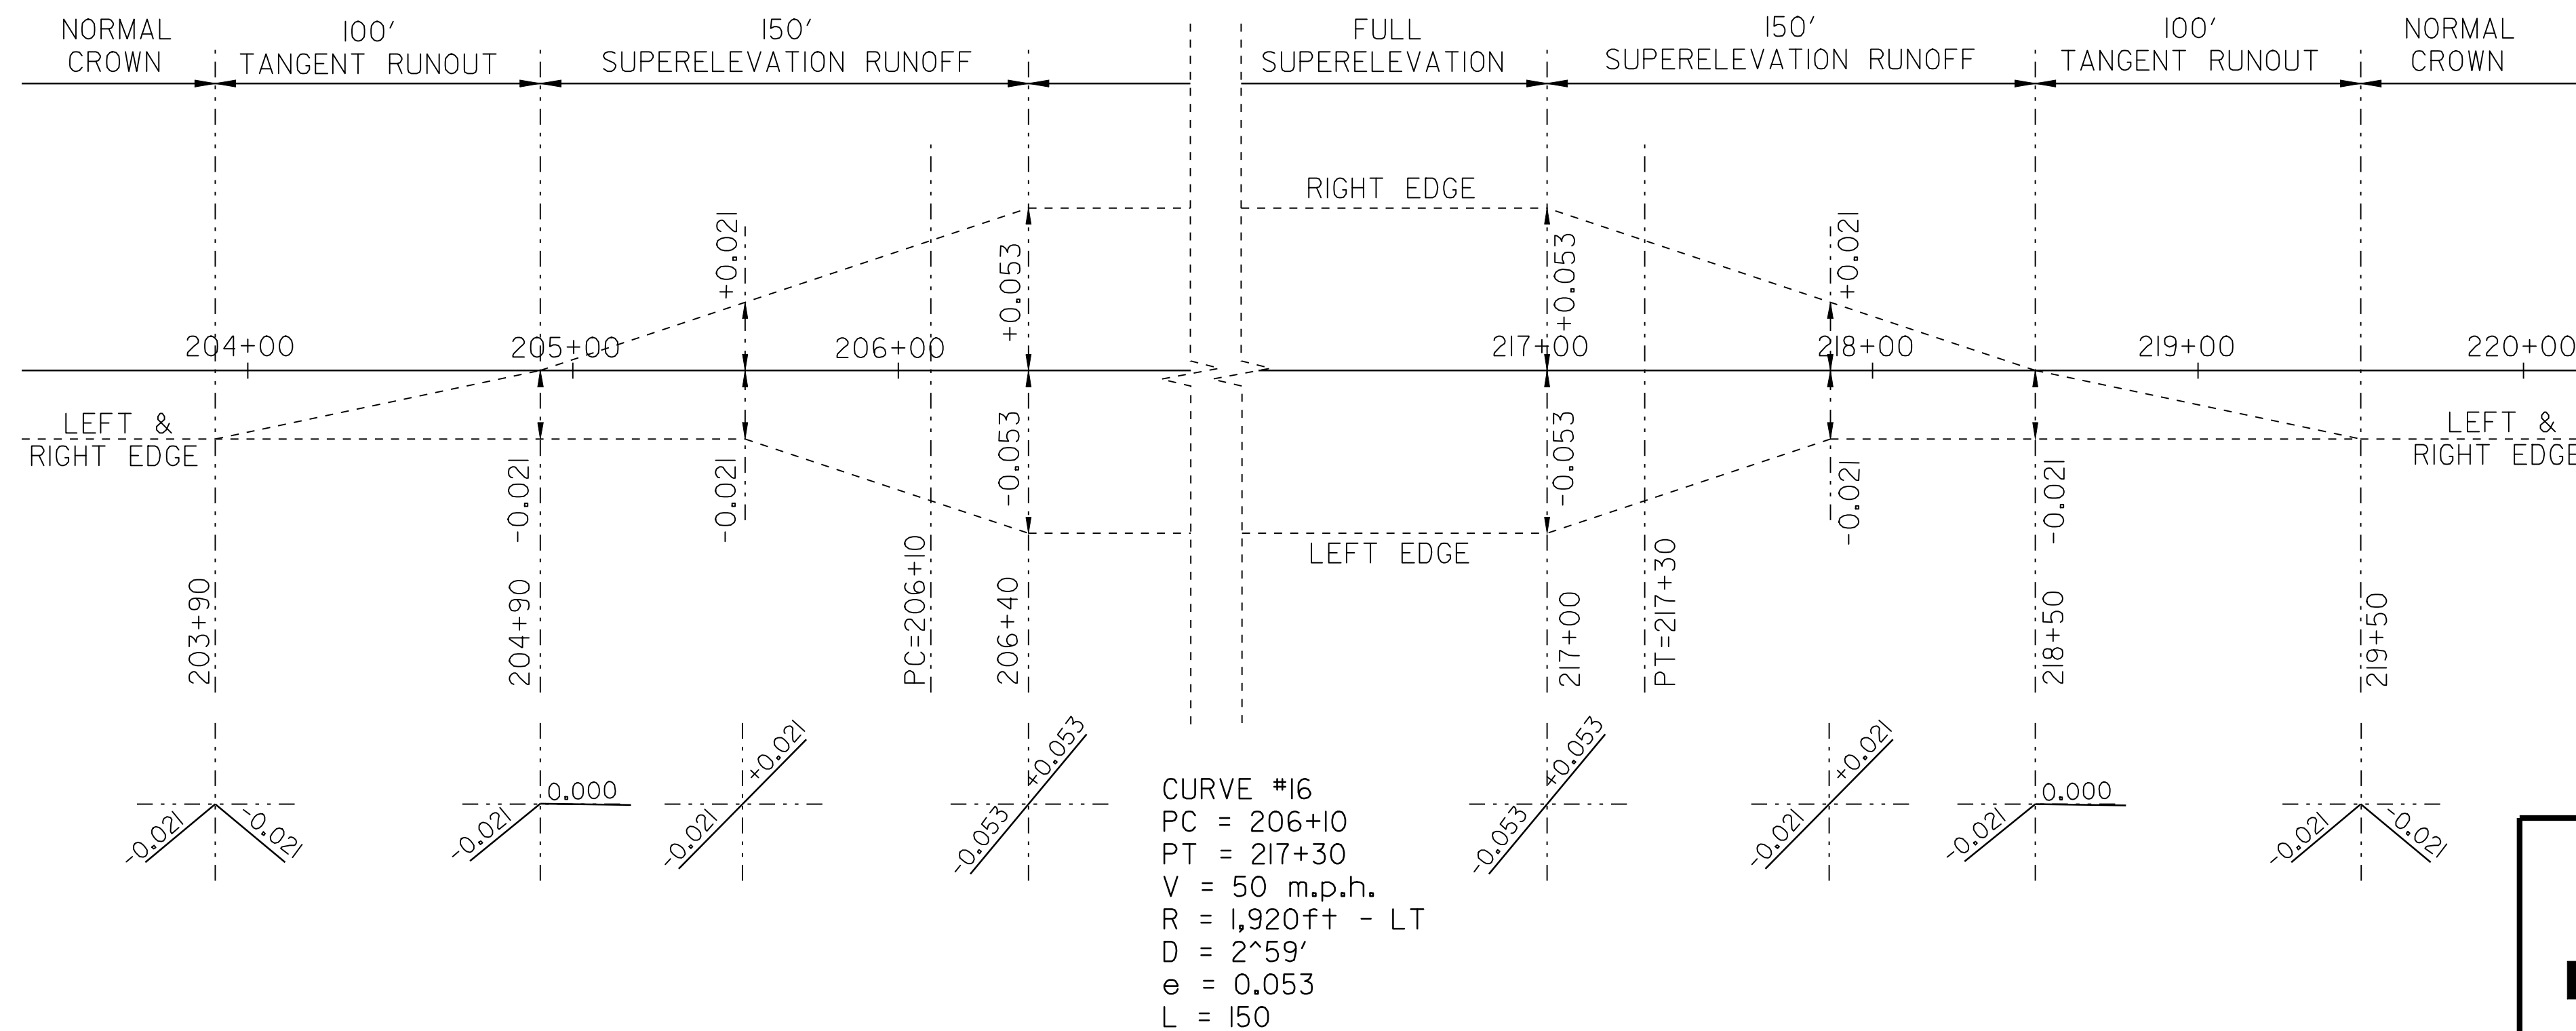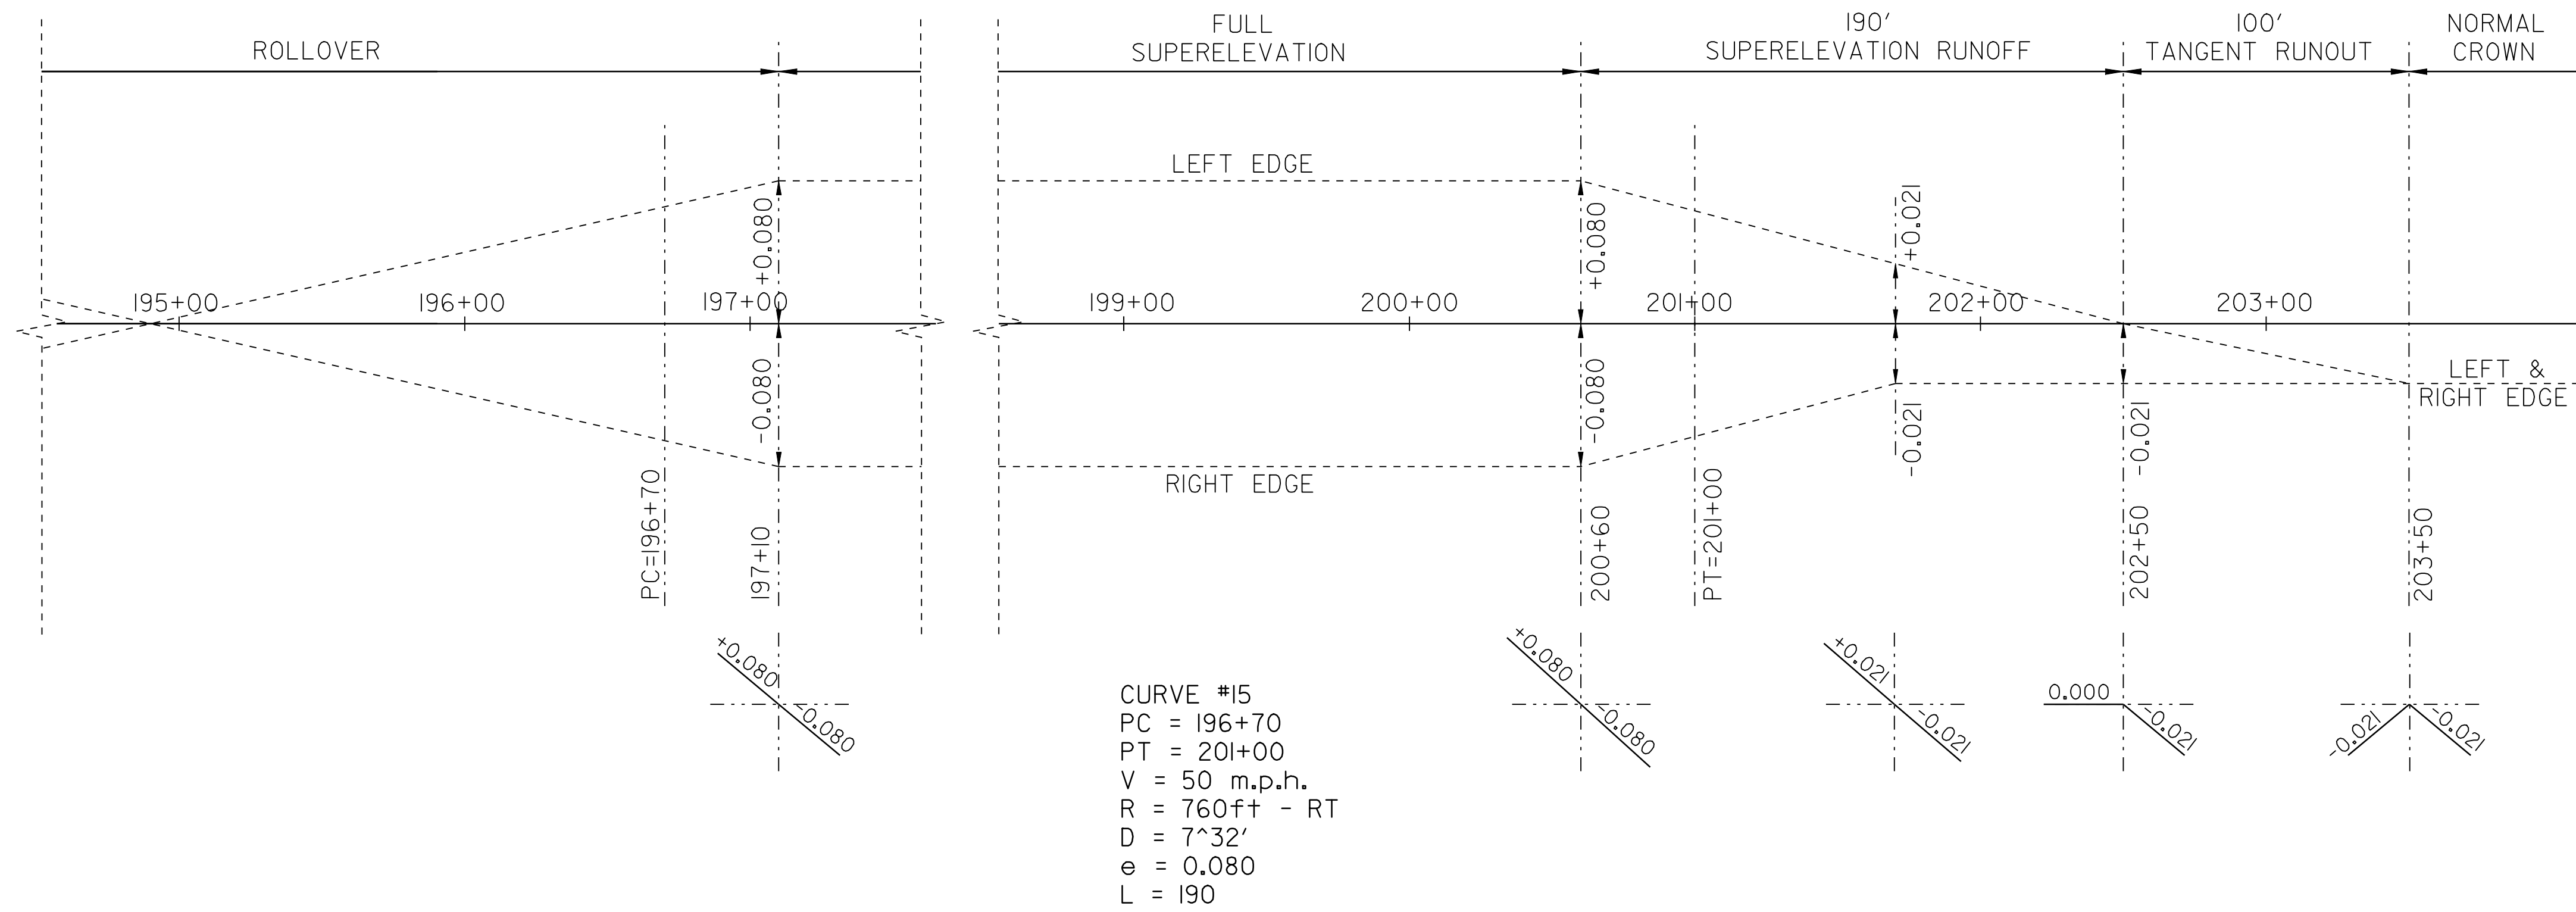



SUPERELEVATION BANKING DIAGRAM SHEET #5

DESIGNED BY	BCE/PJM	DATE	6-07
DRAWN BY	C.E.A., INC.	DATE	6-07
DESIGN FILE NO.	p99cl82.dgn		
PRF FILE	p99cl82sbd5.i	DATE PLOTTED	08-JAN-2009 08
PROJ. NAME	JOHNSON - HYDE PARK		
PROJ. NO.	STP 2215(1)S		
SHEET	24	OF	33 SHEETS

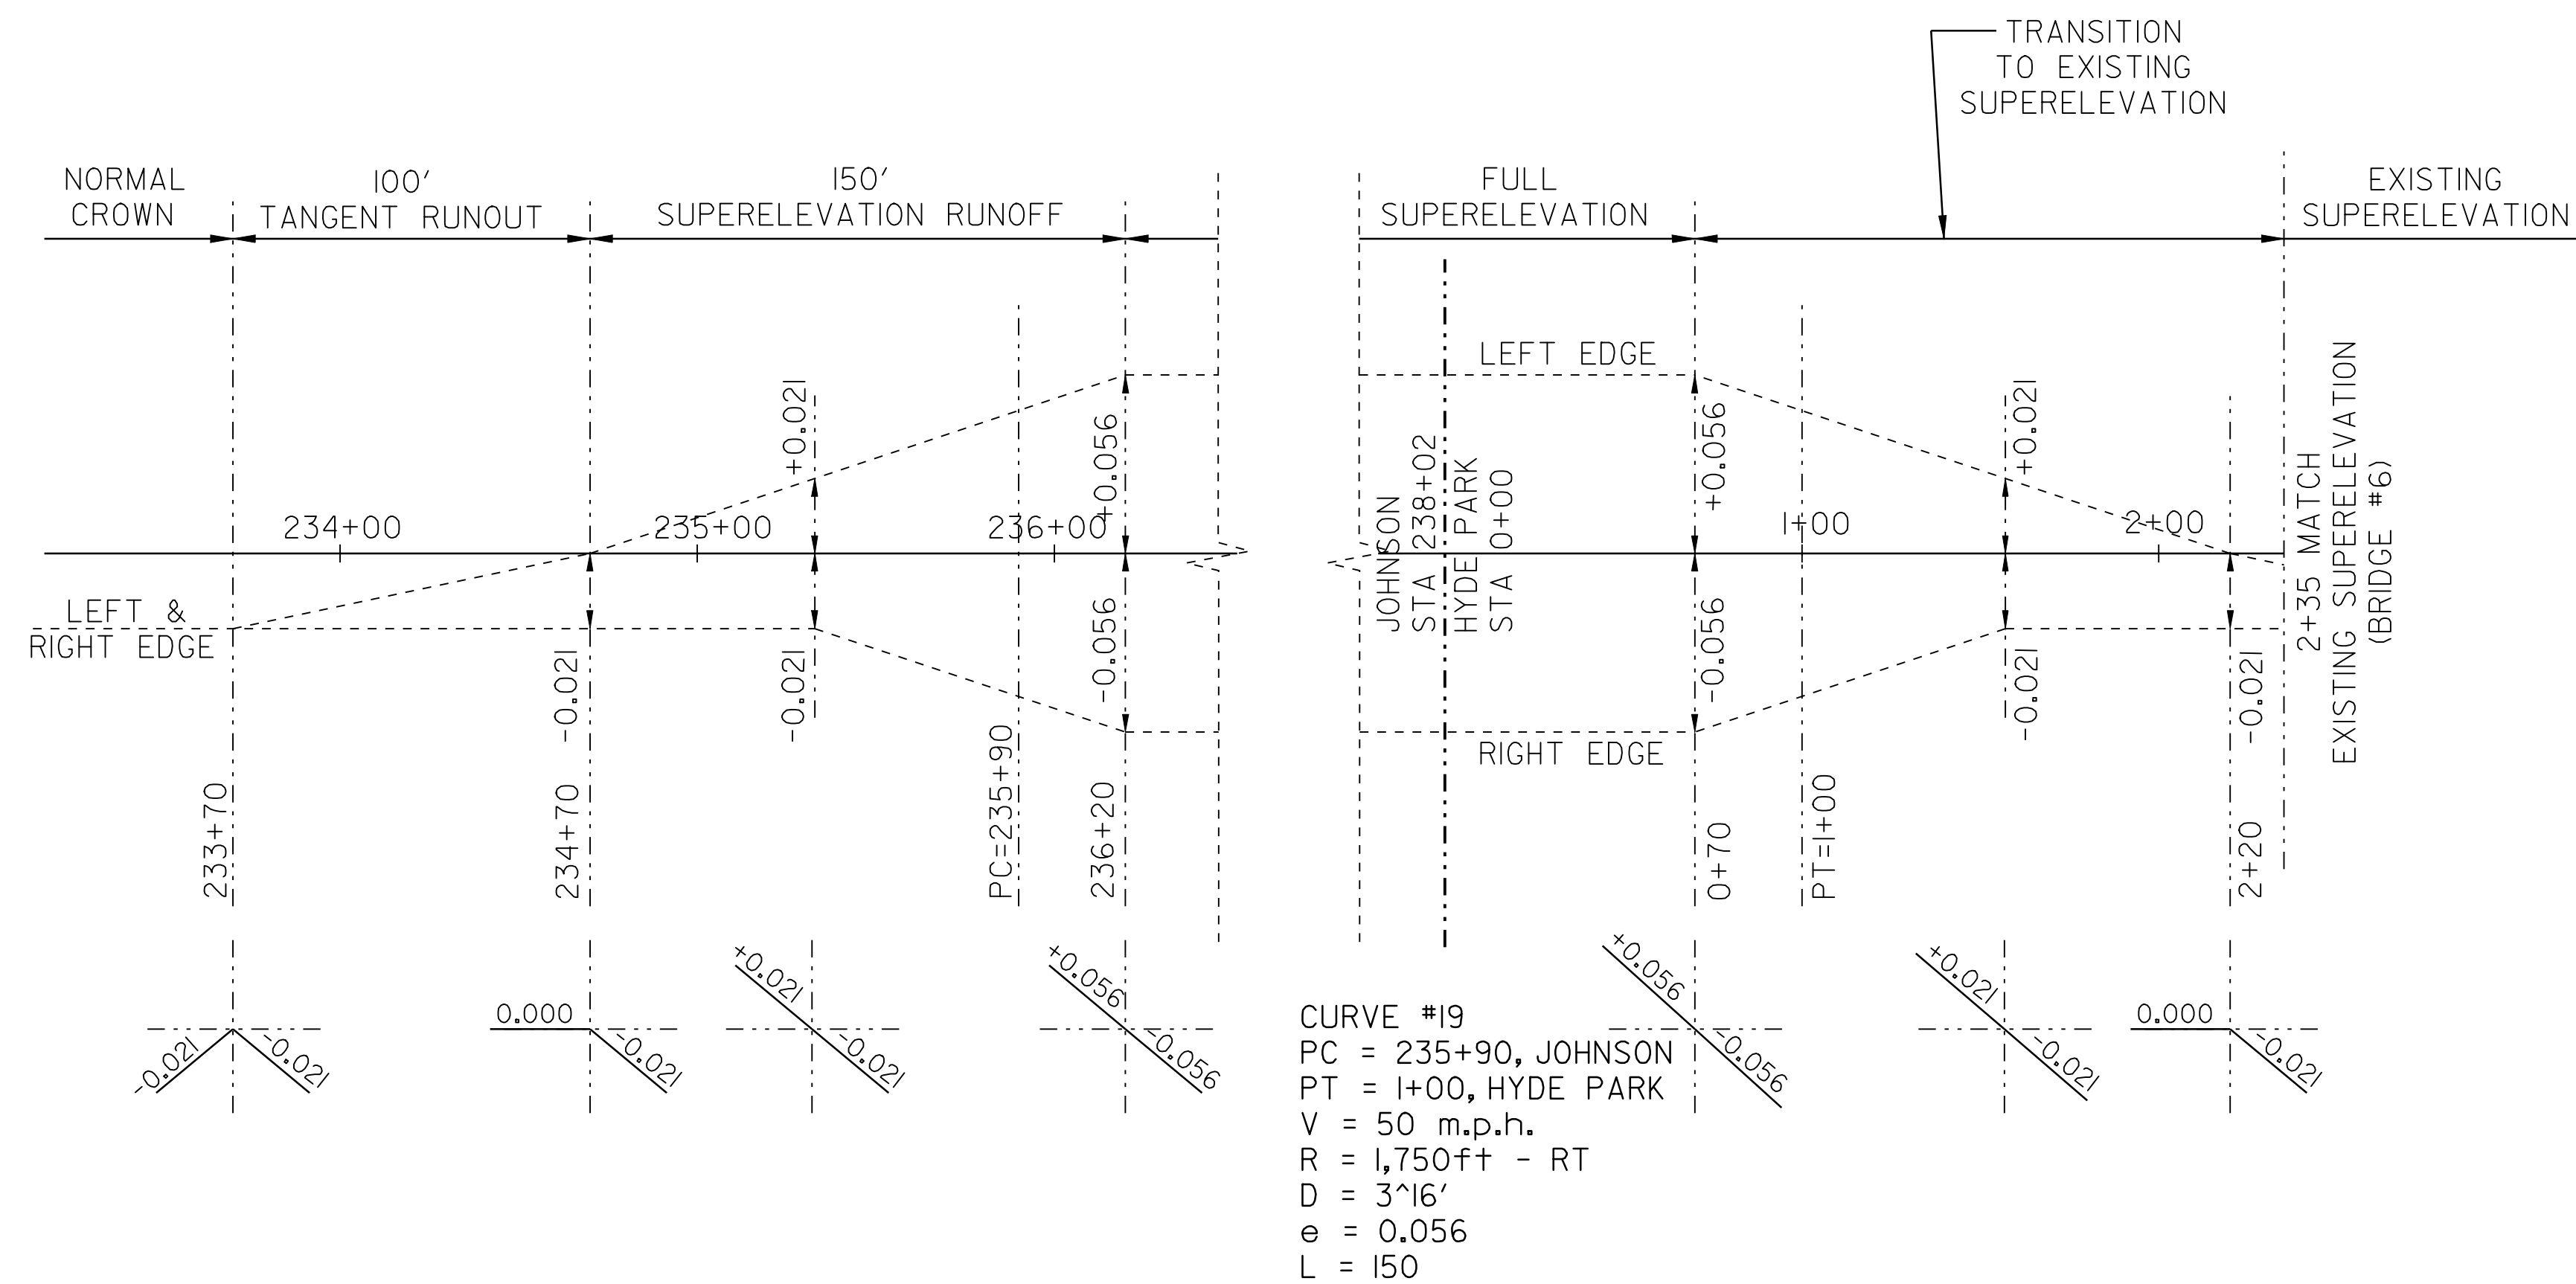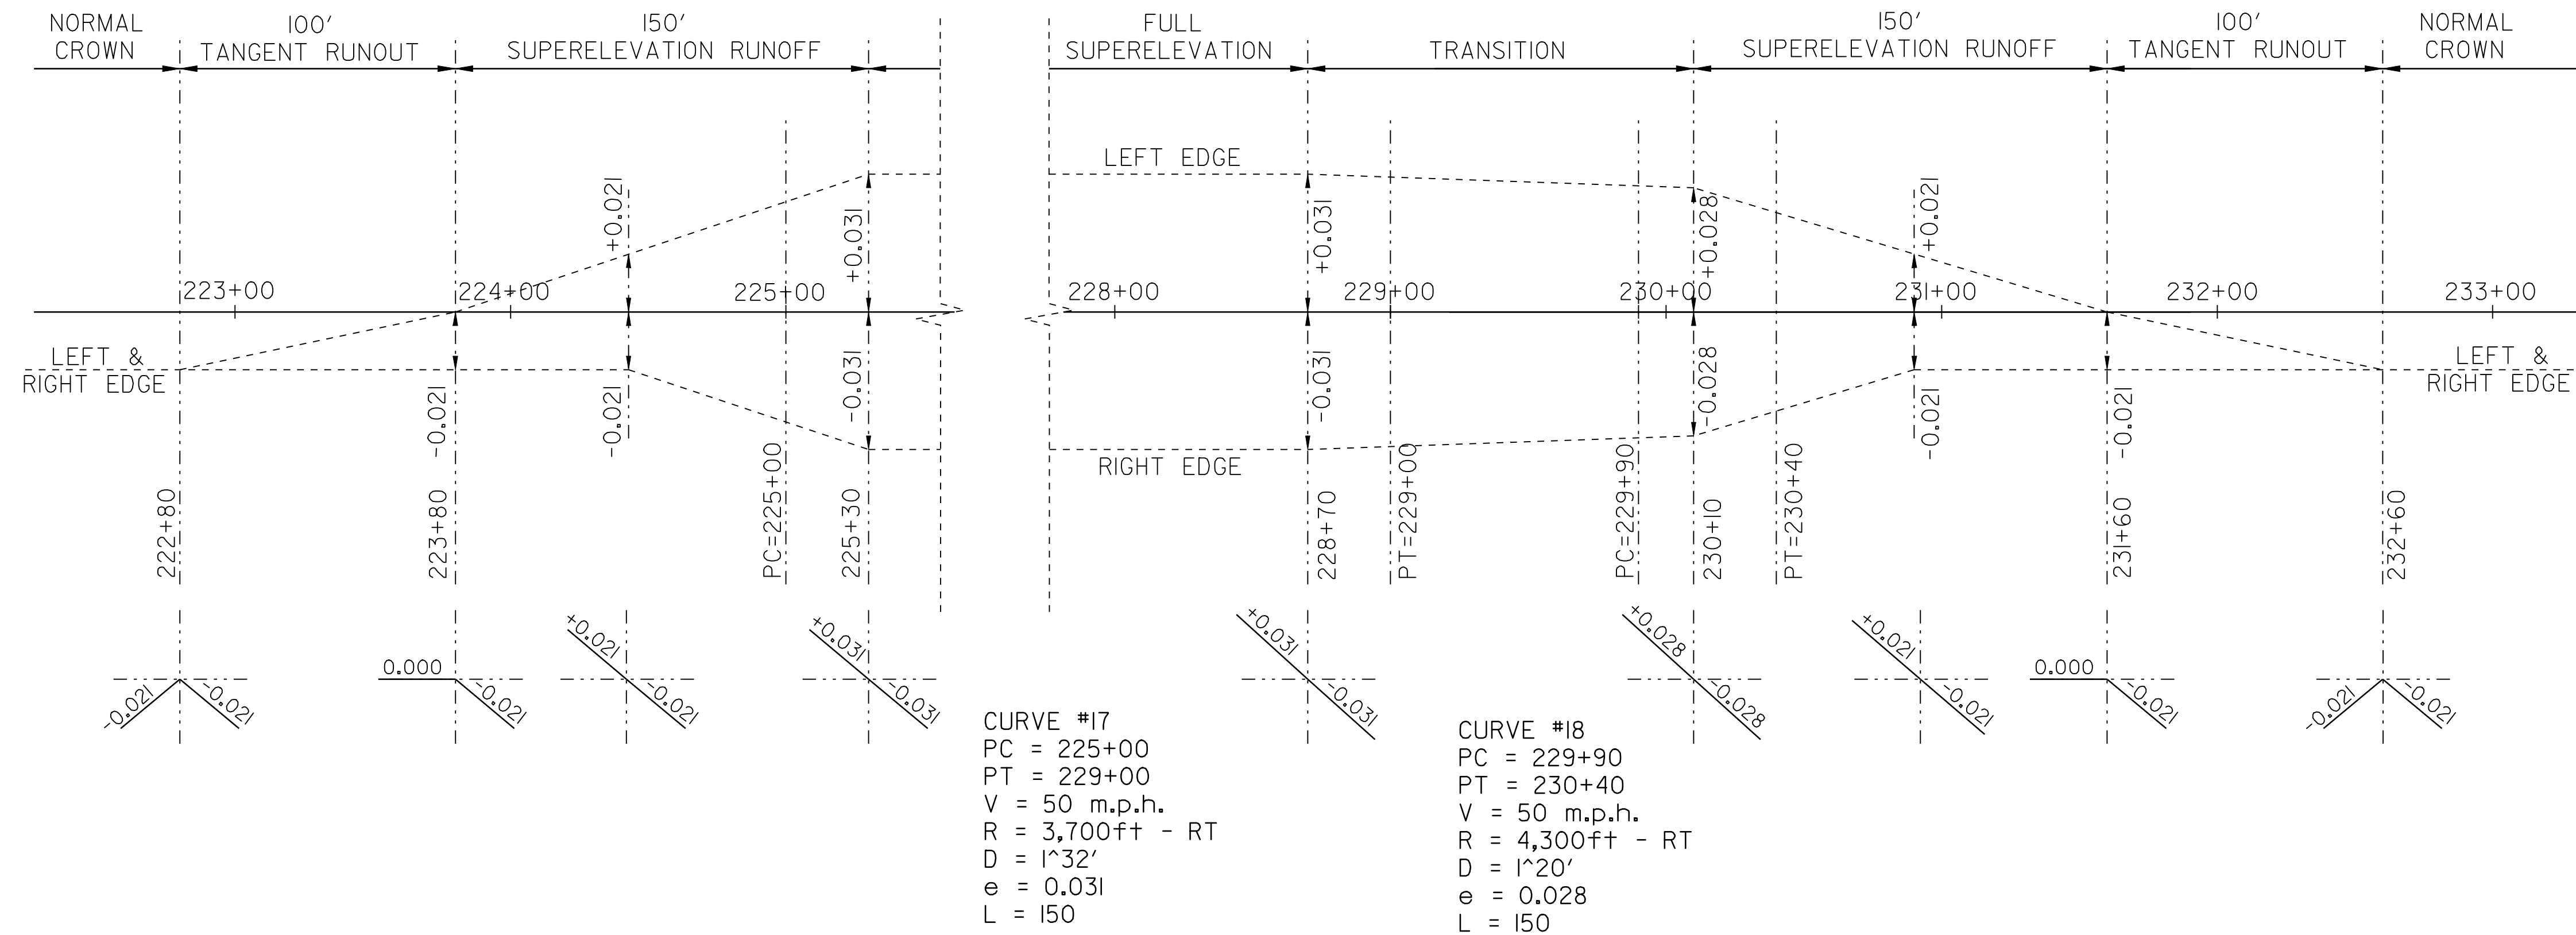



**SUPERELEVATION
 BANKING DIAGRAM
 SHEET #6**

DESIGNED BY	BCE/PJM	DATE	6-07
DRAWN BY	C.E.A., INC.	DATE	6-07
DESIGN FILE NO.	p99cl82.dgn		
PRF FILE	p99cl82sbd6.i	DATE PLOTTED	08-JAN-2009 08
PROJ. NAME	JOHNSON - HYDE PARK		
PROJ. NO.	STP 2215(1)S		
SHEET	25	OF	33 SHEETS

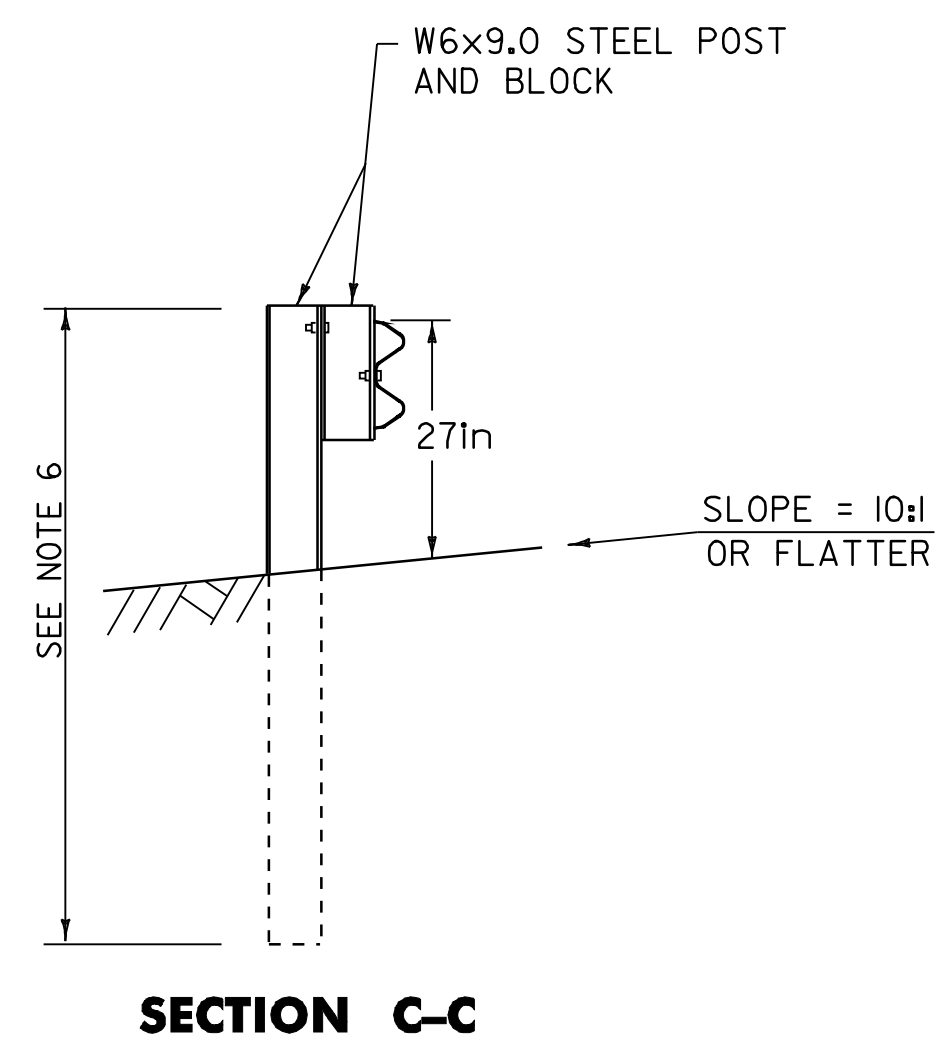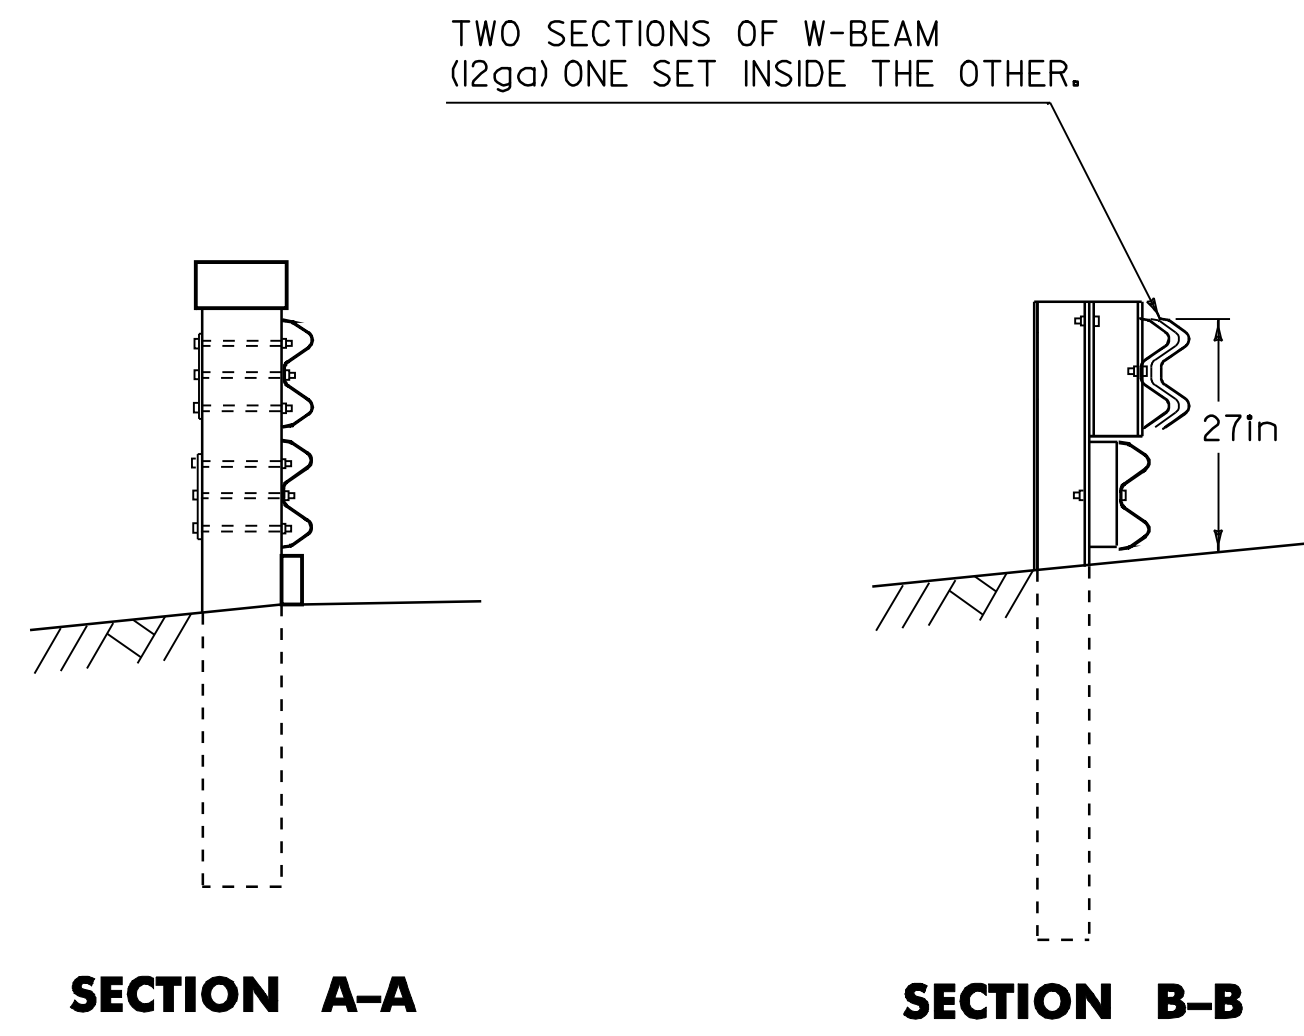

NOTES

1. THIS GUARD RAIL TRANSITION IS FOR CONNECTION TO A VERTICAL CONCRETE BRIDGE AND SHOULD NOT BE CONNECTED DIRECTLY TO A CONCRETE SAFETY SHAPE.
2. BOTTOM BEAM BLOCKS ARE OFFSET DRILLED TO SIT SQUARELY ON THE POST FLANGE. BLOCKS ARE ATTACHED WITH 3/8" CARRIAGE BOLTS.
3. THE RUBRAIL MAY BE SHOP BENT IN THE LAST 3 FEET TO FACILITATE INSTALLATION.
4. POSTS 1, 2, 3, 4, AND 6 REQUIRE AN ADDITIONAL HOLE TO ATTACH LOWER BLOCKS AND OR LOWER BEAM.
5. AT POST 7, BACK-UP PLATE BOLTED TO BLOCK ONLY.
6. POSTS WILL BE 6 FT STEEL POSTS.

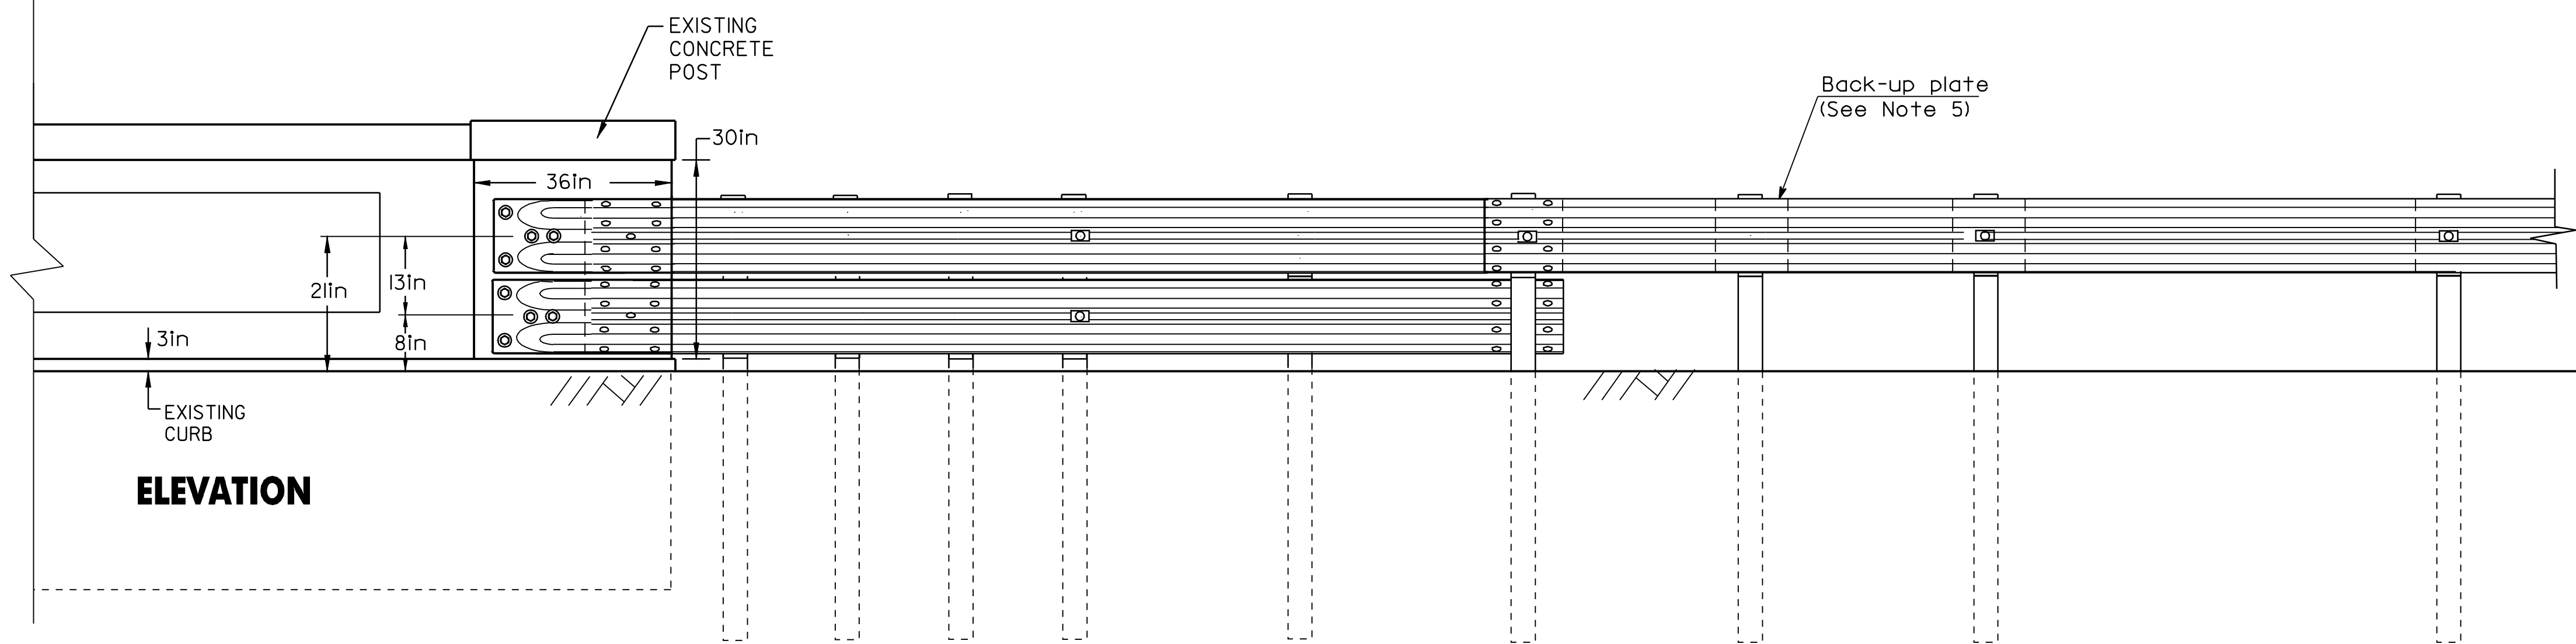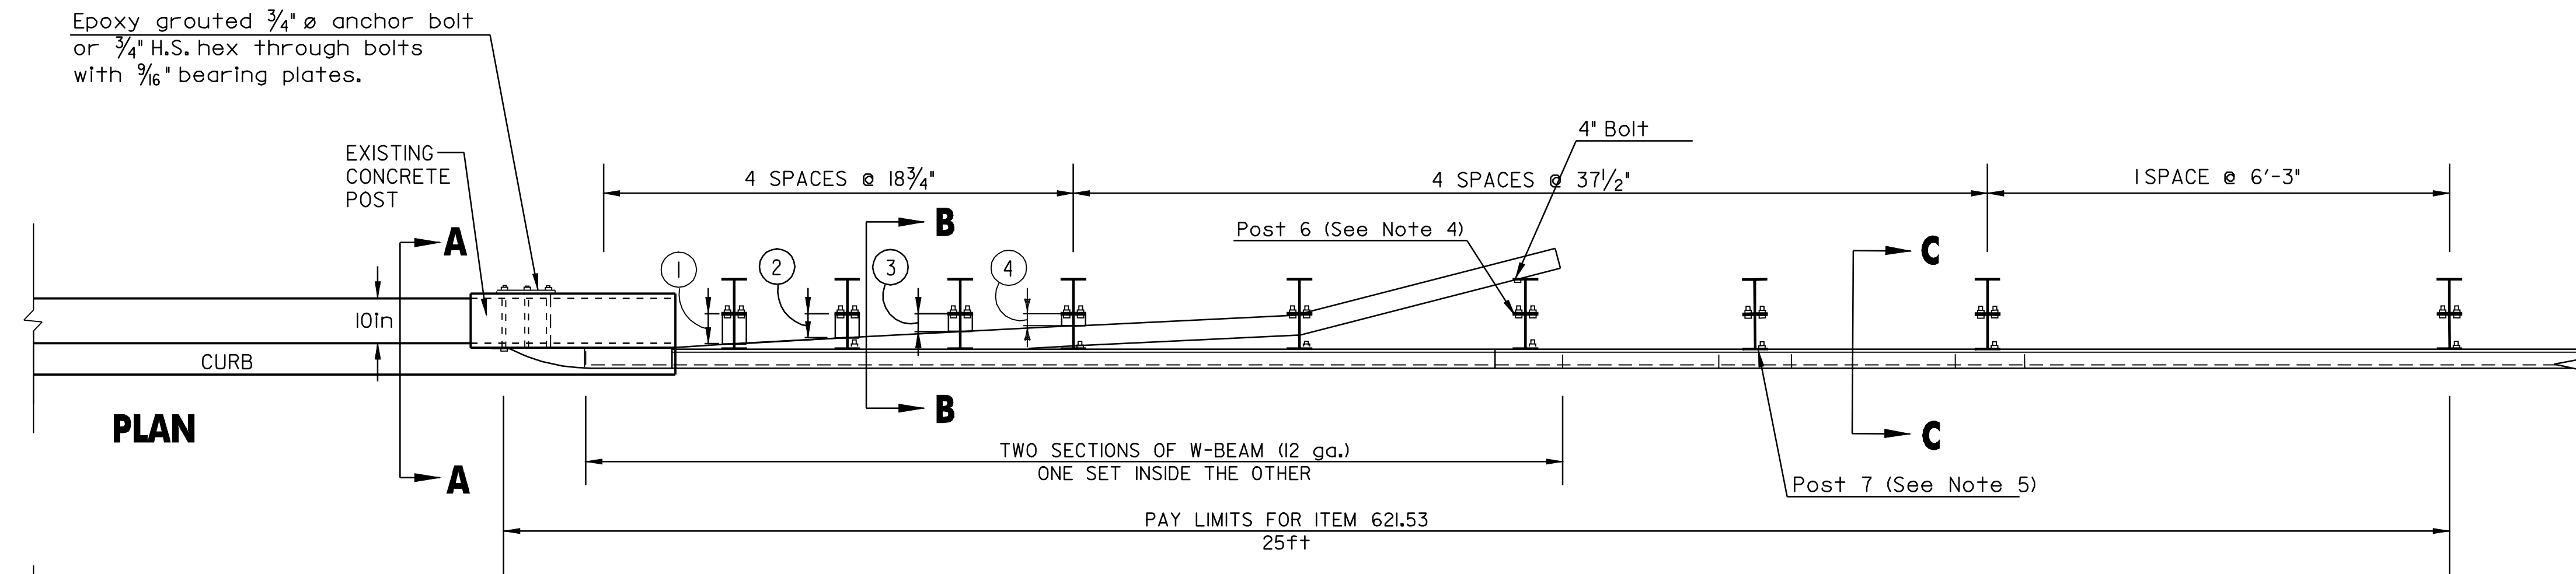


BOTTOM BEAM WOOD BLOCKS	
14" x 4 1/2"	
POST #	THICKNESS
①	5in
②	4in
③	3in
④	2in

No Scale


TERMINAL CONNECTOR FOR STEEL BEAM GUARD RAIL W/STEEL POSTS

DESIGNED BY	BCE/PJM	DATE	6-07
DRAWN BY	C.E.A., INC.	DATE	6-07
DESIGN FILE NO.	p99c182.dgn		
PRF FILE	p99c182+c.1	DATE PLOTTED	08-JAN-2009 08
PROJ. NAME	JOHNSON - HYDE PARK		
PROJ. NO.	STP 2215(1)S		
SHEET	28	OF	33 SHEETS

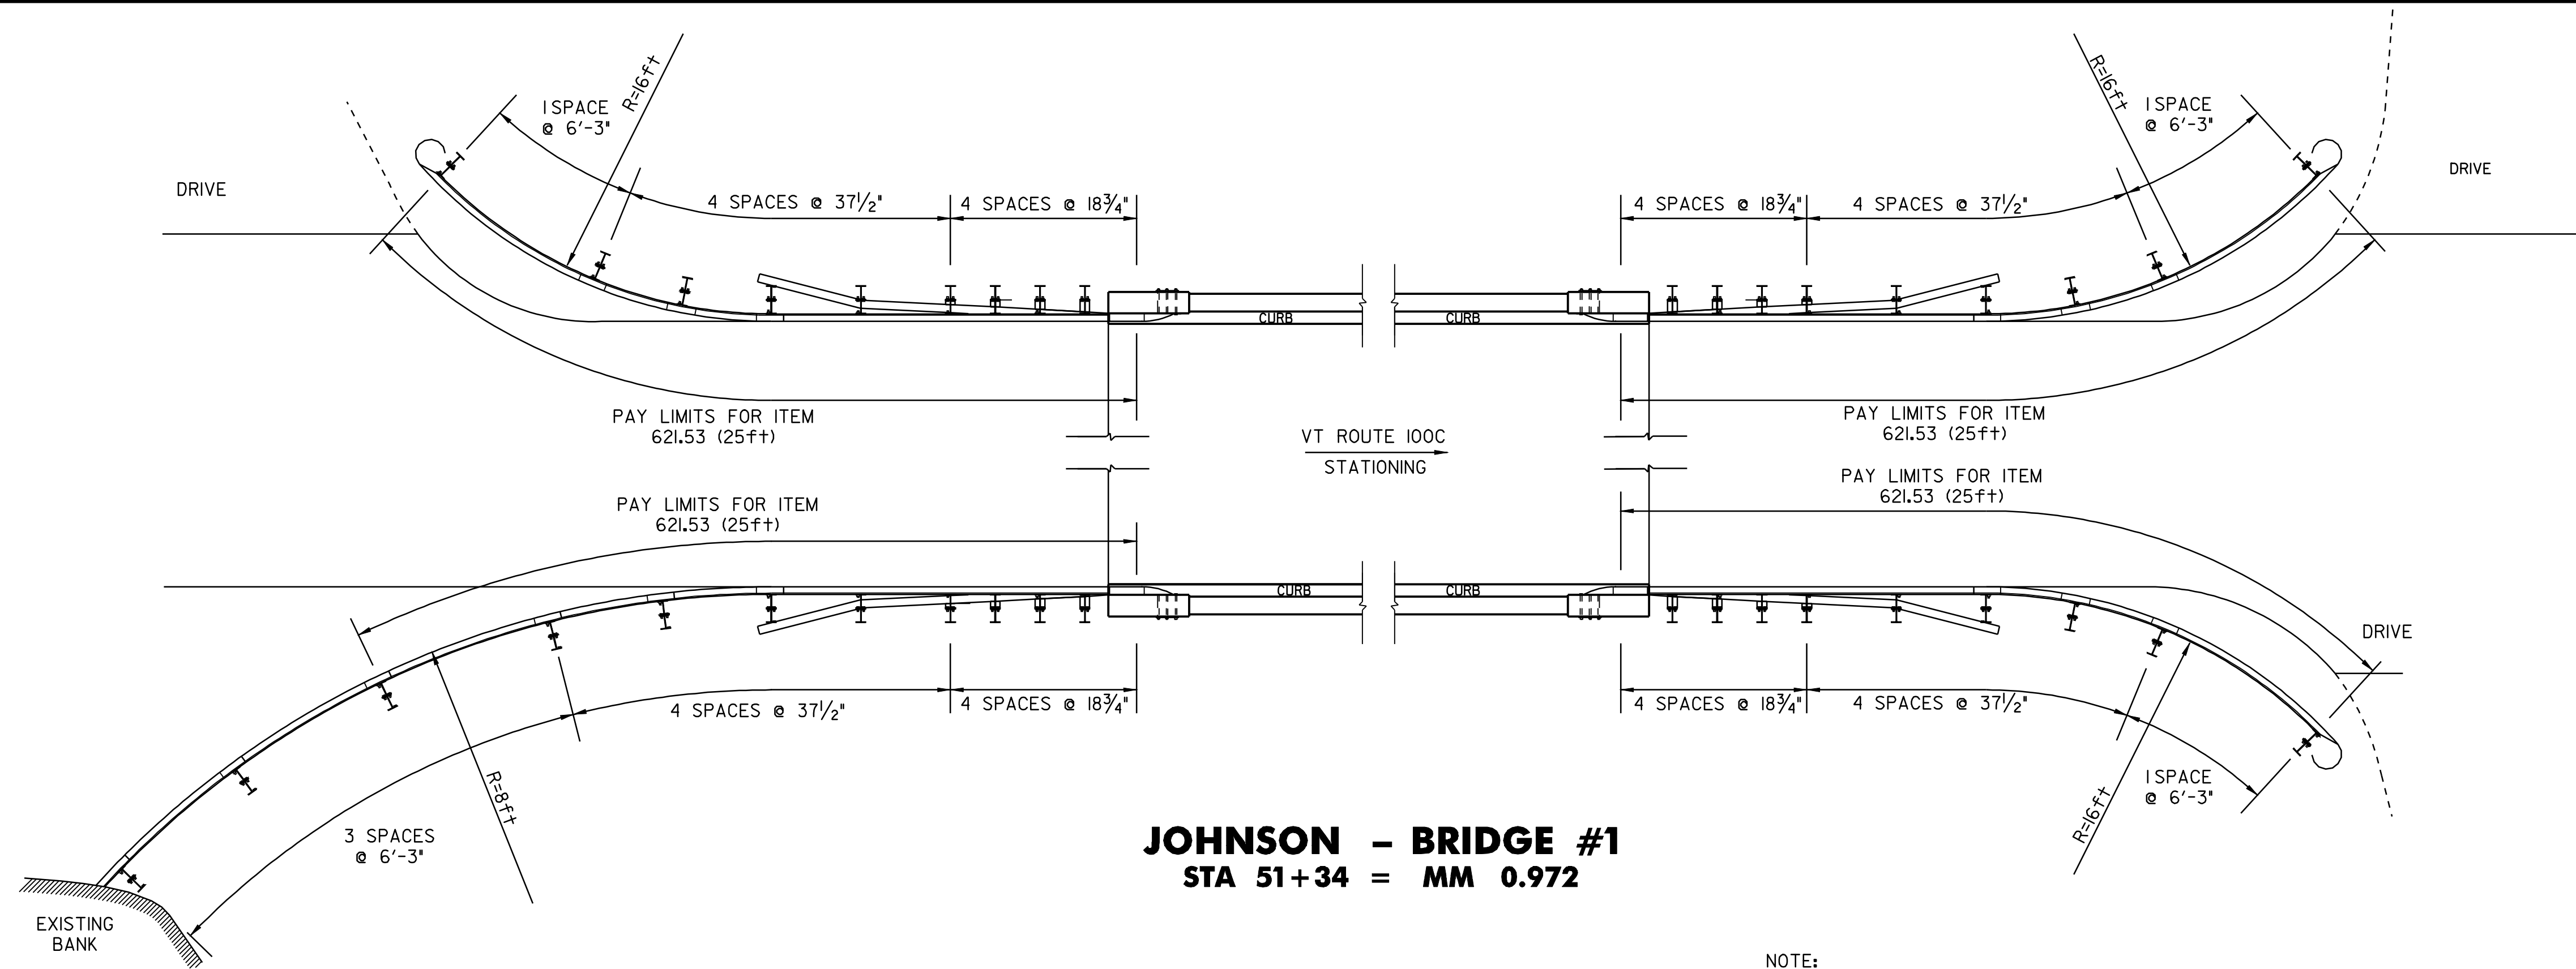

JOHNSON - BRIDGE #1
STA 51+34 = MM 0.972


NOTE:
 FIELD VERIFY ALL RADII.

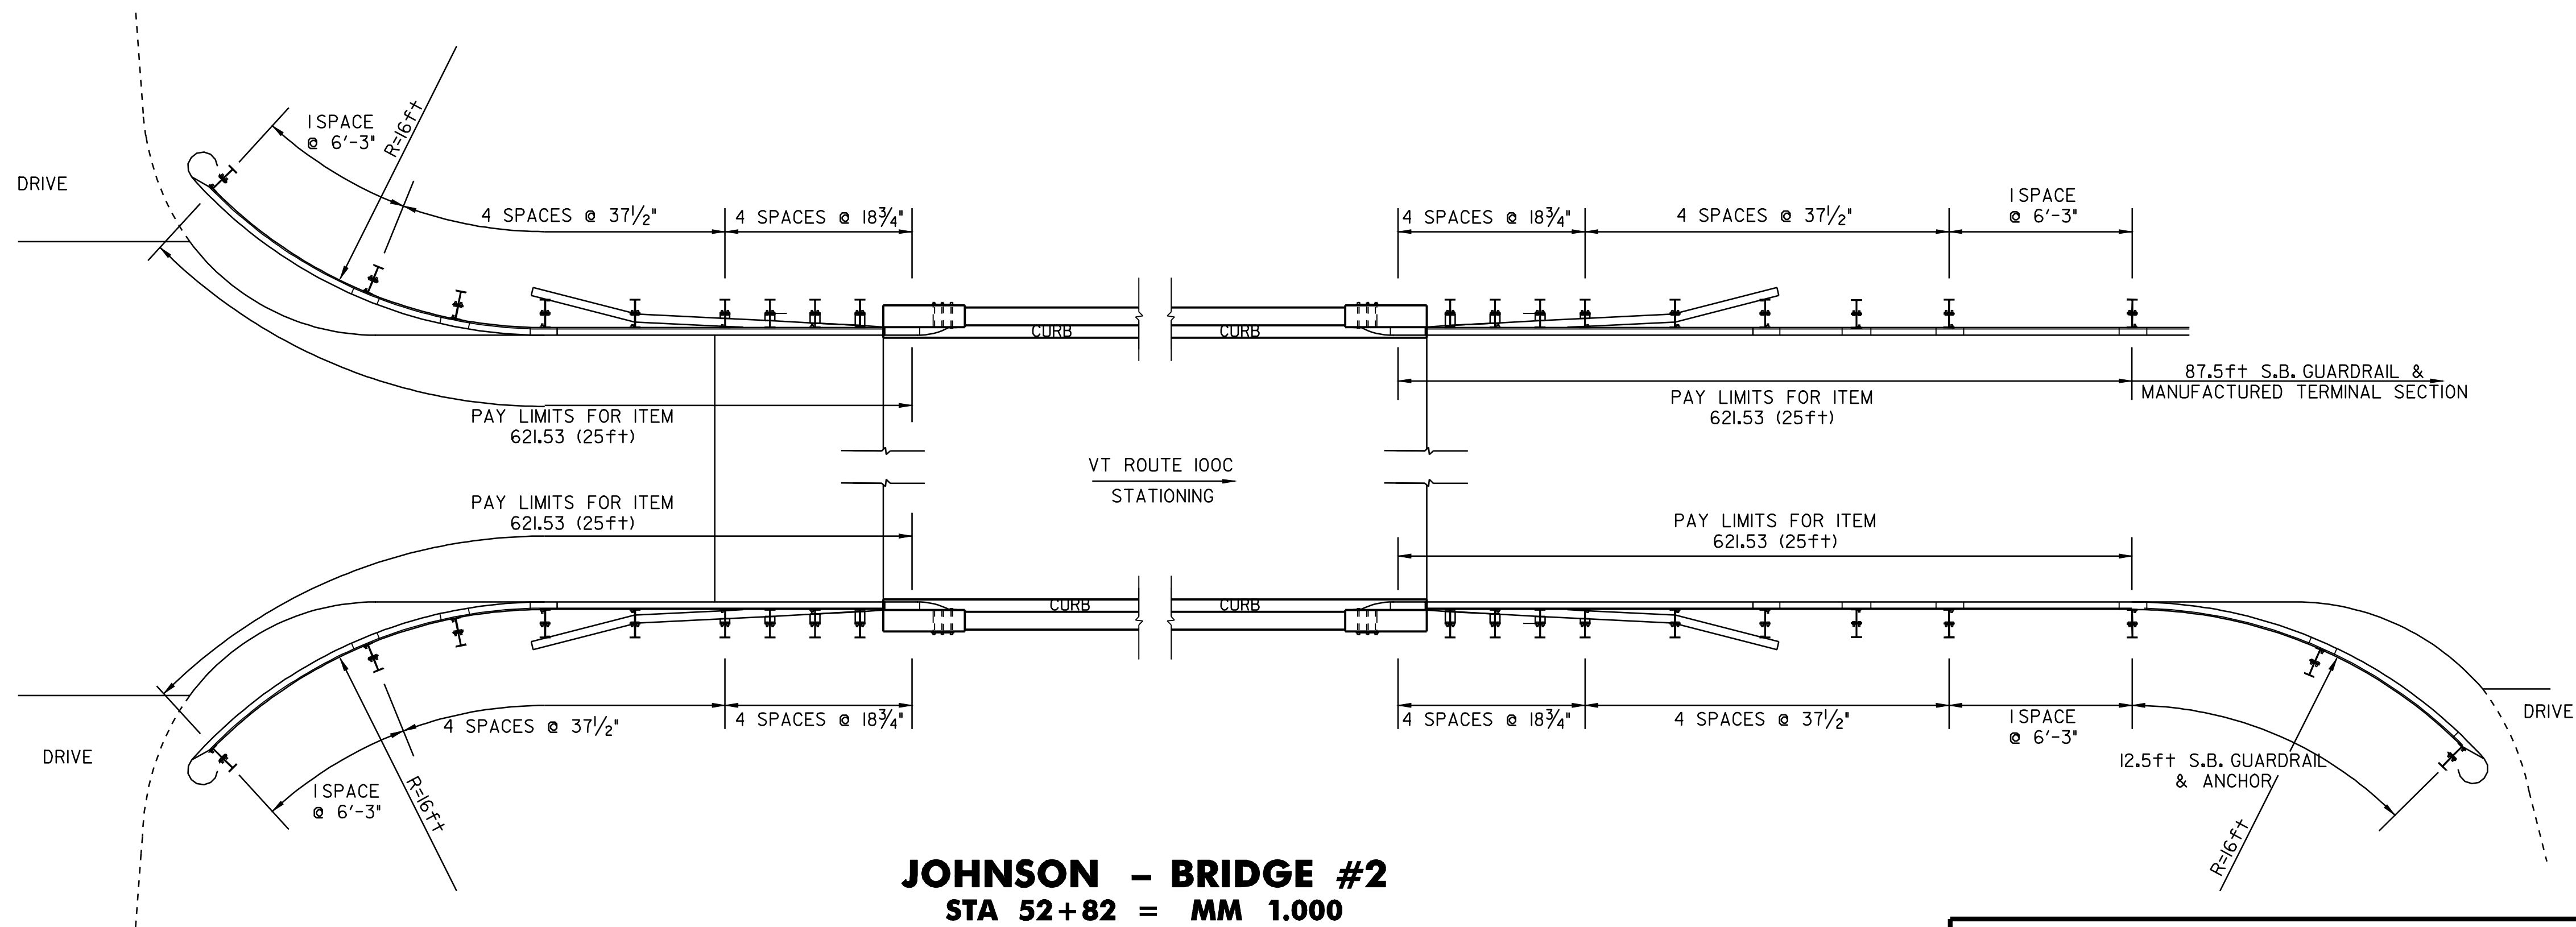

JOHNSON - BRIDGE #2
STA 52+82 = MM 1.000

BRIDGE DETAIL
SHEET #1


DESIGNED BY	BCE/PJM	DATE	6-07
DRAWN BY	C.E.A., INC.	DATE	6-07
DESIGN FILE NO.	p99c182.dgn		
PRF FILE	p99c182bdl1	DATE PLOTTED	08-JAN-2009 08
PROJ. NAME	JOHNSON - HYDE PARK		
PROJ. NO.	STP 2215(1)S		
SHEET	29	OF	33 SHEETS

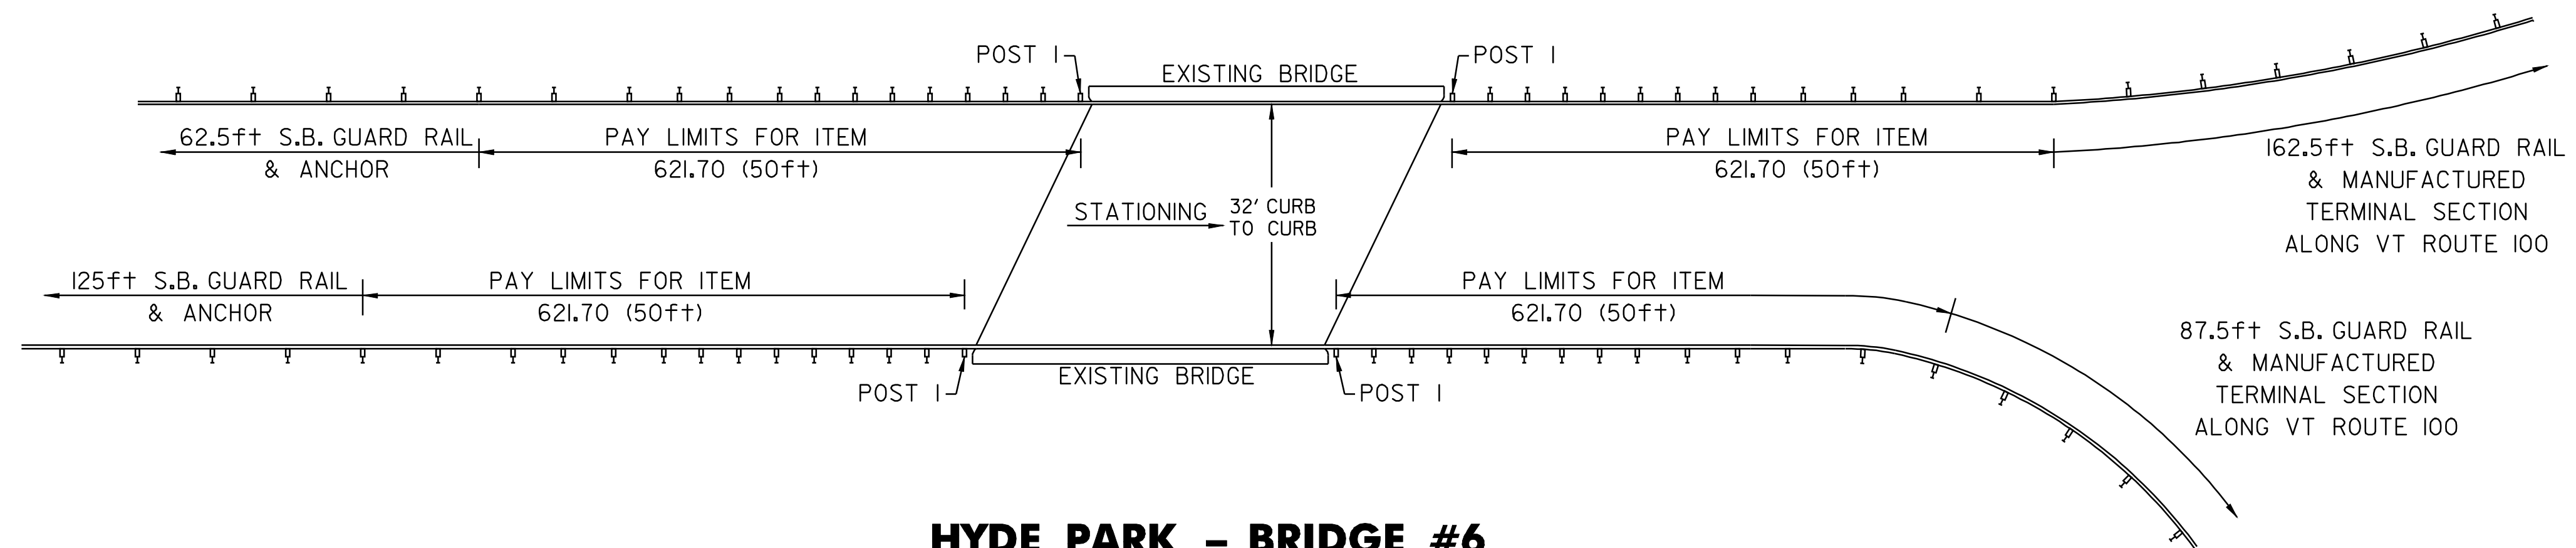

HYDE PARK - BRIDGE #6
STA 2+67 = MM 0.050

BRIDGE DETAIL
SHEET #2


DESIGNED BY BCE/PJM DATE 9-07
 DRAWN BY C.E.A., INC. DATE 9-07
 DESIGN FILE NO. p99cl82.dgn
 PRF FILE p99cl82bd2.1 DATE 08-JAN-2009 08
 PLOTTED
 PROJ. NAME **JOHNSON - HYDE PARK**
 PROJ. NO. **STP 2215(1)S**
 SHEET **30** OF **33** SHEETS

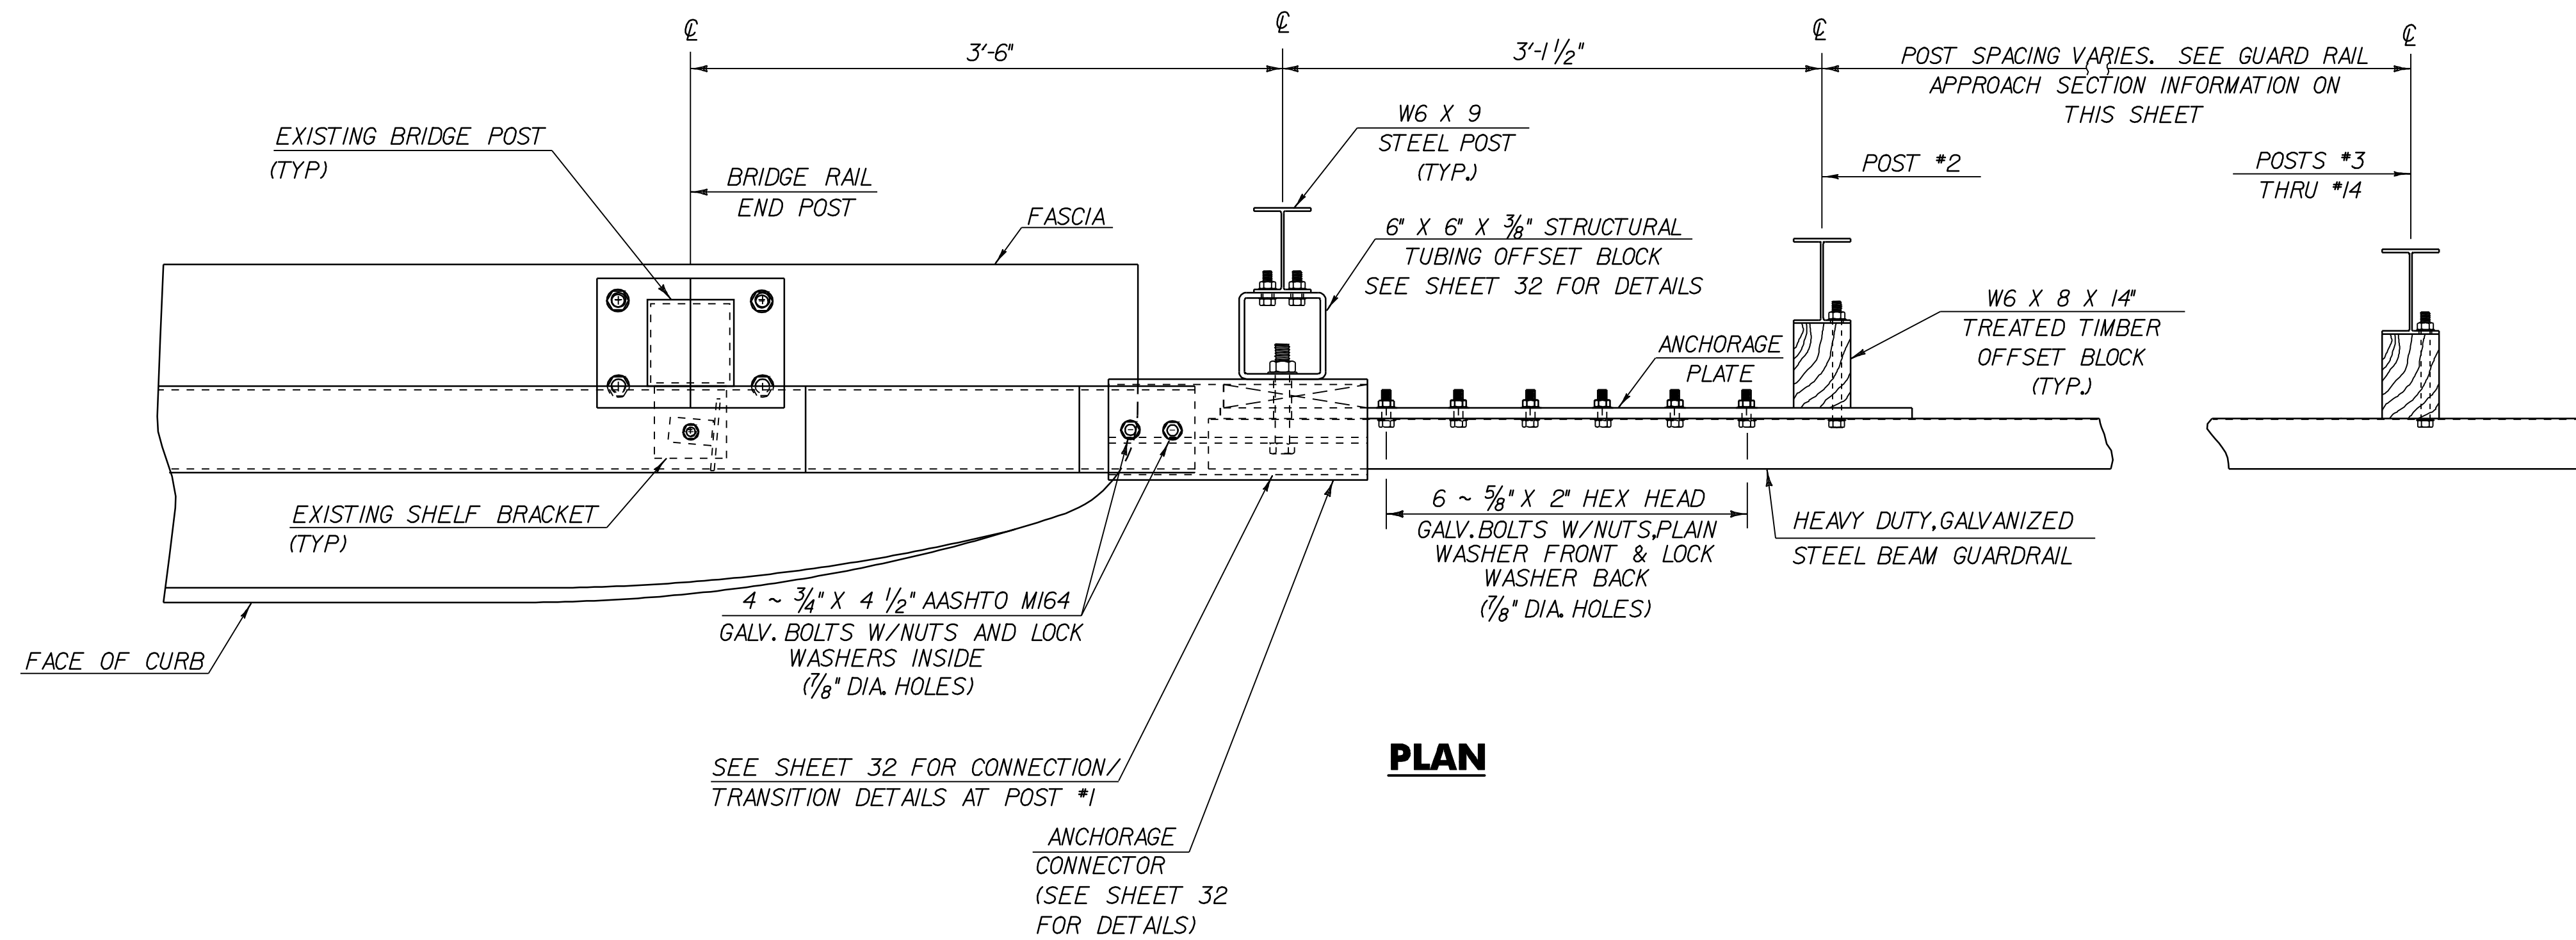

**GUARDRAIL
APPROACH SECTION
TYPE I**

POST NO.	SPACING
1	3'-1 1/2"
2	3'-1 1/2"
3	3'-1 1/2"
4	3'-1 1/2"
5	3'-1 1/2"
6	3'-1 1/2"
7	3'-1 1/2"
8	3'-1 1/2"
9	3'-1 1/2"
10	4'-2"
11	4'-2"
12	4'-2"
13	6'-3"
14	6'-3"

50'-0" PAY LIMIT GUARDRAIL APPROACH SECTION, TYPE I

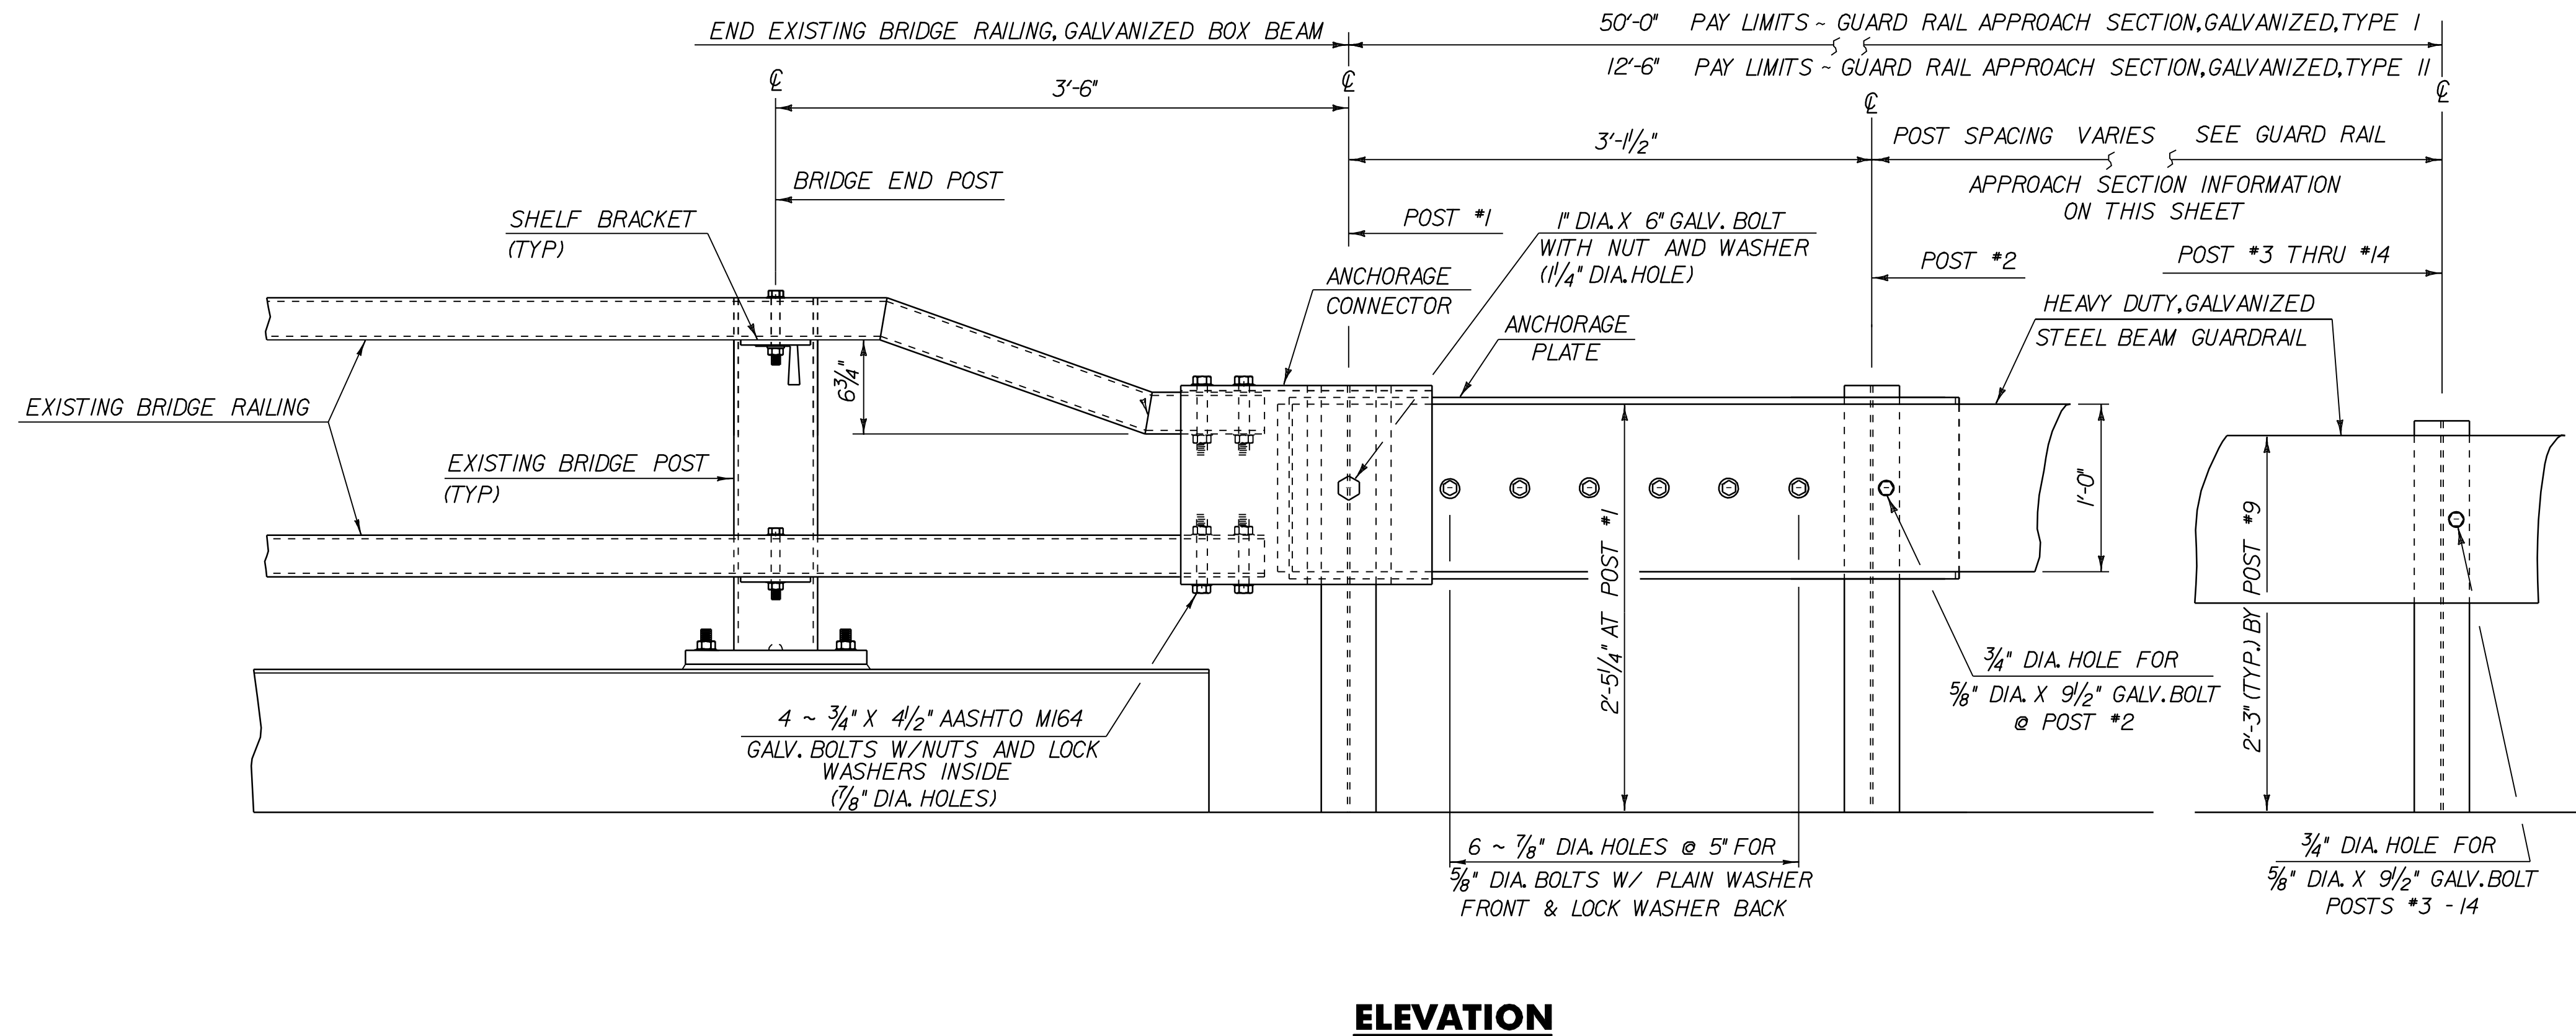

**GUARDRAIL
APPROACH SECTION
TYPE II**

POST NO.	SPACING
1	3'-1 1/2"
2	4'-8 1/4"
3	4'-8 1/4"
4	4'-8 1/4"

12'-6" PAY LIMIT GUARD RAIL APPROACH SECTION TYPE II

GUARDRAIL APPROACH SECTION DETAIL





**GUARDRAIL APPROACH
SECTION DETAIL
SHEET #1**

DETAILS ARE NOT TO SCALE

DESIGNED BY _____ DATE 9-07
DRAWN BY _____ DATE 9-07
DESIGN FILE NO. p99cl82.dgn
PRF FILE p99cl82gasdl.i DATE PLOTTED 08-JAN-2009 08:55
PROJ. NAME JOHNSON - HYDE PARK
PROJ. NO. STP 2215(1)S
SHEET 31 OF 33 SHEETS

APPROACH RAIL NOTES:


1. REFER TO STANDARD G-1 FOR ADDITIONAL RAIL DETAILS.
2. ALL POSTS FOR HEAVY DUTY STEEL BEAM GUARD RAIL SHALL BE STEEL, IN ACCORDANCE WITH SECTION 728 "GUARD RAIL, GUIDE POSTS AND BARRIERS" UNLESS OTHERWISE SPECIFIED IN THE CONTRACT.
3. APPROACH RAIL SPLICES SHALL LAP IN DIRECTION OF TRAFFIC FLOW.
4. ANCHORAGE CONNECTOR AND ANCHORAGE PLATE SHALL BE AASHTO M 270, GRADE 250 GALVANIZED TO AASHTO M III AFTER FABRICATION.
5. ALL BOLTS, NUTS AND WASHERS SHALL BE AASHTO M 164 GALVANIZED TO AASHTO M 232 AFTER FABRICATION.
6. STRUCTURAL TUBING OFFSET BLOCK SHALL BE AASHTO M 183 GALVANIZED TO AASHTO M III AFTER FABRICATION.
7. APPROACH RAILING SHALL BE HEAVY DUTY STEEL BEAM FOR 50'-0" FROM THE CL OF POST #1 FOR TYPE I AND 12'-6" FROM THE CL OF POST #1 FOR TYPE II.
8. ALLOWABLE DIMENSIONAL TOLERANCE FOR BENT SECTIONS IS +/- 1/16 OF AN INCH.
9. THE UNIT PRICES BID FOR EITHER TYPE OF GUARD RAIL APPROACH SECTION SHALL INCLUDE ANCHORAGE CONNECTOR, ANCHORAGE PLATE, HEAVY DUTY STEEL BEAM GUARD RAIL, POSTS, OFFSET BLOCKS, BLOCKING, BOLTS, AND ALL NECESSARY HARDWARE.

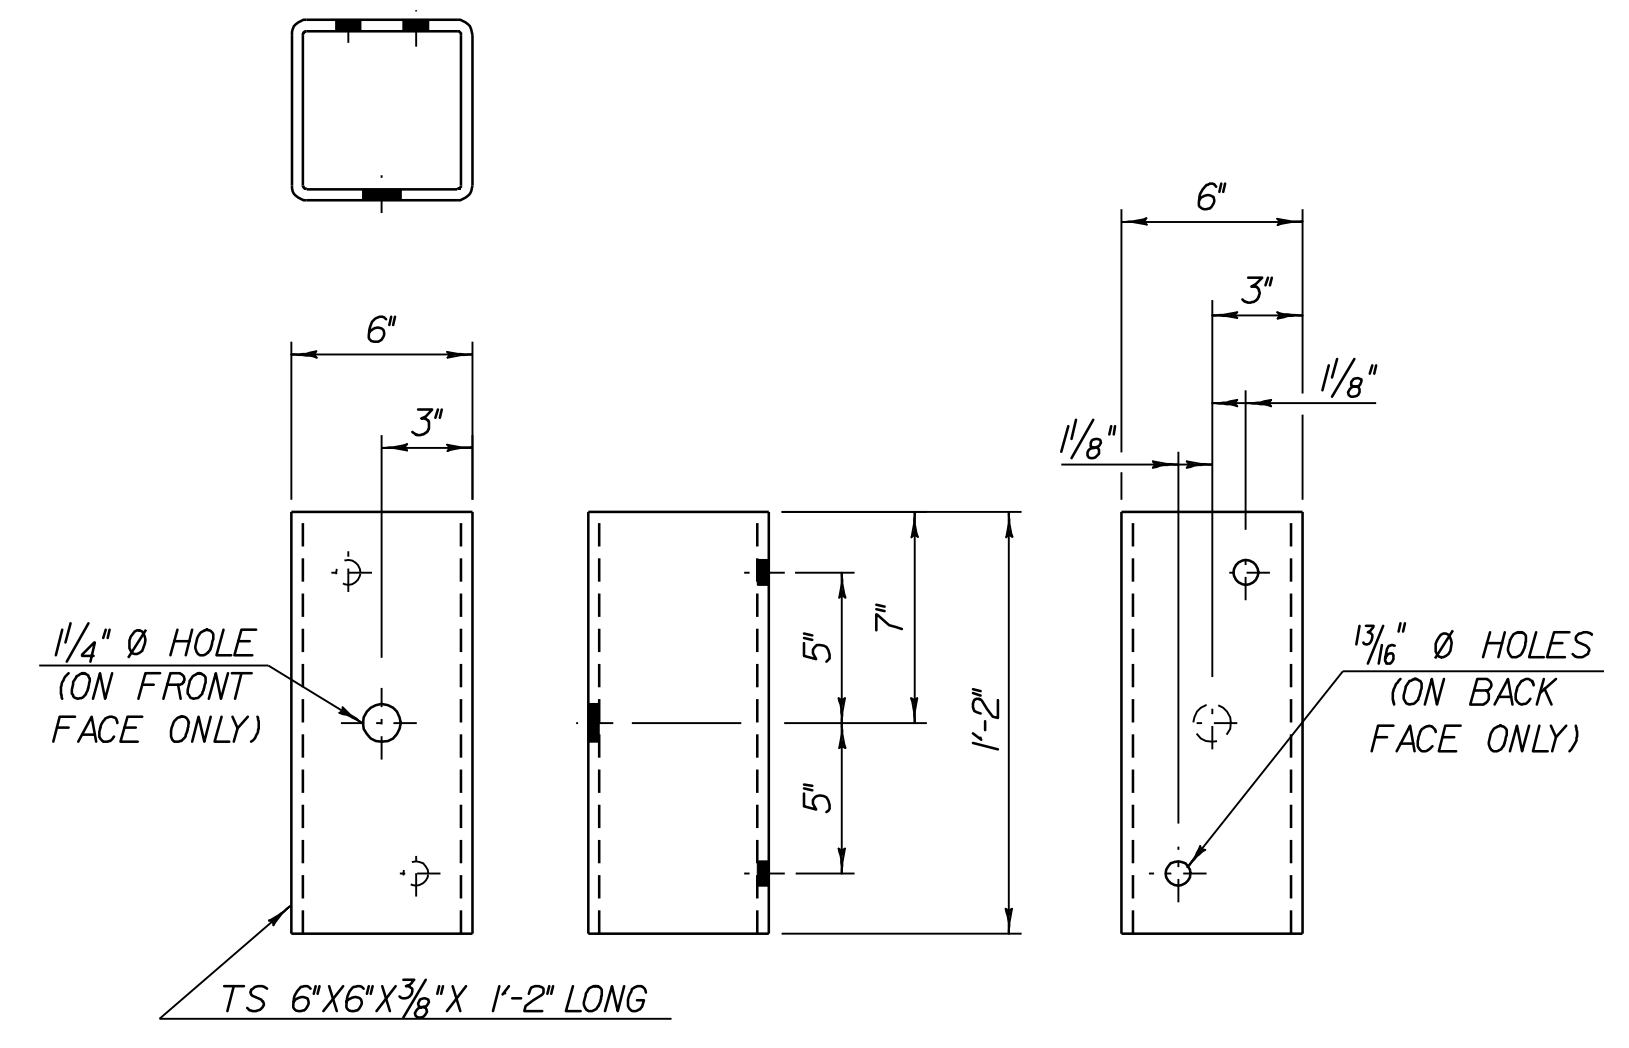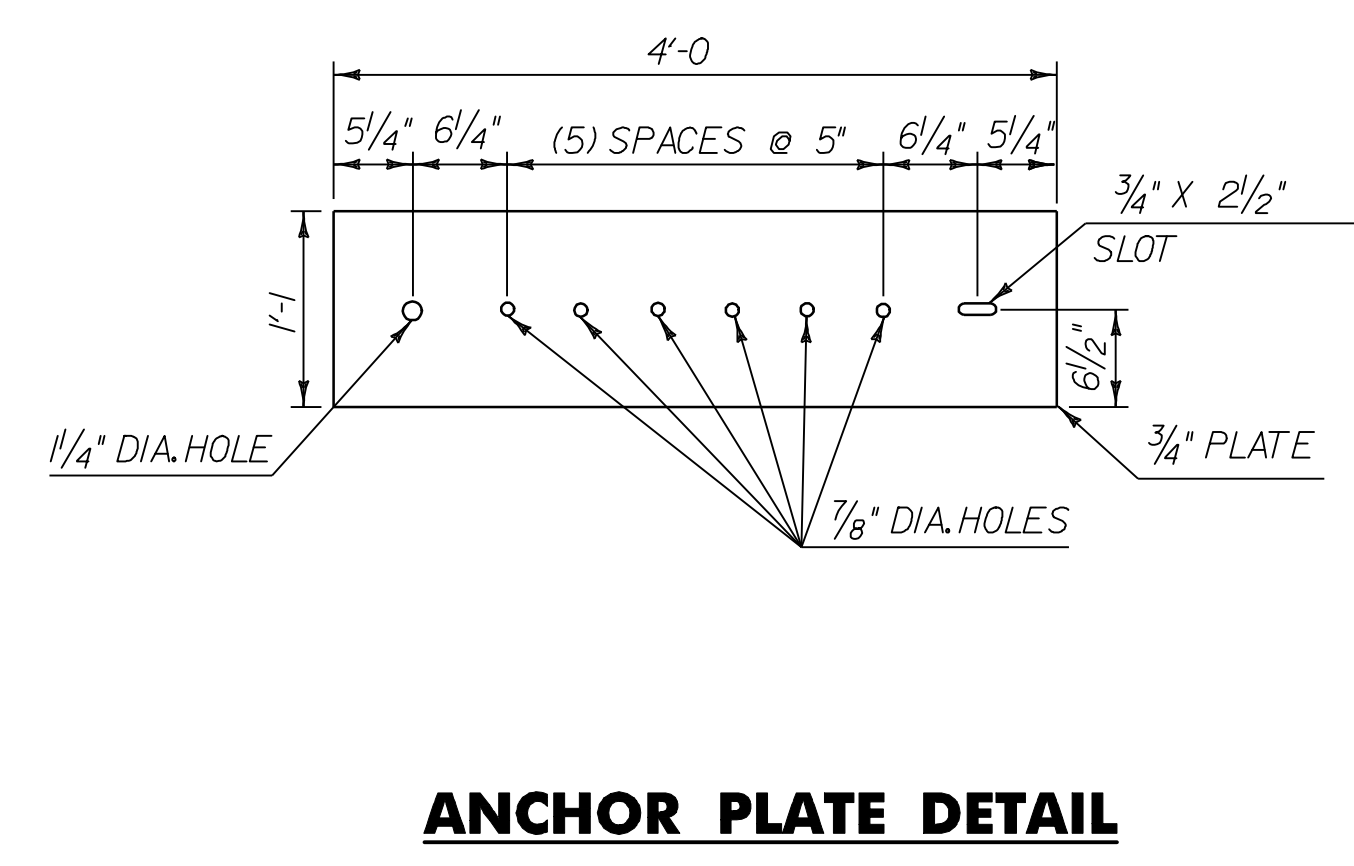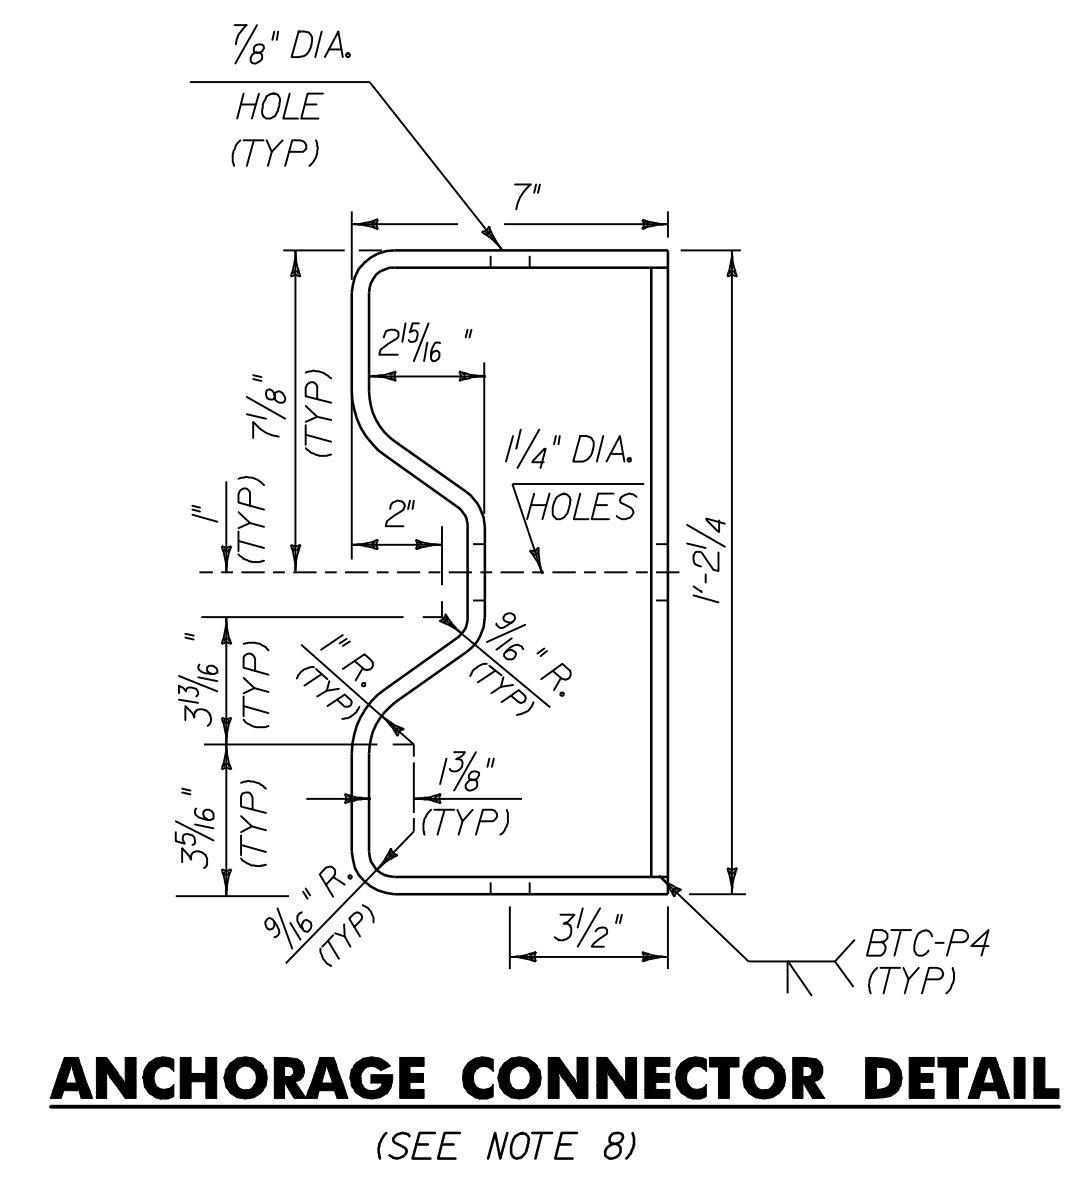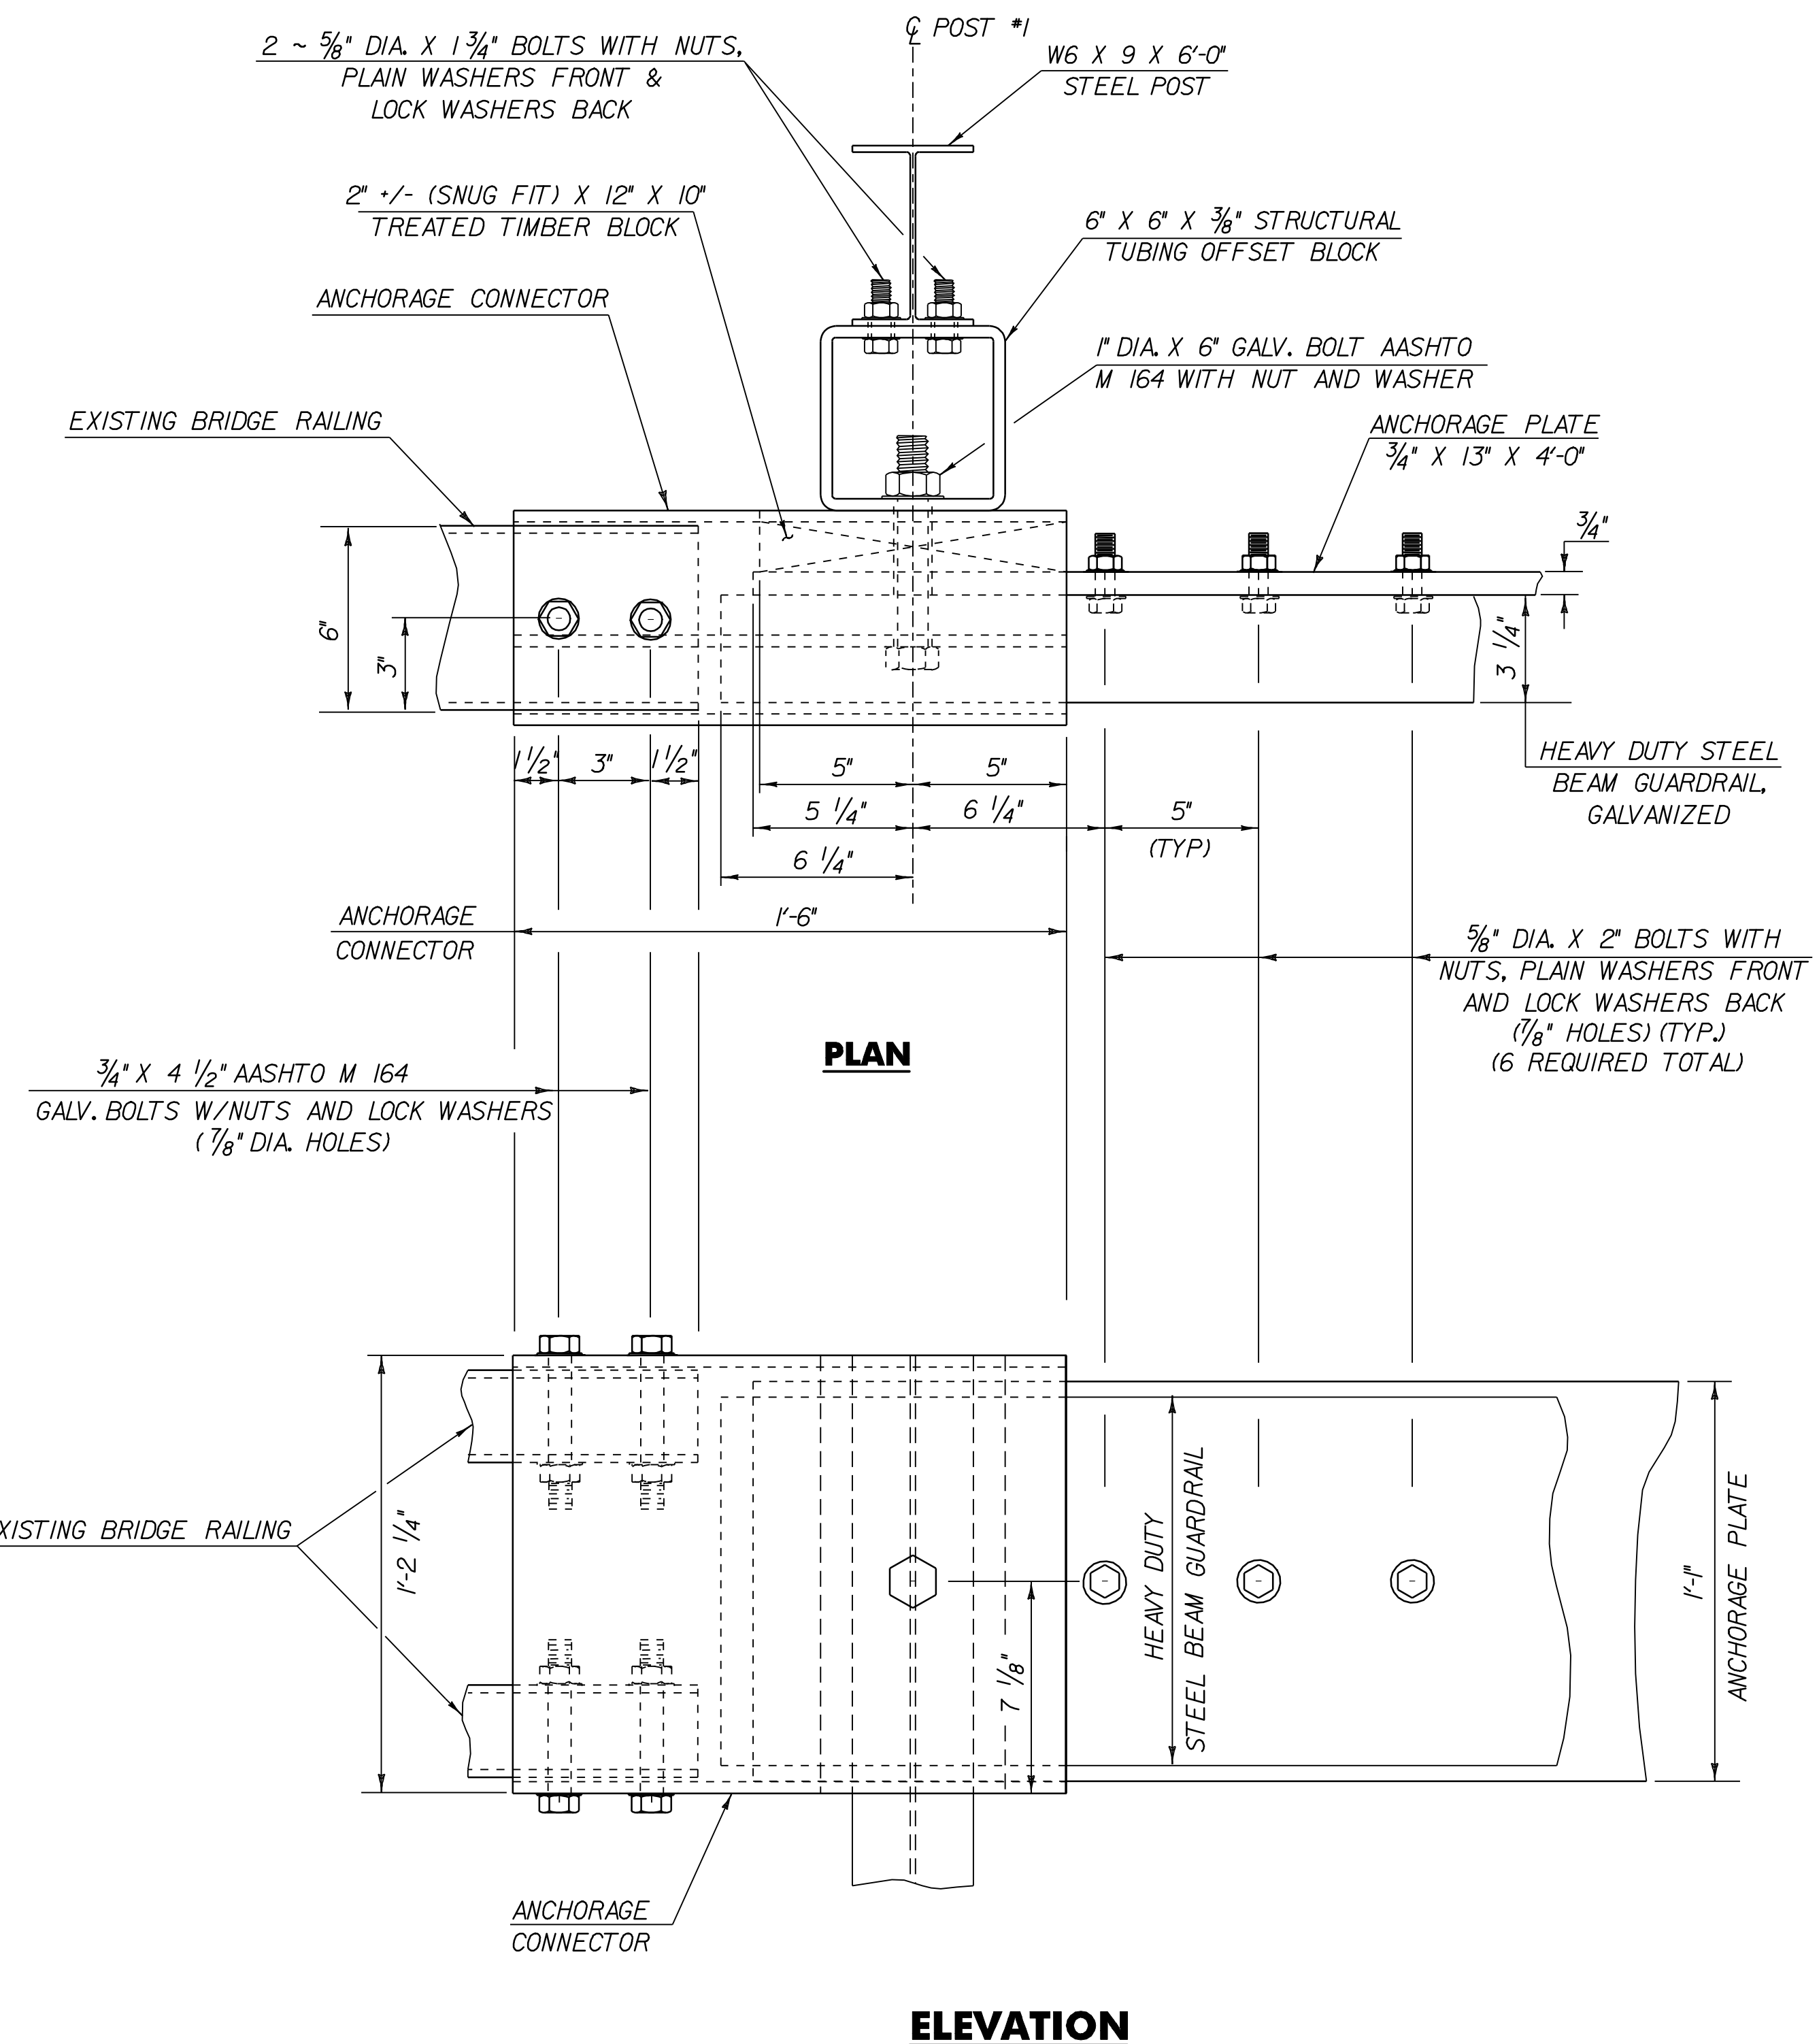

GUARDRAIL APPROACH SECTION DETAIL SHEET #2

DETAILS ARE NOT TO SCALE

DESIGNED BY	DATE 9-07
DRAWN BY	DATE 9-07
DESIGN FILE NO.	p99cl82.dgn
PRF FILE	p99cl82gasd2.1 DATE PLOTTED 08-JAN-2009 08
PROJ. NAME	JOHNSON - HYDE PARK
PROJ. NO.	STP 2215(1)S
SHEET	32 OF 33 SHEETS

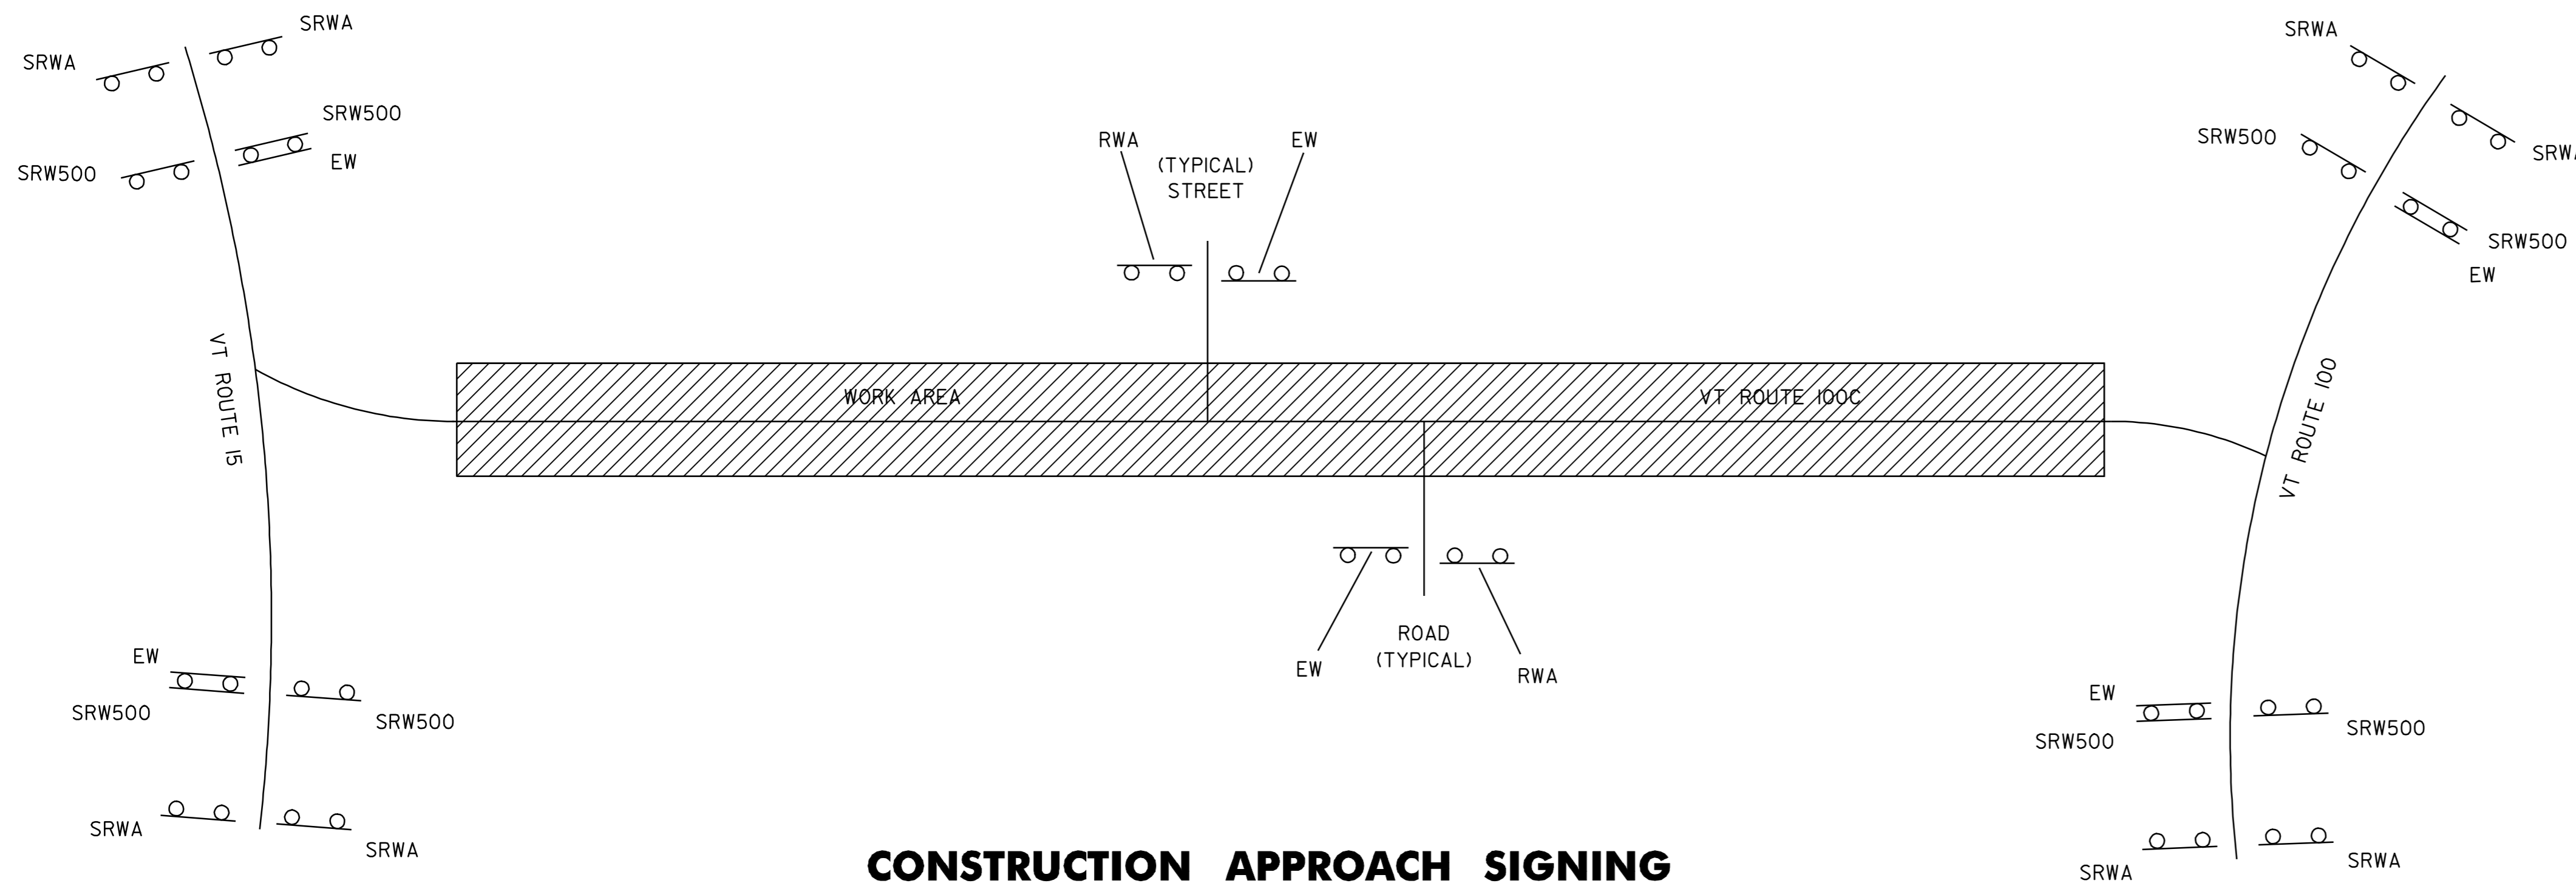

CONSTRUCTION APPROACH SIGNING

SEE STD. E-100 FOR SIGN PLACEMENT


RESIDENT ENGINEER, AT HIS OR HER DISCRETION, SHALL ELIMINATE CONSTRUCTION APPROACH SIGNING AT DEAD END LOCATIONS.

LEGEND



- RWA = SIDE ROAD WORK AHEAD
- SRWA = SIDE ROAD WORK AHEAD
- SRW500 = SIDE ROAD WORK 500 FEET
- EW = END WORK

NOTES:


1. THE CONTRACTOR SHALL SUBMIT A TRAFFIC CONTROL PLAN FOR APPROVAL PRIOR TO THE START OF CONSTRUCTION. THE COST OF PREPARING THIS PLAN (AND MAKING CHANGES IF NECESSARY) SHALL NOT BE PAID SEPARATELY BUT SHALL BE INCIDENTAL TO ITEM 641.10, "TRAFFIC CONTROL".
2. THE CONTRACTOR SHALL INCLUDE A CONSTRUCTION SIGN APPROACH PACKAGE FOR EXPECTED LANE CLOSURES AND WORK ZONE SPEED REDUCTIONS IN COMPLIANCE WITH VTRANS STANDARD E-103. PAYMENT FOR PROVIDING THIS PACKAGE SHALL BE INCIDENTAL TO ITEM 641.10, "TRAFFIC CONTROL".
3. THE MUTCD 2003 SHALL BE THE STANDARD FOR ALL TRAFFIC CONTROL DEVICES. EXISTING SIGNS, SIGNALS AND MARKINGS SHALL BE VALID UNTIL SUCH TIME AS THEY ARE REPLACED OR RECONSTRUCTED. WHEN NEW TRAFFIC CONTROL DEVICES ARE ERECTED OR PLACED OR EXISTING TRAFFIC CONTROL DEVICES ARE REPLACED OR REPAIRED THE EQUIPMENT, DESIGN, METHOD OF INSTALLATION, PLACEMENT OR REPAIR SHALL CONFORM TO THESE STANDARDS.
4. NO CONSTRUCTION SIGNS SHALL BE INSTALLED AS TO INTERFERE OR OBSTRUCT THE VIEW OF EXISTING TRAFFIC CONTROL DEVICES, STOPPING SIGHT DISTANCE, AND CORNER SIGHT DISTANCE FROM DRIVES AND TOWN HIGHWAYS.
5. ON VTRANS STANDARDS E-103, SIGN W4-2 MAY BE REPLACED WITH W9-2:

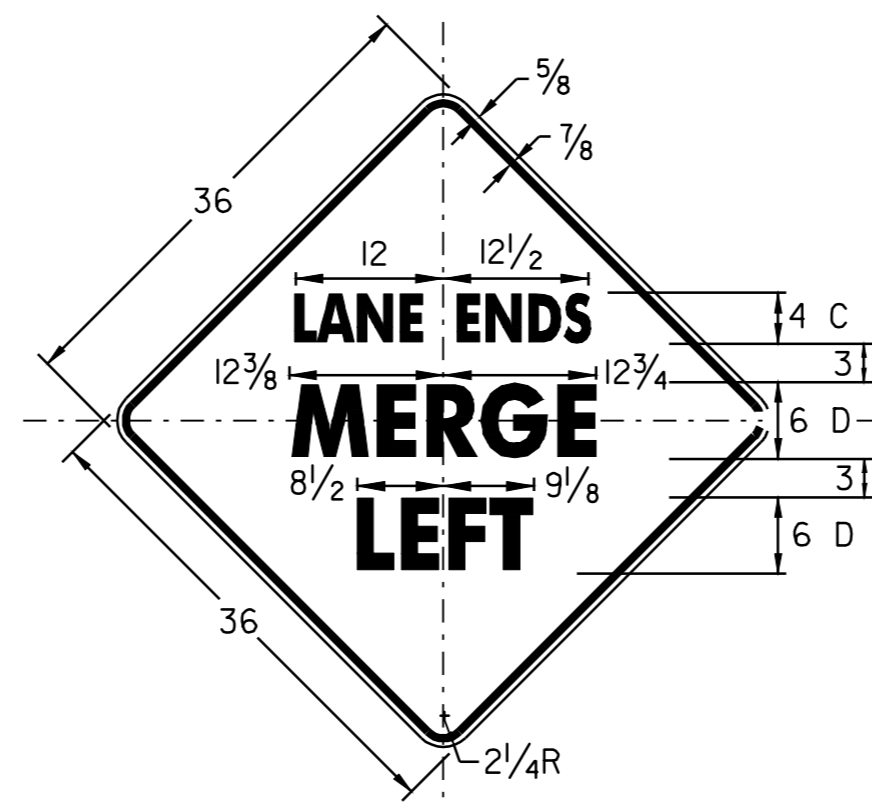

W9-2
MATERIALS & COLORS:
PER VAOT STANDARD E-154

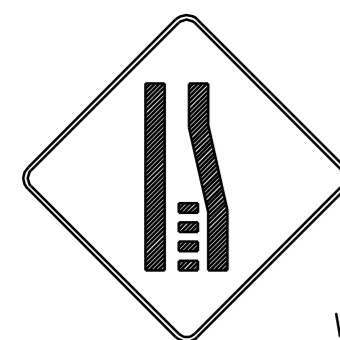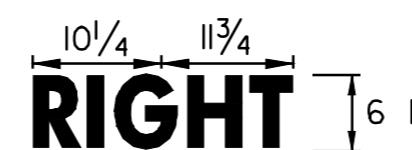


W4-2

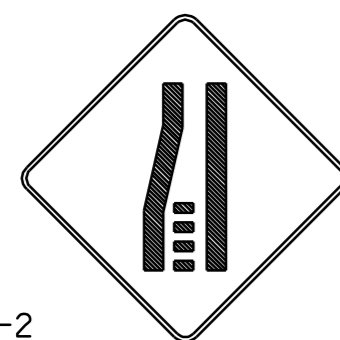

W9-2




W9-2

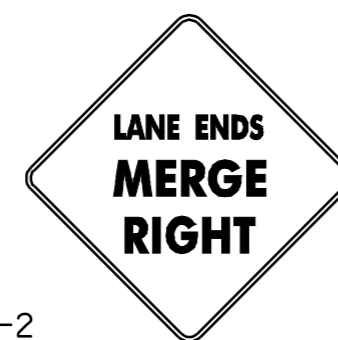


W9-2

LIST OF CONSTRUCTION SIGNS

TOWN HIGHWAY	RWA	EW	SRWA	SRW500
JOHNSON				
BEGIN PROJECT		2	4	4
SCHOOL ROAD				
TH #56				
SINCLAIR ROAD				
ROCKY ROAD				
HOAG ROAD				
WHITCOMB ISLAND ROAD				
MINE ROAD				
WILSON ROAD				
OBER HILL ROAD				
BRADLEY ROAD				
HYDE PARK				
END PROJECT		2	4	4
TOTALS	10	14	8	8

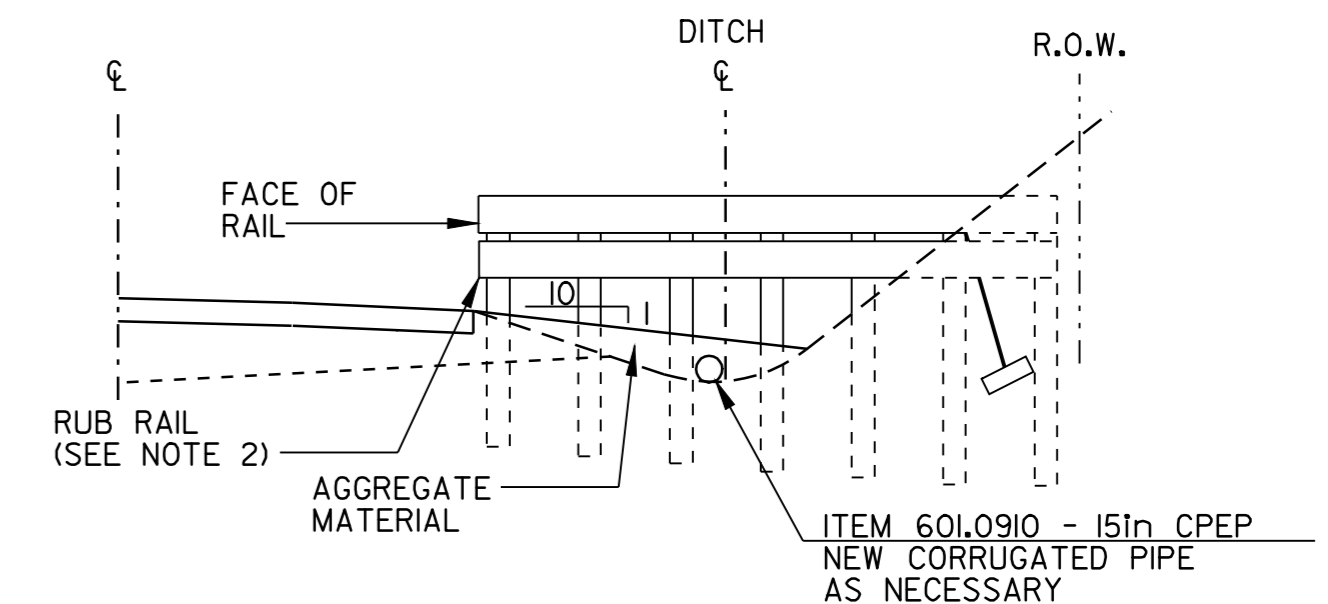

SECTION B-B

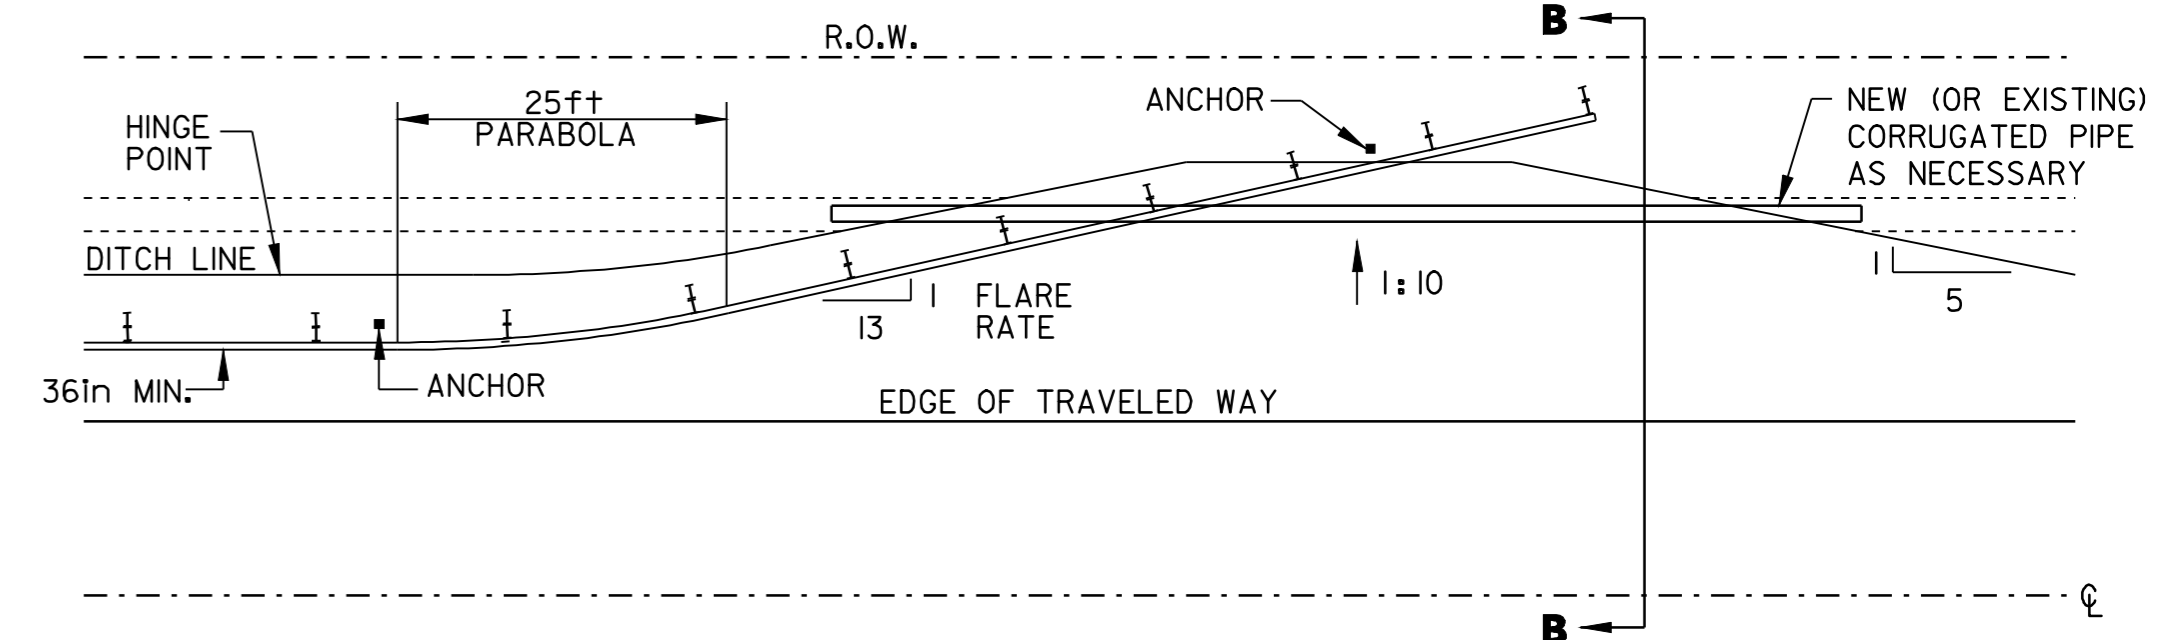

DETAIL FOR BURIED GUARDRAIL ENDS INTO BACKSLOPES

NOT TO SCALE

JOHNSON
STA 50+65 RT

NOTES:

1. PRIMARY RAIL SHALL REMAIN AT A CONSTANT HEIGHT (LEVEL) RELATIVE TO THE HEIGHT OF RAIL AT THE EDGE OF SHOULDER.
2. ADDITION OF RUB RAIL IS REQUIRED WHEN OPENING BENEATH PRIMARY RAIL EXCEEDS 18in. RUB RAIL EXTENDS FROM THE EDGE OF SHOULDER TO THE BACK SLOPE.

CONSTRUCTION APPROACH SIGNING AND BURIED END TERMINAL DETAIL SHEET

DATUM
VERTICAL N/A
HORIZONTAL N/A

DESIGNED BY BCE/PJM DATE 6-07
DRAWN BY C.E.A., INC. DATE 6-07
DESIGN FILE NO. p99cl82.dgn
PRF FILE p99cl82cas.l DATE 08-JAN-2009 PLOTTED
PROJ. NAME **JOHNSON - HYDE PARK**
PROJ. NO. **STP 2215(1)S**
SHEET **33** OF **33** SHEETS